

N^o 10075

**FOLLOWING DATA TO BE ANSWERED BY INSPECTOR
AND SIGNED WHEN RETURNED**

DATE INSPECTED 5-12-91

IF SO HOW AND LOCATION FROM
FIRST MANHOLE DOWN STREAM

HOUSE NO. 638

SIZE OF PIPE USED 6"


DISTANCE FROM FIRST MANHOLE
DOWN STREAM TO DITCH AT
CURB LINE AND DEPTH 8'

WAS LATERAL AT CURB? yes

WAS ATTACHED TO MAIN yes

NAME OF CONTRACTOR Louisville Excavating

SHOW BY DIAGRAM RELATION OF LATERAL TO WALL OF BUILDING SERVED.

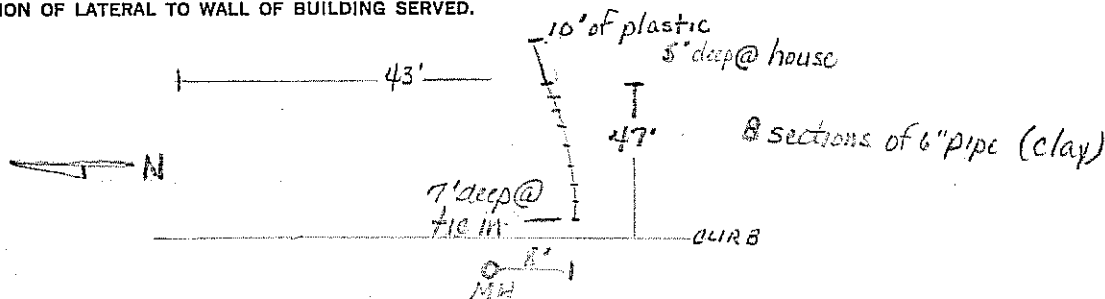

SIGNED _____ FILED AT ENGINEER'S OFFICE _____
Inspector for City

REMARKS no foundation when pipe was laid

TAP

Nº 10075

OFFICE OF THE DIRECTOR OF PUBLIC SEI
PERMIT TO TAP SEWER

MASSILLON, OHIO,

3-11

RECEIVED OF

~~FIFTY~~ ~~TWENTY FIVE~~ DOLLARS

FEE OF \$ 56

FOR WHICH PERMISSION IS GRANTED

LOUISVILLE EXCA

TO TAP

SEWER

SEWER ON THE

RIGHT

OF

28TH

AVE.
ST.

TYPE OF STREET

CHIP & SEAL

THE PREMISES BEING LOT NO.

14318

HOUSE NO.

638

WORK TO BE DONE IN ACCORDANCE WITH ORDINANCE NO. 19-1971 DULY PASSED BY THE CITY COUNCIL, AND I
OF THE DEPARTMENT OF PUBLIC SERVICE.

NAME OF CONTRACTOR

LOUISVILLE EXCA

Note: This permit covers work outside of building only. Any work
walls of building is subject to Massillon Board of Health Regulations.