



CITY OF MASSILLON, OHIO
151 LINCOLN WAY EAST
MUNICIPAL GOVERNMENT ANNEX
CITY ADMINISTRATION BUILDING
MASSILLON, OHIO 44646
PHONE 330-830-1722 FAX 330-830-1786

PERMIT DATE:

10/14/03

PERMIT NO.

3064

PERMIT TO TAP SANITARY SEWER

This permit is issued subject to the latest Codified Ordinances of the City of Massillon, OH. The City Engineer to be notified 24 hours in advance of start of work (330) 830-1722. All permits issued under this ordinance are void after 120 days from date of issuance.

RECEIVED OF:

PERMIT TYPE: ☒ NEW ☐ REPAIR ☐ CUTOFF

CONTRACTOR INFORMATION

CONTRACTOR: MALAVITE EXCAVATING

CONTACT: GUST MALAVITE

ADDRESS:

CITY:

STATE:

ZIP:

PHONE:

FAX:

SURETY:

SITE INFORMATION

OWNER'S NAME: TOBIN CONSTRUCTION

STREET NUMBER: 2162

STREET NAME: UNIVERSITY COMMONS DR

CITY LOT NUMBER: OL 899

PURPOSE OF CUT: SANITARY

ZONING CLASS:

STREET SIDE: EAST

PHONE OTHER:

NOTE: This permit covers work outside of the building ONLY. Any work inside walls of the building is subject to the Massillon Board of Health Regulations.

SANITARY SEWER CONNECTION:

USAGE: ☒ RESIDENTIAL ☐ COMMERCIAL ☐ INDUSTRIAL

DATE INSPECTED

located on the East side of

University Commons DR SE between

Ohio State DR SE and

Direction from downstream Manhole: South

Distance from downstream Manhole: 170'

Connection Length: 0.00 (FEET)

Connection Depth: 0 (FEET)

Size of Sewer Pipe: (INCHES)


Pipe Material:

INSPECTORS NAME: No Inspection

COMMENTS: Measurements From Asbuilts

SKETCH: DRAWING #:

3064

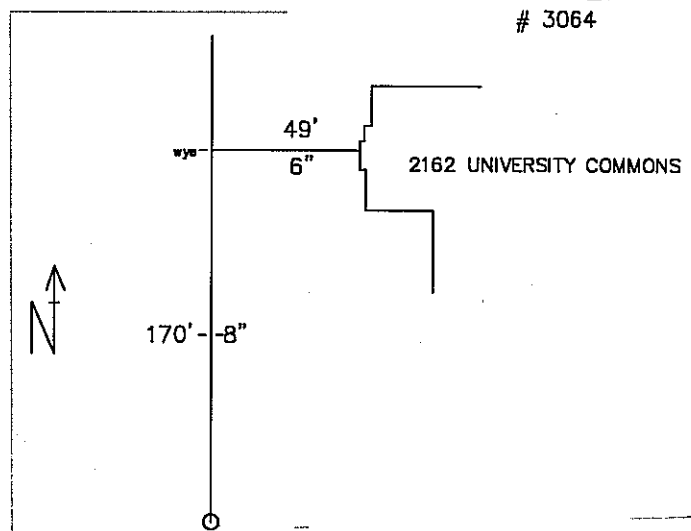

SANITARY SEWER PERMIT FEE: \$50.00

TOTAL COST: \$50.00

TWO WORKING DAYS BEFORE YOU DIG
Ohio Utilities Protection Service
Call 1-800-362-2764 Toll Free....
Non-Members must be called directly.

AUTHORIZED BY: DIRECTOR OF PUBLIC SAFETY AND SERVICE

ISSUED BY: LINDA MIKUTEL