

Aqua Ohio, Inc.

DISTRIBUTION SYSTEM MAPS

STARK REGIONAL DIVISION

SECURITY CHAIN OF CUSTODY

This material may not be distributed to others without the written consent of Aqua Ohio, Inc.

AQUA
Ohio

AQUA
Ohio

Table of Contents

COVER SHEET	1
GREEN INDEX SHEET	2
NORTH INDEX SHEET	3
SOUTH INDEX SHEET	4
GREEN COMP. MAP	5
NORTH COMP. MAP	6
SOUTH COMP. MAP	7
DISTRIBUTION MATCHLINE MAP	A3 - A6
DISTRIBUTION MATCHLINE MAP	B3 - B6
DISTRIBUTION MATCHLINE MAP	C3 - C9
DISTRIBUTION MATCHLINE MAP	D-3 - D9
DISTRIBUTION MATCHLINE MAP	E-3 - E9
DISTRIBUTION MATCHLINE MAP	F-3 - F9
DISTRIBUTION MATCHLINE MAP	G-2 - G2
DISTRIBUTION MATCHLINE MAP	H-2 - H2

BOOSTER STATIONS


FORD	0.7 MGD
16th ST.	1.0 MGD
23rd ST.	1.85 MGD
WALES RD.	4.0 MGD
HILLS & DALES	2.0 MGD
NAVE ST.	1.0 MGD
MCDONALDSVILLE	1.0 MGD
GREEN	

STORAGE TANKS

MCDONALDSVILLE STANDPIPE	1.0 MG
FORD ST. RESERVOIR	2.0 MG
UNDERGROUND RESERVOIR	1.5 MG
BAILEY ELEVATED	0.5 MG
EASTLAKE STANDPIPE	1.0 MG
KENYON STANDPIPE	1.0 MG
NAVE STANDPIPE	1.0 MG
FULTON RESERVOIR	3.0 MG
APPLEGROVE STANDPIPE	0.4 MG
GREEN TANKS	.75 MG (2)
UNIONTOWN	.75 MG

WATER SUPPLY WELLS

#1-86	4.0 MGD
#2-74	1.7 MGD
#3-56	0.5 MGD
#5-66	3.0 MGD
#7-84	3.0 MGD
#8-85	3.0 MGD
#9-88	3.0 MGD
#10-97	5.0 MGD
#11-00	3.0 MGD
#12-02	2.0 MGD
#13-03	2.0 MGD

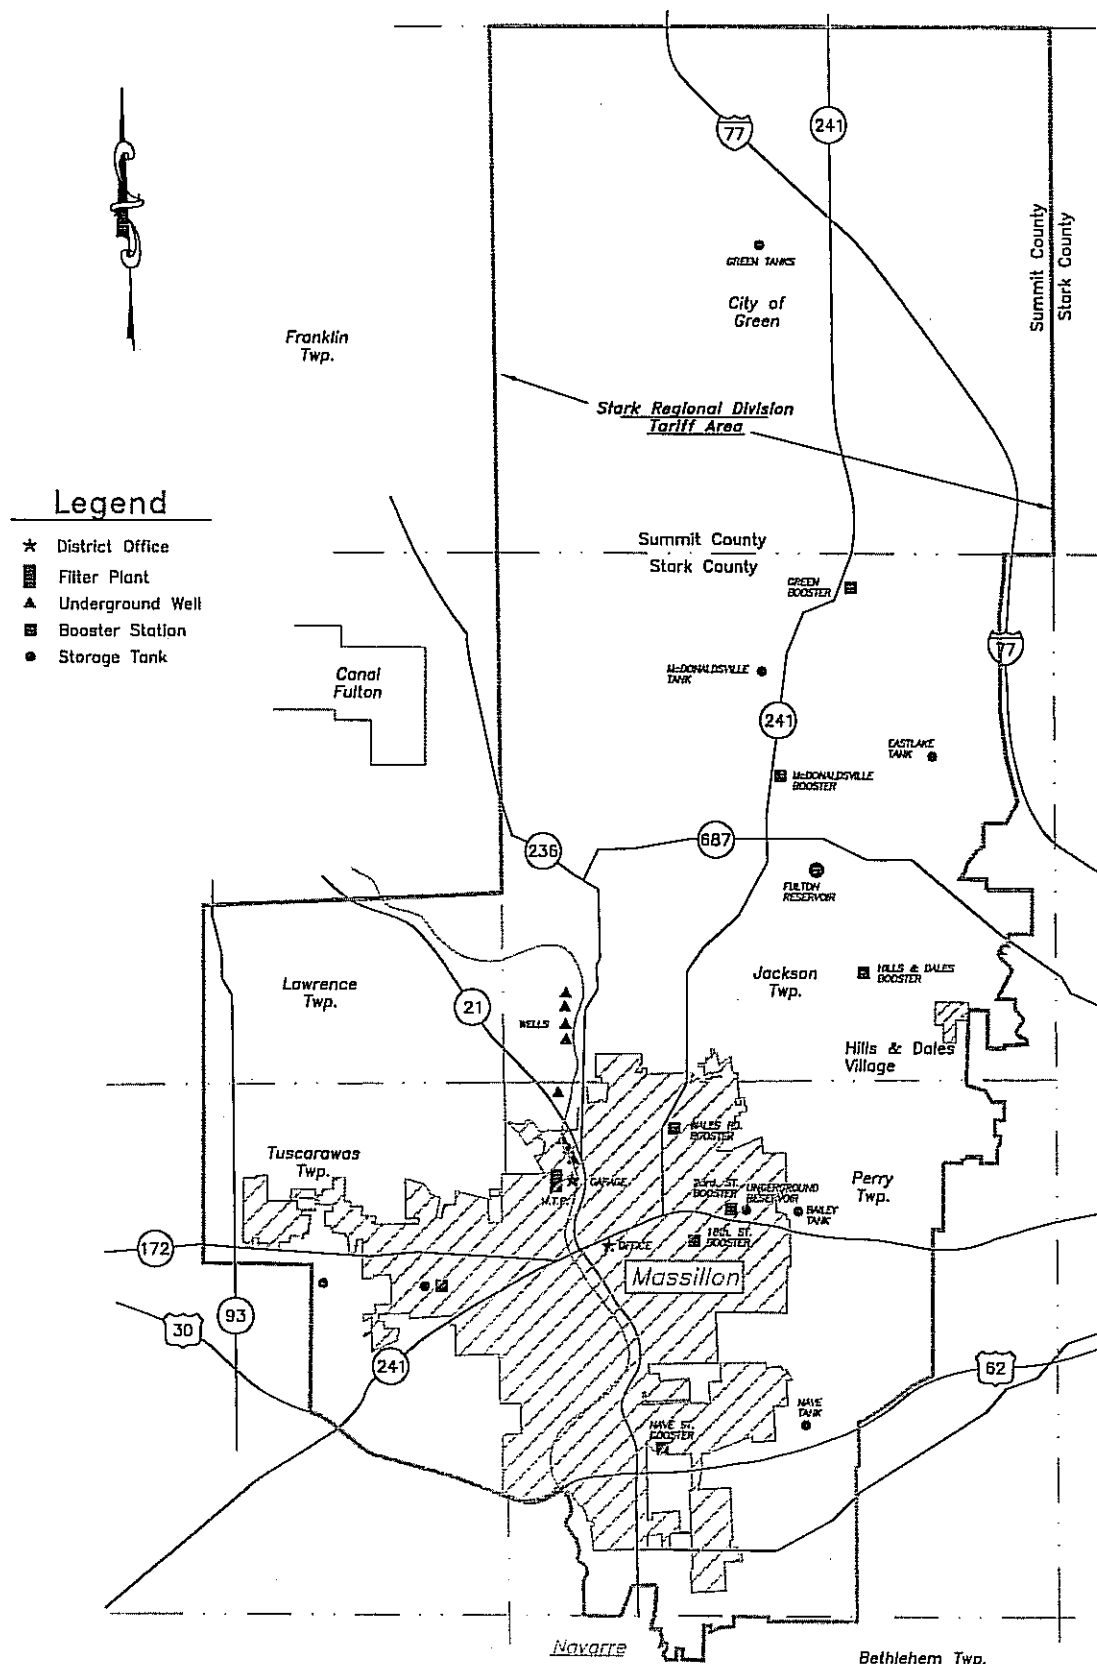

Legend

- ★ District Office
- Filter Plant
- ▲ Underground Well
- Booster Station
- Storage Tank

LEGEND

- PRIVATE HYDRANT
- HYDRANT WITH WATCH VALVE
- HYDRANT WITHOUT WATCH VALVE
- VALVE
- VALVE, CLOSED
- VALVE, PARTLY CLOSED
- VALVE IN VAULT
- TAPPING SLEEVE & VALVE
- CHECK VALVE (FLOW)
- REGULATOR
- B.O. BLOW OFF
- EASEMENT
- PRESSURE
- WELL LOCATION & WELL NO.

- 3"Ø & SMALLER
- 4"Ø WATERLINE
- 6"Ø WATERLINE
- 8"Ø WATERLINE
- 10"Ø WATERLINE
- 12"Ø WATERLINE
- 14"Ø WATERLINE
- 16"Ø WATERLINE
- 18"Ø WATERLINE
- 20"Ø WATERLINE
- 24"Ø WATERLINE
- 30"Ø WATERLINE
- 36"Ø WATERLINE
- PRIVATE W/L
- CROSS OVER
- TEE & CROSS
- RECORDING GAUGE
- REDUCER
- BENDS, HORIZONTAL


RECEIVED

APR 12 2005

PREPARED BY:
SERVICE CENTER ENGINEERING
FEBRUARY 2005

RECORD DRAWING
Locations of Waterworks facilities are approximate.
Offset information is not necessarily complete.
Locations of all abandoned facilities may not be shown.

SECURITY CHAIN OF CUSTODY
This material may not be distributed to others without the written consent of Aqua Ohio, Inc.

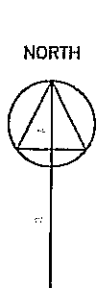

UPDATED	
BY	DATE
L.A.M.	1-04
L.A.M.	2-05


LINE LEGEND	
& SMALLER	
4"	
6"	
8"	
10" & 12"	
14" & 16"	
18" & 20"	
24"	
30"	
36"	

PRIVATE

DRAWN <i>Doug Warrick</i>	DATE <i>May, 1991</i>
CHECKED	DATE
APPROVED	DATE

AQUA
Ohio.


PREPARED BY:
SERVICE CENTER-ENGINEERING DEPT.
5550 SOUTH AVE. BOARDMAN OHIO 44512

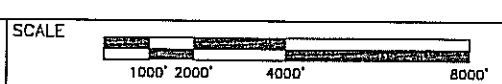


FILE NO.

GREEN INDEX MAP
STARK REGIONAL DIVISION

SHEET NO.
2

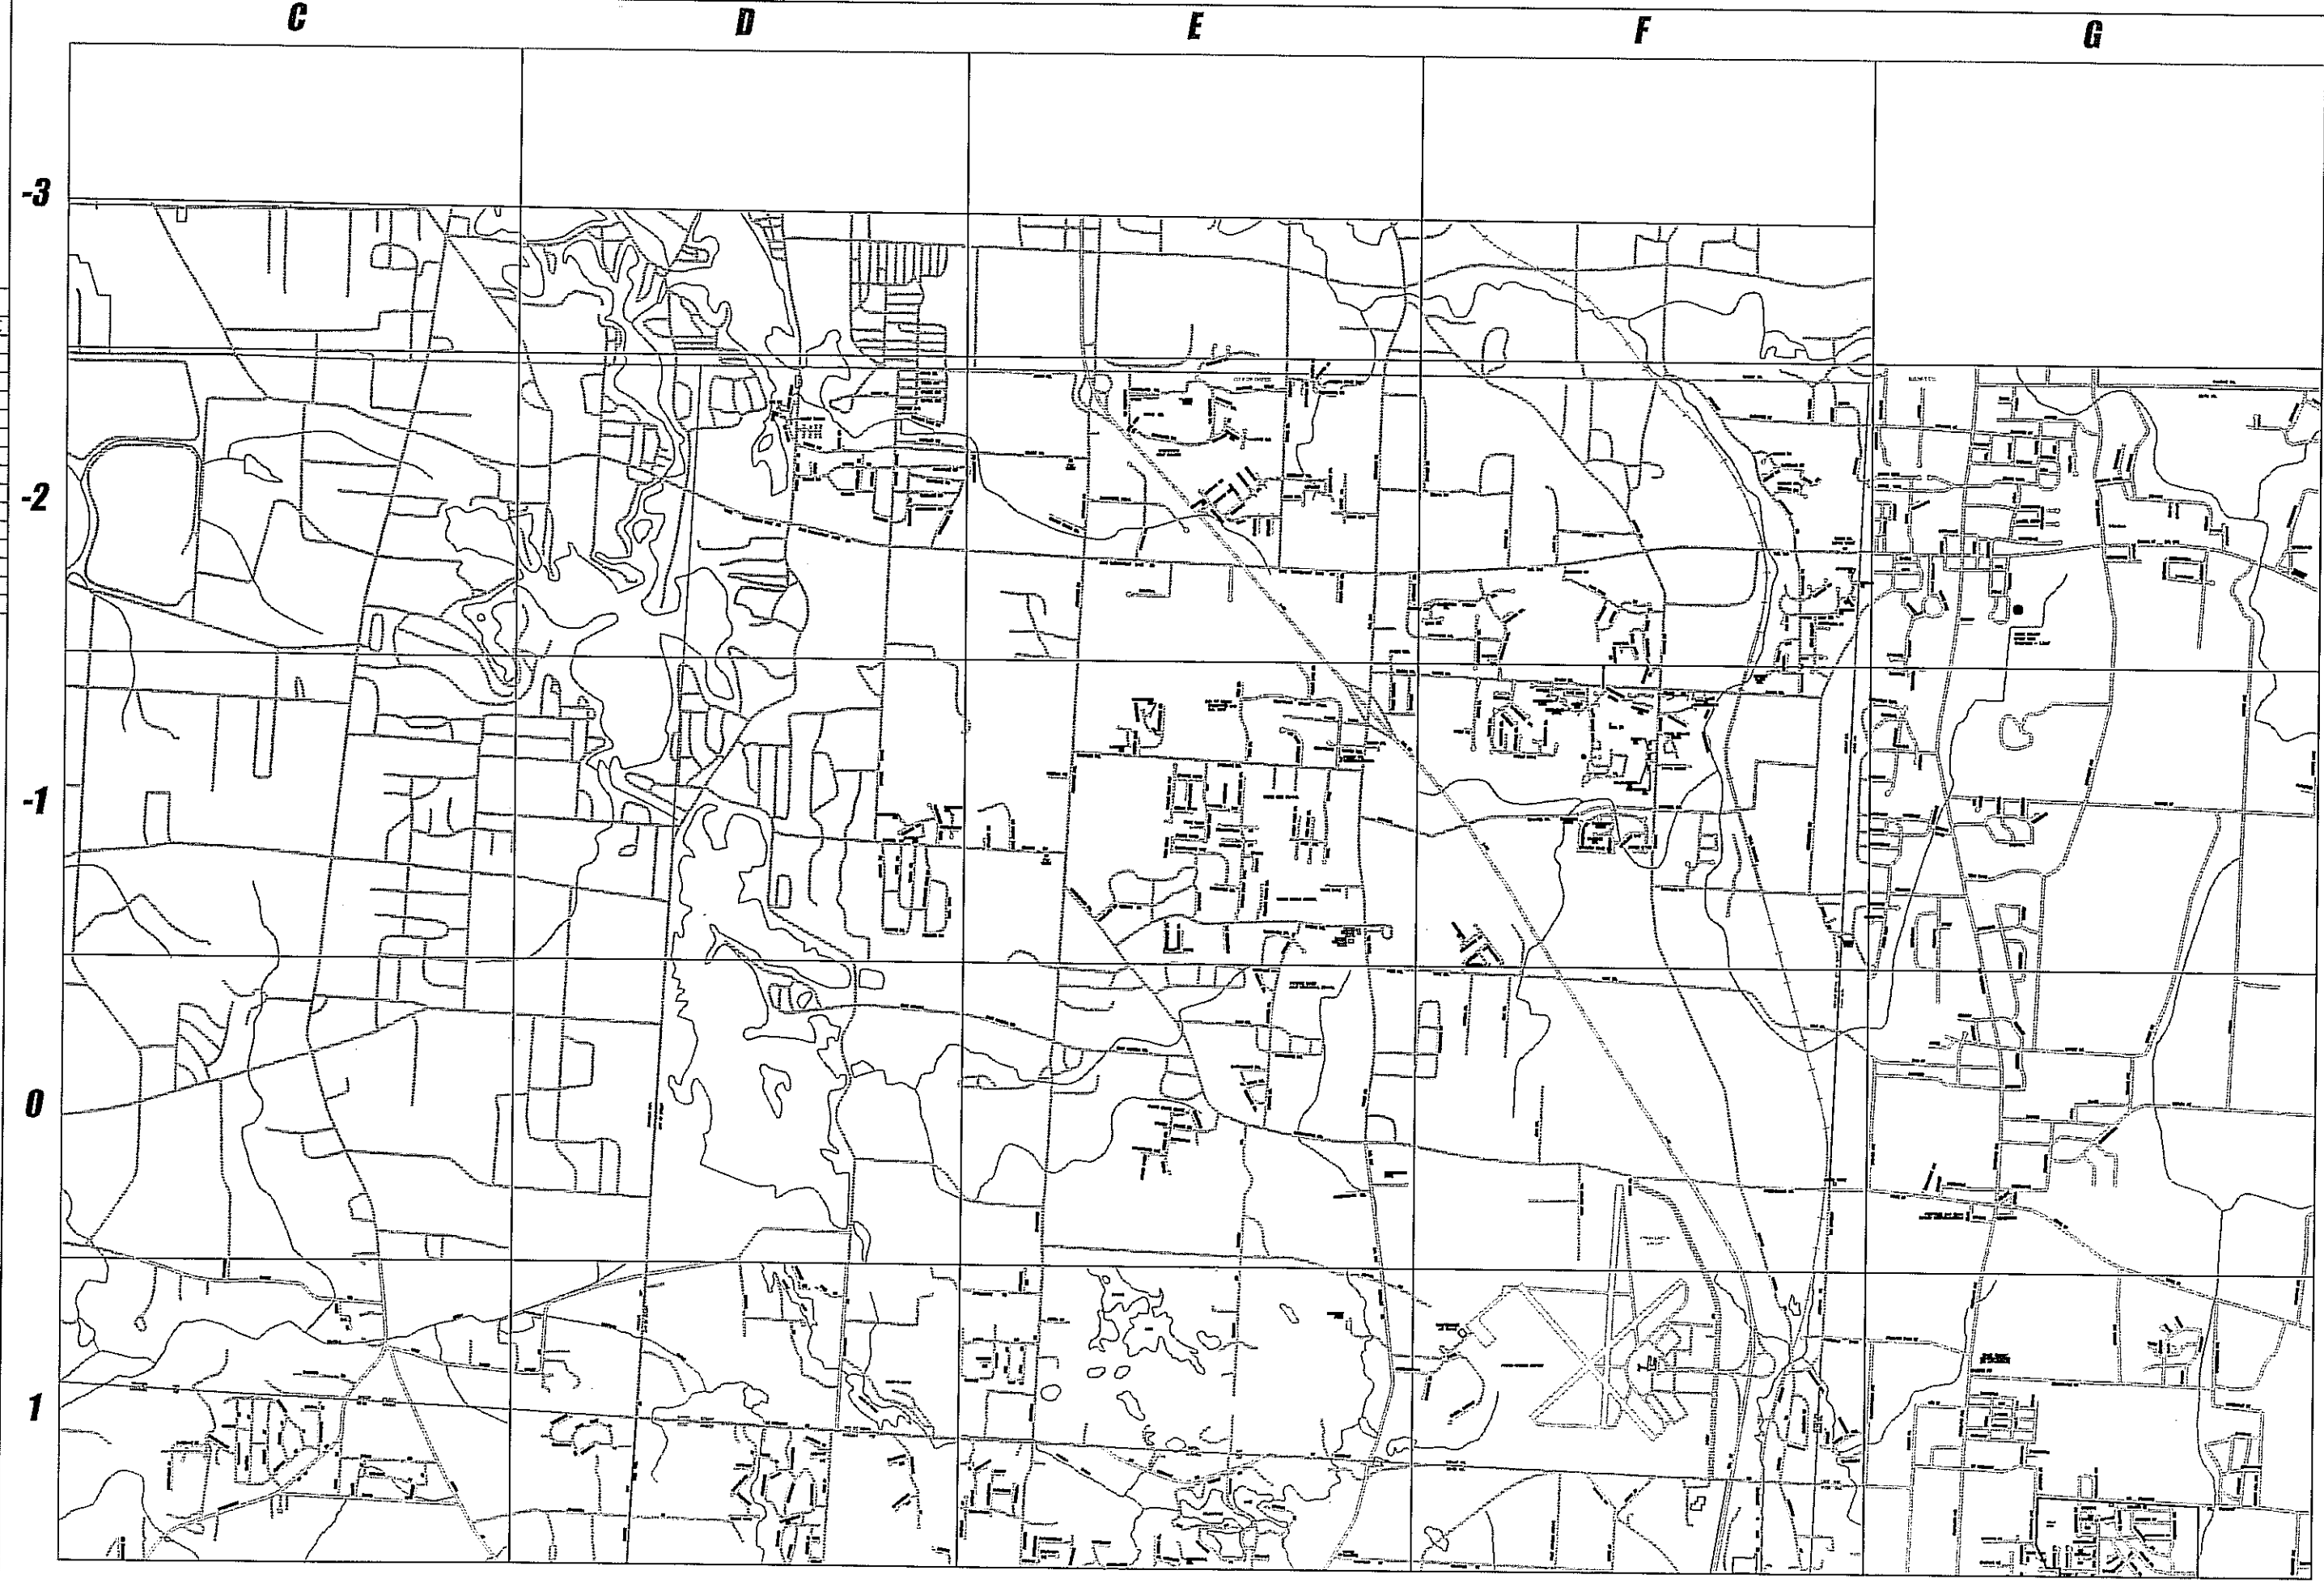


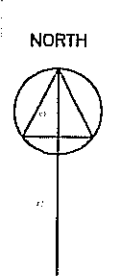

UPDATED	
BY	DATE
L.A.M.	1-04
L.A.M.	2-05

LINE LEGEND	
" & SMALLER	
4"	
6"	
8"	
10" & 12"	
14" & 16"	
18" & 20"	
24"	
30"	
36"	

PRIVATE	
---------	--

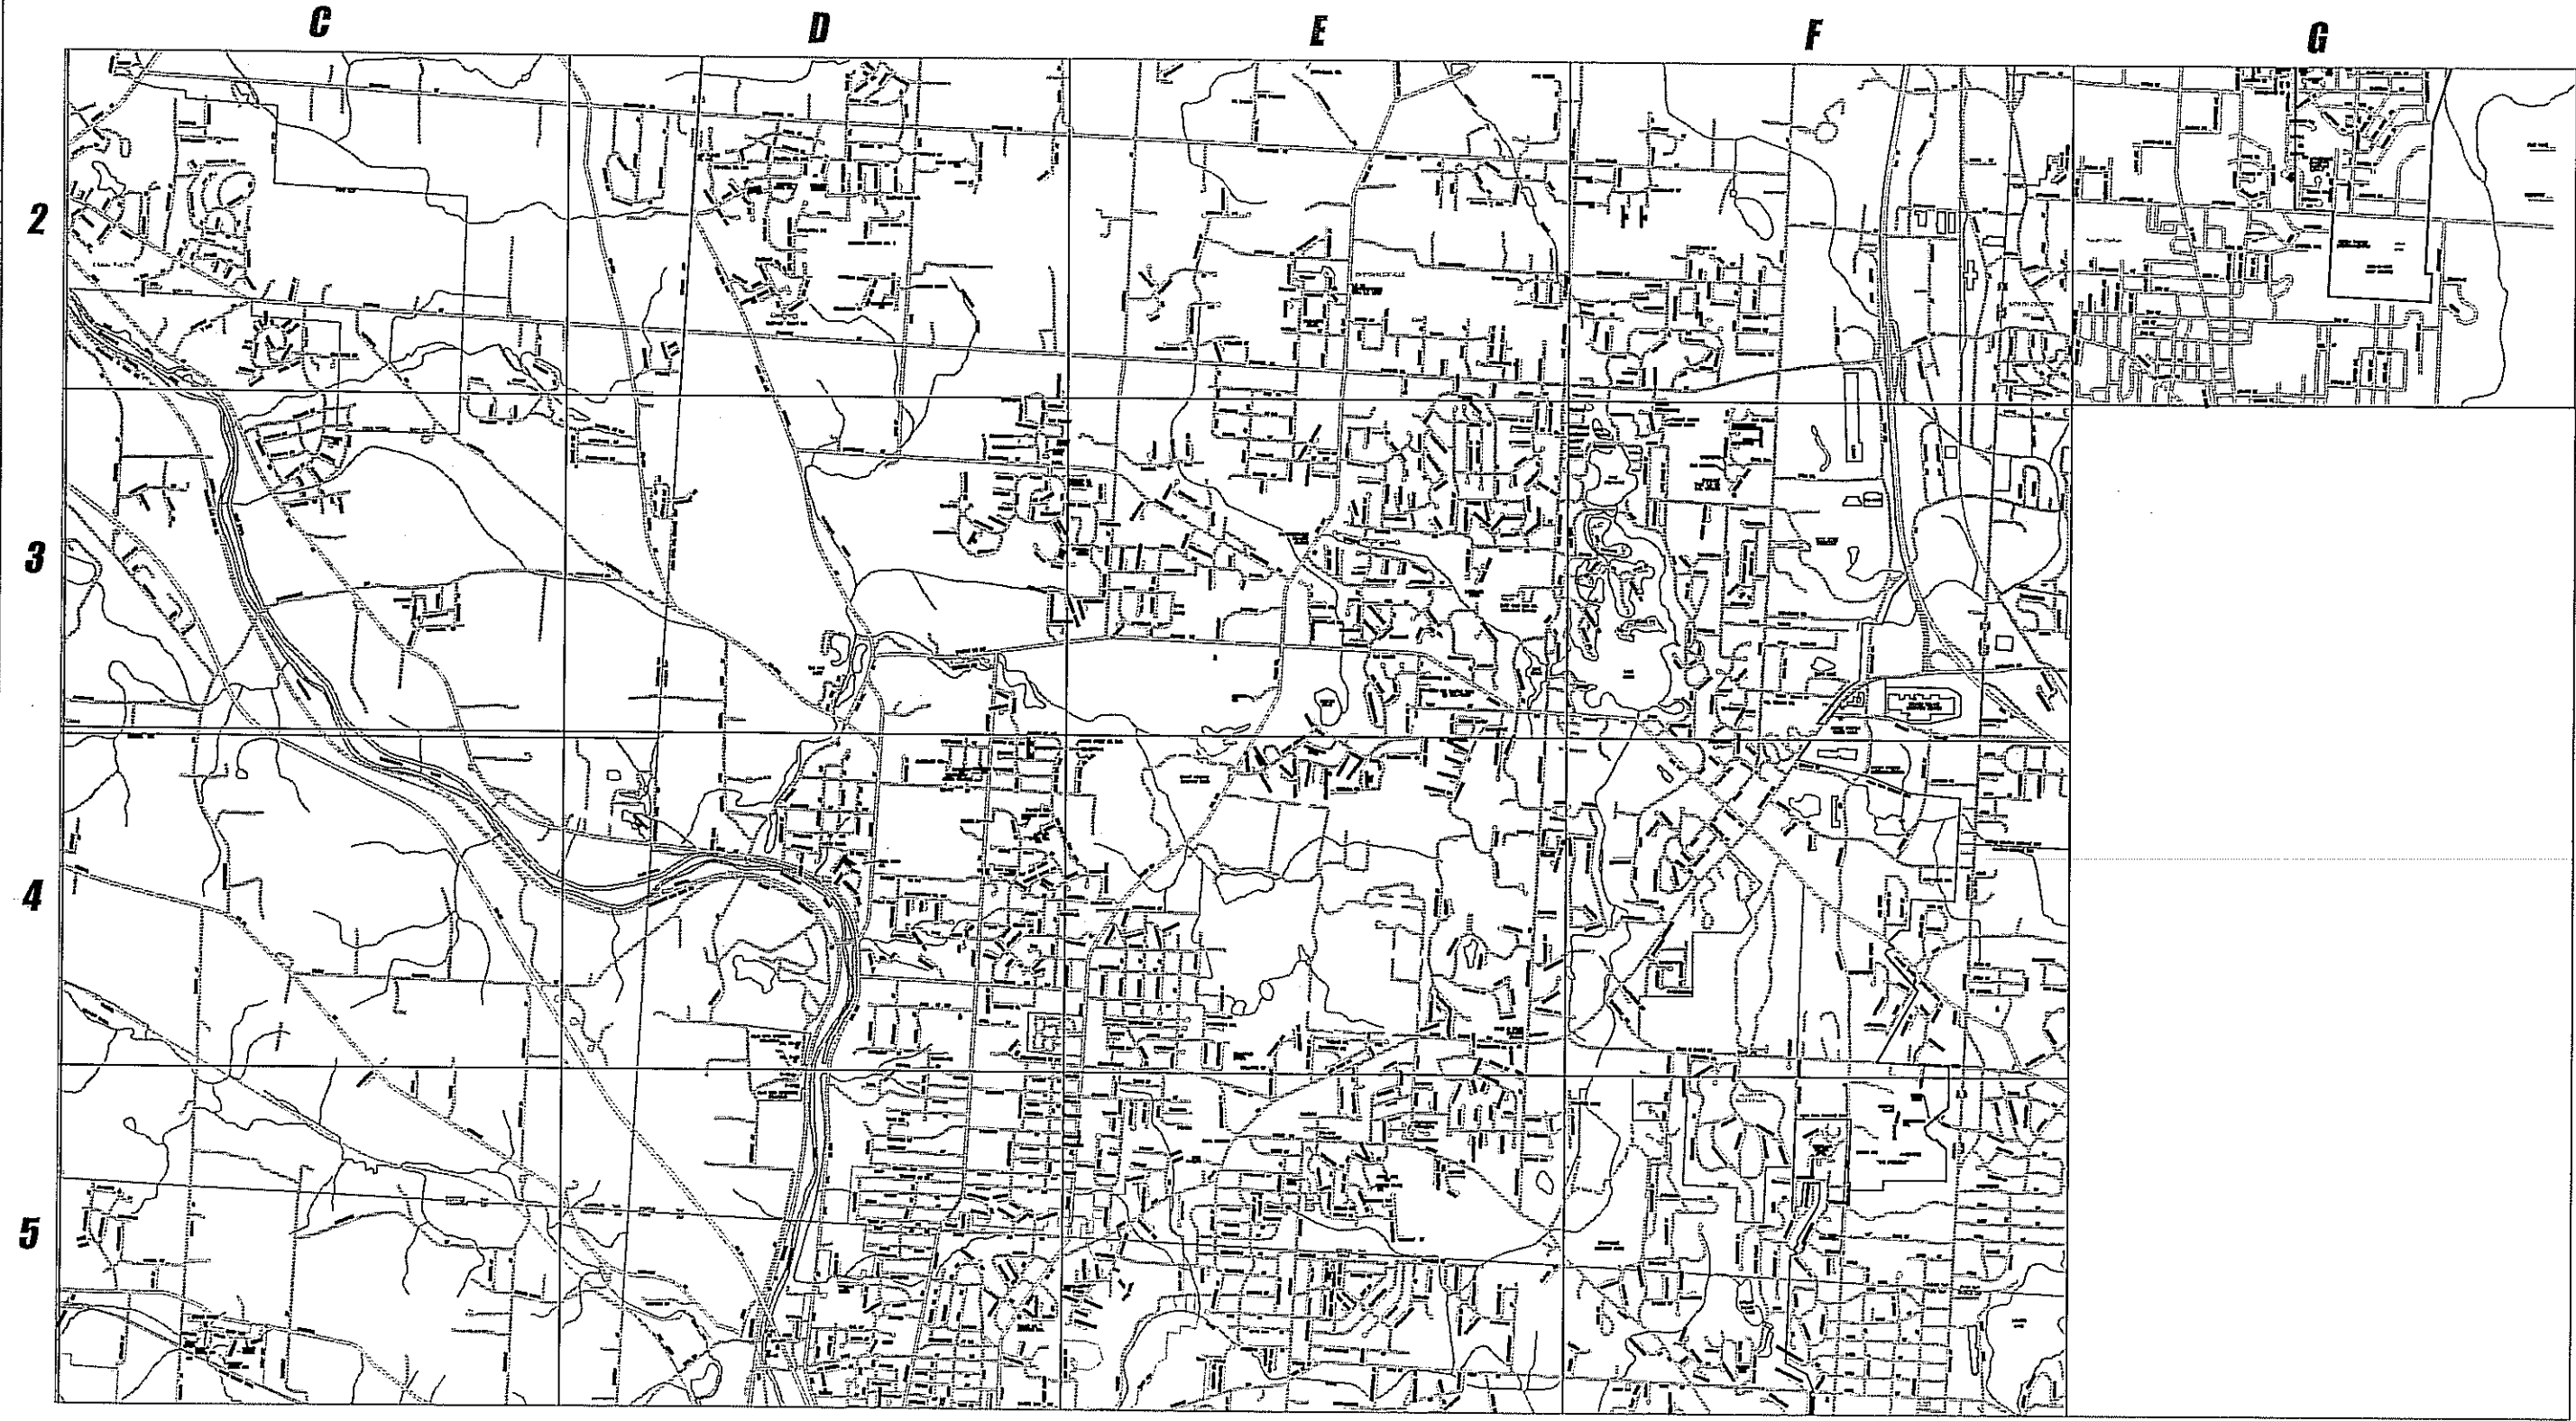

DRAWN <i>Doug Warrick</i>	DATE <i>May, 1997</i>
CHECKED	DATE
APPROVED	DATE

AQUA
Ohio.


PREPARED BY:
SERVICE CENTER-ENGINEERING DEPT.
5650 SOUTH AVE. BOARDMAN OHIO 44512



FILE NO.

NORTH INDEX MAP
STARK REGIONAL DIVISION

SHEET NO.
3

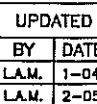[illegible]

NE LEGEND

4"

6"

8"

10" & 12"

14" & 16"


18" & 20"

24"

30"

36"

PRIVATE

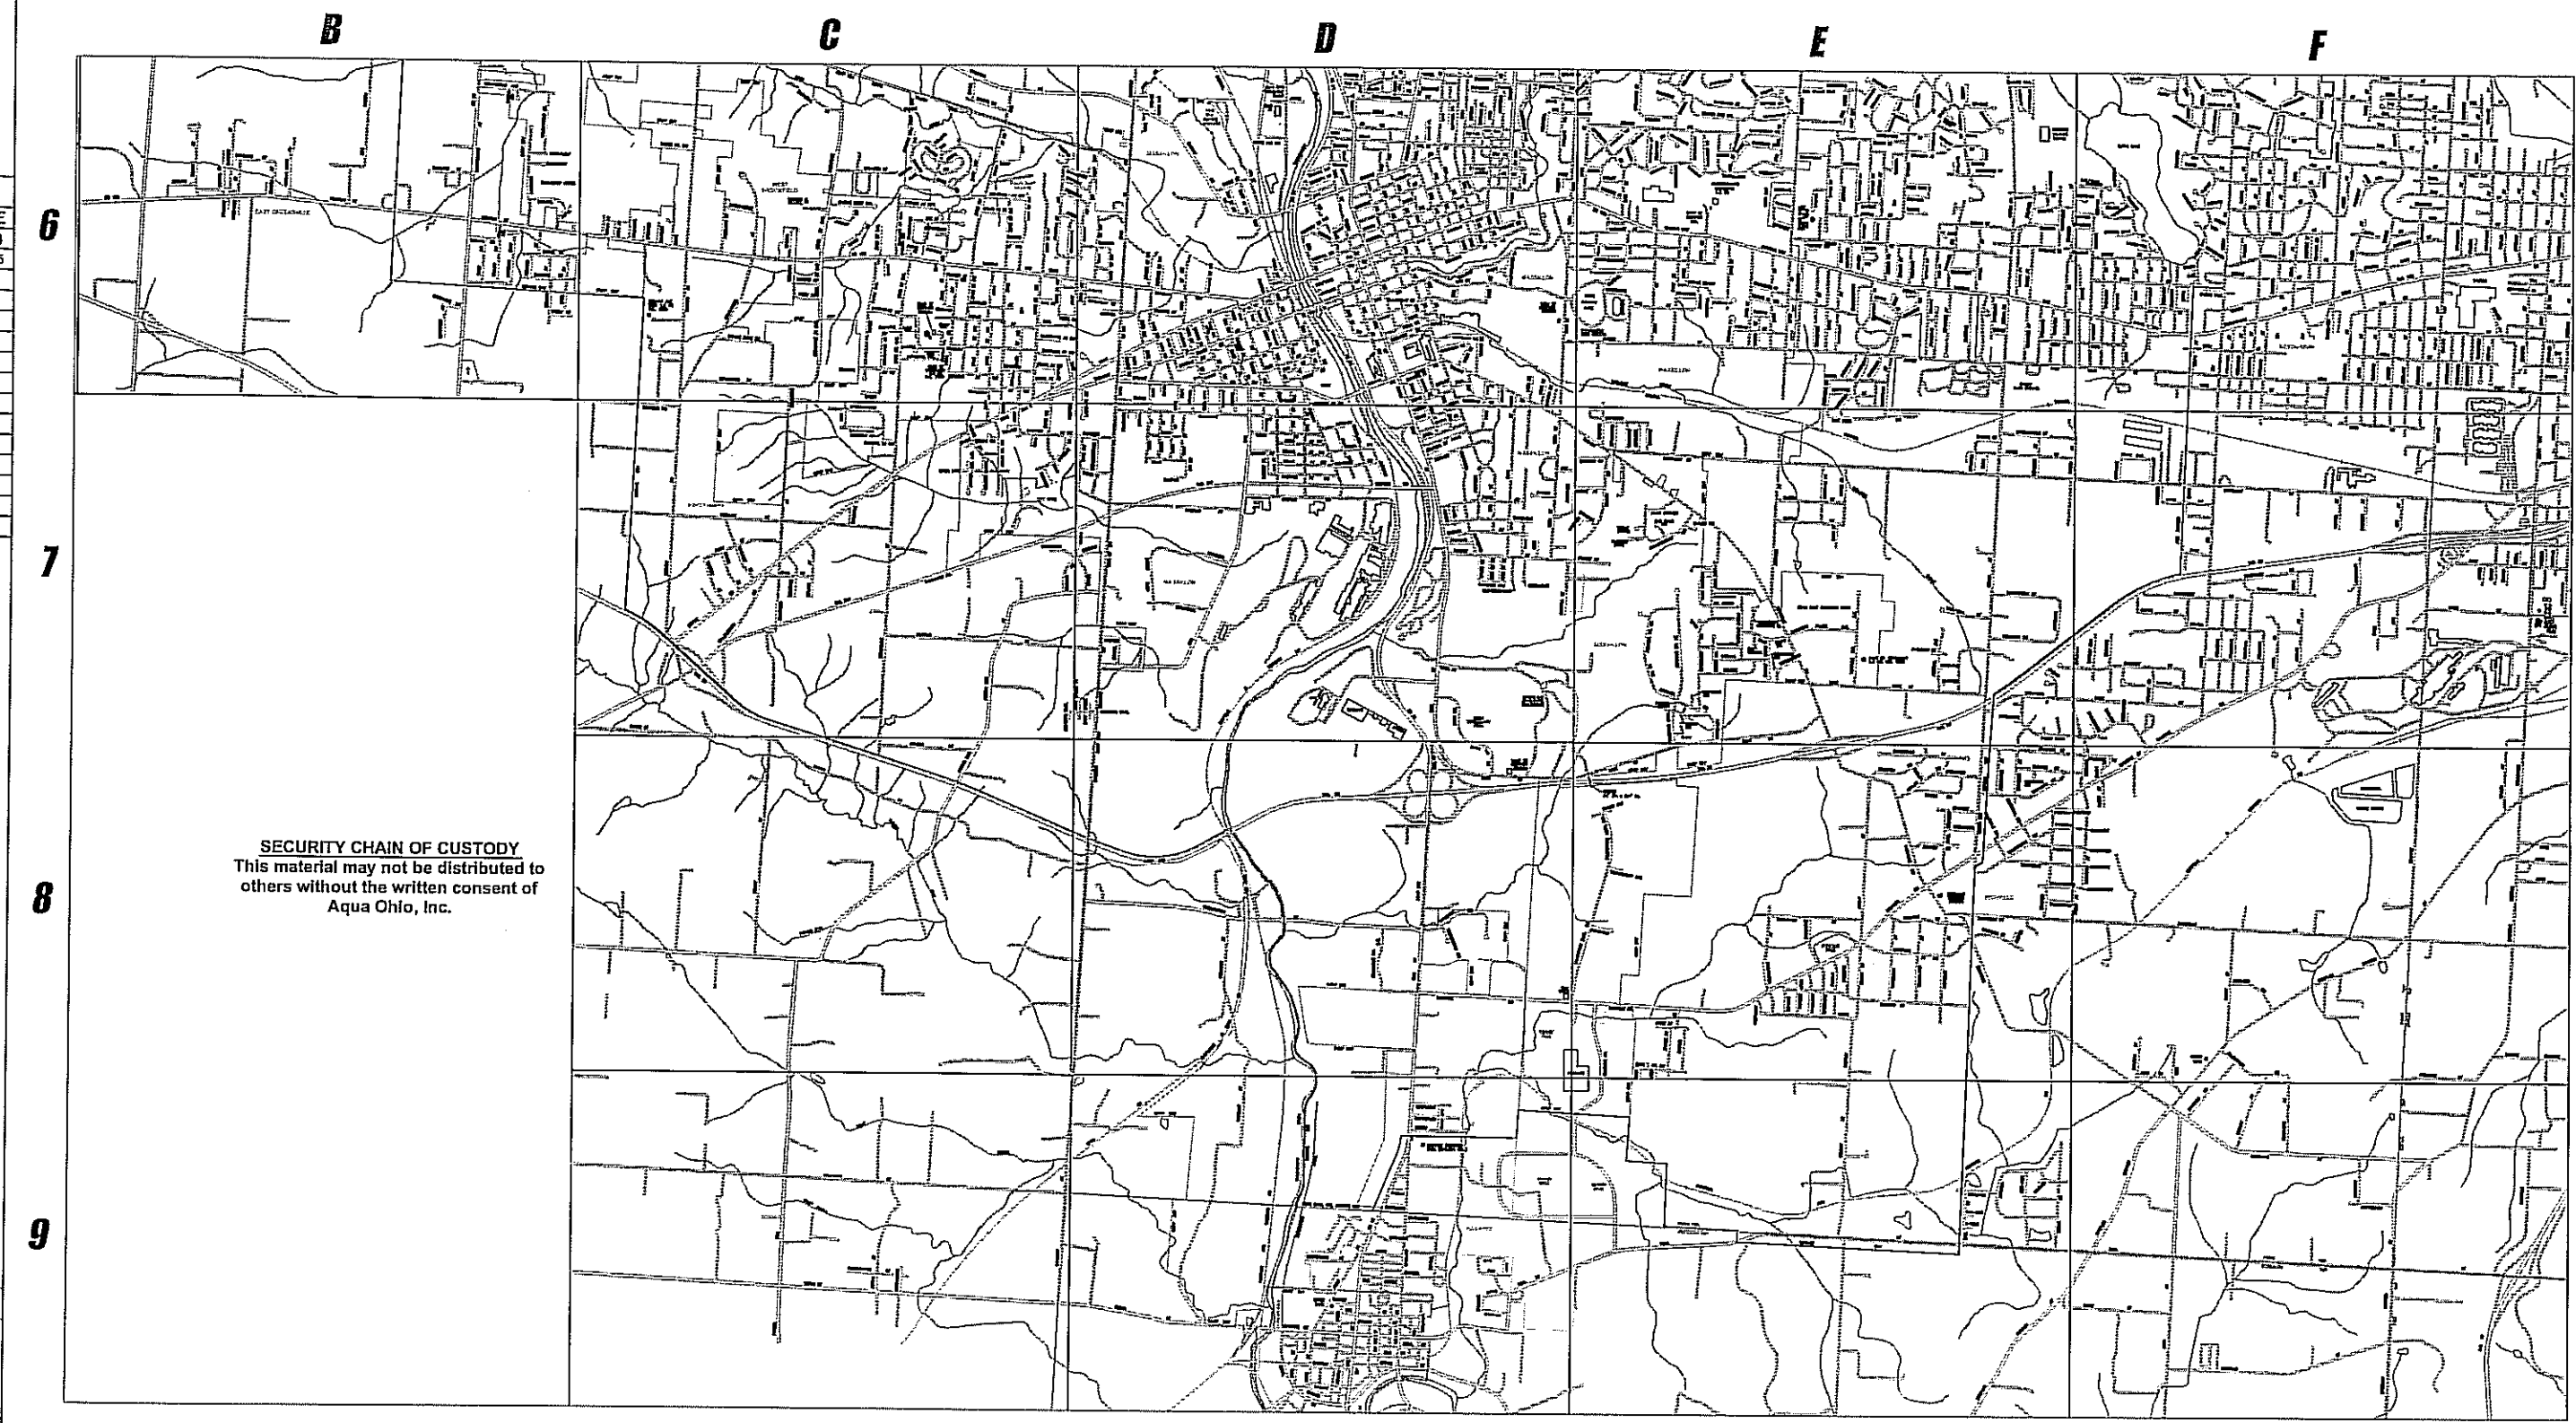

SECURITY CHAIN OF CUSTODY
This material may not be distributed to
others without the written consent of
Aqua Ohio, Inc.

AQUA
Ohio.

PREPARED BY:
SERVICE CENTER-ENGINEERING DEPT.
6650 SOUTH AVE. BOARDMAN OHIO 44512

SCALE




1000' 2000' 4000' 8000'

FILE NO.

SOUTH INDEX MAP
STARK REGIONAL DIVISION


SHEET NO.
4

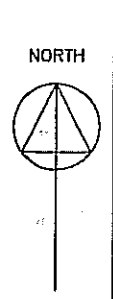

UPDATED	
BY	DATE
L.A.M.	1-04
L.A.M.	2-05

LINE LEGEND	
" & SMALLER	
4"	
6"	
8"	
10" & 12"	
14" & 16"	
18" & 20"	
24"	
30"	
36"	


PRIVATE	
---------	--

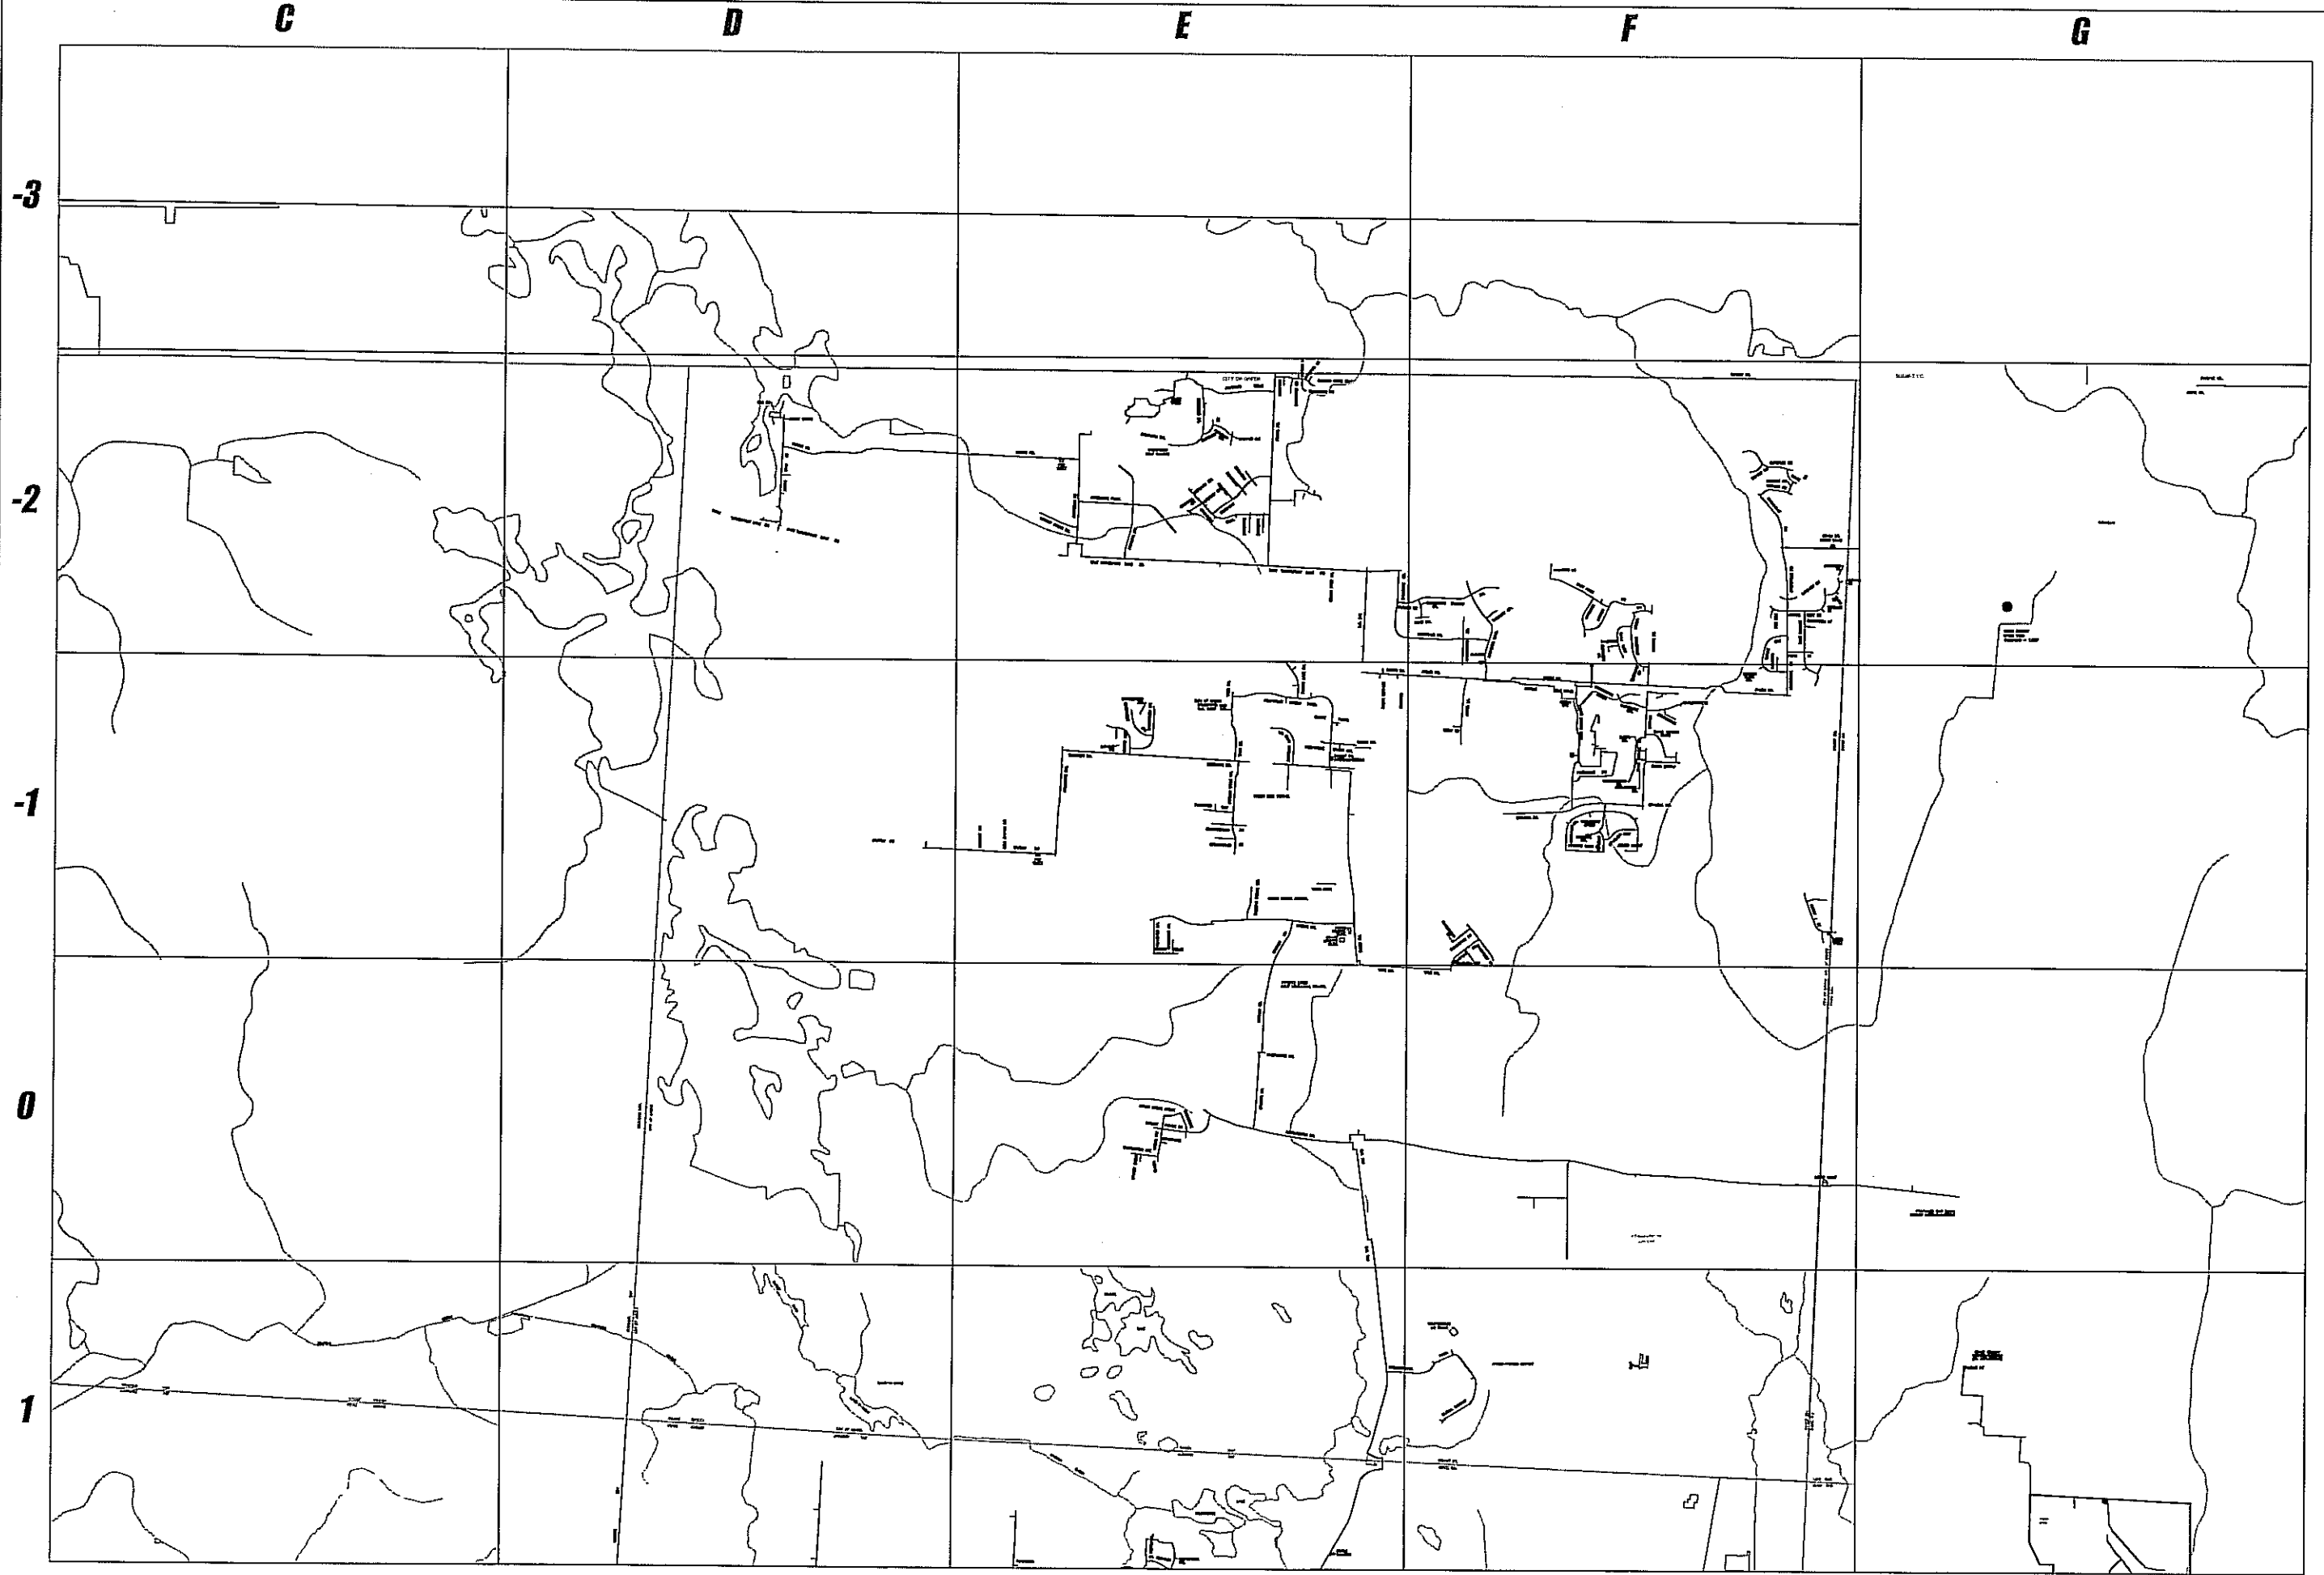

DRAWN <i>Doug Warrick</i>	DATE <i>May, 1991</i>
CHECKED	DATE
APPROVED	DATE

AQUA
Ohio.


PREPARED BY:
SERVICE CENTER—ENGINEERING DEPT.
6650 SOUTH AVE. BOARDMAN OHIO 44512

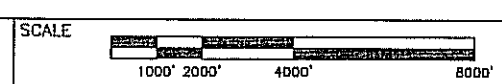

FILE NO.

COMPREHENSIVE MAP for GREEN
STARK REGIONAL DIVISION

SHEET NO.
5

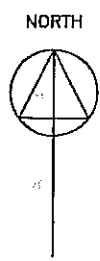

UPDATED
BY DATE
L.A.M. 1-04
L.A.M. 2-05

LINE LEGEND
4" & SMALLER
4"
6"
8"
10" & 12"
14" & 16"
18" & 20"
24"
30"
36"

PRIVATE

DRAWN	Doug Warrick	DATE	May, 1991
CHECKED		DATE	
APPROVED		DATE	

AQUA
Ohio.


PREPARED BY:
SERVICE CENTER-ENGINEERING DEPT.
6550 SOUTH AVE. BOARDMAN OHIO 44512


SCALE
1000' 2000' 4000' 8000'

FILE NO.

NORTH COMPREHENSIVE MAP
STARK REGIONAL DIVISION

SHEET NO.
6

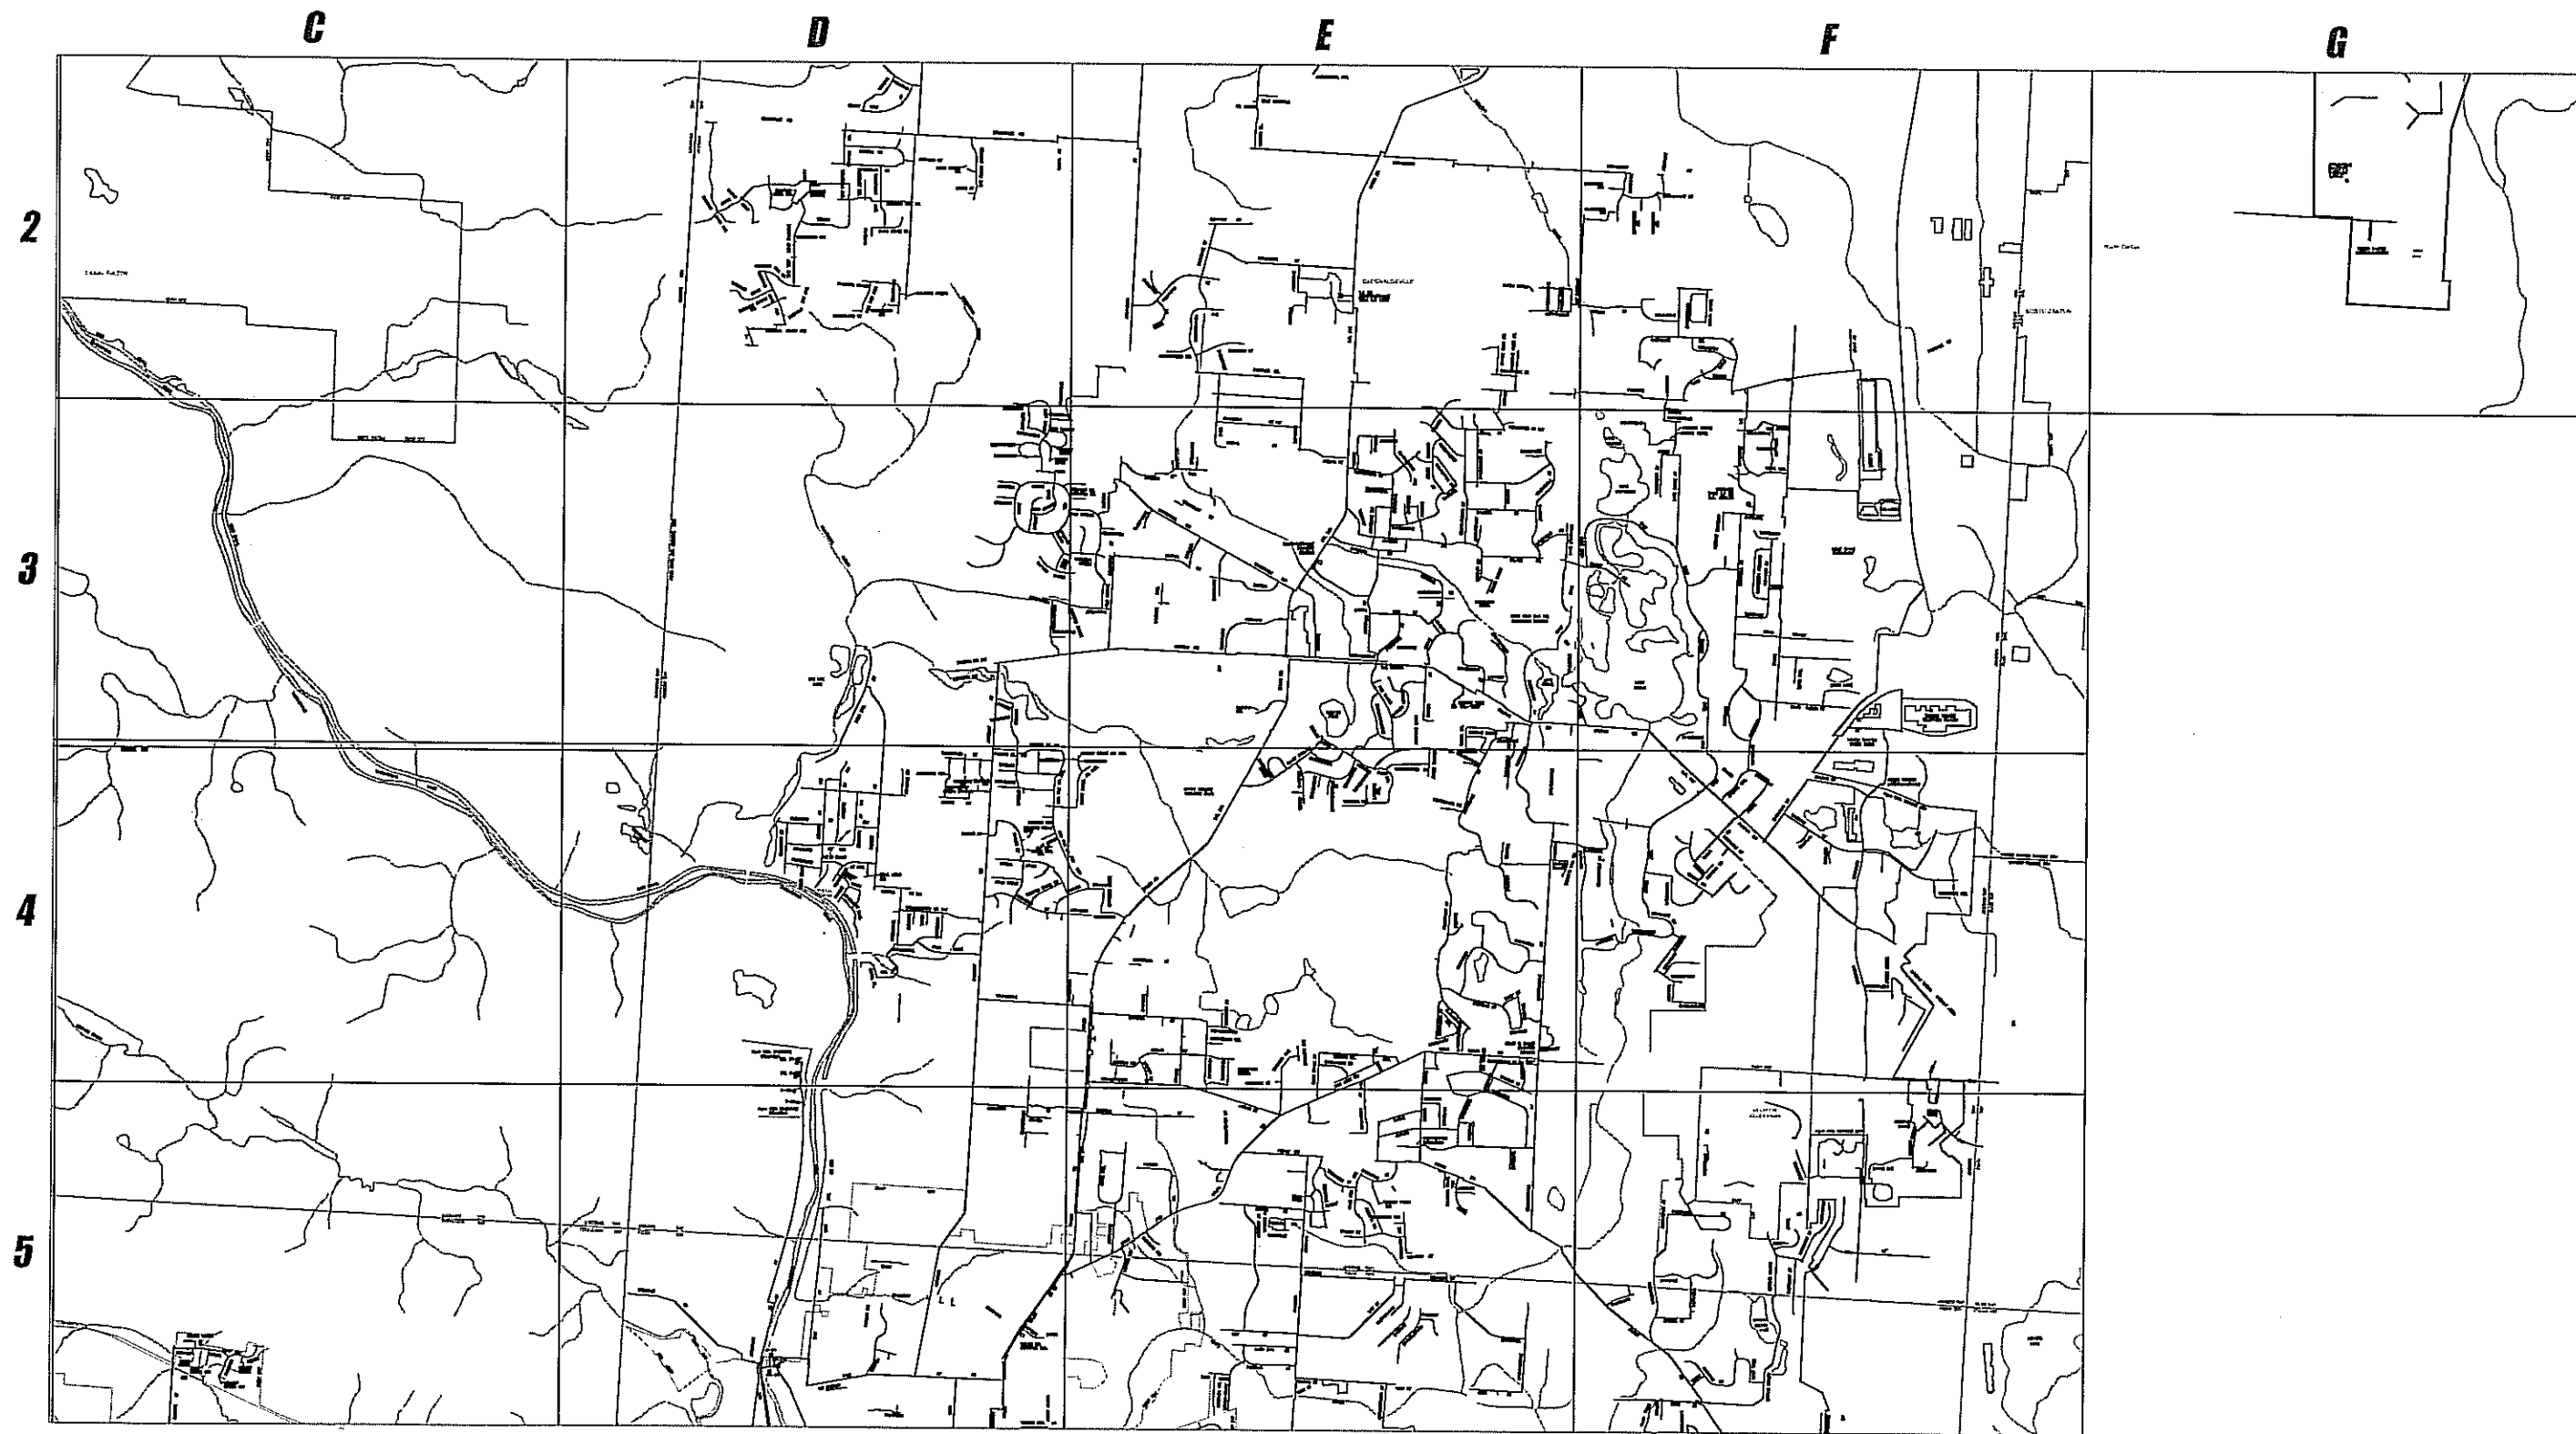

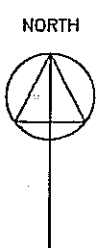

UPDATED	
BY	DATE
J.A.M.	1-04
J.A.M.	2-05


NE LEGEND	
& SMALLER	
4"	
6"	
8"	
10" & 12"	
14" & 16"	
18" & 20"	
24"	
30"	
36"	

PRIVATE

DRAWN	<i>Doug Warrick</i>	DATE	<i>May, 1997</i>
CHECKED		DATE	
APPROVED		DATE	

AQUA
Ohio.


PREPARED BY:
SERVICE CENTER-ENGINEERING DEPT.
5550 SOUTH AVE. BOARDMAN OHIO 44512

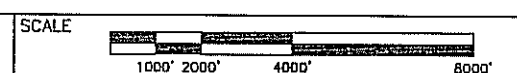


FILE NO.

SOUTH COMPREHENSIVE MAP
STARK REGIONAL DIVISION

SHEET NO.
7

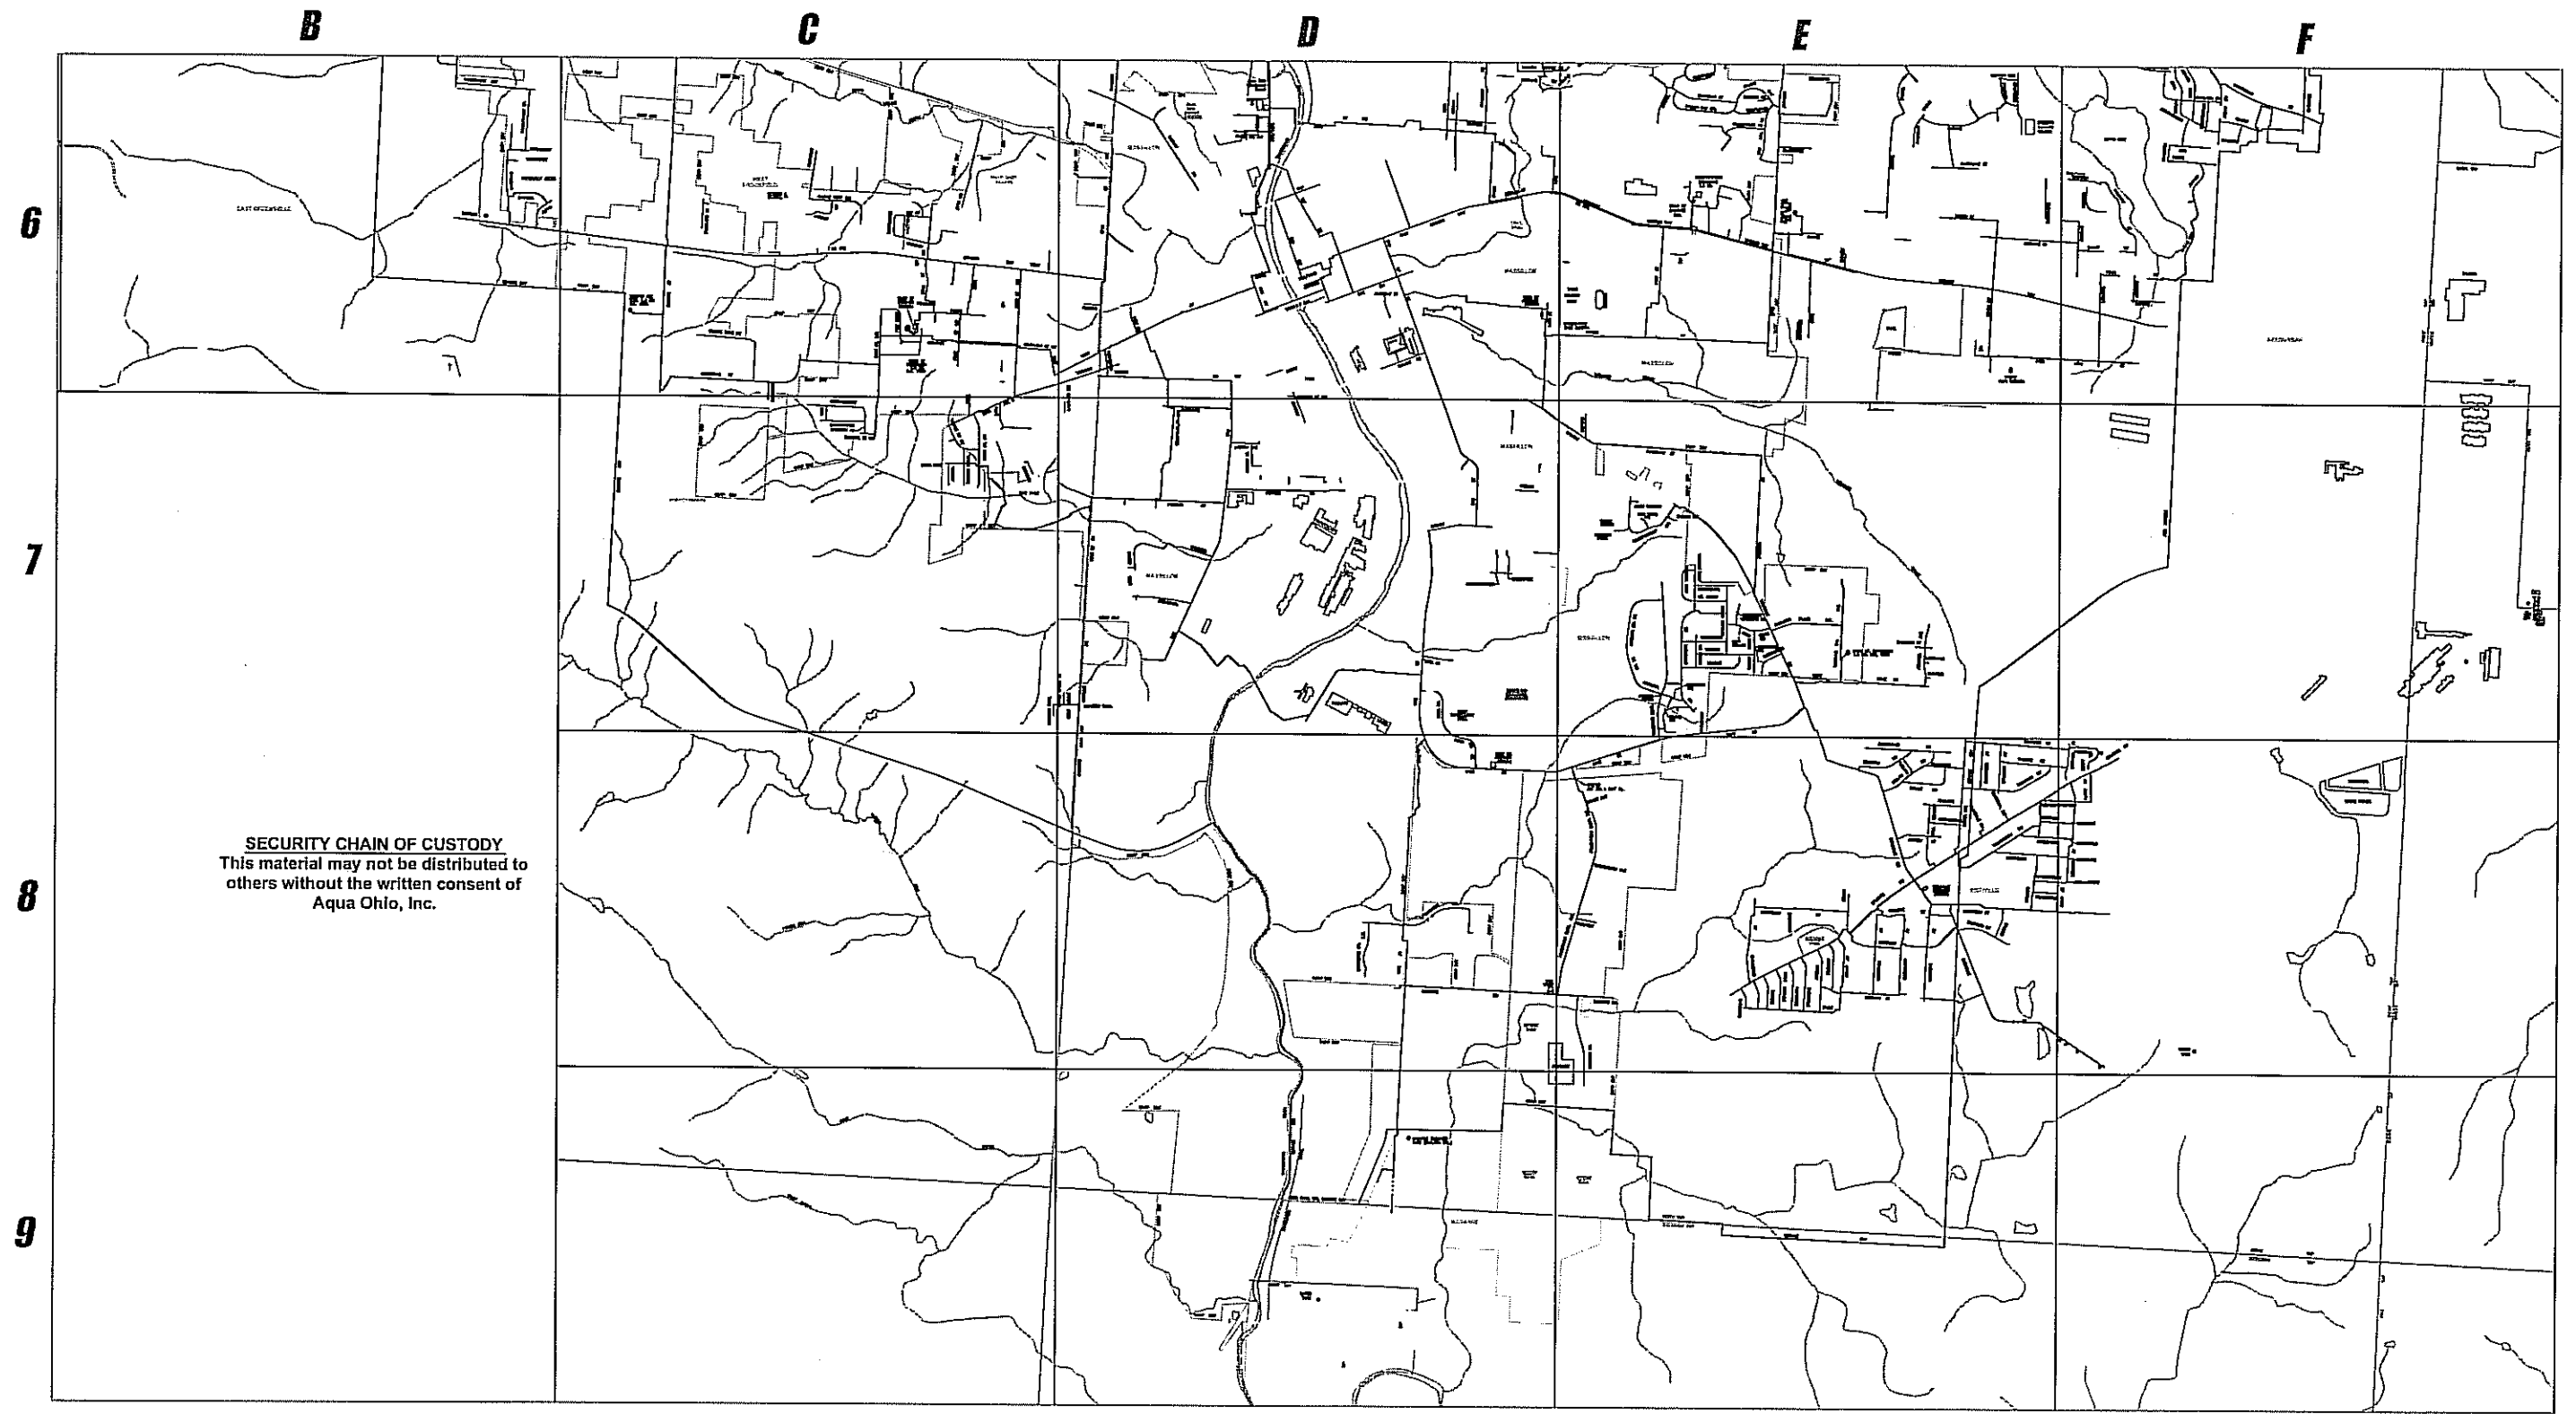

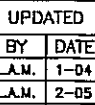

UPDATED	
BY	DATE
A.M.	1-04
A.M.	2-05

[illegible][illegible]

PIPE LEGEND	
& SMALLER	
4"	
6"	
8"	
10" & 12"	
14" & 16"	
18" & 20"	
24"	
30"	
36"	

PRIVATE

PREPARED BY:
SERVICE CENTER-ENGINEERING DEPT.
6650 SOUTH AVE. BOARDMAN OHIO 44512

SCALE

200' 400' 800' 1600'

FILE NO.

DISTRIBUTION MATCHLINE MAP
STARK REGIONAL DIVISION

SHEET NO.
A 3



SEE SHEET AT

DALTON

FOX

LAKE

RD

CHURCH

WEST

LEBANON

RD

RD

3000

15000

CO

CO

KRUG

RD

19200

WAYNE

STARK

CAMPGROUNDS

TRAIL

CORP BDY

SEE SHEET B5

LINE	LEGEND
3" & SMALLER	
4"	
6"	
8"	
10" & 12"	
14" & 16"	
18" & 20"	
24"	
30"	
36"	


DRAWN <i>Doug Warrick</i>	DATE <i>May, 1991</i>
CHECKED	DATE
APPROVED	DATE

PREPARED BY:
SERVICE CENTER - ENGINEERING DEPT.
6650 SOUTH AVE. BOARDMAN OHIO 44612

FILE NO.	
----------	--

SHEET NO.
A5

NORTH

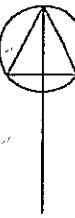

UPDATED	
BY	DATE
L.A.M.	1-04
L.A.M.	2-05

LINE LEGEND
3" & SMALLER
4"
6"
8"
10" & 12"
14" & 16"
18" & 20"
24"
30"
36"

DRAWN <i>Doug Warrick</i>	DATE <i>May, 1991</i>
CHECKED	DATE
APPROVED	DATE

AQUA
Ohio.

PREPARED BY:
SERVICE CENTER-ENGINEERING DEPT.
6650 SOUTH AVE. BOARDMAN OHIO 44512

SCALE




FILE NO.	
----------	--

DISTRIBUTION MATCHLINE MAP
STARK REGIONAL DIVISION

SHEET NO.
A6

9B
SEE SHEET 8B

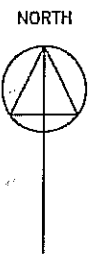

UPDATED	
BY	DATE
L.A.M.	1-04
L.A.M.	2-05

SEE SHEET A3



SEE SHEET C3


SEE SHEET B4

LINE LEGEND	
3" & SMALLER	
4"	
6"	
8"	
10" & 12"	
14" & 16"	
18" & 20"	
24"	
30"	
36"	

DRAWN	<i>Doug Warrick</i>	DATE	<i>May, 1997</i>
CHECKED		DATE	
APPROVED		DATE	

AQUA
Ohio.

PREPARED BY:
SERVICE CENTER-ENGINEERING DEPT.
6650 SOUTH AVE. BOARDMAN OHIO 44512

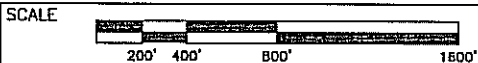

FILE NO.

DISTRIBUTION MATCHLINE MAP
STARK REGIONAL DIVISION

SHEET NO.
B3

SEE SHEET B5

DISTRIBUTION MATCHLINE MAP
STARK REGIONAL DIVISION

SEE SHEET C4.

SEE SHEET A4

NORTH LAWRENCE

YOUTH

NEWMAN CREEK
CEMETERY

דבר נוסף

1

~~CONFIDENTIAL~~

NEWMAN CREEK

5

12

5

ORVILLE

ALABAMA AV

71

EASTERN AV.

SECRET

WATERWAY AV

WATER

PENFORD ST

CHURCH	FIELD	ST
--------	-------	----

CENMONT ST

LAWMONT ST

GRIFFITH CIR

MERRY S

PENBROOK AV

KATIE
ST

SCALE

FILE NO.	
----------	--


AQUA
Ohio.

PREPARED BY:
SERVICE CENTER-ENGINEERING DEPT.
6650 SOUTH AVE. BOARDMAN OHIO 44512

DRAWN <i>Doug Warrick</i>	DATE <i>May, 1991</i>
CHECKED	DATE
APPROVED	DATE

LINE LEGEND
3" & SMALLER
4"
6"
8"
10" & 12"
14" & 16"
18" & 20"
24"
30"
36"

[illegible]

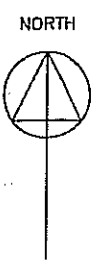


SEE SHEET B4

UPDATED	
BY	DATE
L.A.M.	1-04
L.A.M.	2-05

LINE LEGEND	
3" & SMALLER	
4"	
6"	
8"	
10" & 12"	
14" & 16"	
18" & 20"	
24"	
30"	
36"	
PRIVATE	

SEE SHEET A5

SEE SHEET C5

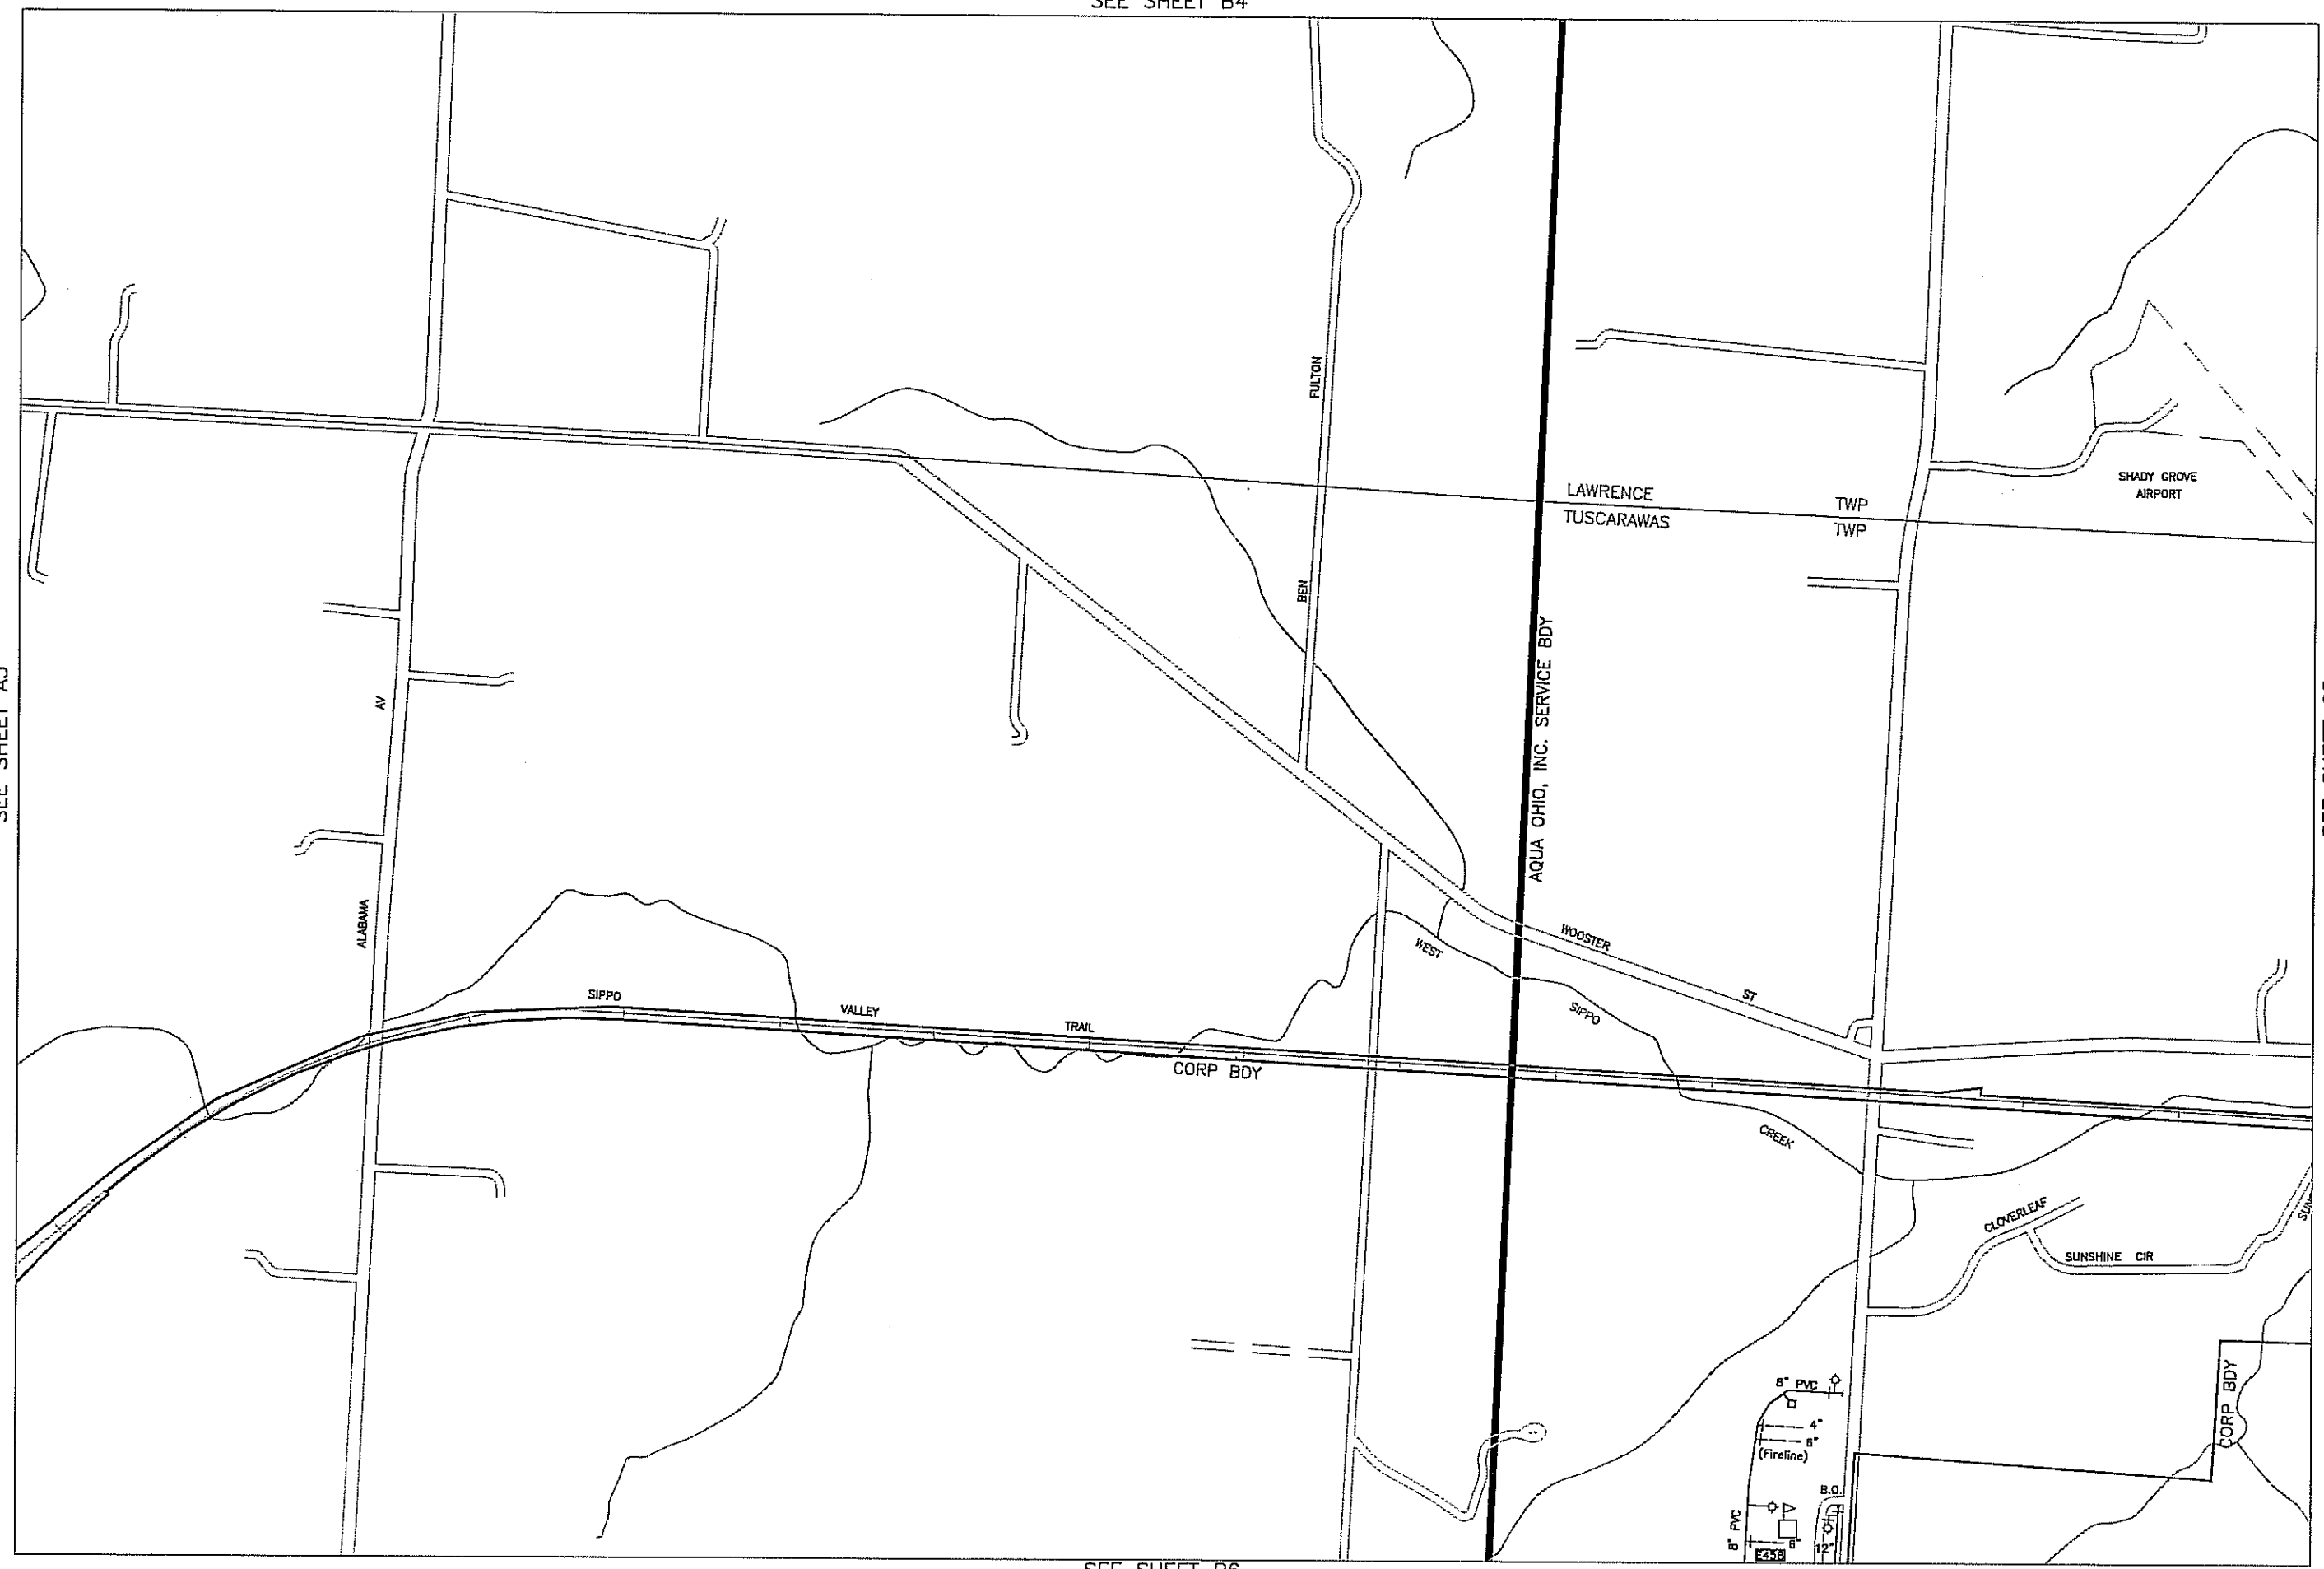

SEE SHEET B6

DRAWN	<i>Doug Warrick</i>	DATE	<i>May, 1997</i>
CHECKED		DATE	
APPROVED		DATE	

AQUA
Ohio.

PREPARED BY:
SERVICE CENTER-ENGINEERING DEPT.
5650 SOUTH AVE. BOARDMAN OHIO 44512




FILE NO.

DISTRIBUTION MATCHLINE MAP
STARK REGIONAL DIVISION

SHEET NO.
B5

LINE LEGEND	
3" & SMALLER	
4"	
6"	
8"	
10" & 12"	
14" & 16"	
18" & 20"	
24"	
30"	
36"	

SHEET NO.
B6

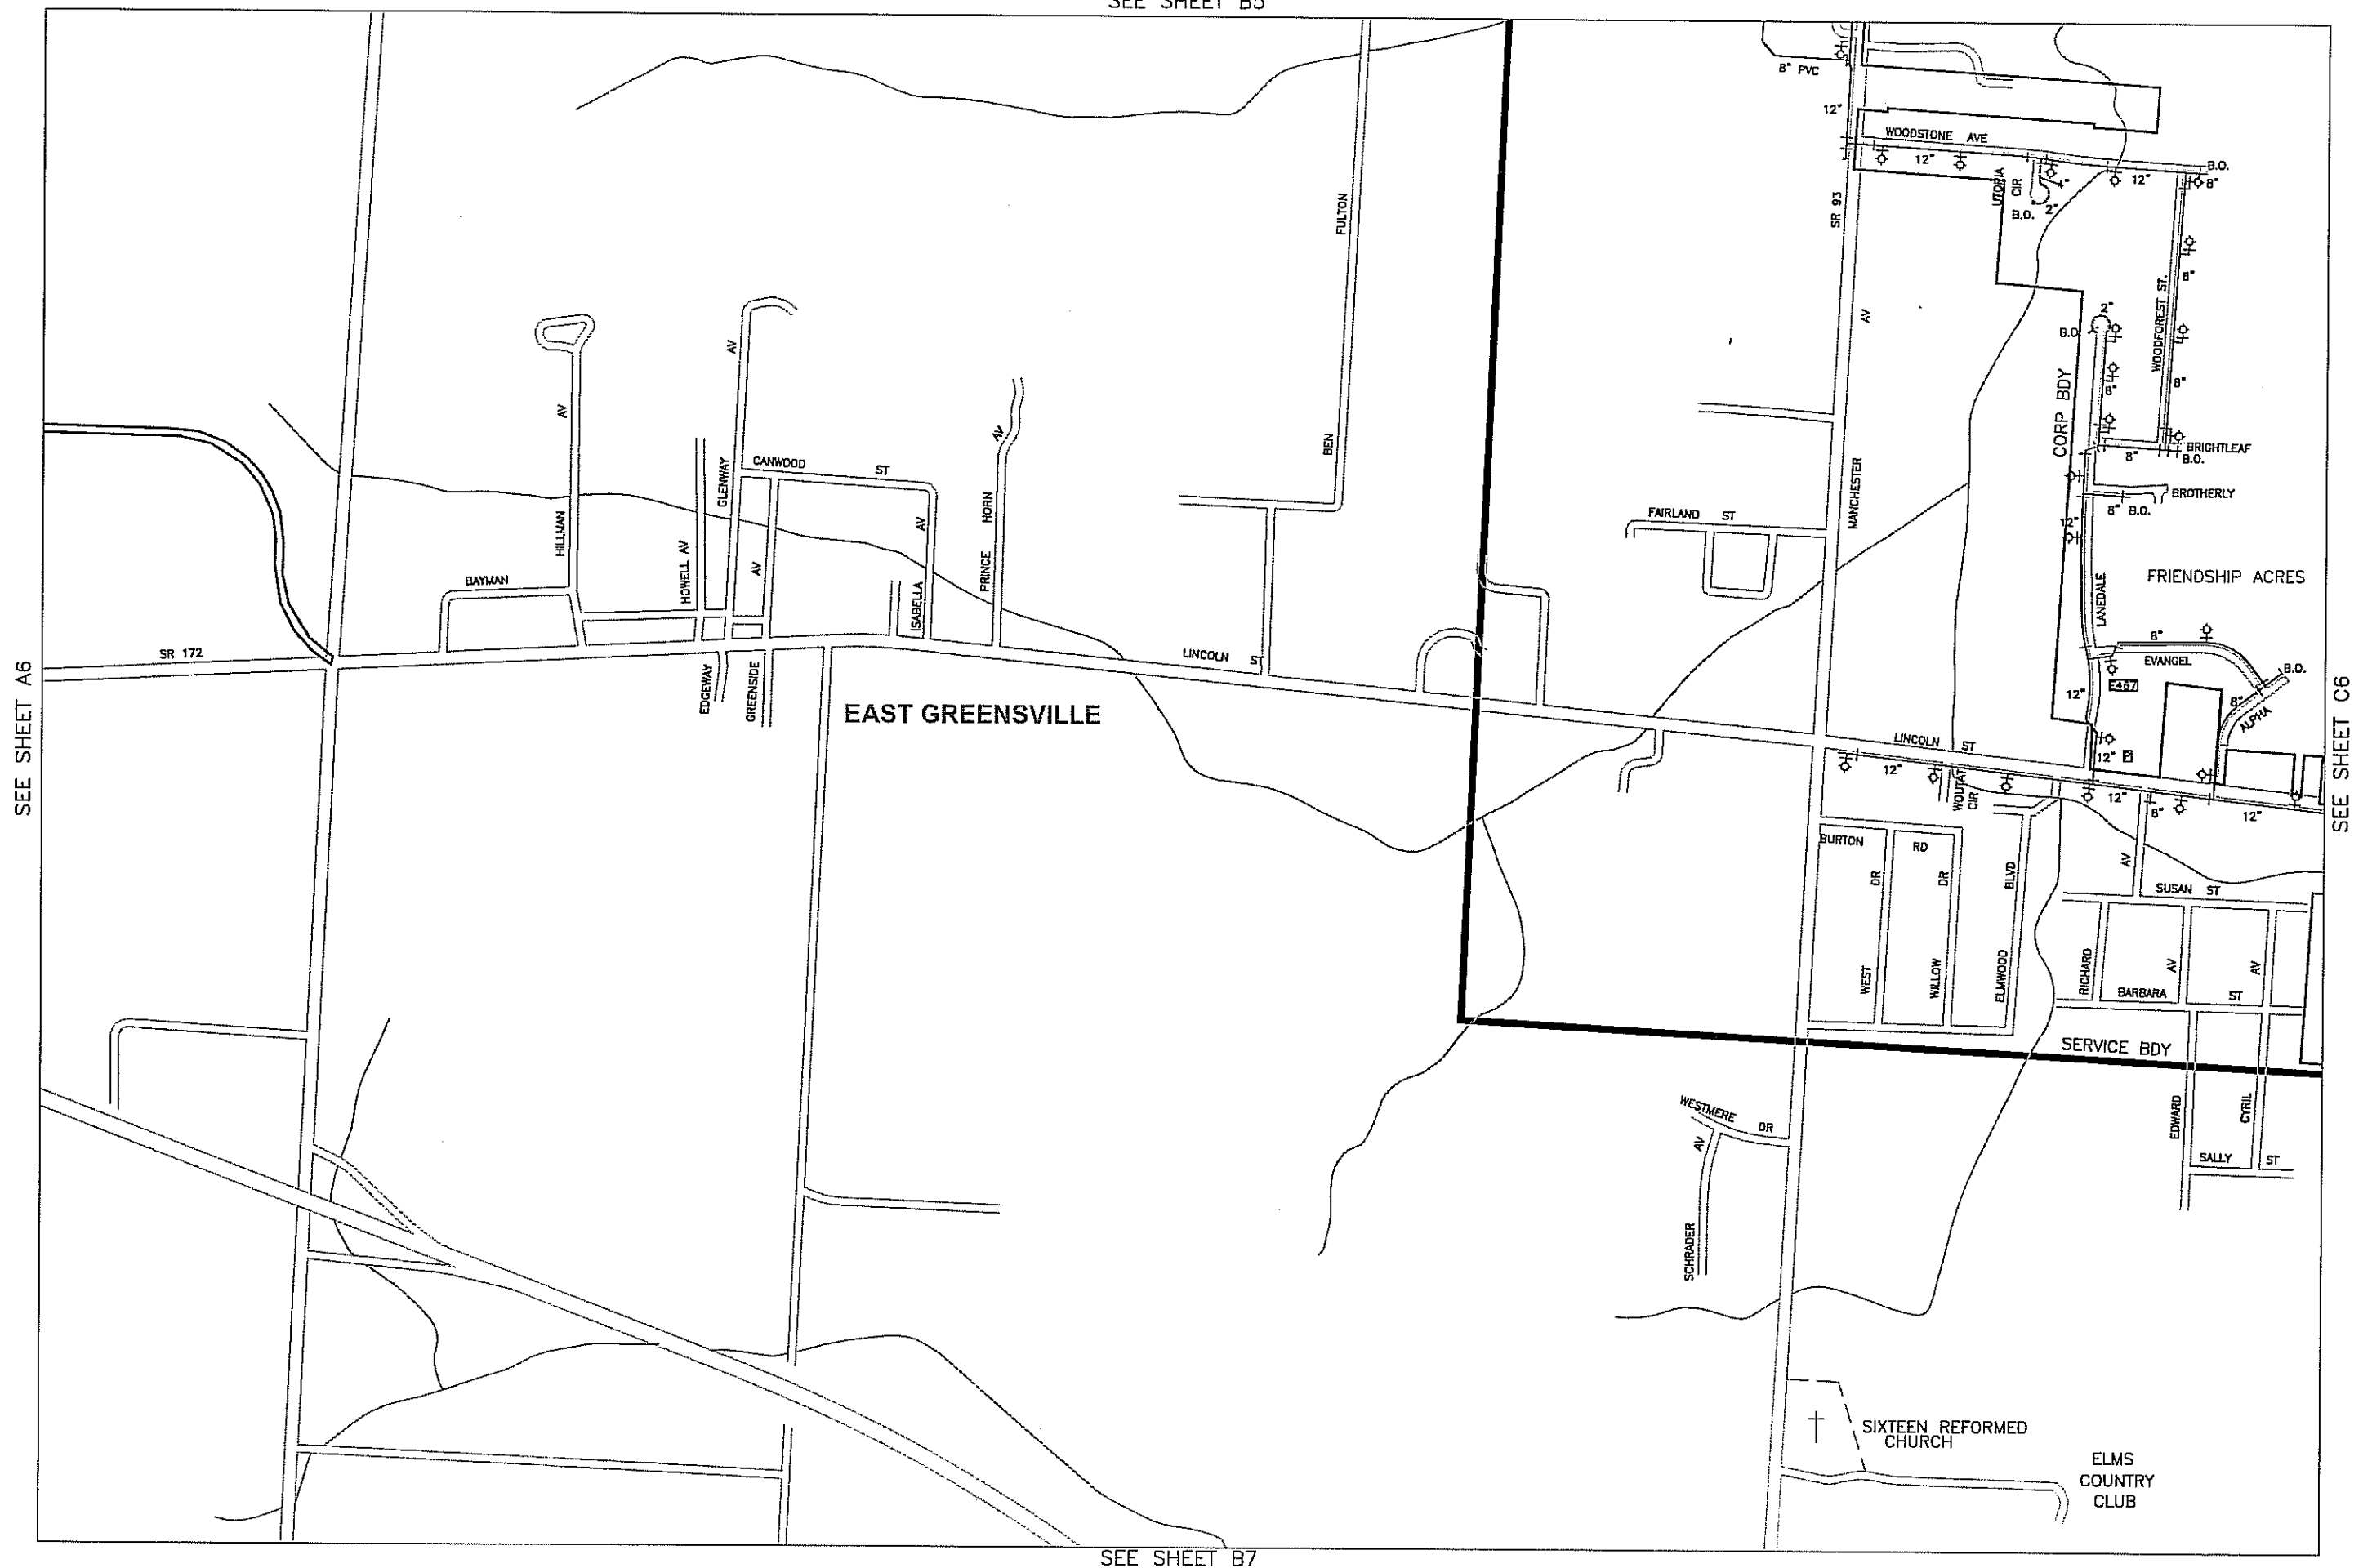

SEE SHEET D-2

DRAWN <i>Doug Warrick</i>	DATE <i>May, 1991</i>
CHECKED	DATE
APPROVED	DATE

AQUA
Ohio.

PREPARED BY:
SERVICE CENTER-ENGINEERING DEPT.
6650 SOUTH AVE. BOARDMAN OHIO 44512


Age Group	Percentage
200'	~15%
400'	~35%
800'	~45%
1500'	~5%

FILE NO.	
----------	--

DISTRIBUTION MATCHLINE MAP
STARK REGIONAL DIVISION

SHEET NO.
C-2

NORTH

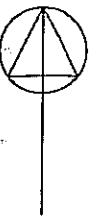

SEE SHEET C-2

UPDATED

BY DATE

L.A.M. 1-04

L.A.M. 2-05

LINE LEGEND

3" & SMALLER

4"

6"

8"

10" & 12"

14" & 16"

18" & 20"

24"

30"

36"

PRIVATE

DRAWN *Doug Warrick* DATE *May, 1991*

CHECKED DATE

APPROVED DATE

AQUA
Ohio.

PREPARED BY:
SERVICE CENTER - ENGINEERING DEPT.
6650 SOUTH AVE. BOARDMAN OHIO 44512

SCALE

200' 400' 600' 1600'

FILE NO.

DISTRIBUTION MATCHLINE MAP
STARK REGIONAL DIVISION

SHEET NO.
C-1

SEE SHEET D-1

SEE SHEET C-0

A detailed black and white map of a land parcel, identified as "SEE SHEET 6" at the top center. The map shows a complex network of lines representing property boundaries, roads, and possibly water features. The parcel is irregularly shaped, with several smaller, more regular shapes (possibly buildings or smaller lots) attached to its perimeter. The map is oriented horizontally, with the top edge of the sheet at the top of the image.

SEE SHEET C1

LINE LEGEND
3" & SMALLER
4"
6"
8"
10" & 12"
14" & 16"
18" & 20"
24"
30"
36"

SHEET NO.
CO

SEE SHEET C2

[illegible]


PRIVATE

PREPARED BY:
SERVICE CENTER-ENGINEERING DEPT.
5650 SOUTH AVE. BOARDMAN OHIO 44512

200' 400' 800' 1600'

SHEET NO.
C1

NORTH

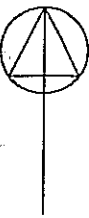

UPDATED	
BY	DATE
L.A.M.	1-04
L.A.M.	2-05

LINE LEGEND
3" & SMALLER
4"
6"
8"
10" & 12"
14" & 16"
18" & 20"
24"
30"
36"

PRIVATE

DRAWN Doug Warrick

DATE May, 1997

CHECKED

DATE _____

APPROVED

DATE _____

AQUA
Ohio.

PREPARED BY:
SERVICE CENTER-ENGINEERING DEPT.
6650 SOUTH AVE. BOARDMAN OHIO 44512

SCALE



FILE NO

DISTRIBUTION MATCHLINE MAP
STARK REGIONAL DIVISION

SHEET NO.
C2

SEE SHEET C4

LINE LEGEND
3" & SMALLER
4"
6"
8"
10" & 12"
14" & 16"
18" & 20"
24"
30"
36"

SEE SHEET B3

SEE SHEET D3

PREPARED BY:
SERVICE CENTER-ENGINEERING DEPT.
6650 SOUTH AVE. BOARDMAN OHIO 44512

Age Group	Total (%)	Male (%)	Female (%)	Unknown (%)
18-24	~15	~15	~15	~15
25-34	~25	~25	~25	~25
35-44	~35	~35	~35	~35
45-54	~45	~45	~45	~45
55-64	~55	~55	~55	~55
65+	~65	~65	~65	~65

DISTRIBUTION MATCHLINE MAP
STARK REGIONAL DIVISION

SHEET NO.
C3

SEE SHEET C3



UPDATED

BY	DATE
44	1-1

L.M.	2-0
------	-----

SEE SHEET B4

SEE SHEET DV

LINE LEGEND

3" & SMALLER

4th

6"

B

10^m & 12^m

14" & 15"

18th & 20th

24

30

36

PRIVATE

AQUA
Ohio

PREPARED BY:
SERVICE CENTER-ENGINEERING DEPT.
6650 SOUTH AVE. BOARDMAN OHIO 44511

SCALE




FILE NO.

DISTRIBUTION MATCHLINE MA
STARK REGIONAL DIVISION

SHEET NO
C4

NORTH

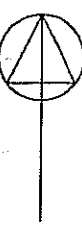

SEE SHEET C4

UPDATED	
BY	DATE
L.A.M.	1-04
L.A.M.	2-05

SEE SHEET B5

SEE SHEET D5


SEE SHEET C6

LINE LEGEND	
3" & SMALLER	
4"	
6"	
8"	
10" & 12"	
14" & 16"	
18" & 20"	
24"	
30"	
36"	
PRIVATE	

DRAWN	Doug Warrick	DATE	May, 1991
CHECKED		DATE	
APPROVED		DATE	



PREPARED BY:
SERVICE CENTER - ENGINEERING DEPT.
6650 SOUTH AVE. BOARDMAN OHIO 44512

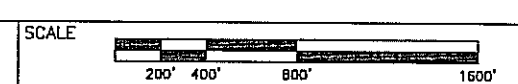

FILE NO.

DISTRIBUTION MATCHLINE MAP
STARK REGIONAL DIVISION

SHEET NO.
C5



NORTH

SEE SHEET C5

UPDATED	BY	DATE
L.A.M.	1-04	
L.A.M.	2-05	




SEE SHEET C7

LINE LEGEND
3" & SMALLER
4"
6"
8"
10" & 12"
14" & 16"
18" & 20"
24"
30"
36"

DRAWN	Doug Warrick	DATE	May, 1997
CHECKED		DATE	
APPROVED		DATE	

AQUA
Ohio.

PREPARED BY:
SERVICE CENTER-ENGINEERING DEPT.
6650 SOUTH AVE. BOARDMAN OHIO 44512

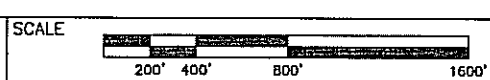

FILE NO.	DISTRIBUTION MATCHLINE MAP STARK REGIONAL DIVISION	SHEET NO. C6
----------	---	-----------------

SEE SHEET C8

LINE LEGEND
3" & SMALLER
4"
6"
8"
10" & 12"
14" & 16"
18" & 20"
24"
30"
36"



SEE SHEET D7

AQUA
Ohio.

PREPARED BY:
SERVICE CENTER-ENGINEERING DEPT.
6650 SOUTH AVE. BOARDMAN OHIO 44512

SCALE


200' 400' 800' 1600'

FILE NO.	
----------	--

DISTRIBUTION MATCHLINE MAP
STARK REGIONAL DIVISION

SHEET NO.
C7

NORTH

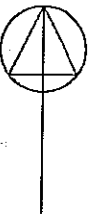

UPDATED

BY	DATE
L.A.M.	1-04
L.A.M.	2-05

SEE SHEET C7



SEE SHEET D8

SEE SHEET C9

LINE LEGEND

3" & SMALLER

4"

6"

8"

10" & 12"

14" & 16"

18" & 20"

24"

30"

36"

PRIVATE

DRAWN

CHECKED

APPROVED

DATE

DATE

DATE

AQUA
Ohio.

PREPARED BY:
SERVICE CENTER-ENGINEERING DEPT.
6650 SOUTH AVE. BOARDMAN OHIO 44512

SCALE



FILE NO.

DISTRIBUTION MATCHLINE MAP
STARK REGIONAL DIVISION

SHEET NO.
C8

SEE SHEET 65

WOLF CREEK

POORMAN ST

CAMP CREEK

RUN

AV

GREENHAVEN ST

ADAMS ST

WOODGROVE ST

ELTON ST

PIGEON

CARNOUT ST

SEE SHEET D9

SHEET NO.
C9

UPDATED	
BY	DATE
L.A.M.	1-04
L.A.M.	2-05

LINE	LEGEND
3" & SMALLER	
4"	
5"	
8"	
10" & 12"	
14" & 16"	
18" & 20"	
24"	
30"	
36"	

DRAWN <i>Doug Warrick</i>	DATE <i>May, 1991</i>
CHECKED	DATE
APPROVED	DATE

AQUA
Ohio.


PREPARED BY:
SERVICE CENTER-ENGINEERING DEPT.
6650 SOUTH AVE. BOARDMAN OHIO 44512

SCALE



FILE NO.	
----------	--


DISTRIBUTION MATCHLINE MAP
STARK REGIONAL DIVISION

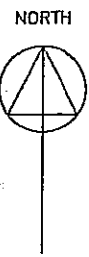

UPDATED	
BY	DATE
L.A.M.	1-04
L.A.M.	2-05

SEE SHEET C-3

SEE SHEET E-3

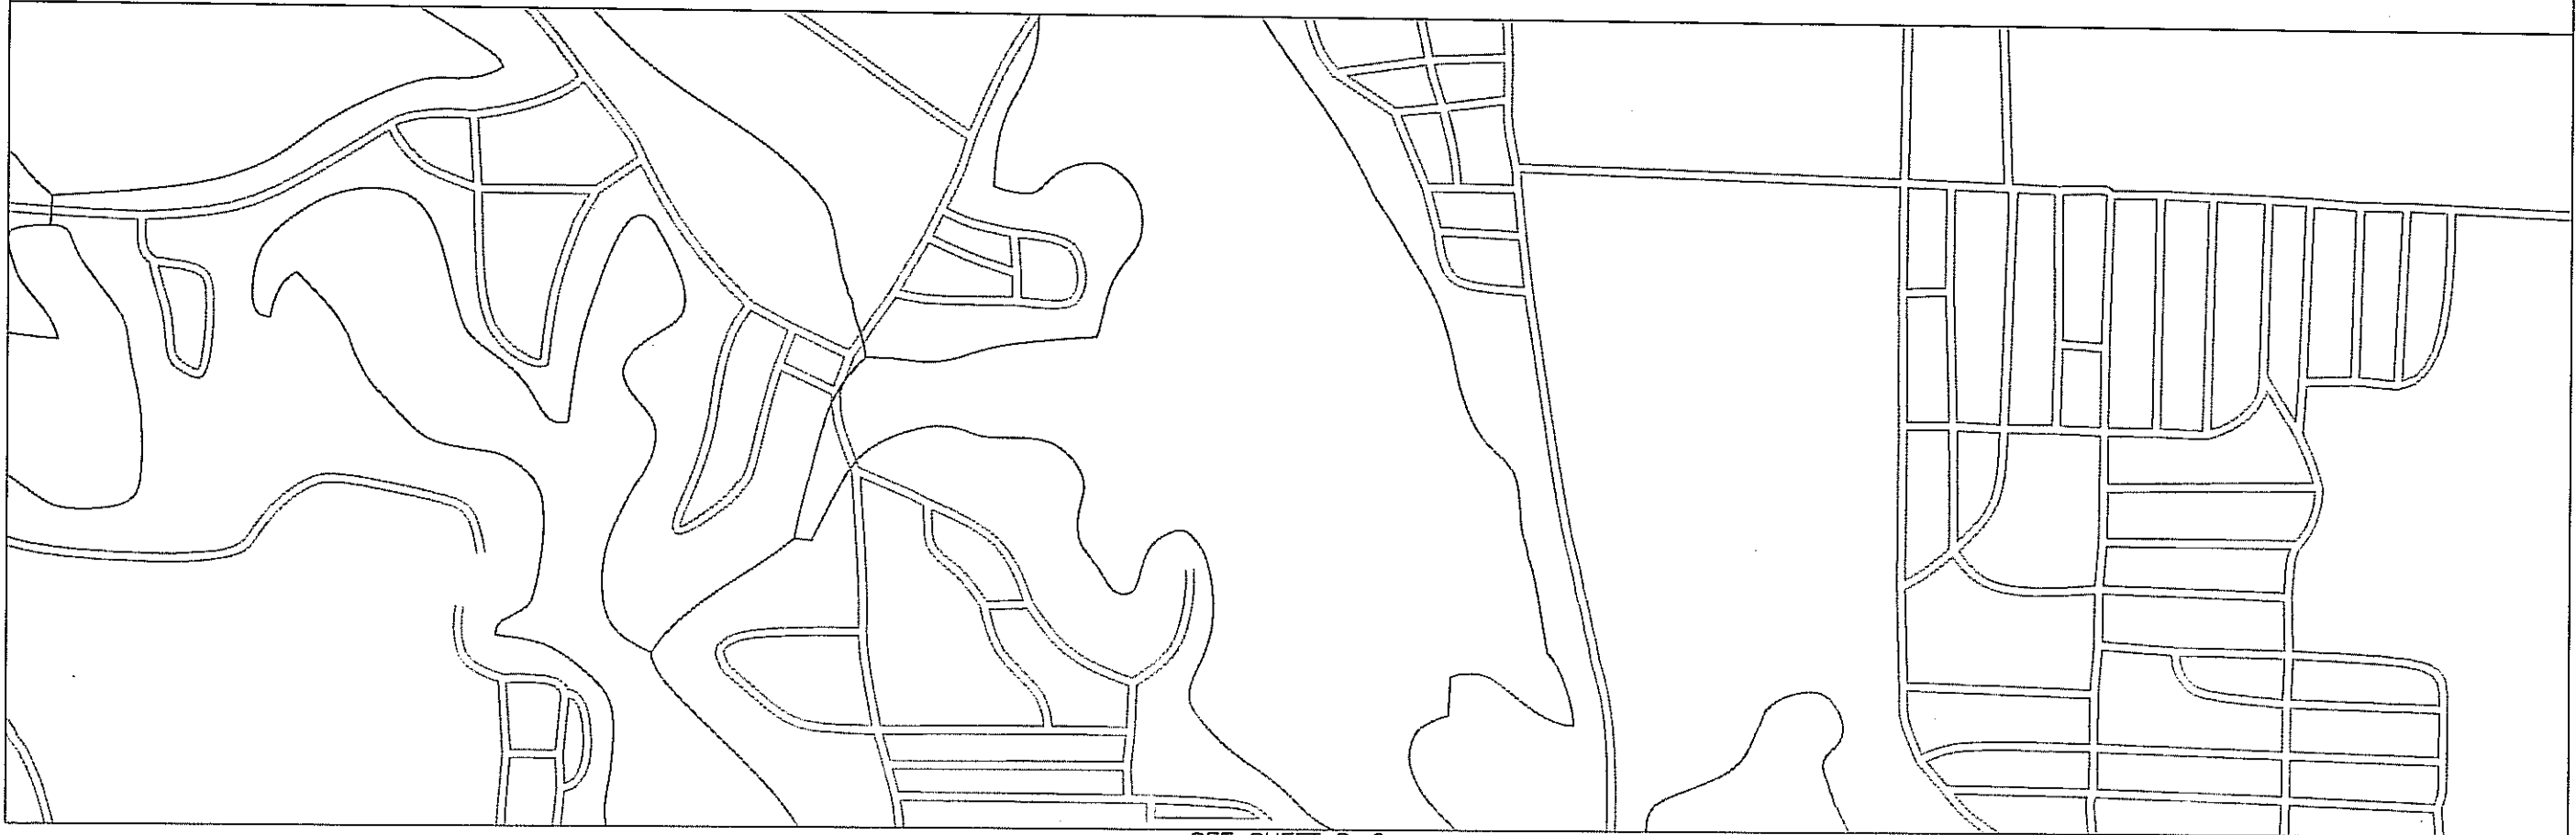


SEE SHEET D-2

LINE LEGEND	
3" & SMALLER	
4"	
6"	
8"	
10" & 12"	
14" & 16"	
18" & 20"	
24"	
30"	
36"	
PRIVATE	

DRAWN <i>Doug Warrick</i>	DATE <i>May, 1997</i>
CHECKED	DATE
APPROVED	DATE

AQUA
Ohio.

PREPARED BY:
SERVICE CENTER-ENGINEERING DEPT.
6650 SOUTH AVE. BOARDMAN OHIO 44512

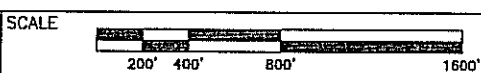


FILE NO.

DISTRIBUTION MATCHLINE MAP
STARK REGIONAL DIVISION

SHEET NO.
D-3

NORTH

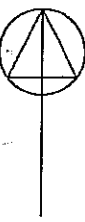

SEE SHEET D-2

UPDATED	
BY	DATE
L.A.M.	1-04
L.A.M.	2-05

SEE SHEET C-1

LINE LEGEND	
3" & SMALLER	
4"	
6"	
8"	
10" & 12"	
14" & 16"	
18" & 20"	
24"	
30"	
36"	
PRIVATE	

DRAWN	Doug Warrick	DATE	May, 1991
CHECKED		DATE	
APPROVED		DATE	

AQUA
Ohio.

PREPARED BY:
SERVICE CENTER-ENGINEERING DEPT.
6650 SOUTH AVE. BOARDMAN OHIO 44512

SCALE

200' 400' 800' 1600'

FILE NO.

DISTRIBUTION MATCHLINE MAP
STARK REGIONAL DIVISION


SHEET NO.
D-1

SEE SHEET E-1

SEE SHEET D0



NORTH

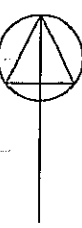

SEE SHEET D-1

UPDATED

BY DATE

L.A.M. 1-04

L.A.M. 2-05

SEE SHEET C0

SEE SHEET E0

FRANKLIN TWP.

CITY OF GREEN

EAST NIMISILA

SEE SHEET D1

LINE LEGEND

3" & SMALLER

4"

6"

8"

10" & 12"

14" & 16"

18" & 20"

24"

30"

36"

PRIVATE

DRAWN *Doug Warrick* DATE *May, 1991*

CHECKED DATE

APPROVED DATE

AQUA
Ohio.

PREPARED BY:
SERVICE CENTER-ENGINEERING DEPT.
6650 SOUTH AVE. BOARDMAN OHIO 44512

SCALE
200' 400' 800' 1600'

FILE NO.

DISTRIBUTION MATCHLINE MAP
STARK REGIONAL DIVISION

SHEET NO.
D0

NORTH



SEE SHEET D0

UPDATED	
BY	DATE
L.A.M.	1-04
L.A.M.	2-05

SEE SHEET C1



SEE SHEET E1


SEE SHEET D2

LINE LEGEND	
3" & SMALLER	
4"	
6"	
8"	
10" & 12"	
14" & 16"	
18" & 20"	
24"	
30"	
36"	

PRIVATE	DRAWN <i>Doug Warrick</i>	DATE <i>May, 1991</i>
CHECKED		DATE
APPROVED		DATE

AQUA
Ohio.

PREPARED BY:
SERVICE CENTER-ENGINEERING DEPT.
6550 SOUTH AVE. BOARDMAN OHIO 44512

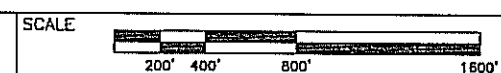

FILE NO.

DISTRIBUTION MATCHLINE MAP
STARK REGIONAL DIVISION

SHEET NO.
D1

SEE SHEET D3

LINE LEGEND
3" & SMALLER
4"
6"
8"
10" & 12"
14" & 16"
18" & 20"
24"
30"
36"


SEE SHEET C2

SEE SHEET E2



SHEET NO.
D2

NORTH

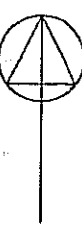

SEE SHEET D2


UPDATED	
BY	DATE
L.A.M.	1-04
L.A.M.	2-05

LINE LEGEND	
3" & SMALLER	
4"	
6"	
8"	
10" & 12"	
14" & 16"	
18" & 20"	
24"	
30"	
36"	

PRIVATE	DRAWN <i>Doug Warrick</i>	DATE <i>May, 1991</i>
CHECKED		DATE
APPROVED		DATE

AQUA
Ohio.


PREPARED BY:
SERVICE CENTER-ENGINEERING DEPT.
6650 SOUTH AVE. BOARDMAN OHIO 44512

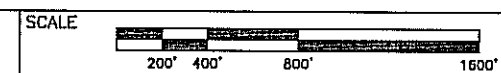

FILE NO.

DISTRIBUTION MATCHLINE MAP
STARK REGIONAL DIVISION

SHEET NO.
D3

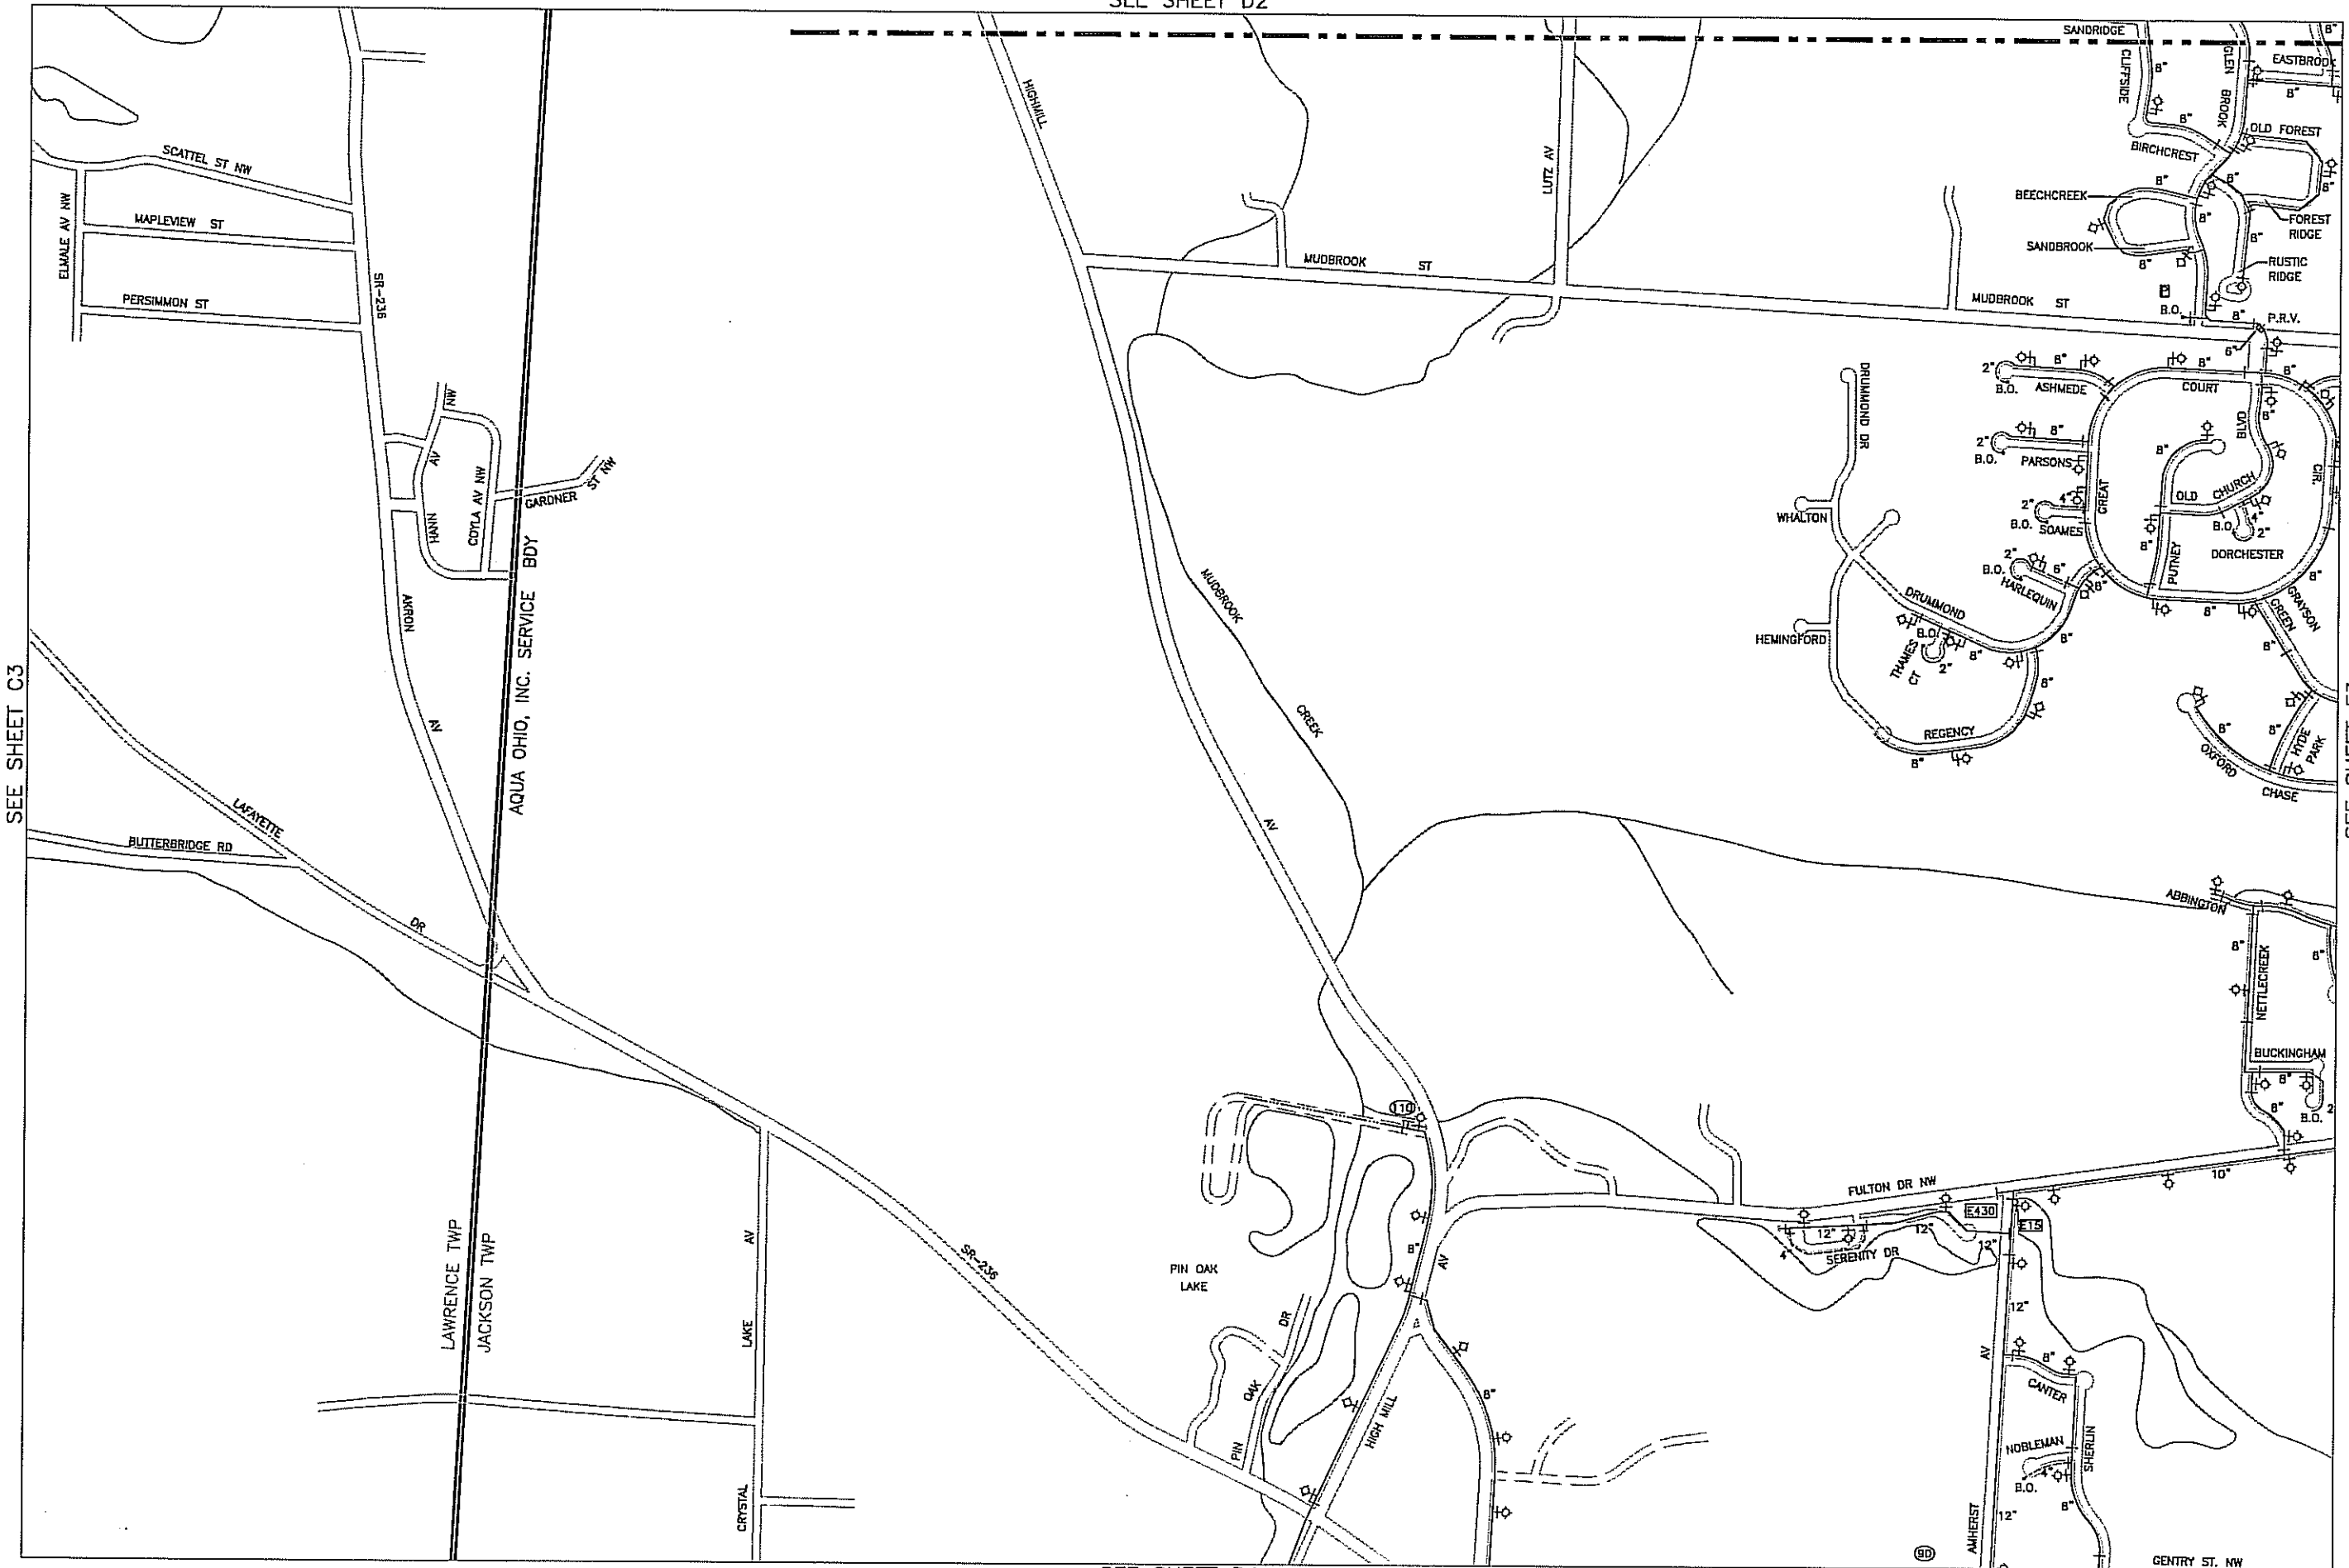

SEE SHEET C3

SEE SHEET E3

SEE SHEET D4

NORTH

SEE SHEET D3

UPDATED	
BY	DATE
L.A.M.	1-04
L.A.M.	2-05


SEE SHEET C4

LINE LEGEND	
3" & SMALLER	
4"	
6"	
8"	
10" & 12"	
14" & 16"	
18" & 20"	
24"	
30"	
36"	

DRAWN	Doug Warrick	DATE	May, 1991
CHECKED		DATE	
APPROVED		DATE	

AQUA
Ohio.

PREPARED BY:
SERVICE CENTER-ENGINEERING DEPT.
6650 SOUTH AVE. BOARDMAN OHIO 44512

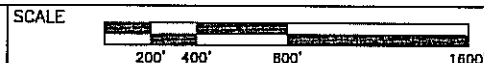

FILE NO.

DISTRIBUTION MATCHLINE MAP
STARK REGIONAL DIVISION


SHEET NO.
D4



SEE SHEET D5

SEE SHEET E4

NORTH

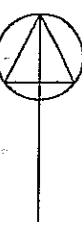

SEE SHEET D4


UPDATED	
BY	DATE
L.A.M.	1-04
L.A.M.	2-05

LINE LEGEND	
3" & SMALLER	
4"	
6"	
8"	
10" & 12"	
14" & 16"	
18" & 20"	
24"	
30"	
36"	

PRIVATE	
DRAWN	Doug Warrick
CHECKED	
APPROVED	
DATE	May, 1997
DATE	

AQUA
Ohio.

PREPARED BY:
SERVICE CENTER-ENGINEERING DEPT.
6650 SOUTH AVE. BOARDMAN OHIO 44512

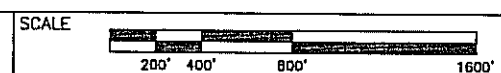

FILE NO.

DISTRIBUTION MATCHLINE MAP
STARK REGIONAL DIVISION

SHEET NO.
D5




NORTH

SEE SHEET D5

UPDATED	
BY	DATE
L.A.M.	1-04
L.A.M.	2-05

LINE LEGEND	
3" & SMALLER	
4"	
6"	
8"	
10" & 12"	
14" & 16"	
18" & 20"	
24"	
30"	
36"	
PRIVATE	

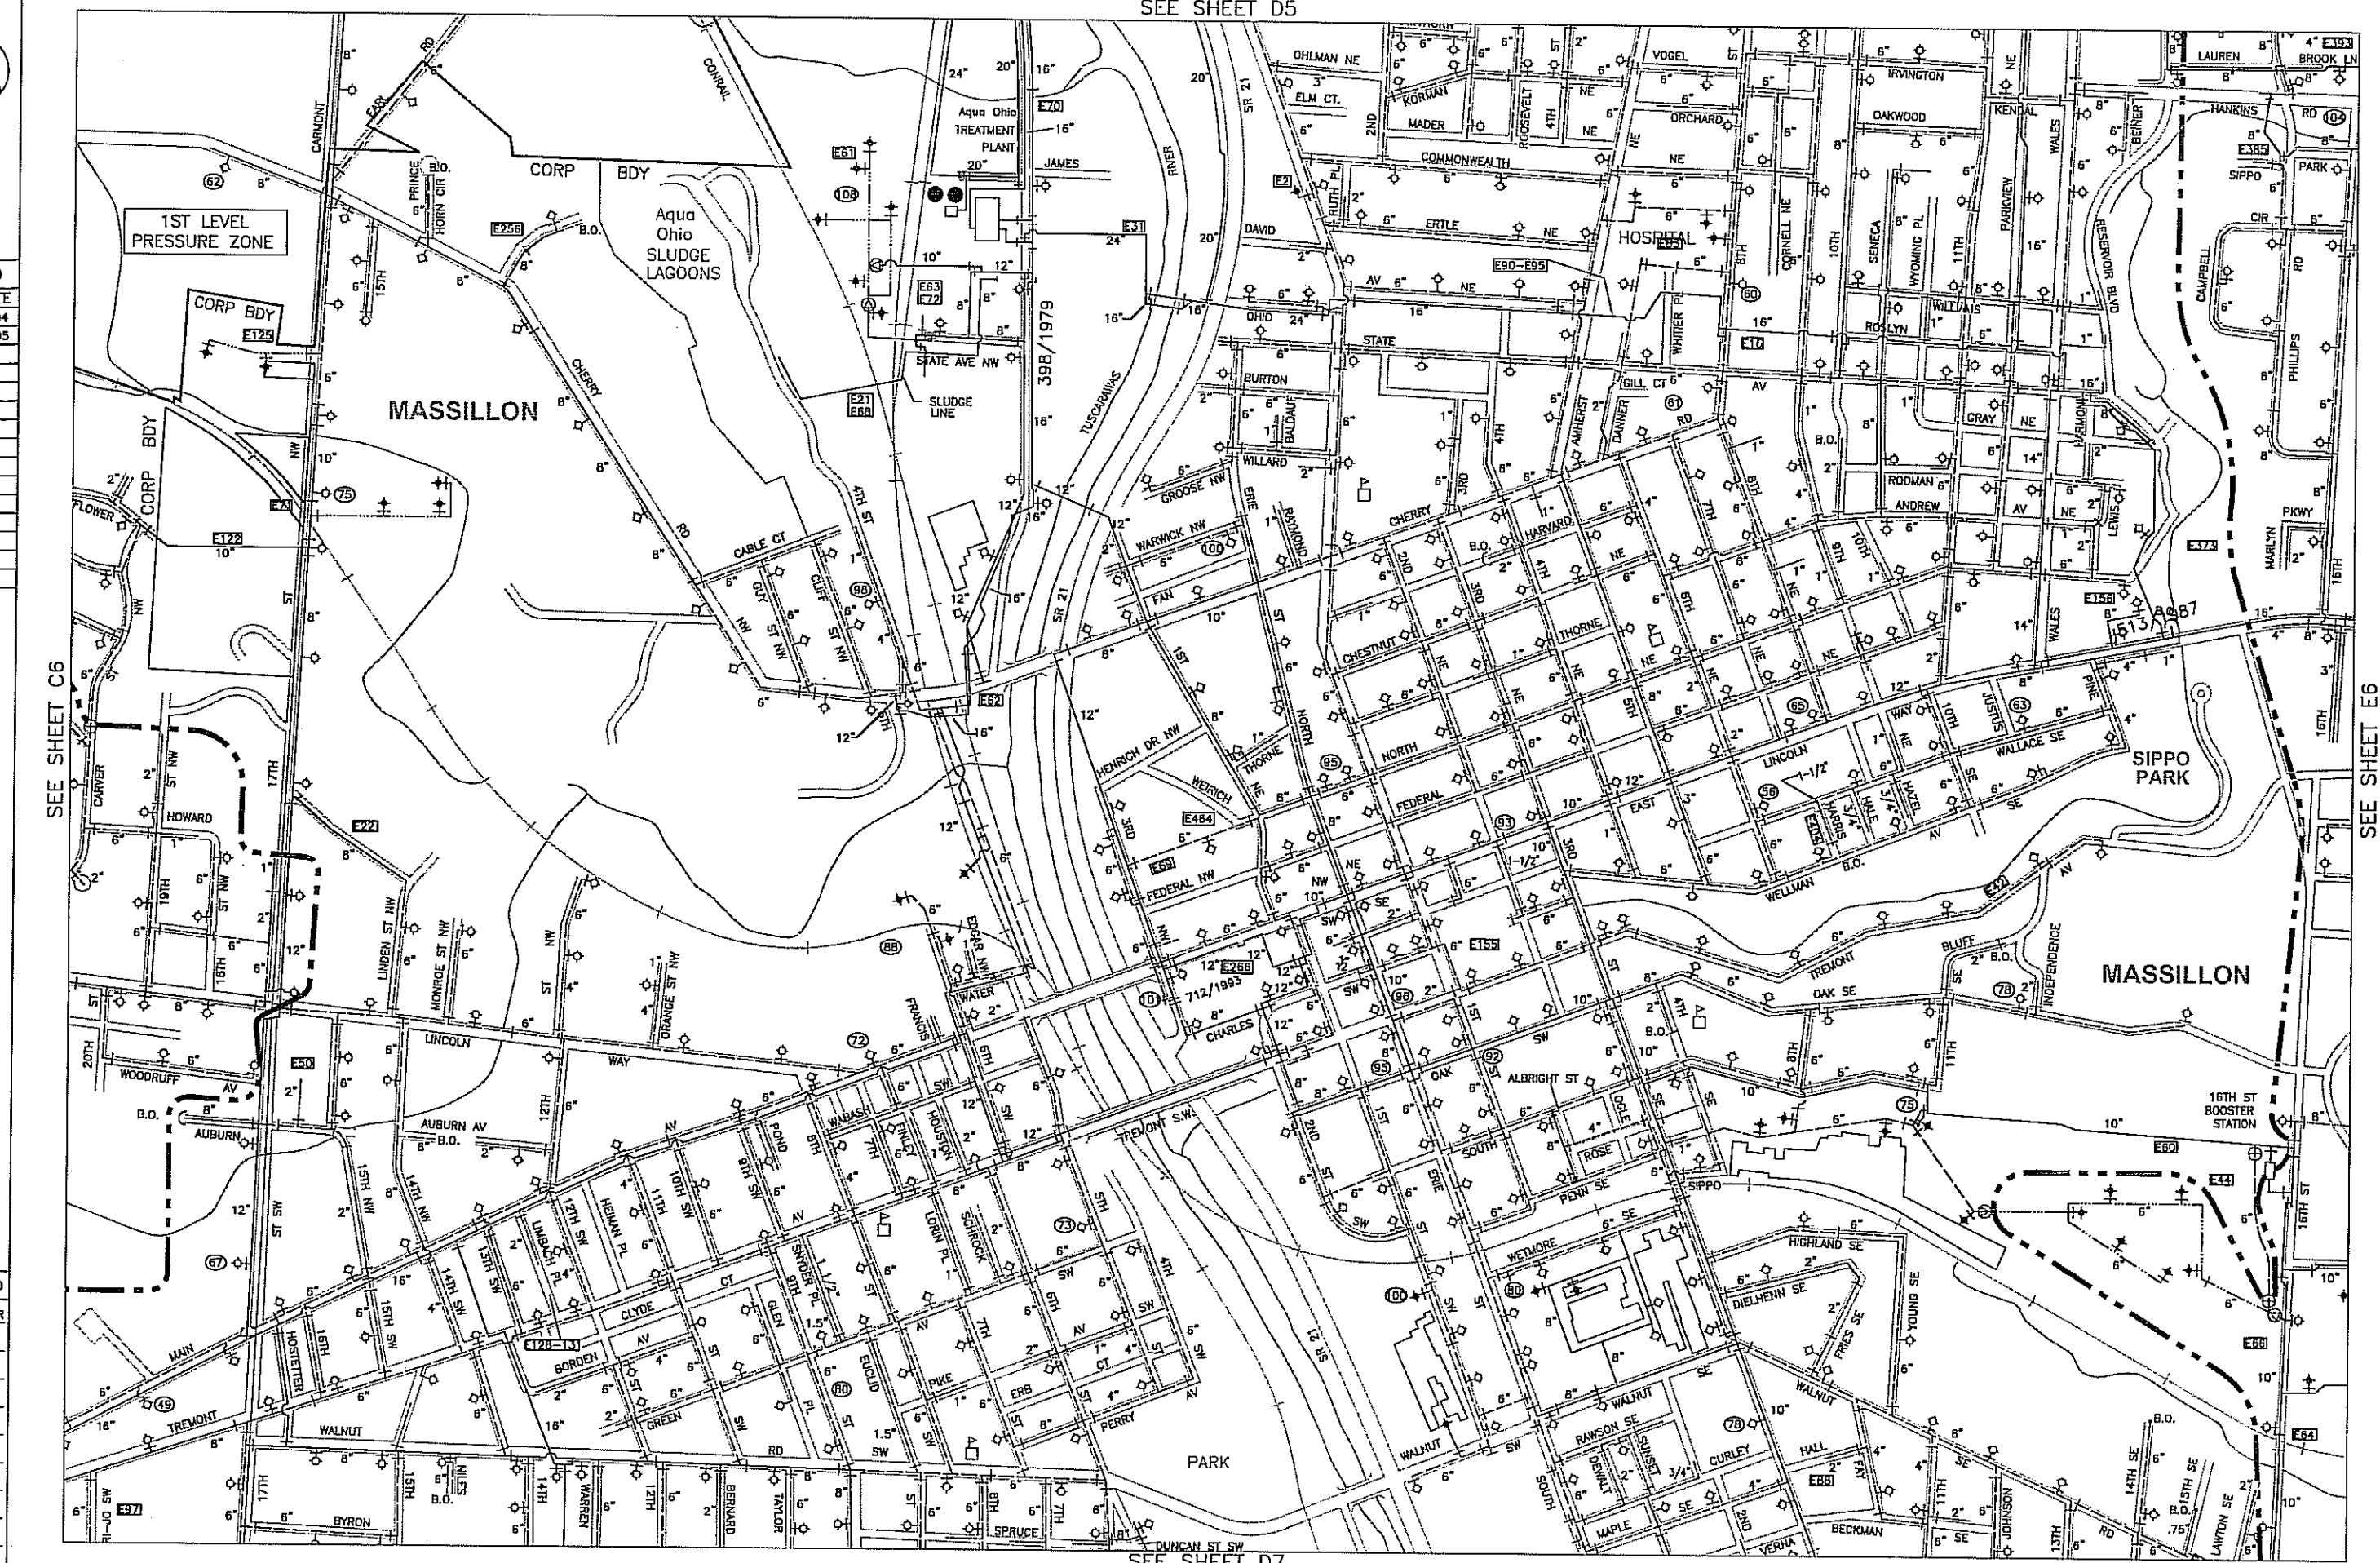


SEE SHEET D7

DRAWN	Doug Warrick	DATE	May, 1991
CHECKED		DATE	
APPROVED		DATE	

AQUA
Ohio.

PREPARED BY:
SERVICE CENTER - ENGINEERING DEPT.
8650 SOUTH AVE. BOARDMAN OHIO 44512

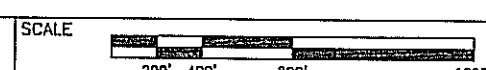

FILE NO.

DISTRIBUTION MATCHLINE MAP
STARK REGIONAL DIVISION

SHEET NO.
D6

NORTH

SEE SHEET D6

UPDATED	
BY	DATE
L.A.M.	1-04
L.A.M.	2-05

SEE SHEET C7

LINE LEGEND

3" & SMALLER

4"

6"

8"

10" & 12"

14" & 16"

18" & 20"

24"

30"

36"

PRIVATE

DRAWN	Doug Warrick	DATE	May, 1991
CHECKED		DATE	
APPROVED		DATE	

AQUA
Ohio.

PREPARED BY:
SERVICE CENTER-ENGINEERING DEPT.
6650 SOUTH AVE. BOARDMAN OHIO 44512

SCALE




FILE NO.

DISTRIBUTION MATCHLINE MAP
STARK REGIONAL DIVISION

SHEET NO.


D7

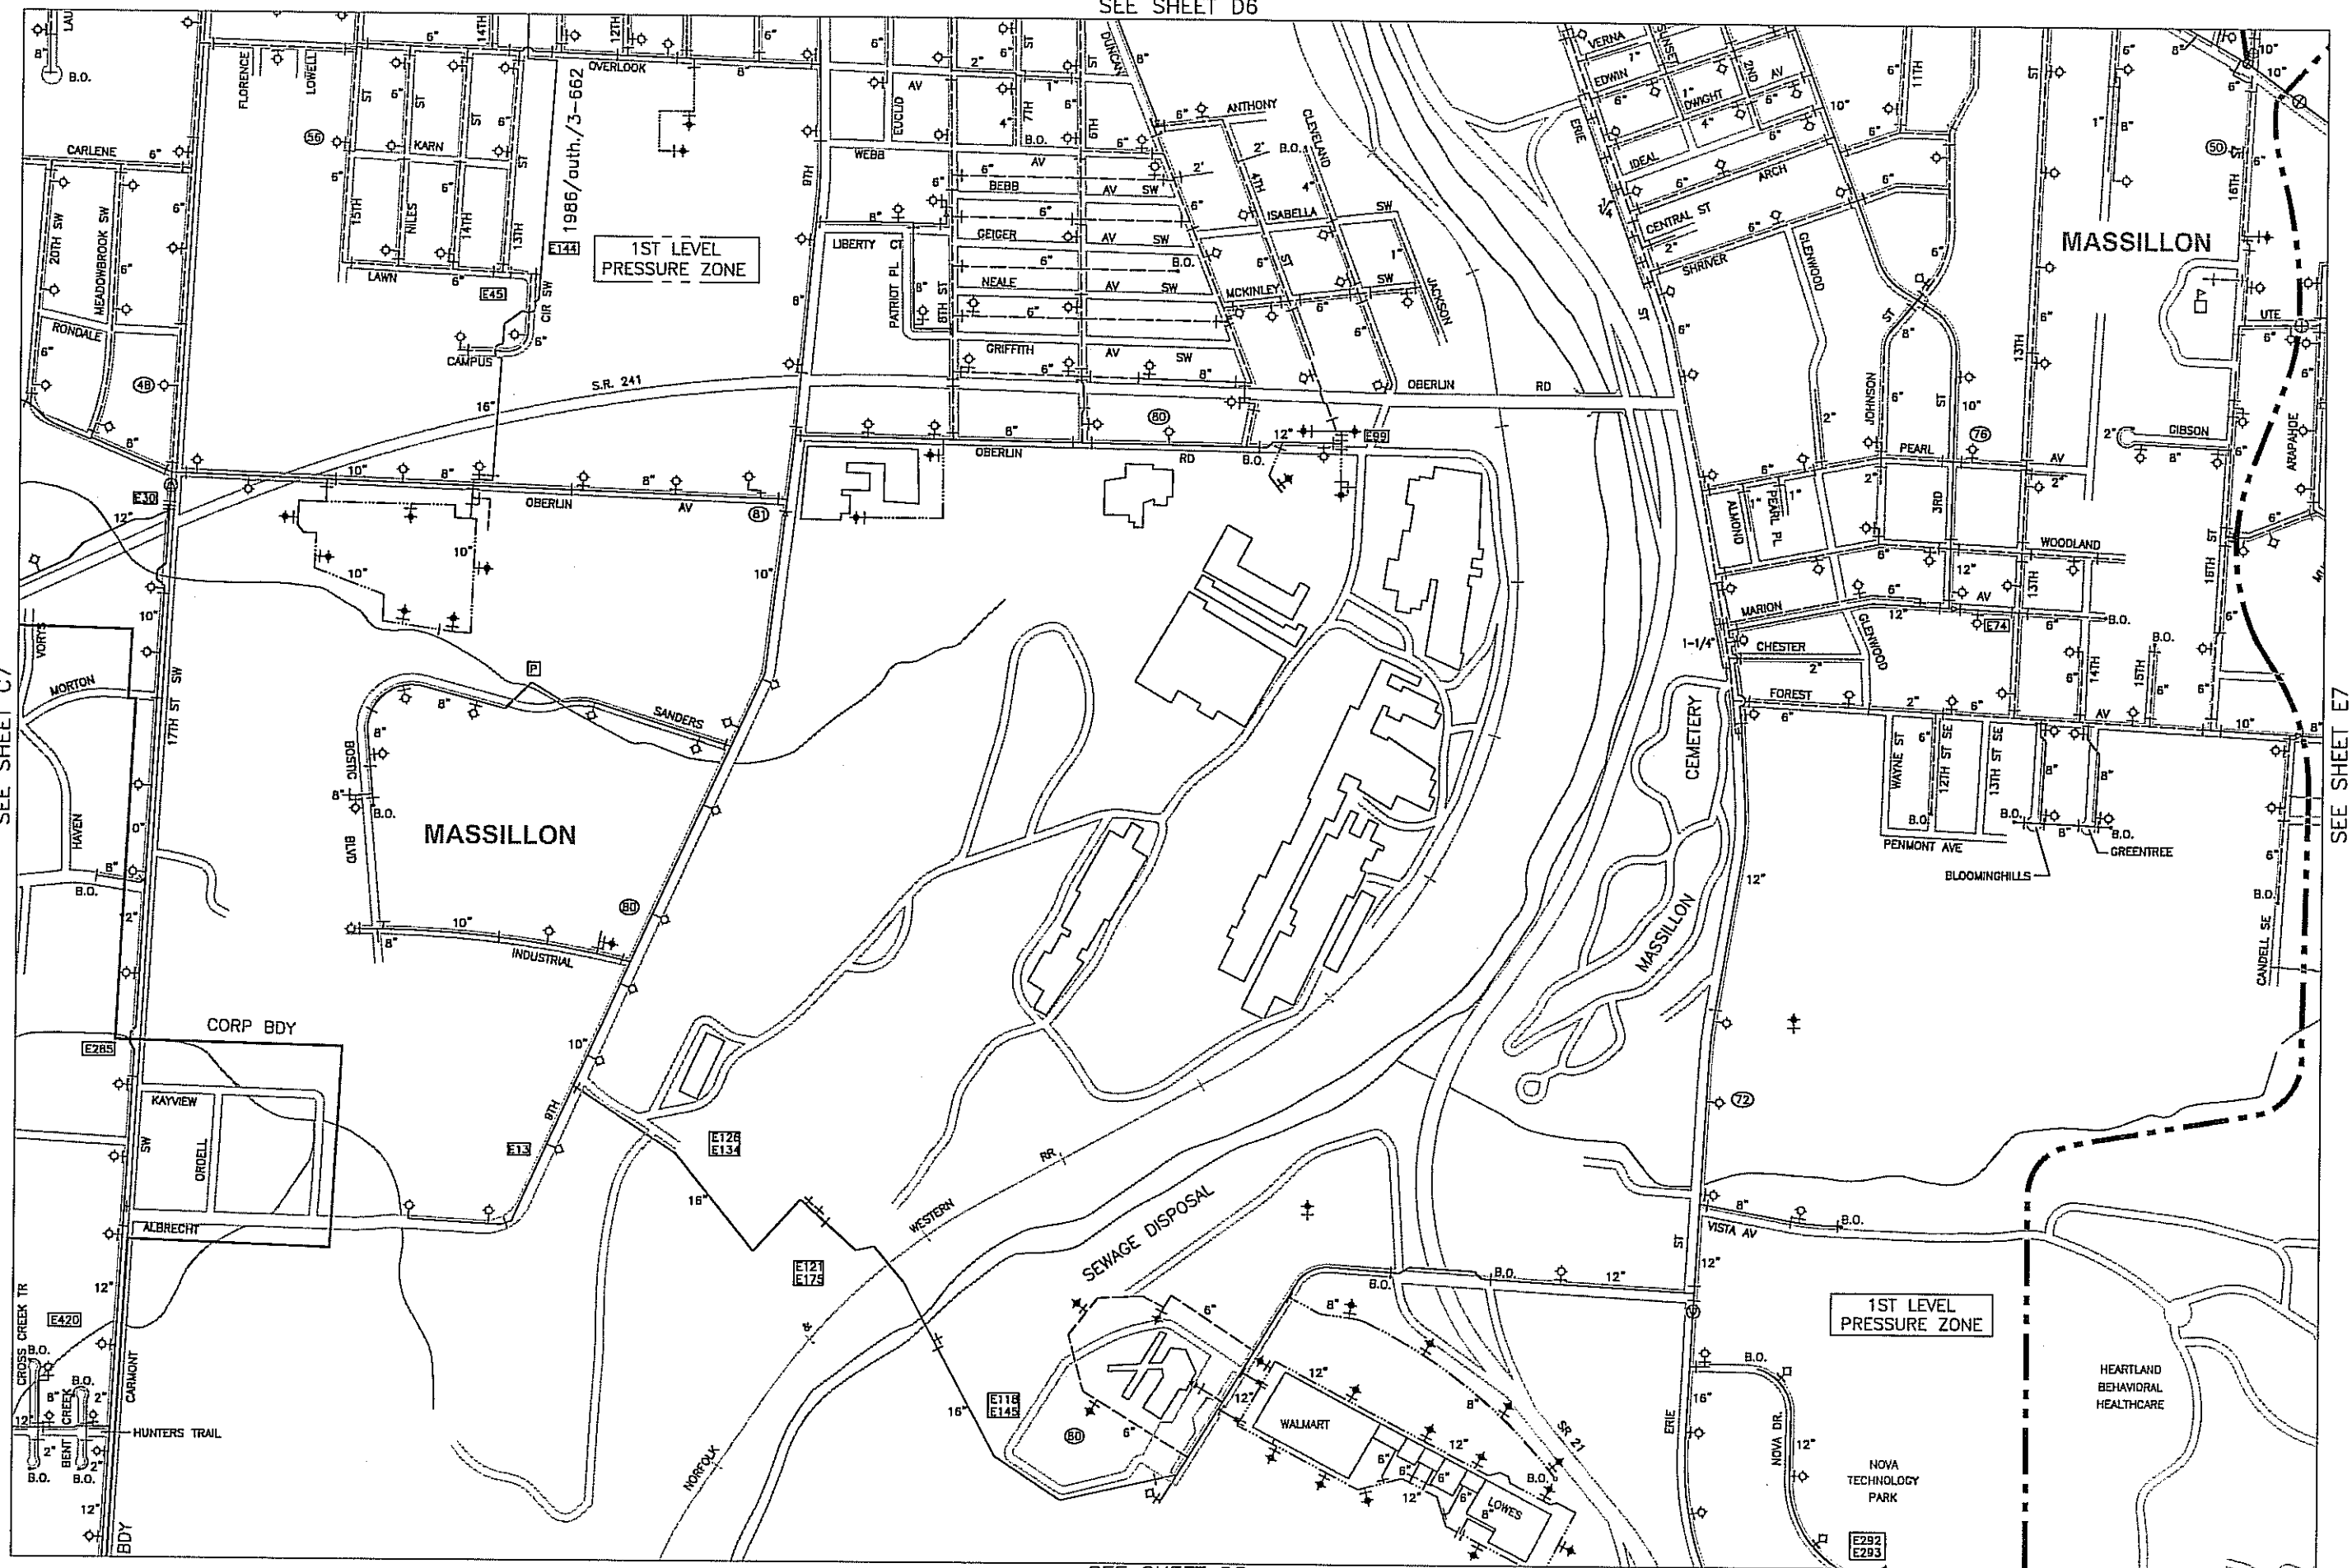

SEE SHEET E7

SEE SHEET D8

NORTH

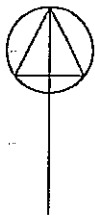

UPDATED	
BY	DATE
L.A.M.	1-04
L.A.M.	2-05

SEE SHEET C8

83 LEHS FES

LINE LEGEND

3" & SMALLER

4th

_____ 6" _____

8"

10" & 12"

14" & 16"

18" & 20"

24th

30"

36°

PRIVATE

AQUA
Ohio.

PREPARED BY:
SERVICE CENTER-ENGINEERING DEPT.
6650 SOUTH AVE. BOARDMAN OHIO 44512


SCALE



FILE NO.

DISTRIBUTION MATCHLINE MAP
STARK REGIONAL DIVISION

SHEET NO.
D8

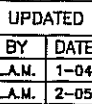[illegible]

10

100

NE LEGEND

& SMALLER

4"

6"

8"

0" & 12"


14" & 16"

8" & 20"
24"
30"
36"

PRIVATE

SEE SHEET C9

63 LEHS EES
SEE SHEET E9

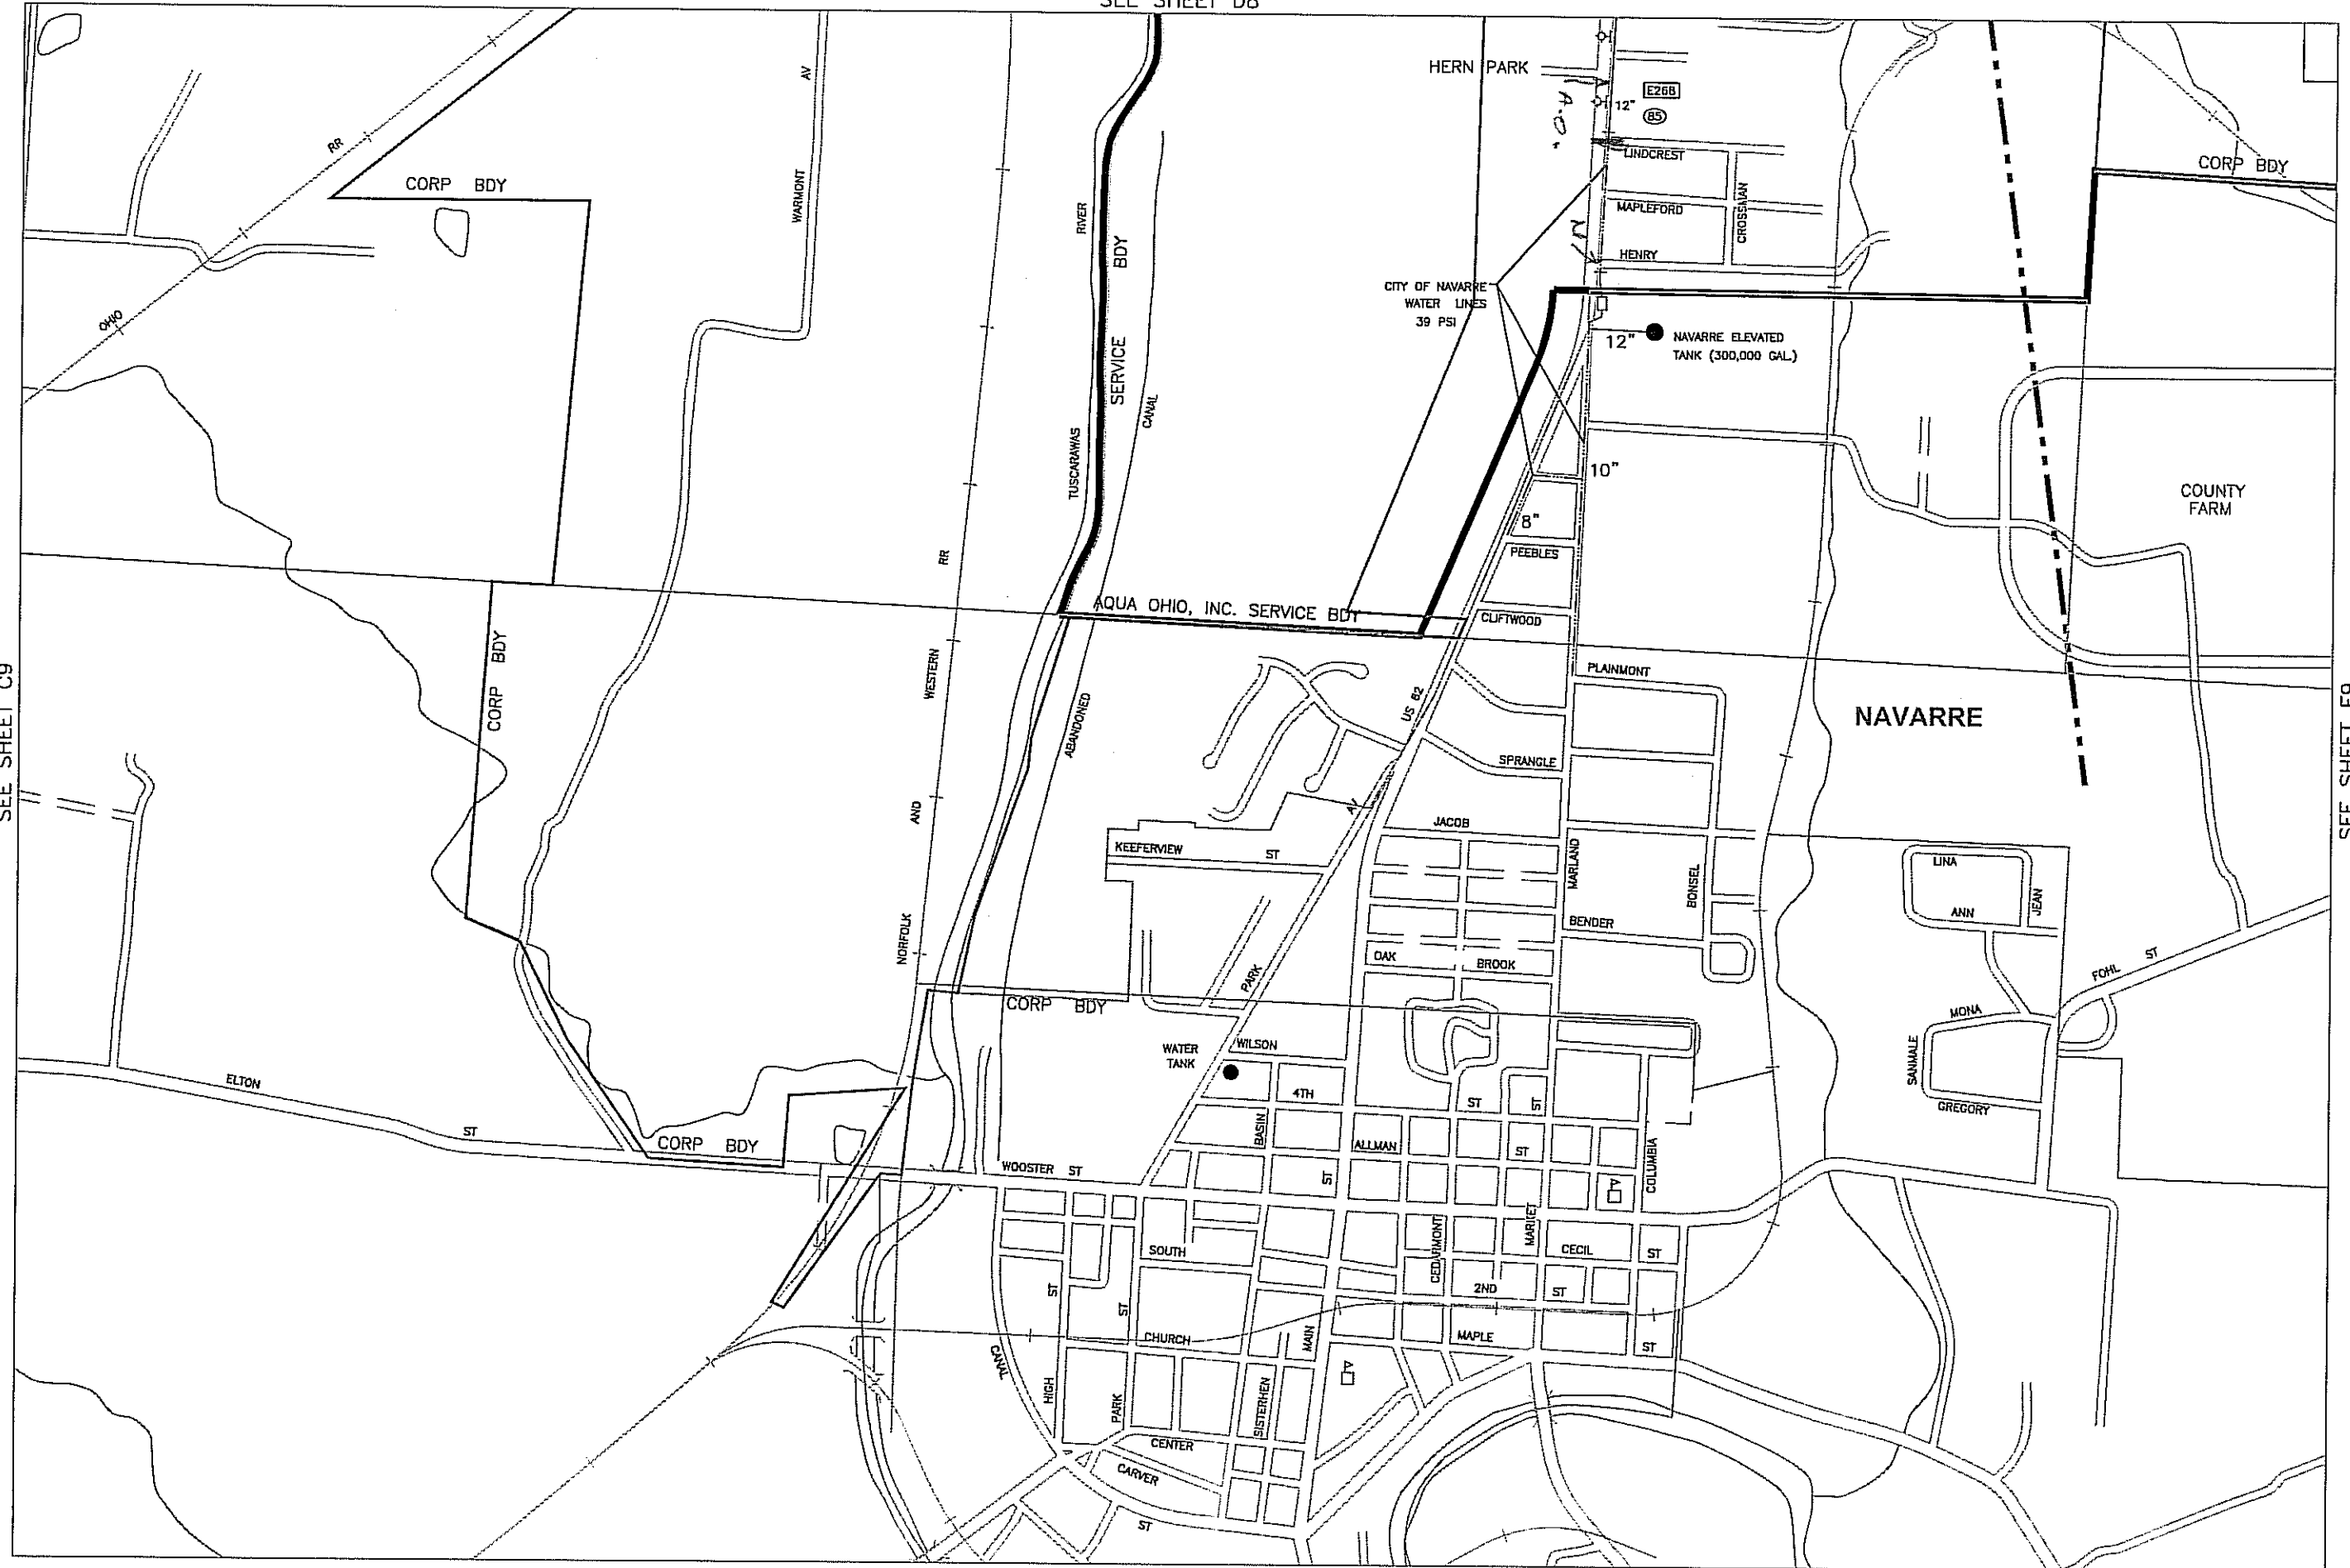


PREPARED BY:
SERVICE CENTER-ENGINEERING DEPT.
6650 SOUTH AVE. BOARDMAN OHIO 44512



DISTRIBUTION MATCHLINE MAP
STARK REGIONAL DIVISION

SHEET NO.
D9

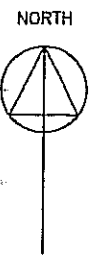

UPDATED	
BY	DATE
L.A.M.	1-04
L.A.M.	2-05

SEE SHEET D-3

SEE SHEET F-3


LINE LEGEND	
3" & SMALLER	
4"	
6"	
8"	
10" & 12"	
14" & 16"	
18" & 20"	
24"	
30"	
36"	



SEE SHEET E-2

NORTH

SEE SHEET E-2

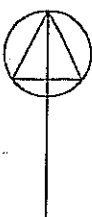

UPDATED	
BY	DATE
L.A.M.	1-04
L.A.M.	2-05

SEE SHEET D-1


LINE LEGEND	
3" & SMALLER	
4"	
6"	
8"	
10" & 12"	
14" & 16"	
18" & 20"	
24"	
30"	
36"	

PRIVATE

DRAWN	Doug Warrick	DATE	May, 1991
CHECKED		DATE	
APPROVED		DATE	

AQUA
Ohio.


PREPARED BY:
SERVICE CENTER-ENGINEERING DEPT.
6650 SOUTH AVE. BOARDMAN OHIO 44512

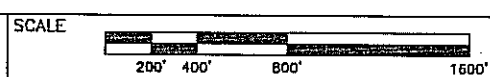

FILE NO.

DISTRIBUTION MATCHLINE MAP
STARK REGIONAL DIVISION

SHEET NO.
E-1

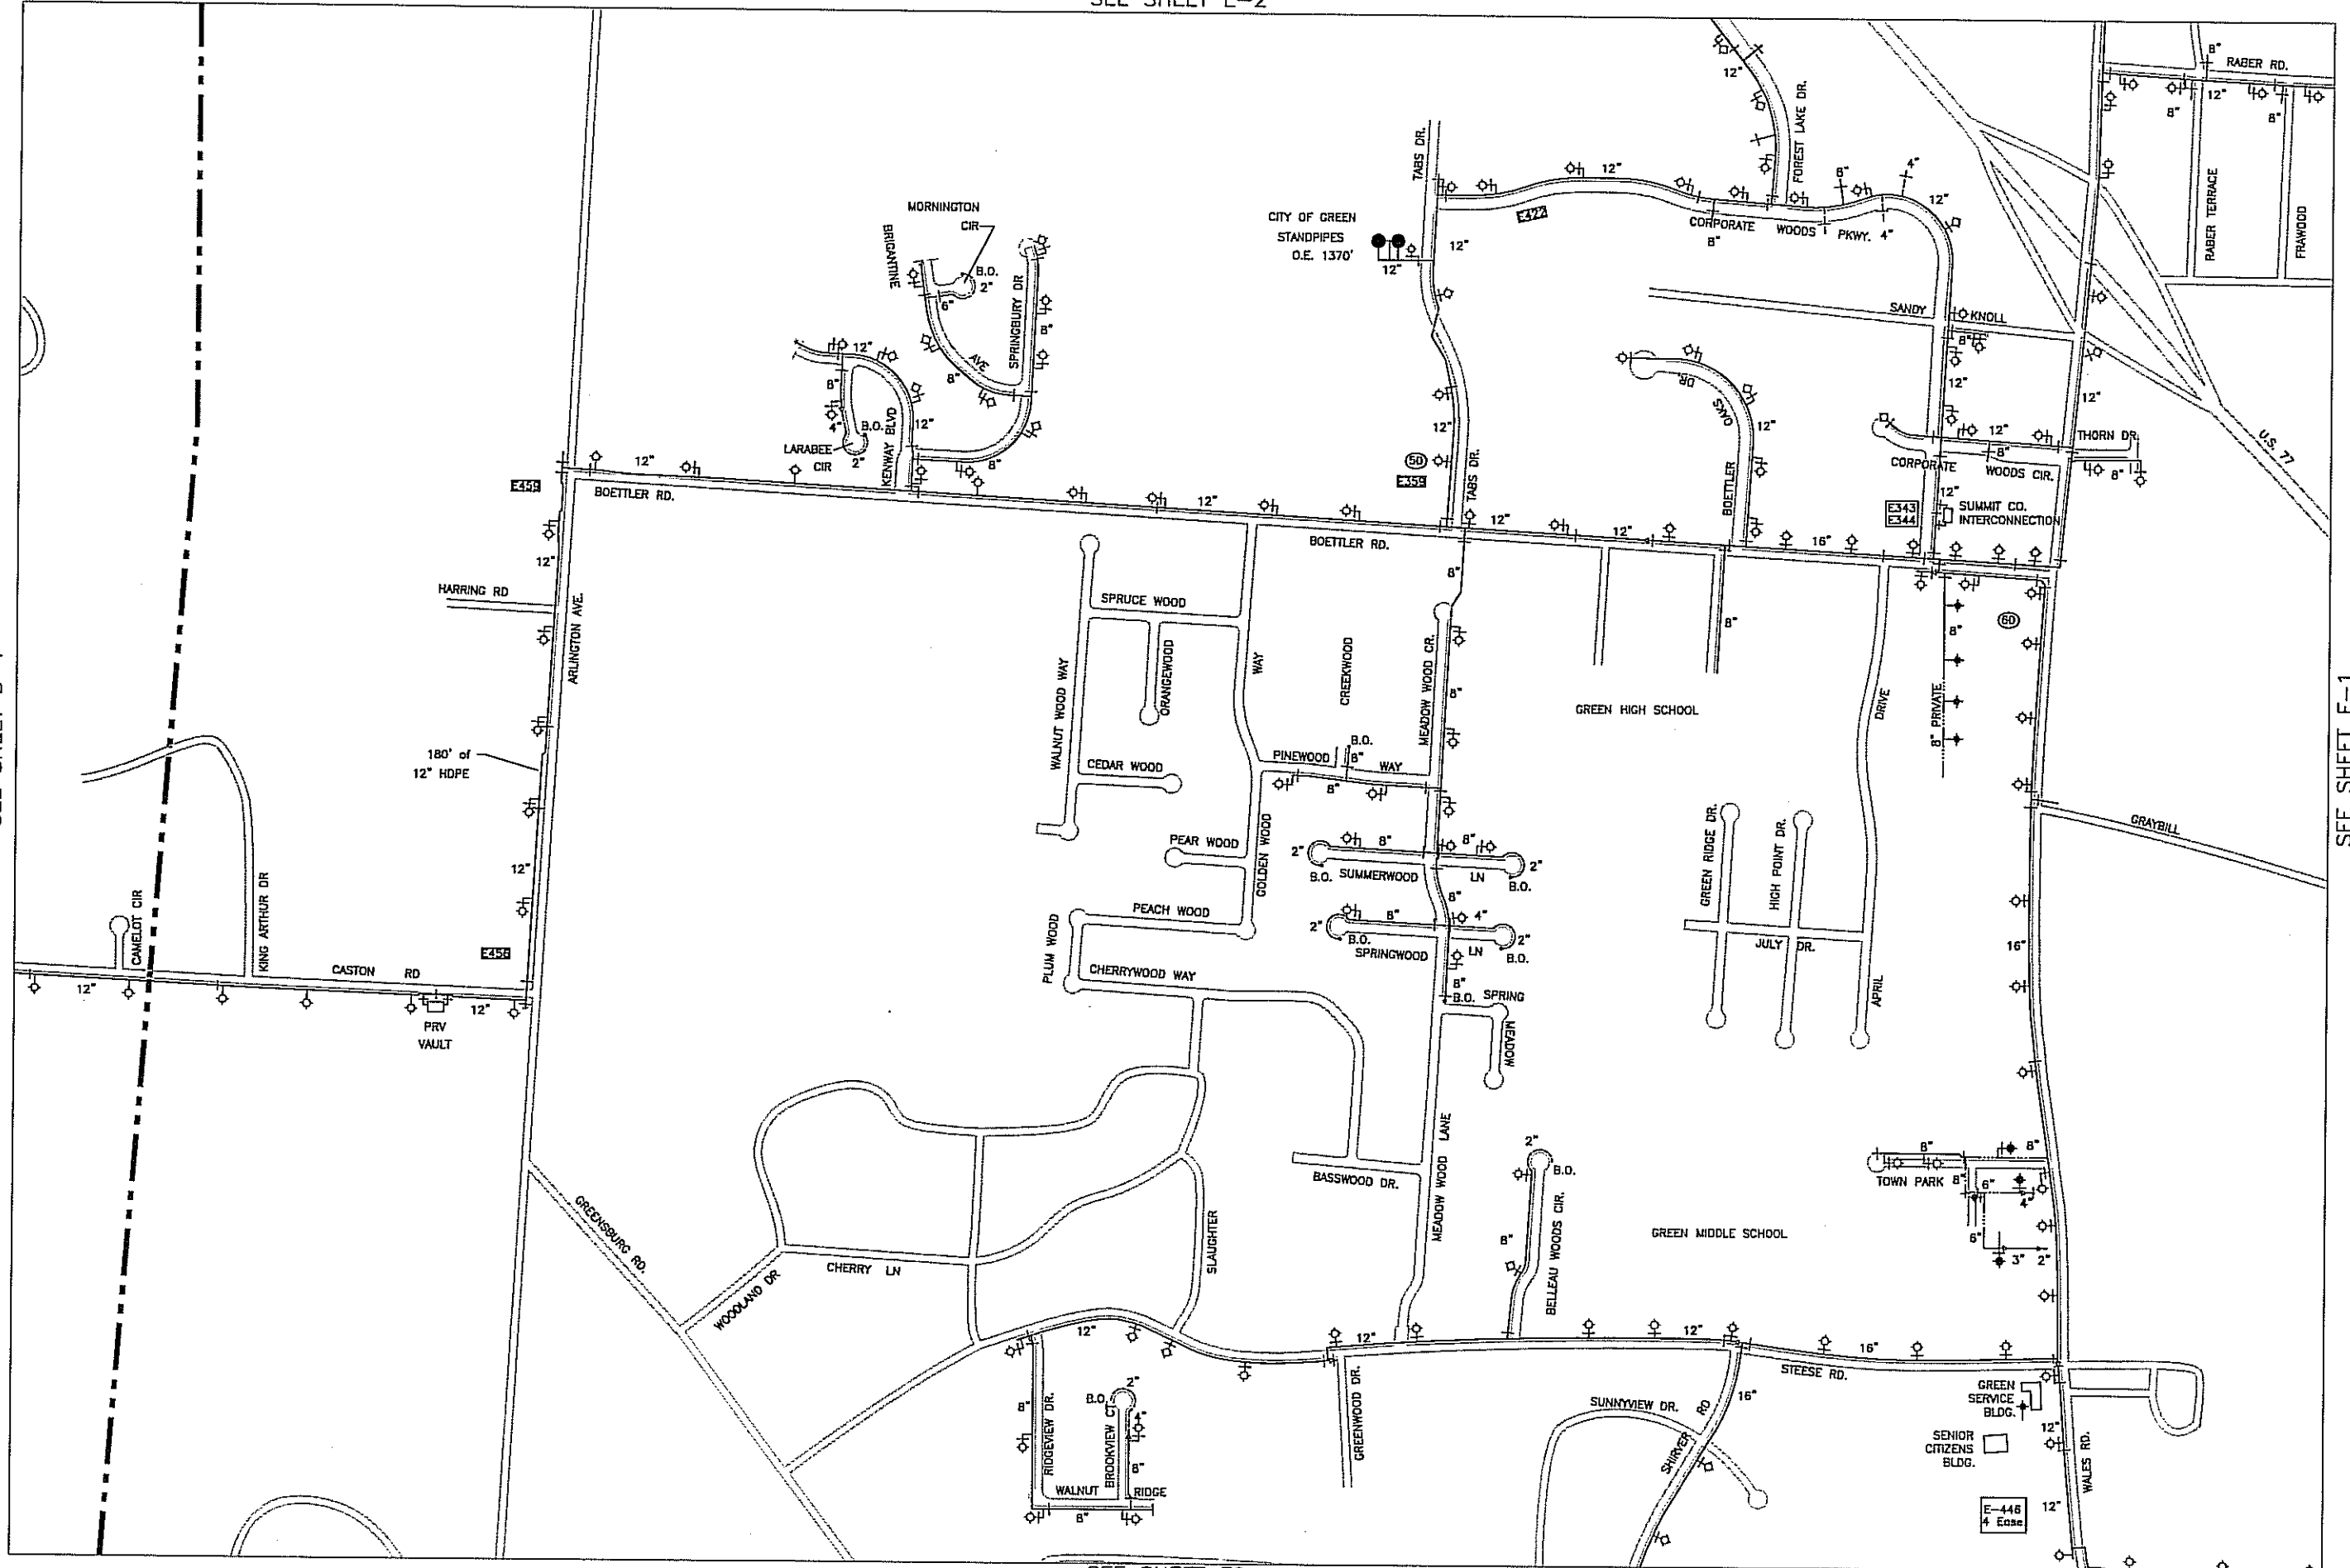

SEE SHEET F-1

SEE SHEET E0

NORTH




SEE SHEET E-1

UPDATED

BY	DATE
L.A.M.	1-04
L.A.M.	2-05

SEE SHEET D0

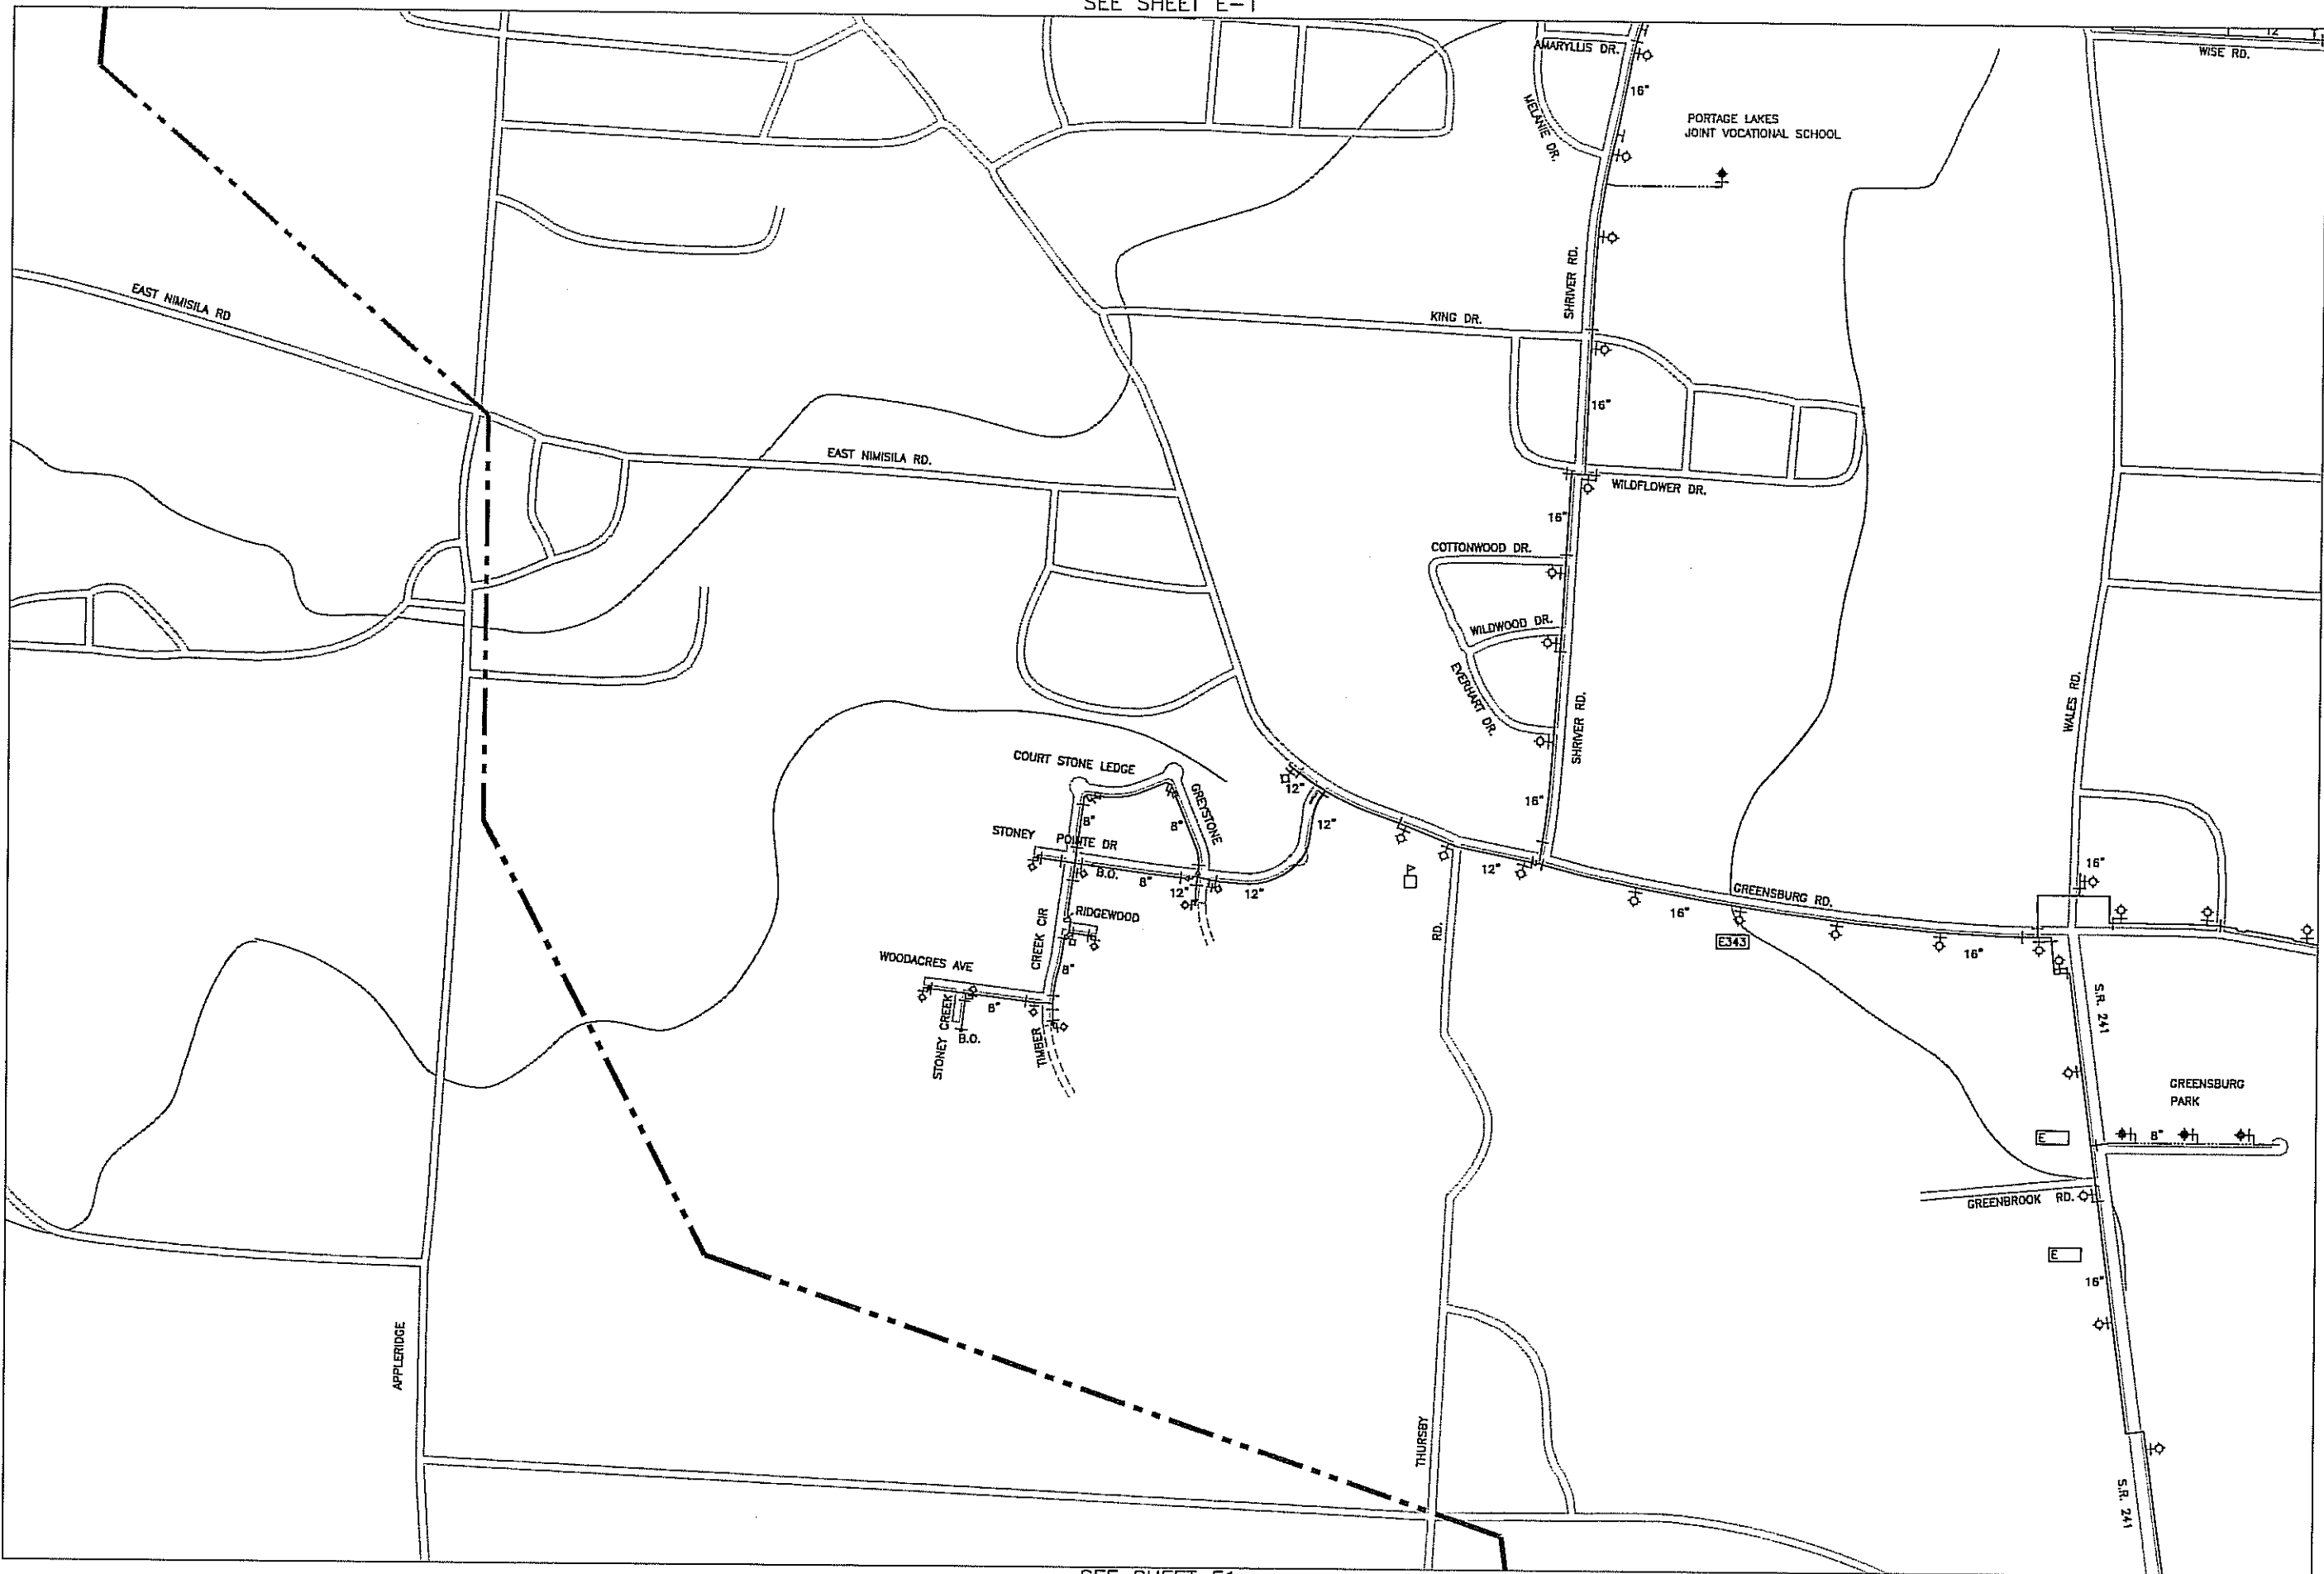

SEE SHEET F0

SEE SHEET E1

LINE LEGEND

3" & SMALLER

4"

6"

8"

10" & 12"

14" & 16"

18" & 20"

24"

30"

36"

PRIVATE

DRAWN	Doug Warrick	DATE	May, 1991
CHECKED		DATE	
APPROVED		DATE	

AQUA
Ohio.

PREPARED BY:
SERVICE CENTER-ENGINEERING DEPT.
6650 SOUTH AVE. HOARDMAN OHIO 44512



FILE NO.

DISTRIBUTION MATCHLINE MAP
STARK REGIONAL DIVISION

SHEET NO.
E0

NORTH

SEE SHEET E0



UPDATED

BY DATE

L.A.M. 1-04

L.A.M. 2-05

SEE SHEET D1

SEE SHEET F1

SEE SHEET E2

LINE LEGEND	
3" & SMALLER	
4"	
6"	
8"	
10" & 12"	
14" & 16"	
18" & 20"	
24"	
30"	
36"	
PRIVATE	
DRAWN	Doug Warrick
CHECKED	
APPROVED	
DATE	May, 1991
DATE	
DATE	

AQUA
Ohio.


PREPARED BY:
SERVICE CENTER-ENGINEERING DEPT.
6650 SOUTH AVE. BOARDMAN OHIO 44512

SCALE
200' 400' 800' 1600'

FILE NO.


DISTRIBUTION MATCHLINE MAP
STARK REGIONAL DIVISION

SHEET NO.
E1

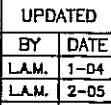

LINE LEGEND
4"
6"
8"
10" & 12"
14" & 16"
18" & 20"
24"
30"
36"

PRIVATE

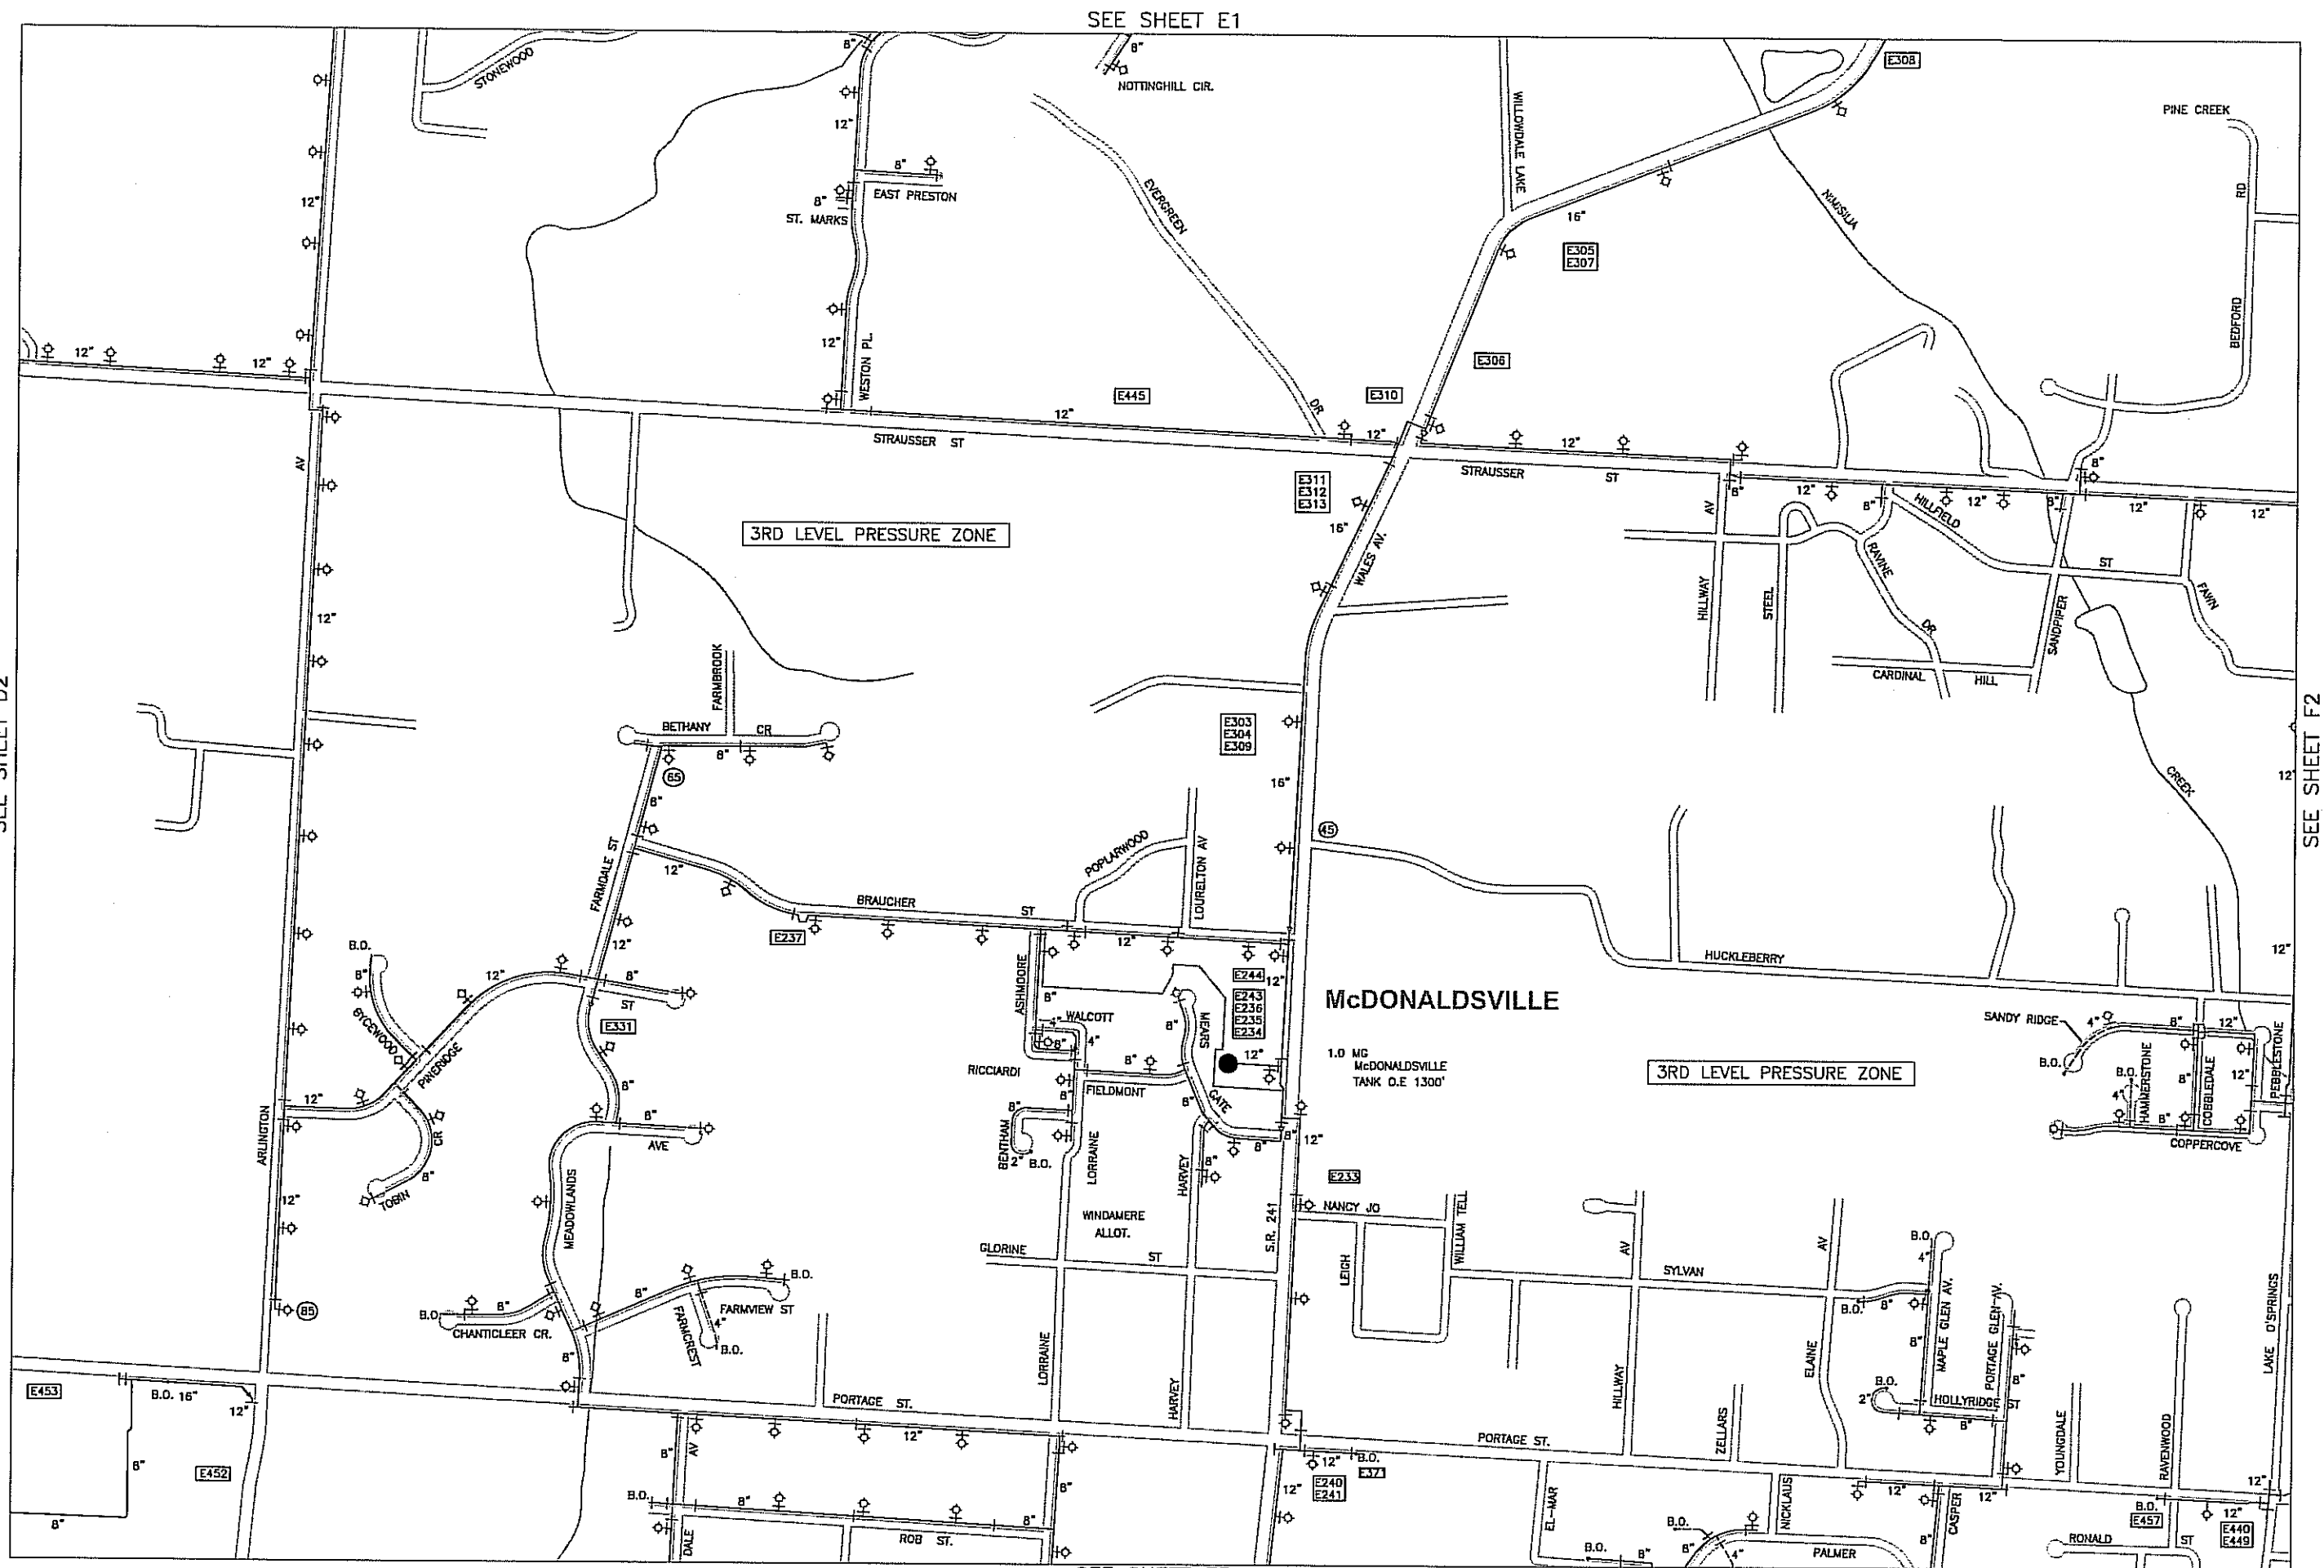

SEE SHEET E3

SCALE



FILE NO.


DISTRIBUTION MATCHLINE MAP
STARK REGIONAL DIVISION

SHEET NO.
E2

NORTH

SEE SHEET E2

UPDATED	BY	DATE
L.A.M.	1-04	
L.A.M.	2-05	

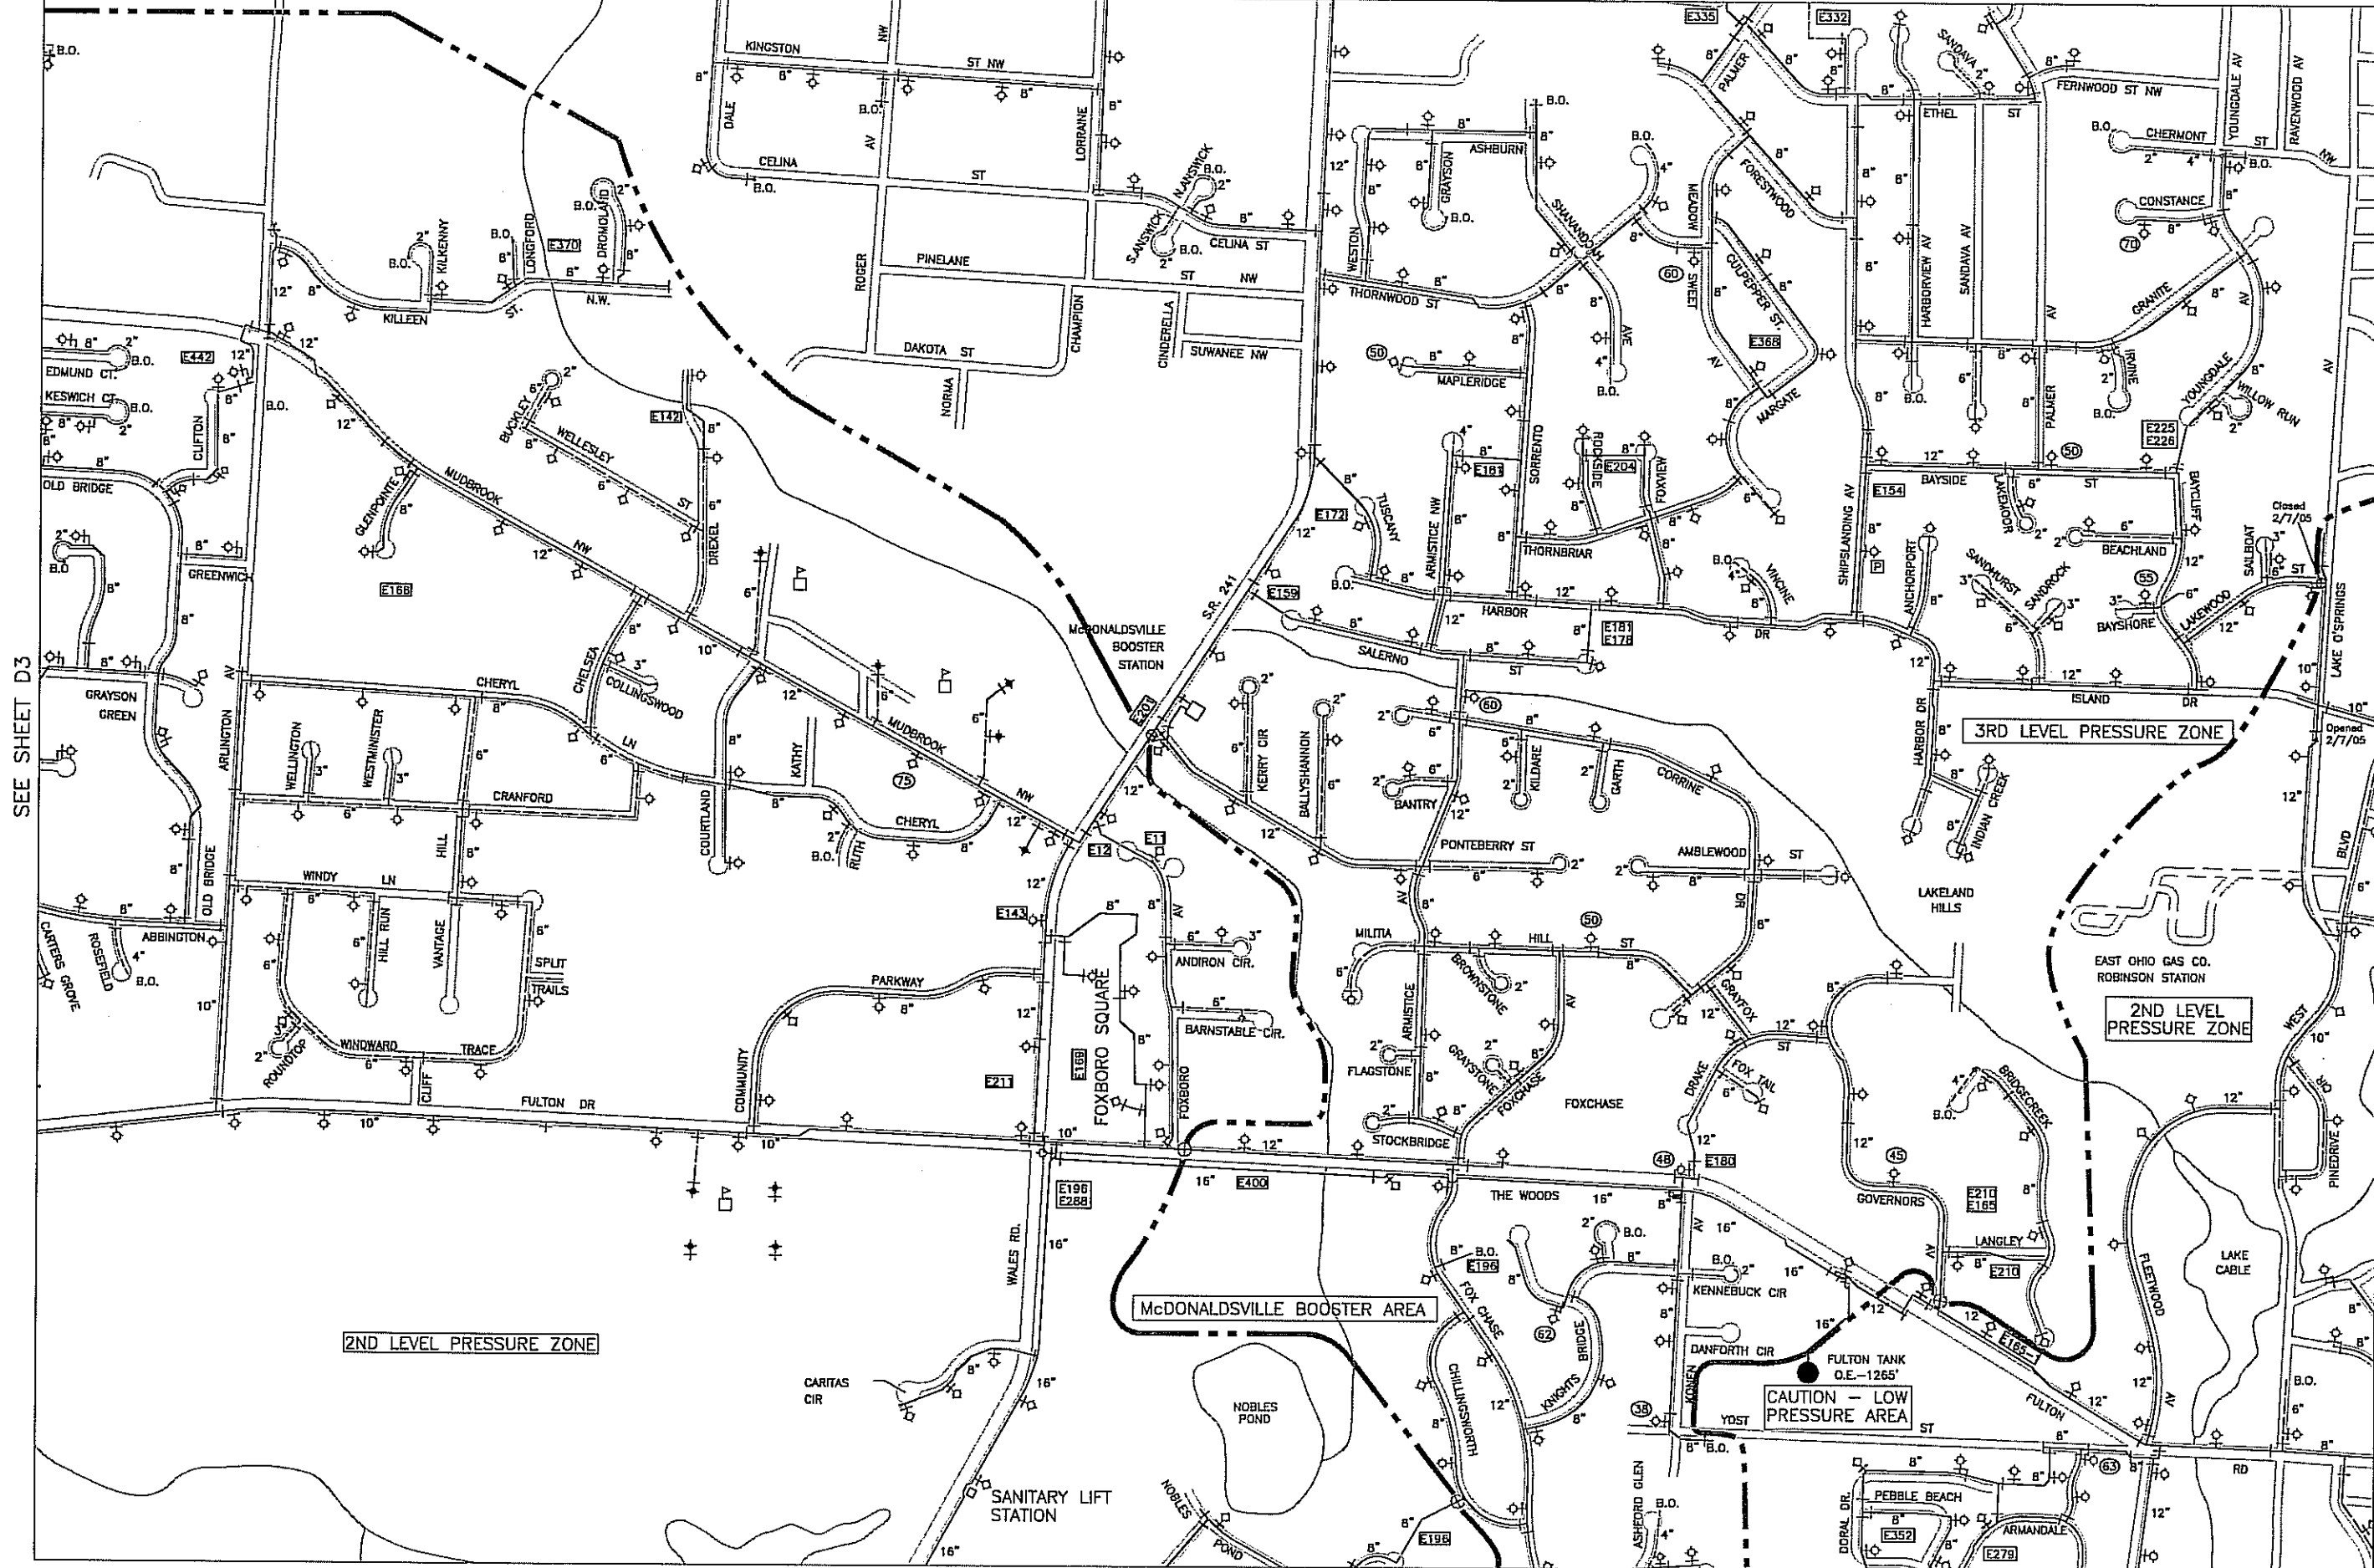


LINE LEGEND
3" & SMALLER
4"
6"
8"
10" & 12"
14" & 16"
18" & 20"
24"
30"
36"
PRIVATE

DRAWN	Doug Warrick	DATE	May, 1991
CHECKED		DATE	
APPROVED		DATE	


AQUA Ohio.

PREPARED BY:
SERVICE CENTER - ENGINEERING DEPT.
6650 SOUTH AVE. BOARDMAN OHIO 44512

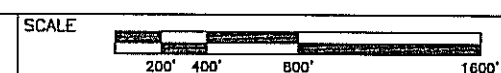


FILE NO.	DISTRIBUTION MATCHLINE MAP STARK REGIONAL DIVISION	SHEET NO. E3
----------	---	-----------------

NORTH

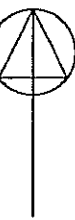

UPDATED	BY	DATE
L.A.M.	1-04	
L.A.M.	2-05	

SEE SHEET E3

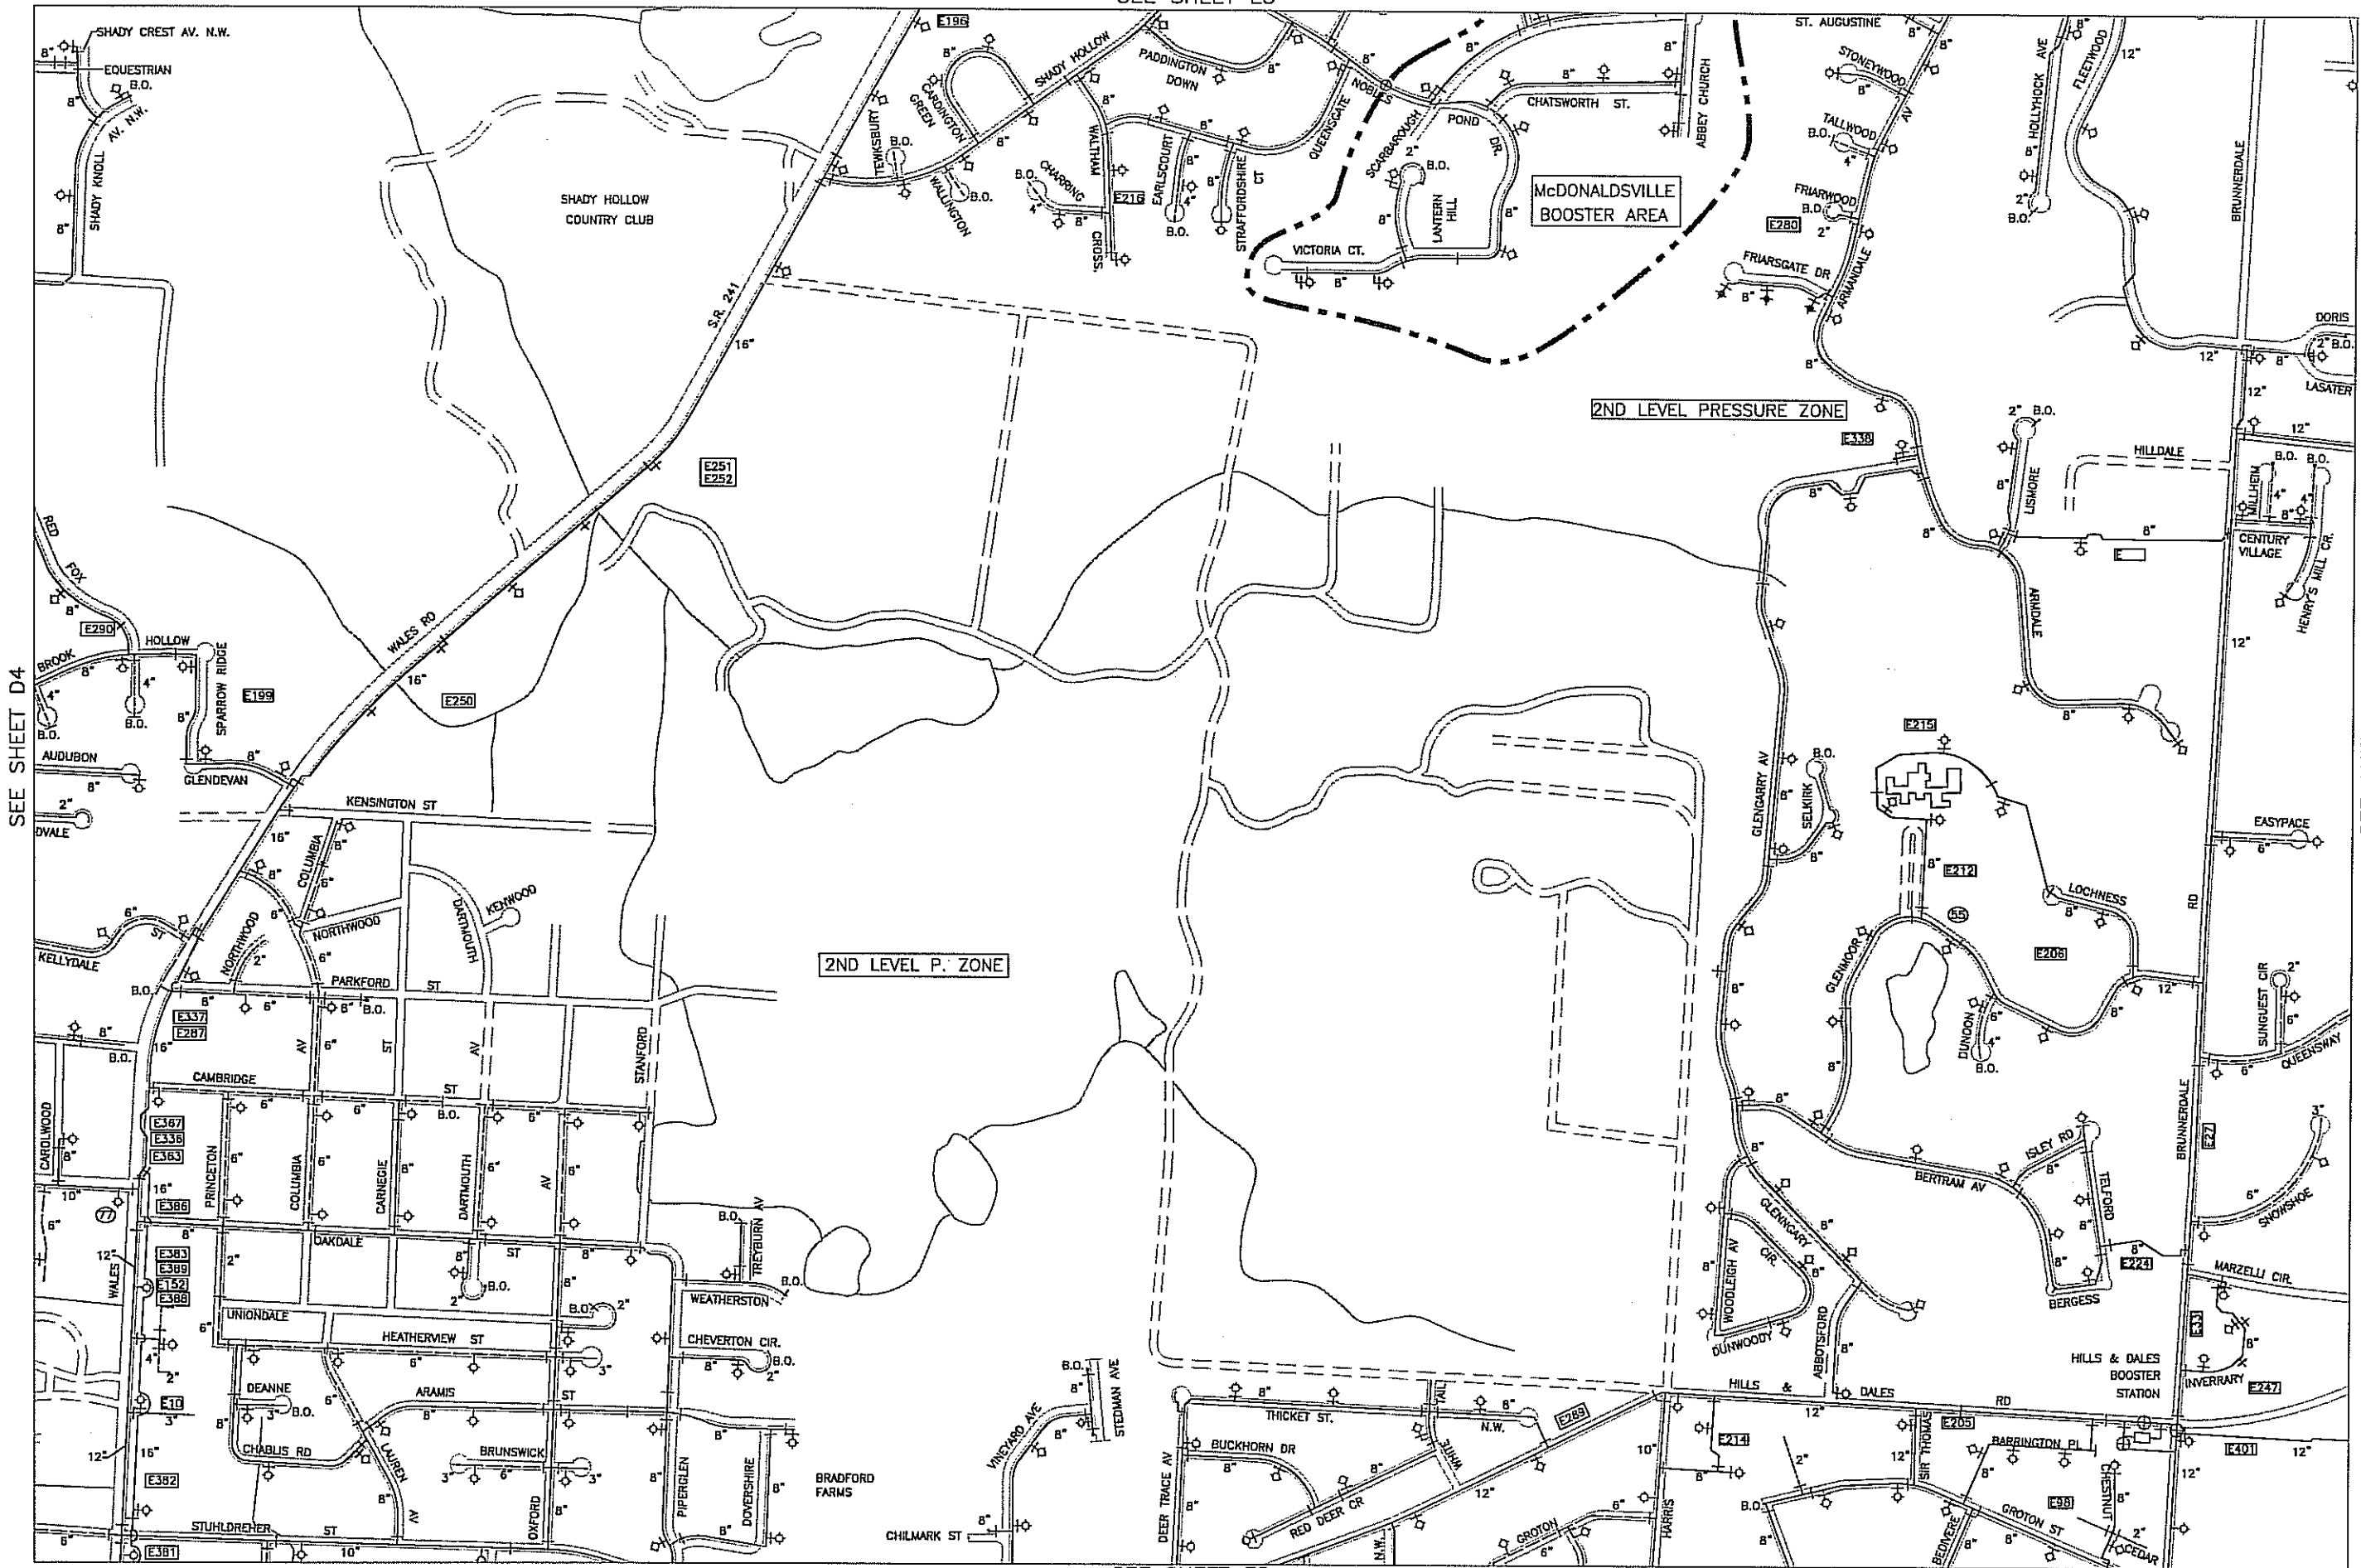

SEE SHEET D4

SEE SHEET F4


SEE SHEET E5

LINE LEGEND
3" & SMALLER
4"
6"
8"
10" & 12"
14" & 16"
18" & 20"
24"
30"
36"

DRAWN	Doug Warrick	DATE	May, 1997
CHECKED		DATE	
APPROVED		DATE	

AQUA
Ohio.

PREPARED BY:
SERVICE CENTER-ENGINEERING DEPT.
6650 SOUTH AVE. BOARDMAN OHIO 44512

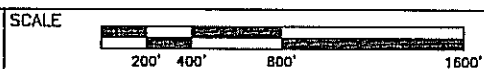


FILE NO.

DISTRIBUTION MATCHLINE MAP
STARK REGIONAL DIVISION


SHEET NO.
E4

NORTH

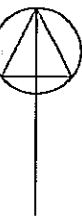

SEE SHEET E4

UPDATED	BY	DATE
L.A.M.	1-04	
L.A.M.	2-05	

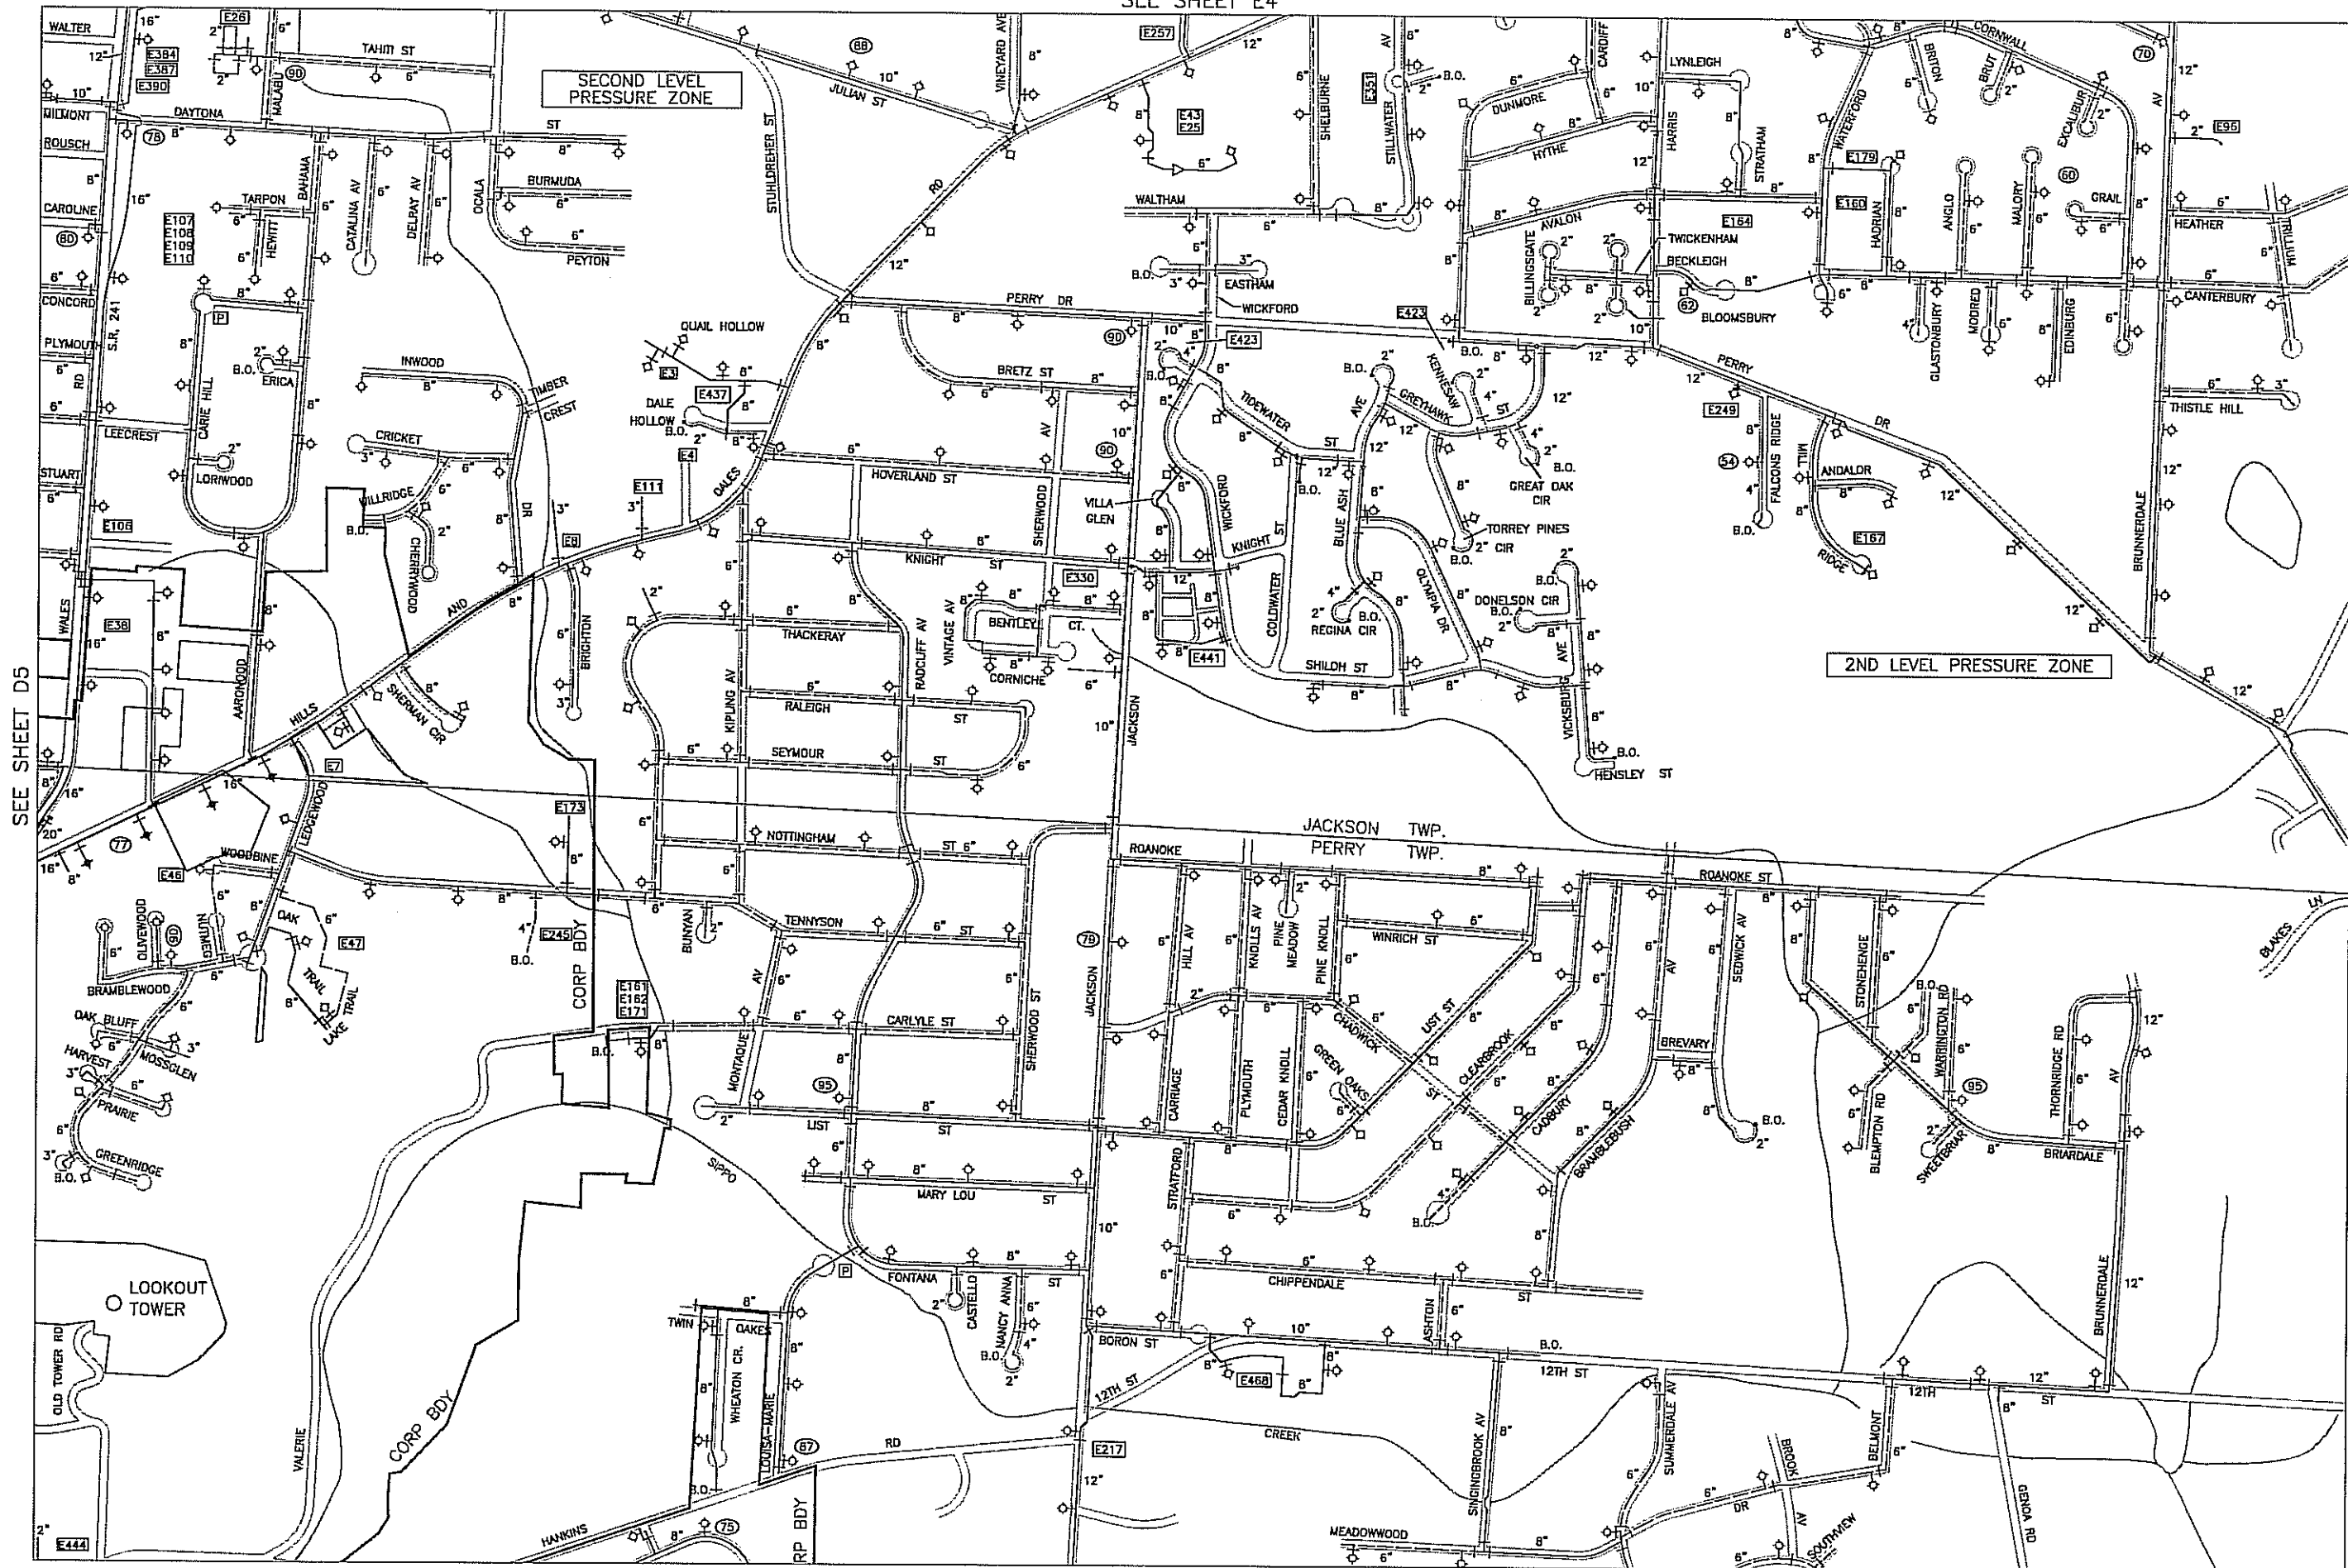

SEE SHEET D5

SEE SHEET F5


SEE SHEET E6

LINE LEGEND	
3" & SMALLER	
4"	
6"	
8"	
10" & 12"	
14" & 16"	
18" & 20"	
24"	
30"	
36"	

PRIVATE	DRAWN	DATE
	Doug Warrick	May, 1991
	CHECKED	
	DATE	
	APPROVED	
	DATE	

AQUA
Ohio.

PREPARED BY:
SERVICE CENTER-ENGINEERING DEPT.
6650 SOUTH AVE. BOARDMAN OHIO 44112

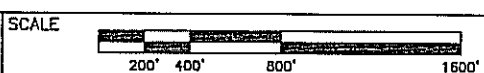

FILE NO.	DISTRIBUTION MATCHLINE MAP STARK REGIONAL DIVISION	SHEET NO. E5
----------	---	-----------------

NORTH

SEE SHEET E5

UPDATED
BY DATE
L.A.M. 1-04
L.A.M. 2-05

SEE SHEET D6

SEE SHEET F6

LINE LEGEND
3" & SMALLER
4"
6"
8"
10" & 12"
14" & 16"
18" & 20"
24"
30"
36"

PRIVATE
DRAWN
CHECKED
APPROVED

DATE May, 1991
DATE
DATE

AQUA
Ohio.

PREPARED BY:
SERVICE CENTER-ENGINEERING DEPT.
6650 SOUTH AVE. BOARDMAN OHIO 44512

SCALE



FILE NO.

DISTRIBUTION MATCHLINE MAP
STARK REGIONAL DIVISION


SHEET NO.
E6



NORTH

SEE SHEET E6

UPDATED	
BY	DATE
L.A.M.	1-04
L.A.M.	2-05

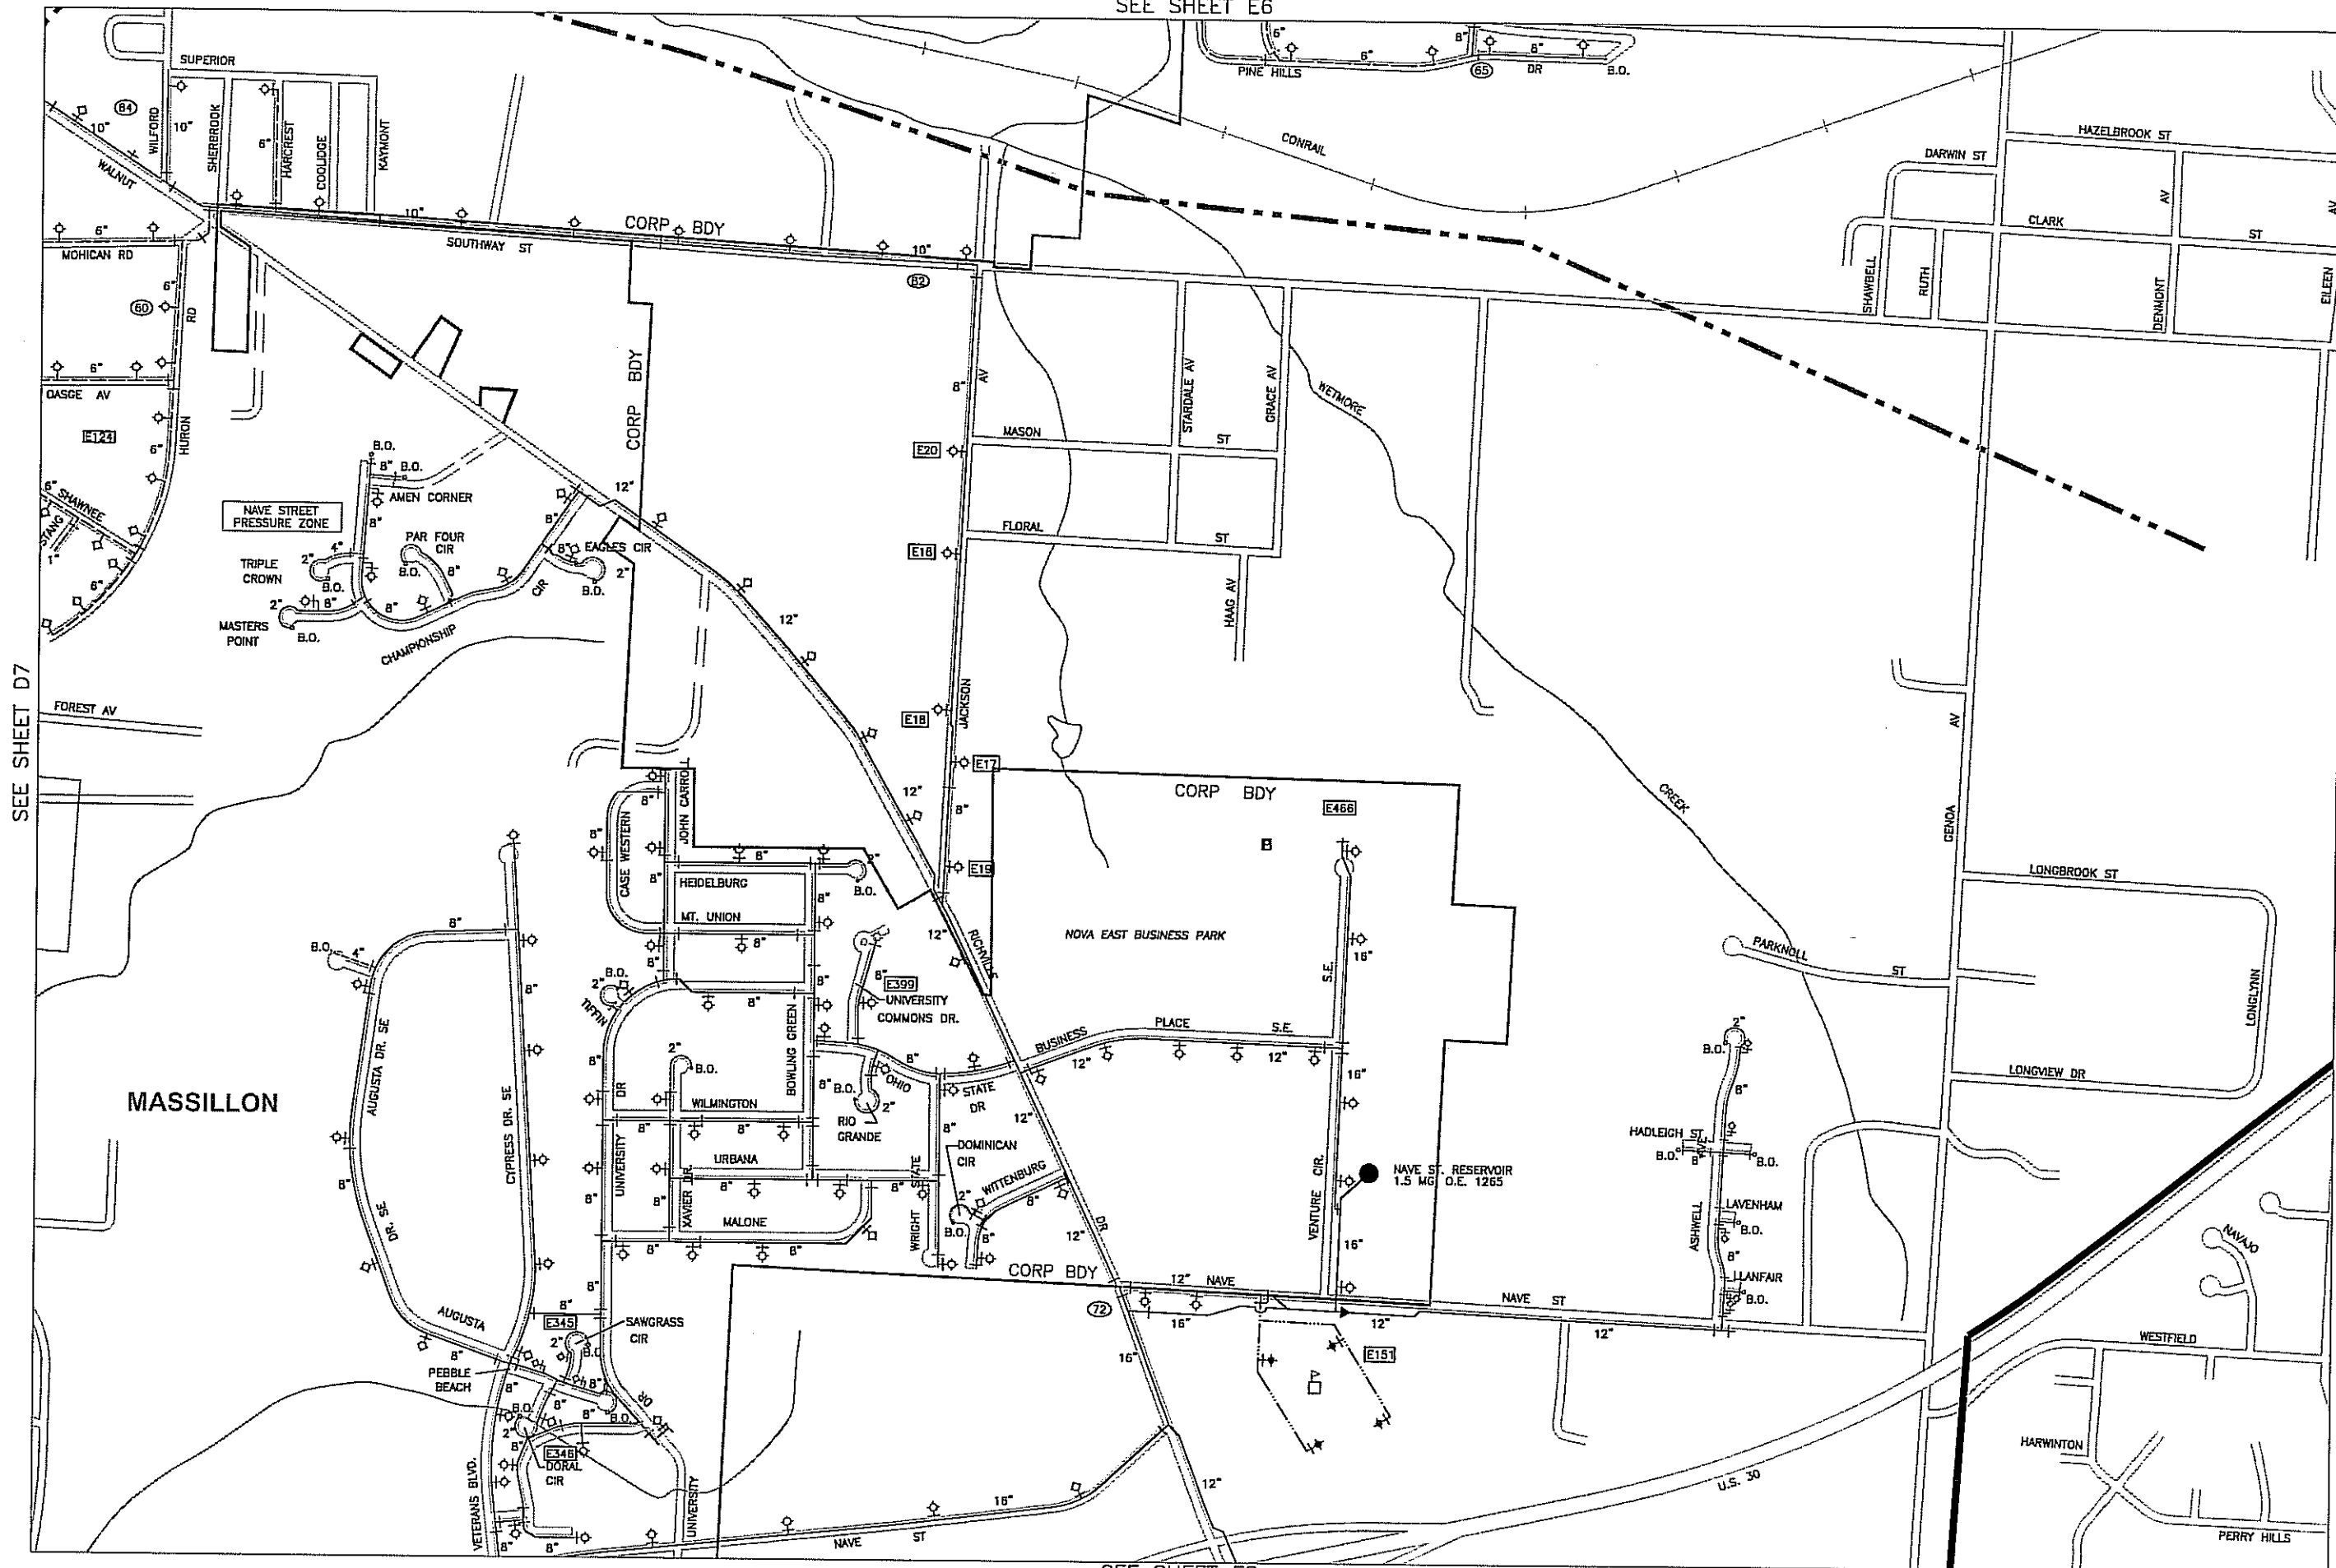

SEE SHEET D7

SEE SHEET F7


SEE SHEET E8

LINE LEGEND	
3" & SMALLER	
4"	
6"	
8"	
10" & 12"	
14" & 16"	
18" & 20"	
24"	
30"	
36"	
PRIVATE	

DRAWN	Doug Warrick	DATE	May, 1991
CHECKED		DATE	
APPROVED		DATE	

AQUA
Ohio

PREPARED BY:
SERVICE CENTER-ENGINEERING DEPT.
6650 SOUTH AVE. BOARDMAN OHIO 44512

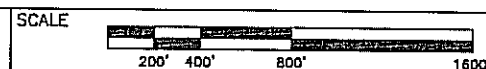

FILE NO.

DISTRIBUTION MATCHLINE MAP
STARK REGIONAL DIVISION

SHEET NO.
E7




SEE SHEET E9

SEE SHEET F8

SEE SHEET D8

LINE LEGEND
3" & SMALLER
4"
6"
8"
10" & 12"
14" & 16"
18" & 20"
24"
30"
36"
PRIVATE

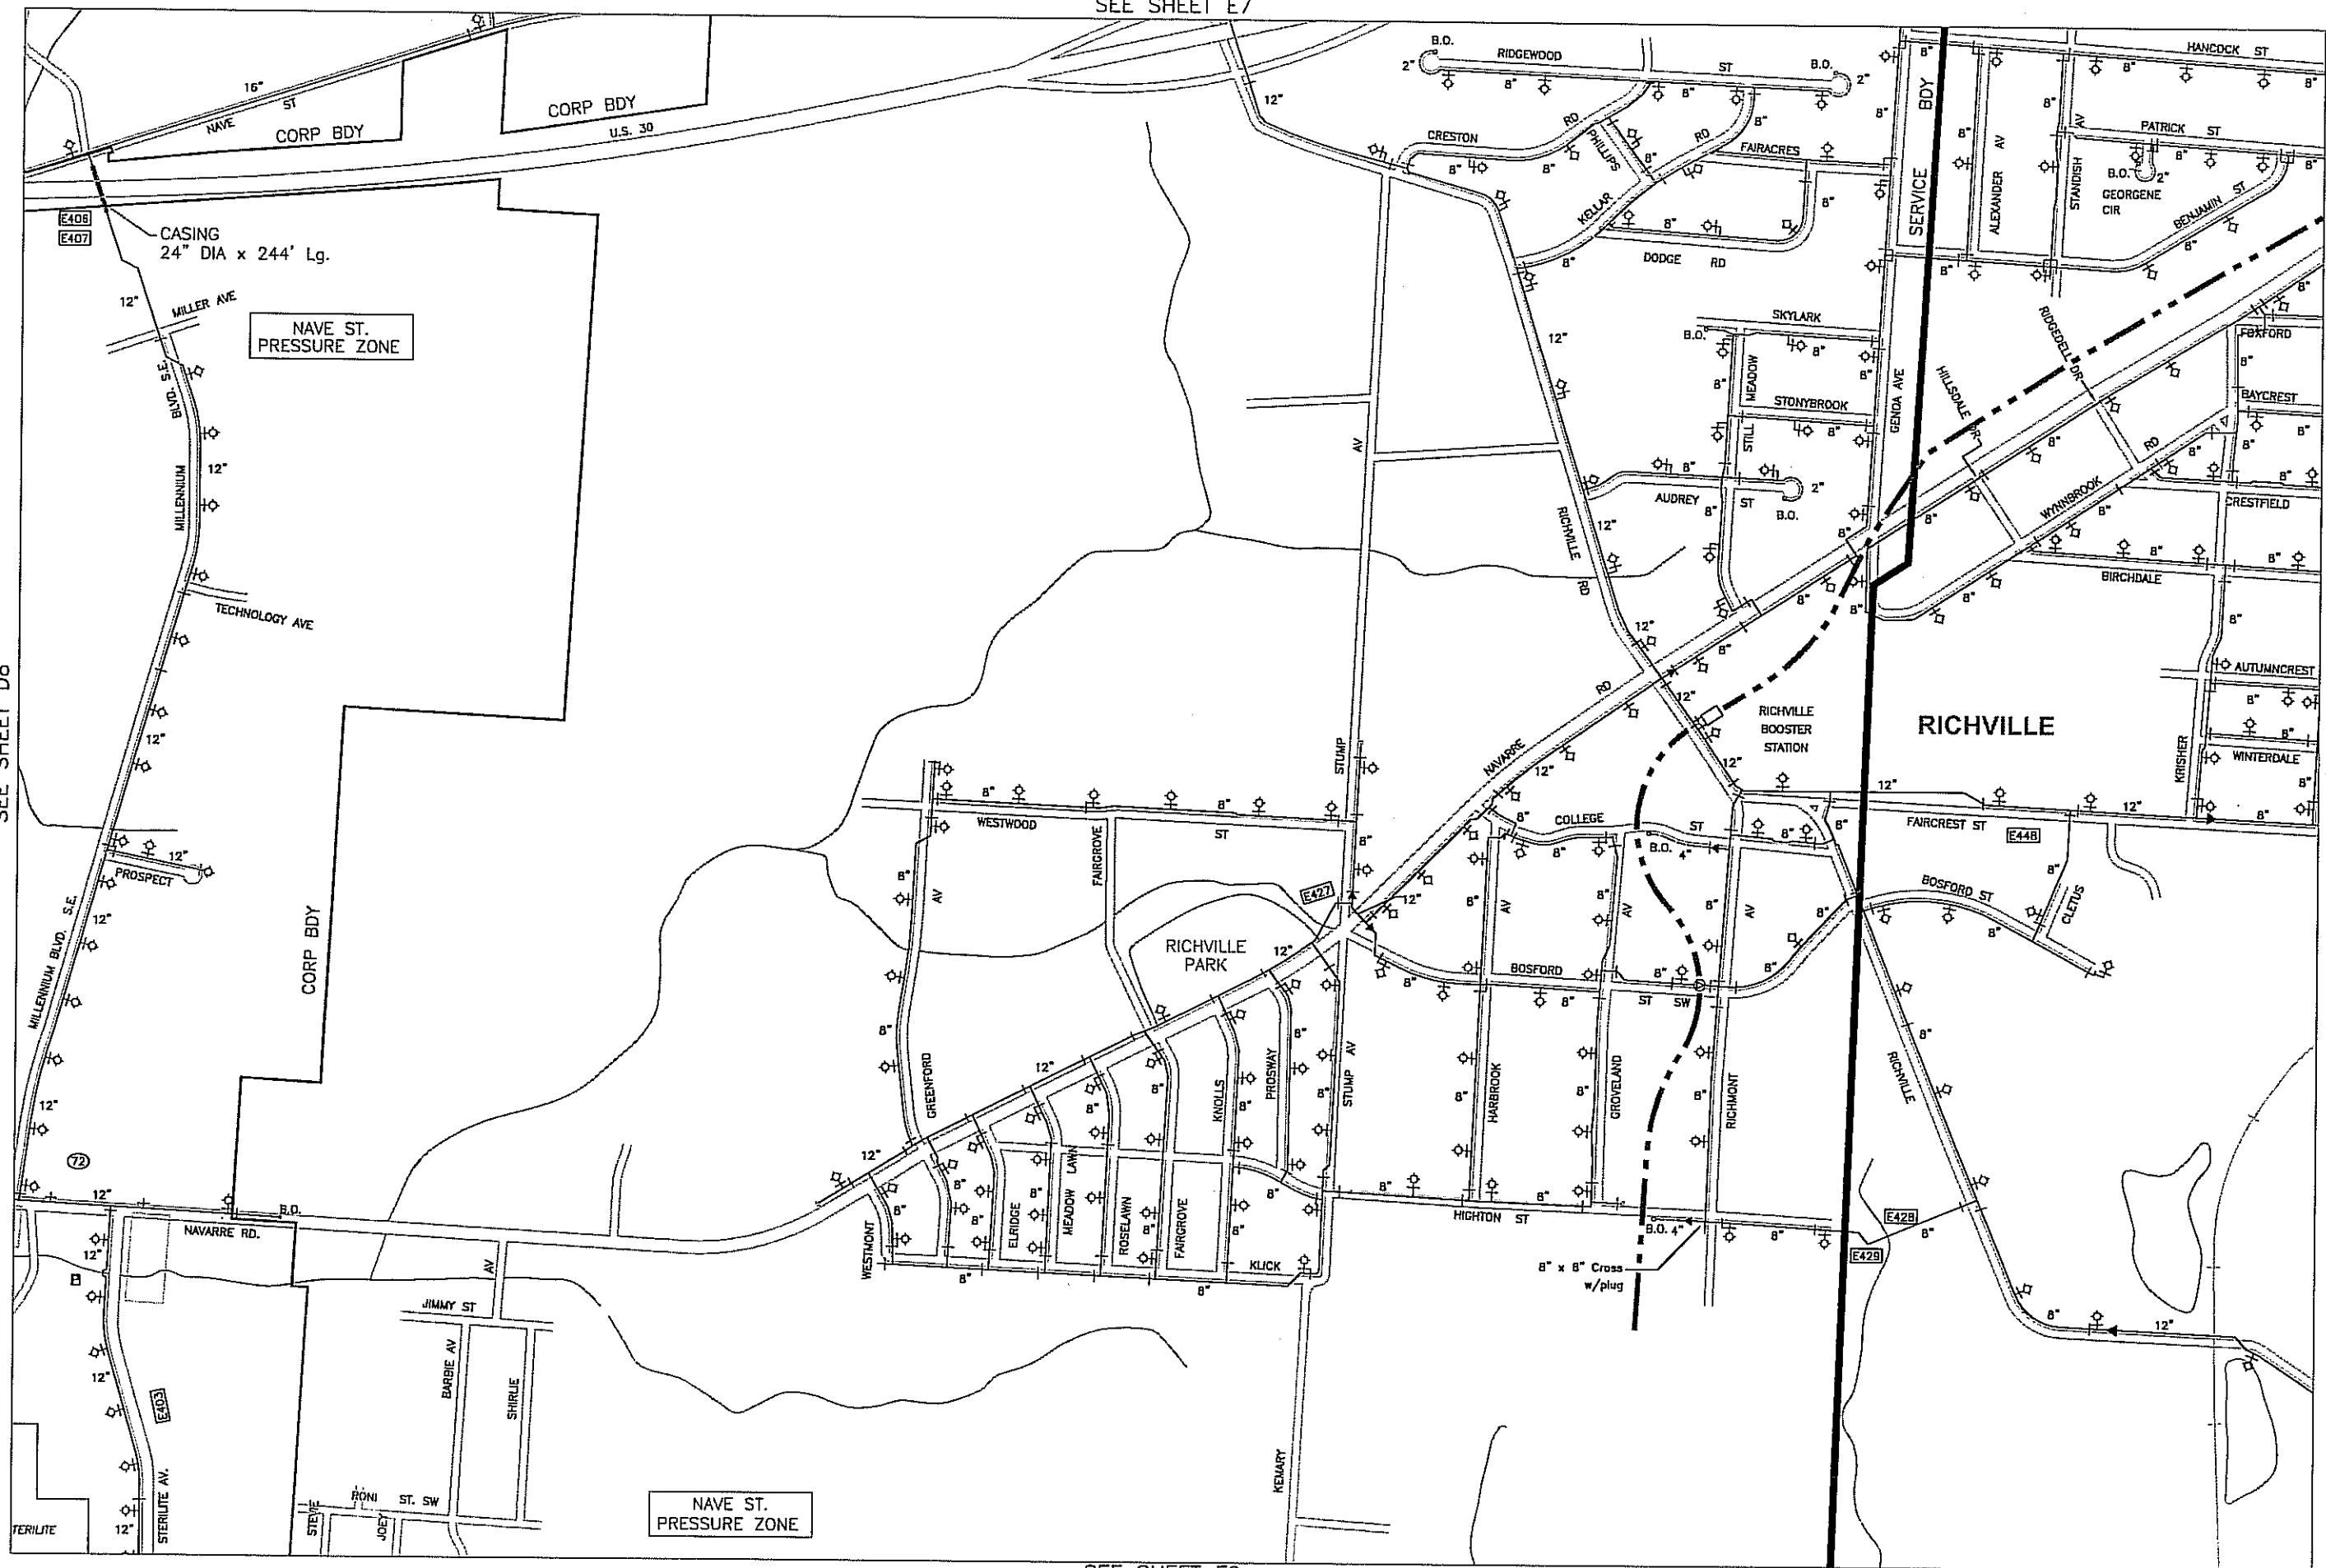

PREPARED BY:
SERVICE CENTER-ENGINEERING DEPT.
6650 SOUTH AVE. BOARDMAN OHIO 44512

SCALE




200' 400' 800' 1500'

FILE NO.

DISTRIBUTION MATCHLINE MAP
STARK REGIONAL DIVISION

SHEET NO.
E8

NORTH

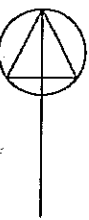

SEE SHEET E8

UPDATED

BY	DATE
L.A.M.	1-04
L.A.M.	2-05

SEE SHEET D9

SEE SHEET F9

LINE LEGEND

3" & SMALLER

4"

6"

8"

10" & 12"

14" & 16"

18" & 20"

24"

30"

36"

PRIVATE

DRAWN	<i>Doug Warrick</i>	DATE	<i>May, 1991</i>
CHECKED		DATE	
APPROVED		DATE	

AQUA
Ohio.

PREPARED BY:
SERVICE CENTER-ENGINEERING DEPT.
6650 SOUTH AVE. BOARDMAN OHIO 44512

SCALE



FILE NO.

DISTRIBUTION MATCHLINE MAP
STARK REGIONAL DIVISION

SHEET NO.

E9

NORTH



UPDATED

BY DATE

L.A.M. 1-04

L.A.M. 2-05

SEE SHEET E-3

LINE LEGEND

3" & SMALLER

4"

6"

8"

10" & 12"

14" & 16"

18" & 20"

24"

30"

36"

SEE SHEET F-2

PRIVATE

CHECKED

APPROVED

DRAWN *Doug Warrick*

CHECKED

APPROVED

DATE *May, 1991*

DATE

DATE

AQUA
Ohio.

PREPARED BY:
SERVICE CENTER-ENGINEERING DEPT.
6650 SOUTH AVE. BOARDMAN OHIO 44512

SCALE



FILE NO.


DISTRIBUTION MATCHLINE MAP
STARK REGIONAL DIVISION

SHEET NO.
F-3

[illegible]

SEE SHEET EO

SEE SHEET GO

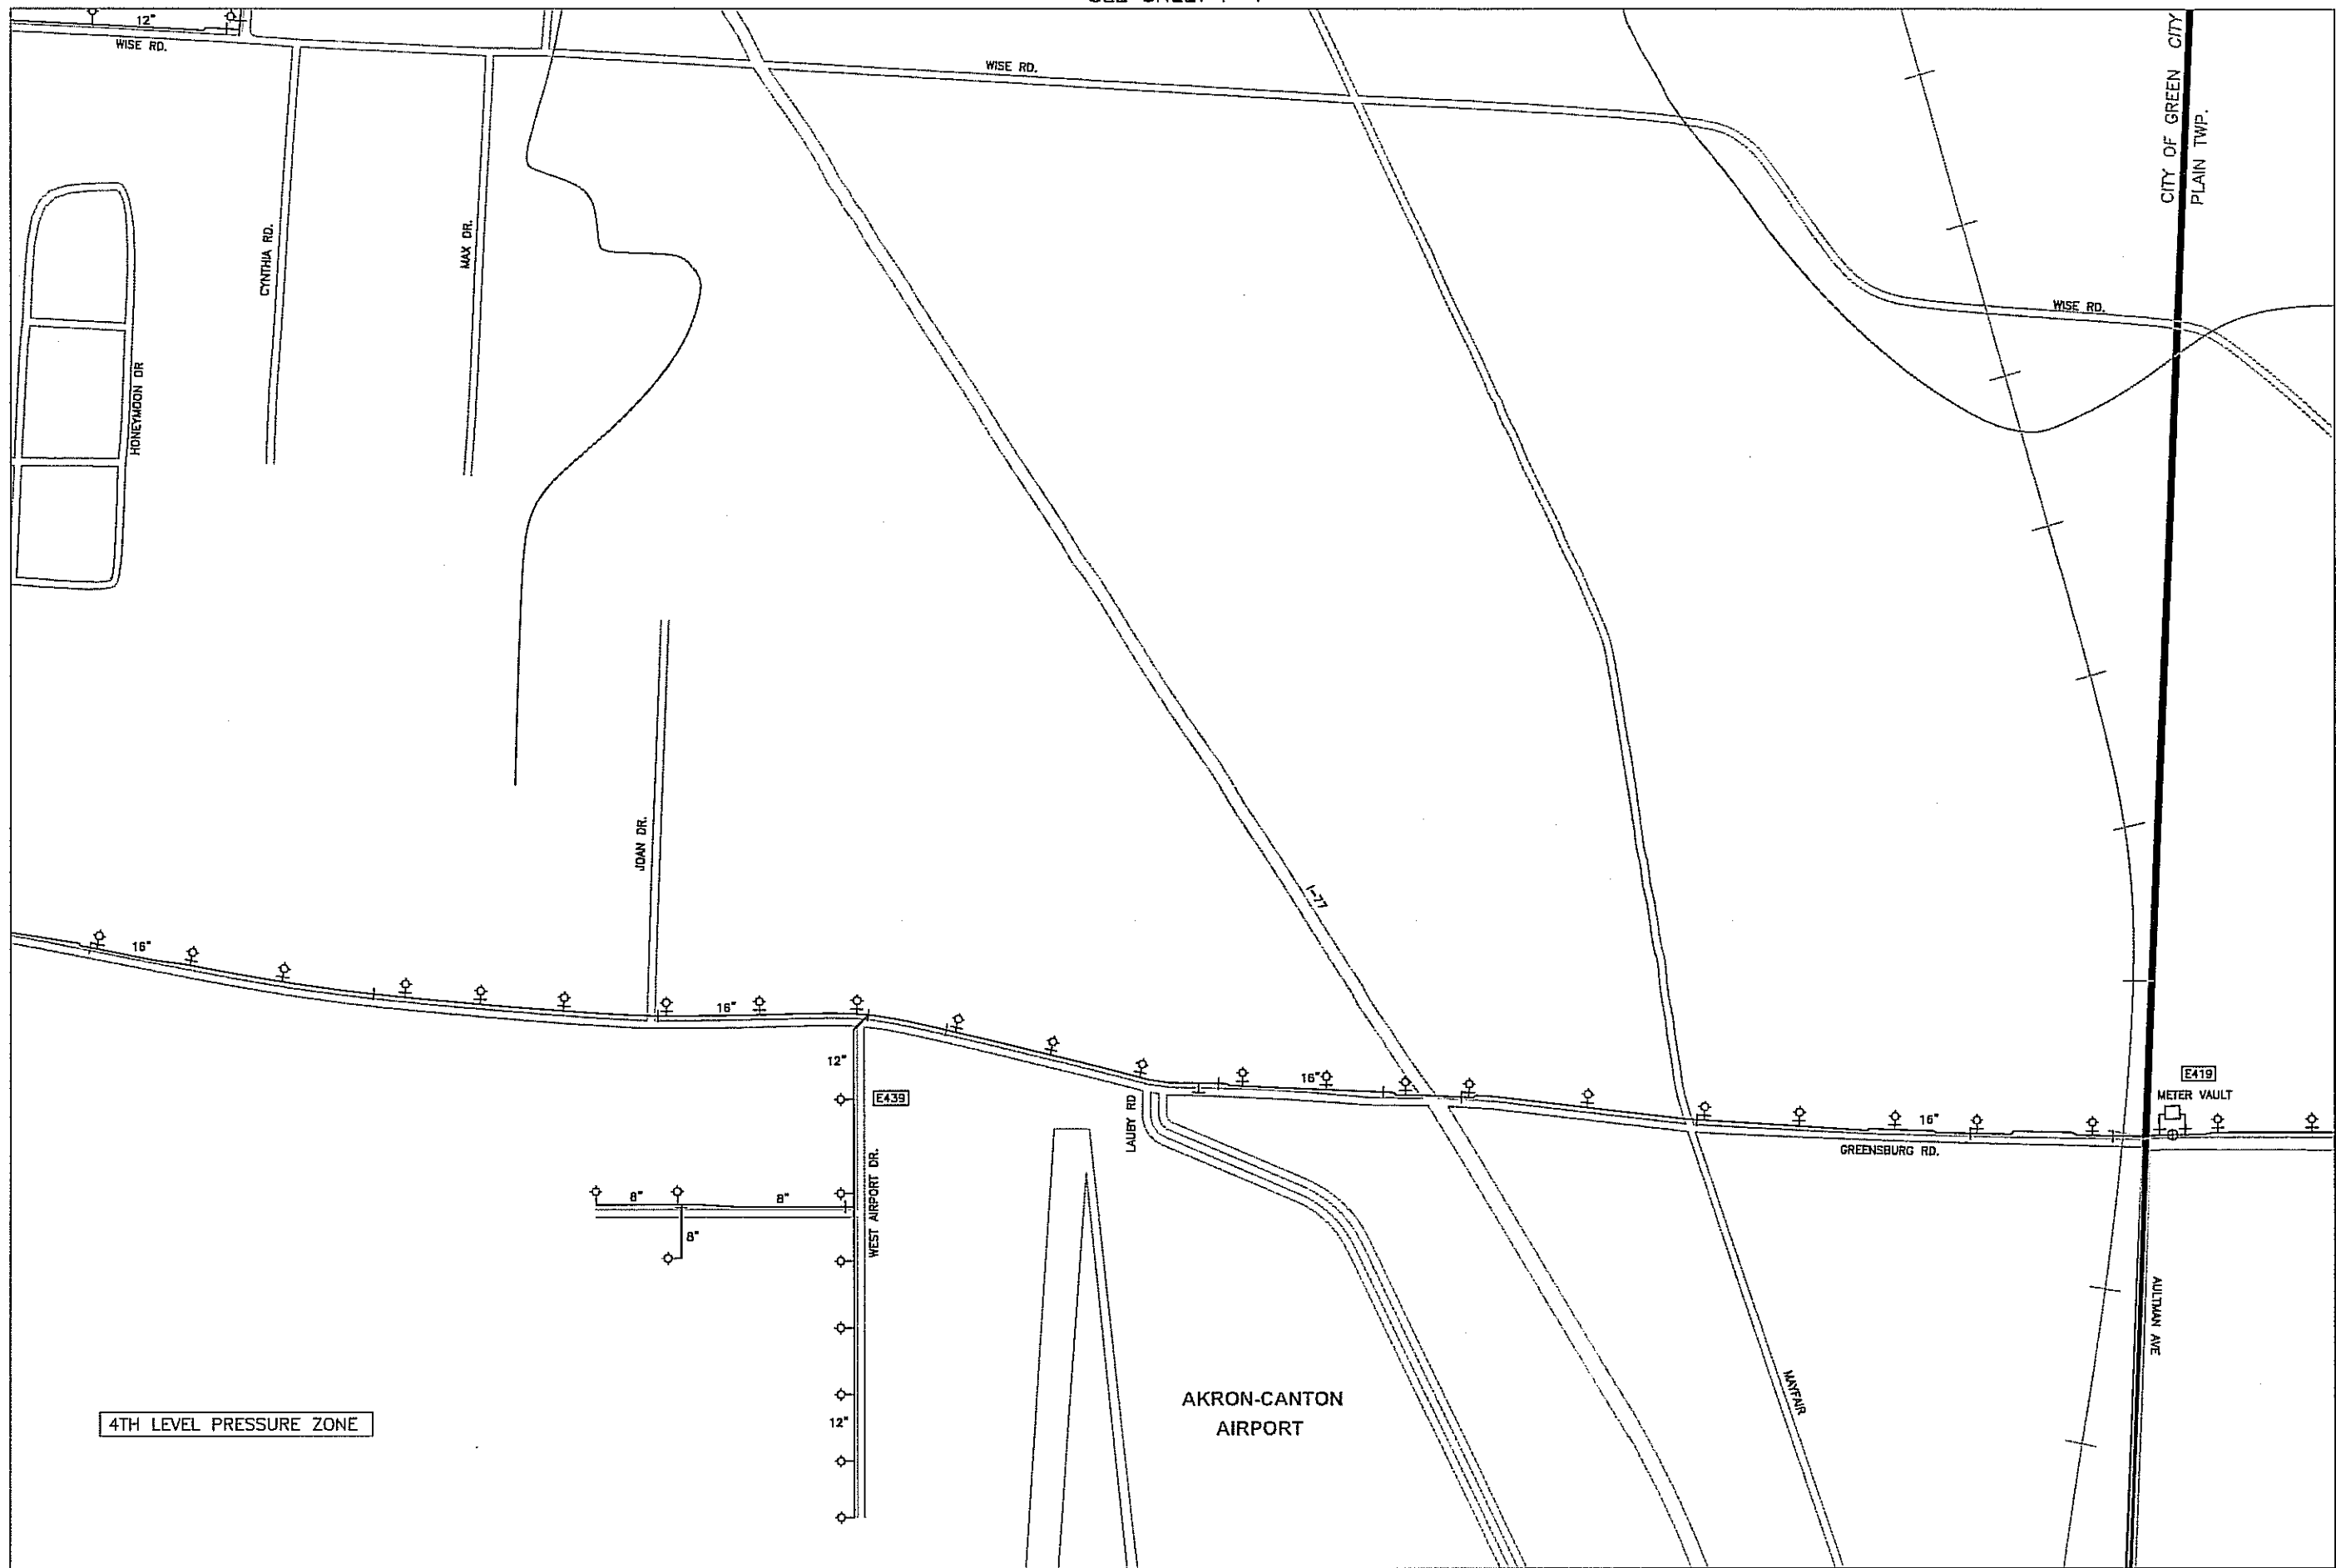

SCALE



DISTRIBUTION MATCHLINE MAP
STARK REGIONAL DIVISION

SHEET NO.
FO

PREPARED BY:
SERVICE CENTER-ENGINEERING DEPT.
6650 SOUTH AVE. BOARDMAN OHIO 44512


NORTH



UPDATED
BY DATE
L.A.M. 1-04
L.A.M. 2-05

LINE LEGEND	
3" & SMALLER	
4"	
6"	
8"	
10" & 12"	
14" & 16"	
18" & 20"	
24"	
30"	
36"	
PRIVATE	

SEE SHEET E1

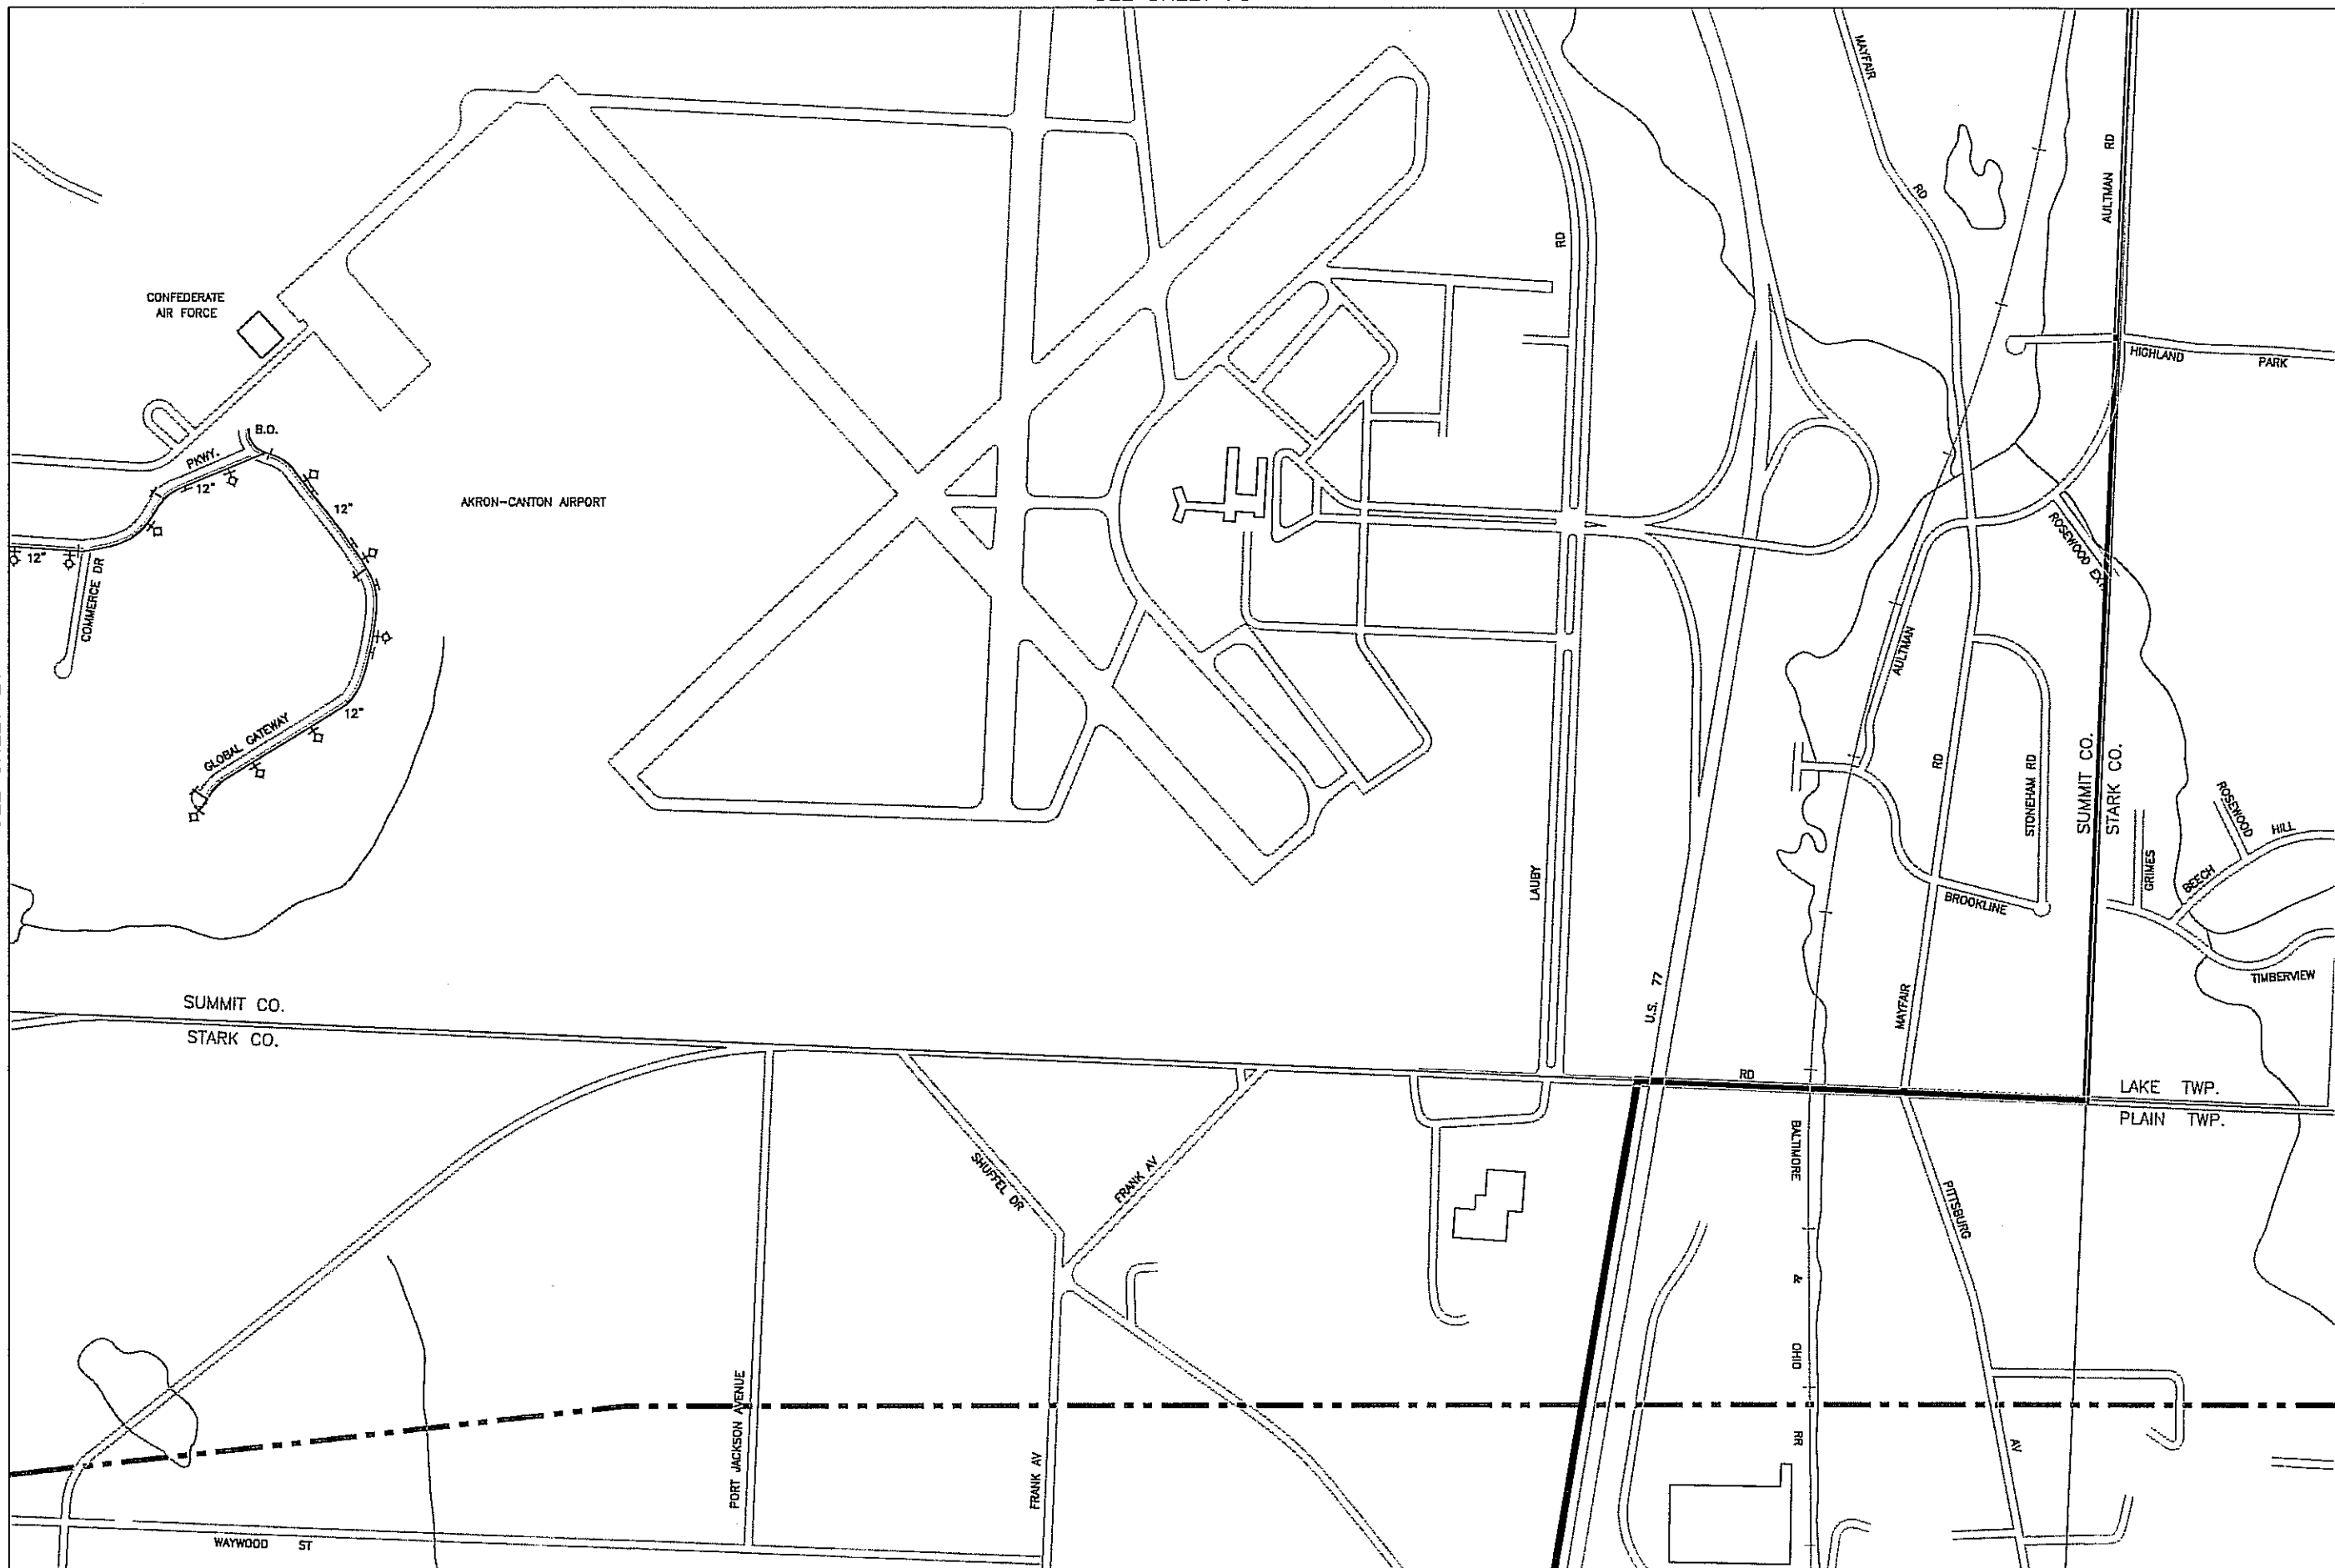

SEE SHEET G1

DRAWN	Doug Warrick	DATE	May, 1991
CHECKED		DATE	
APPROVED		DATE	

AQUA
Ohio.

PREPARED BY:
SERVICE CENTER-ENGINEERING DEPT.
6650 SOUTH AVE. BOARDMAN OHIO 44512



FILE NO.

DISTRIBUTION MATCHLINE MAP
STARK REGIONAL DIVISION

SHEET NO.
F1

NORTH



UPDATED

BY DATE

L.A.M. 1-04

L.A.M. 2-05

SEE SHEET E2



SEE SHEET G2

SEE SHEET F3

LINE LEGEND	
3" & SMALLER	
4"	
6"	
8"	
10" & 12"	
14" & 16"	
18" & 20"	
24"	
30"	
36"	

PRIVATE	DRAWN <i>Doug Warrick</i>	DATE <i>May, 1991</i>
	CHECKED	DATE
	APPROVED	DATE

AQUA
Ohio.

PREPARED BY:
SERVICE CENTER-ENGINEERING DEPT.
6650 SOUTH AVE. BOARDMAN OHIO 44512

SCALE



FILE NO.

DISTRIBUTION MATCHLINE MAP
STARK REGIONAL DIVISION

SHEET NO.
F2

NORTH



UPDATED
BY DATE
L.A.M. 1-04
L.A.M. 2-05

LINE LEGEND

3" & SMALLER

4"

6"

8"

10" & 12"

14" & 16"

18" & 20"


24"


30"

36"

PRIVATE

SEE SHEET E3

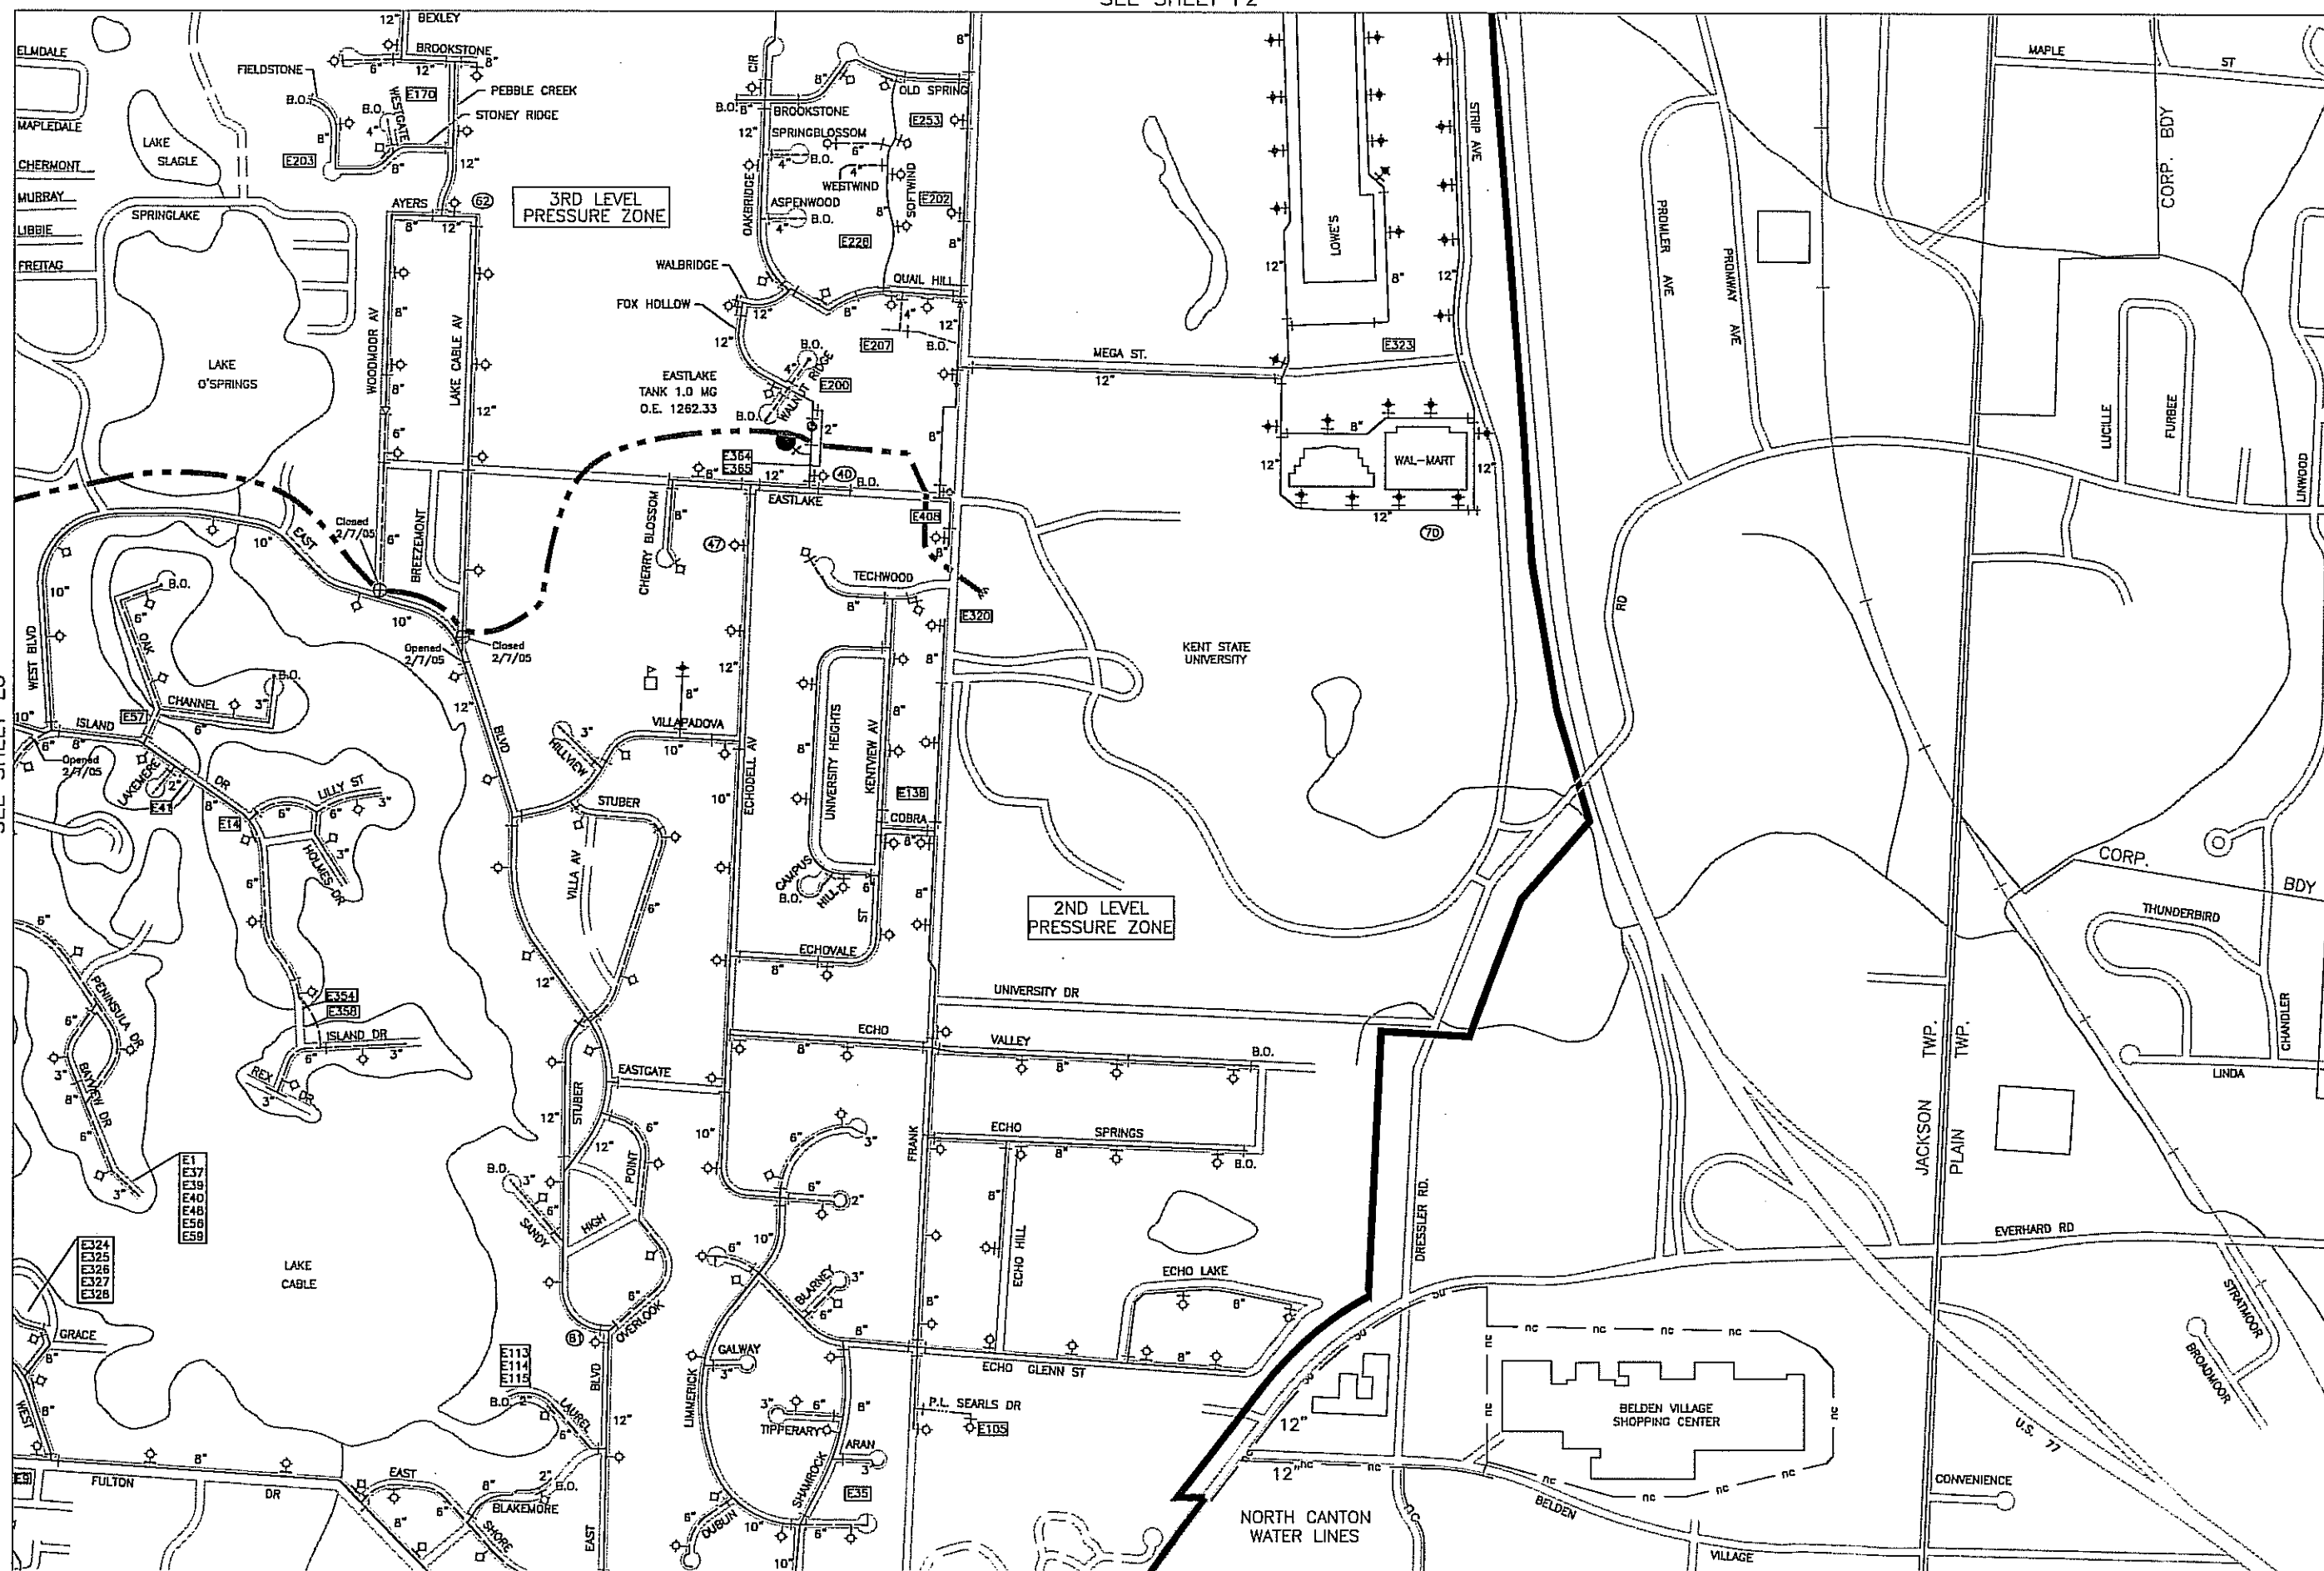

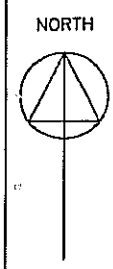


UPDATED	
BY	DATE
L.A.M.	1-04
L.A.M.	2-05

LINE LEGEND	
3" & SMALLER	
4"	
6"	
8"	
10" & 12"	
14" & 16"	
18" & 20"	
24"	
30"	
36"	
PRIVATE	

SEE SHEET E4

SEE SHEET F3


SEE SHEET F5

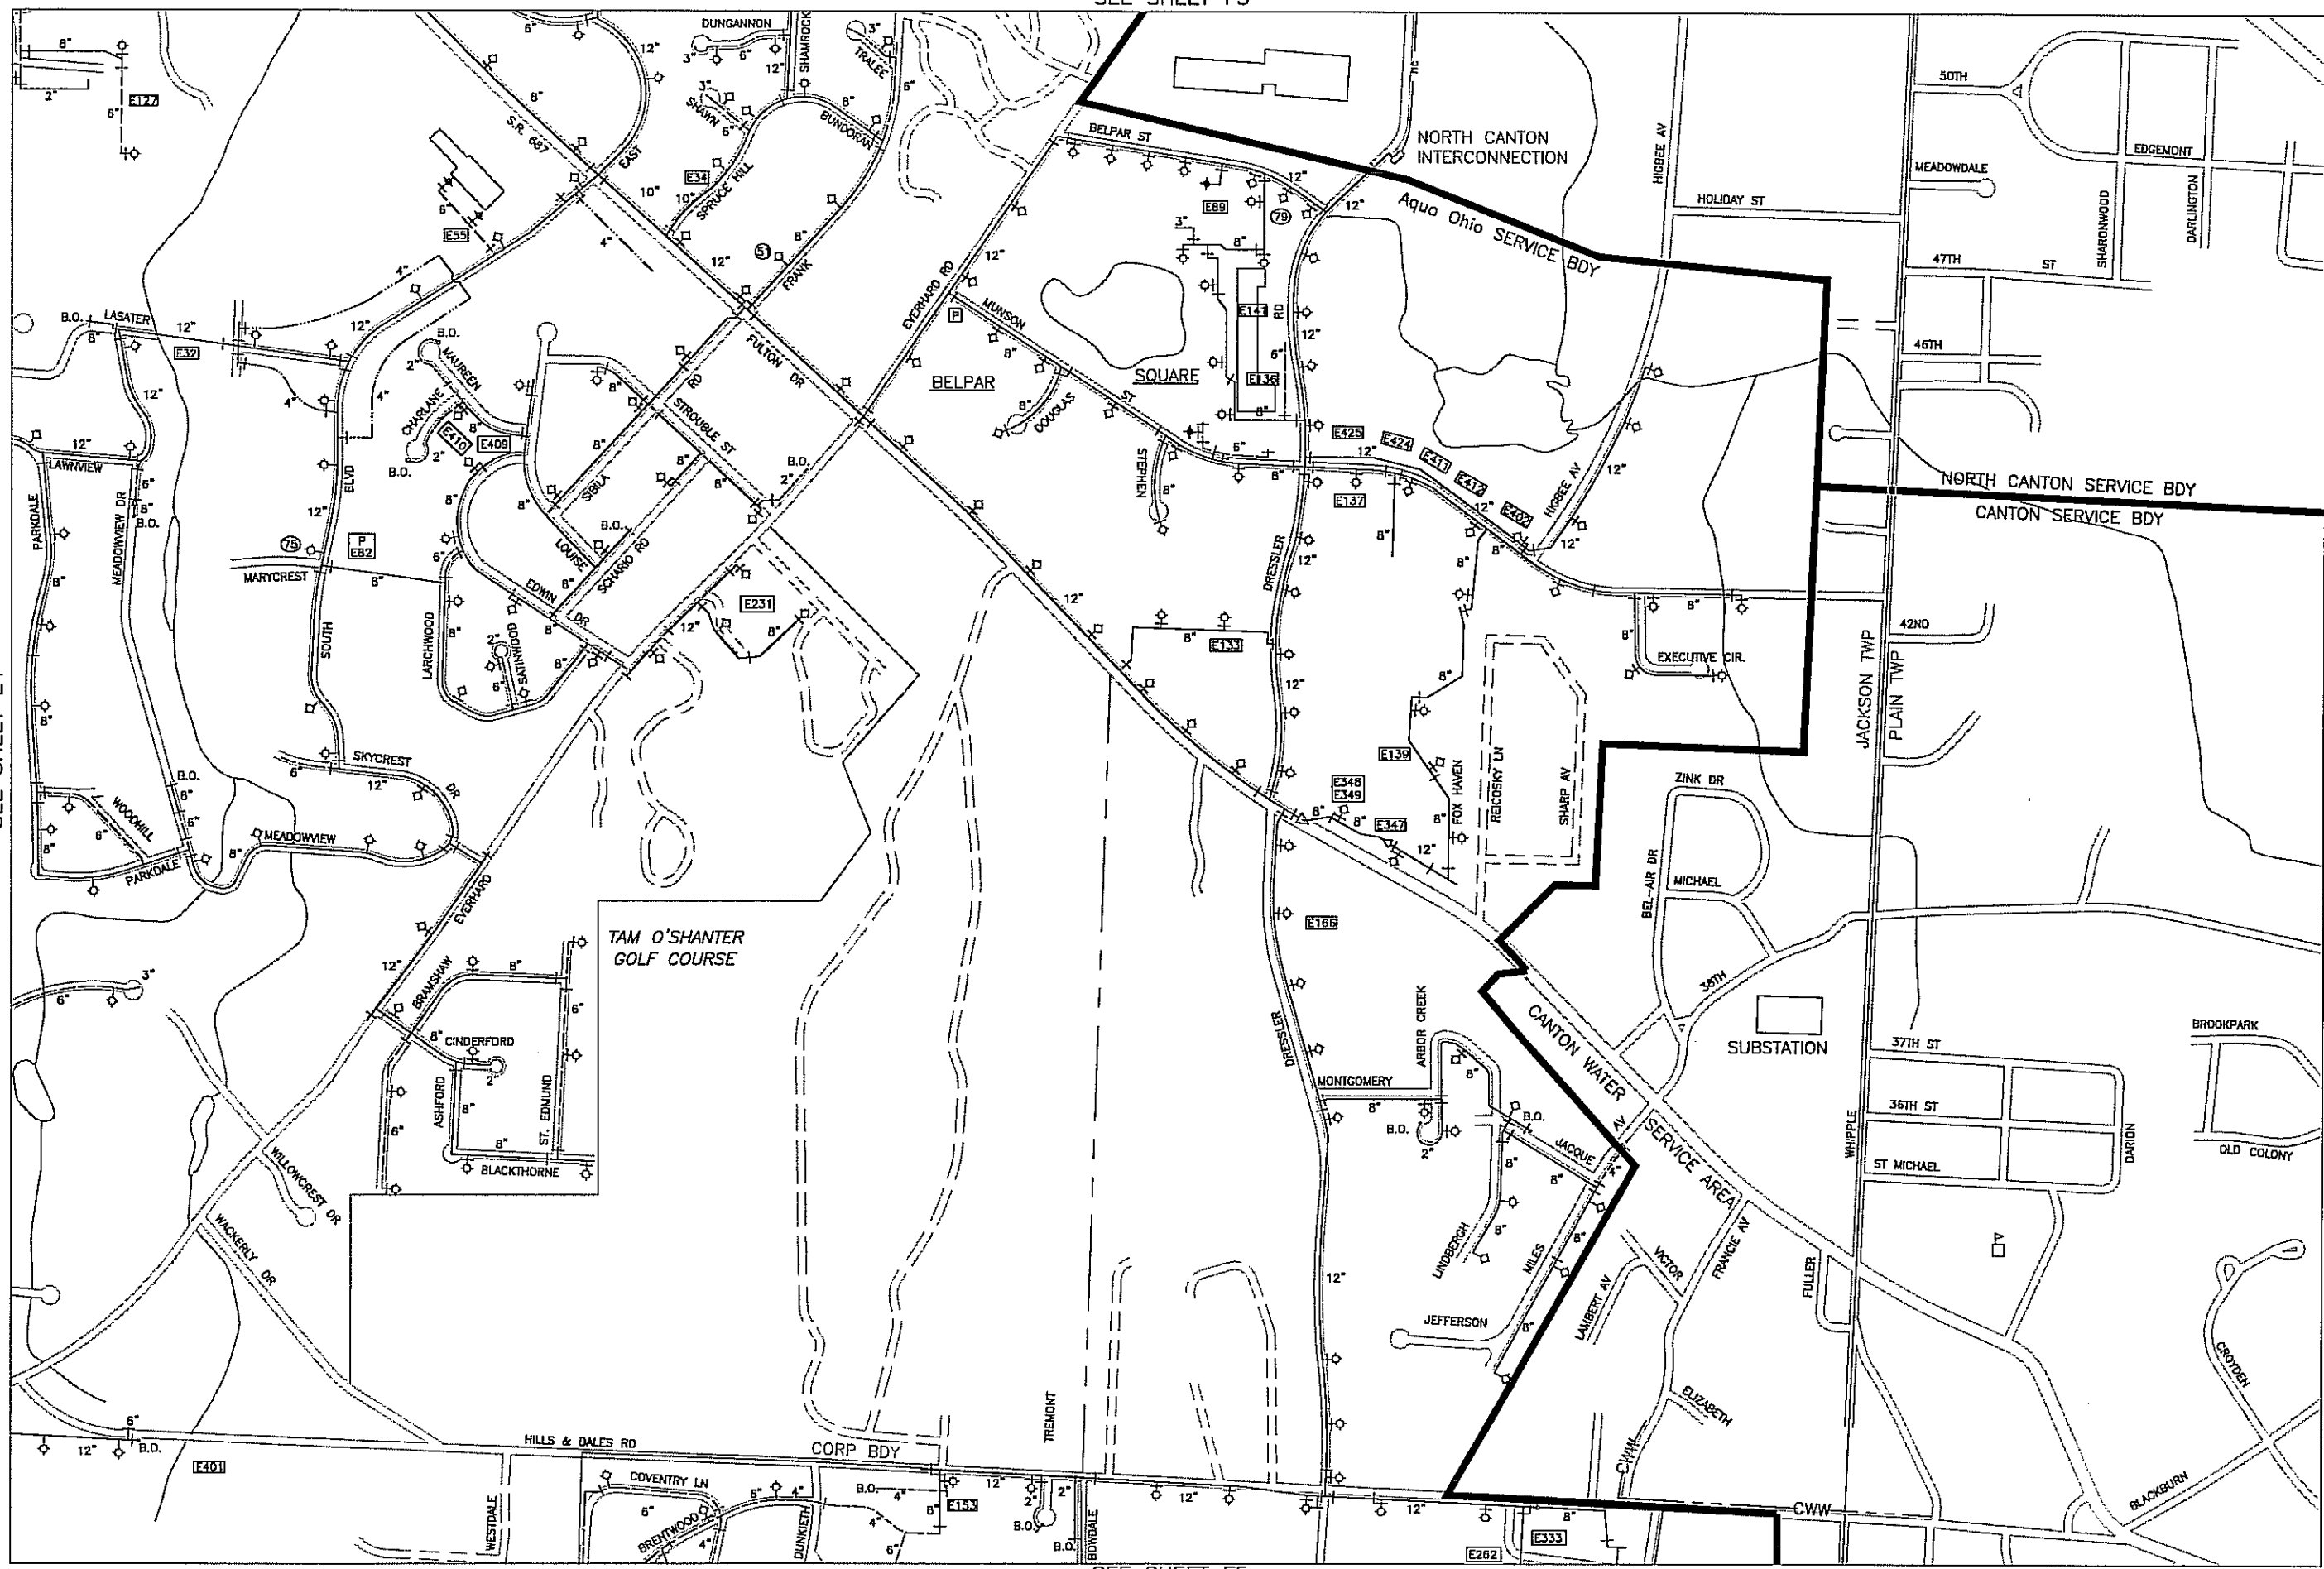

DRAWN	Doug Warrick	DATE	May, 1991
CHECKED		DATE	
APPROVED		DATE	

AQUA
Ohio.

PREPARED BY:
SERVICE CENTER-ENGINEERING DEPT.
6650 SOUTH AVE. BOARDMAN OHIO 44512

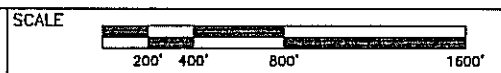

FILE NO.


DISTRIBUTION MATCHLINE MAP
STARK REGIONAL DIVISION

SHEET NO.
F4

NORTH

SEE SHEET F4

UPDATED	BY	DATE
L.A.M.	1-04	
L.A.M.	2-05	

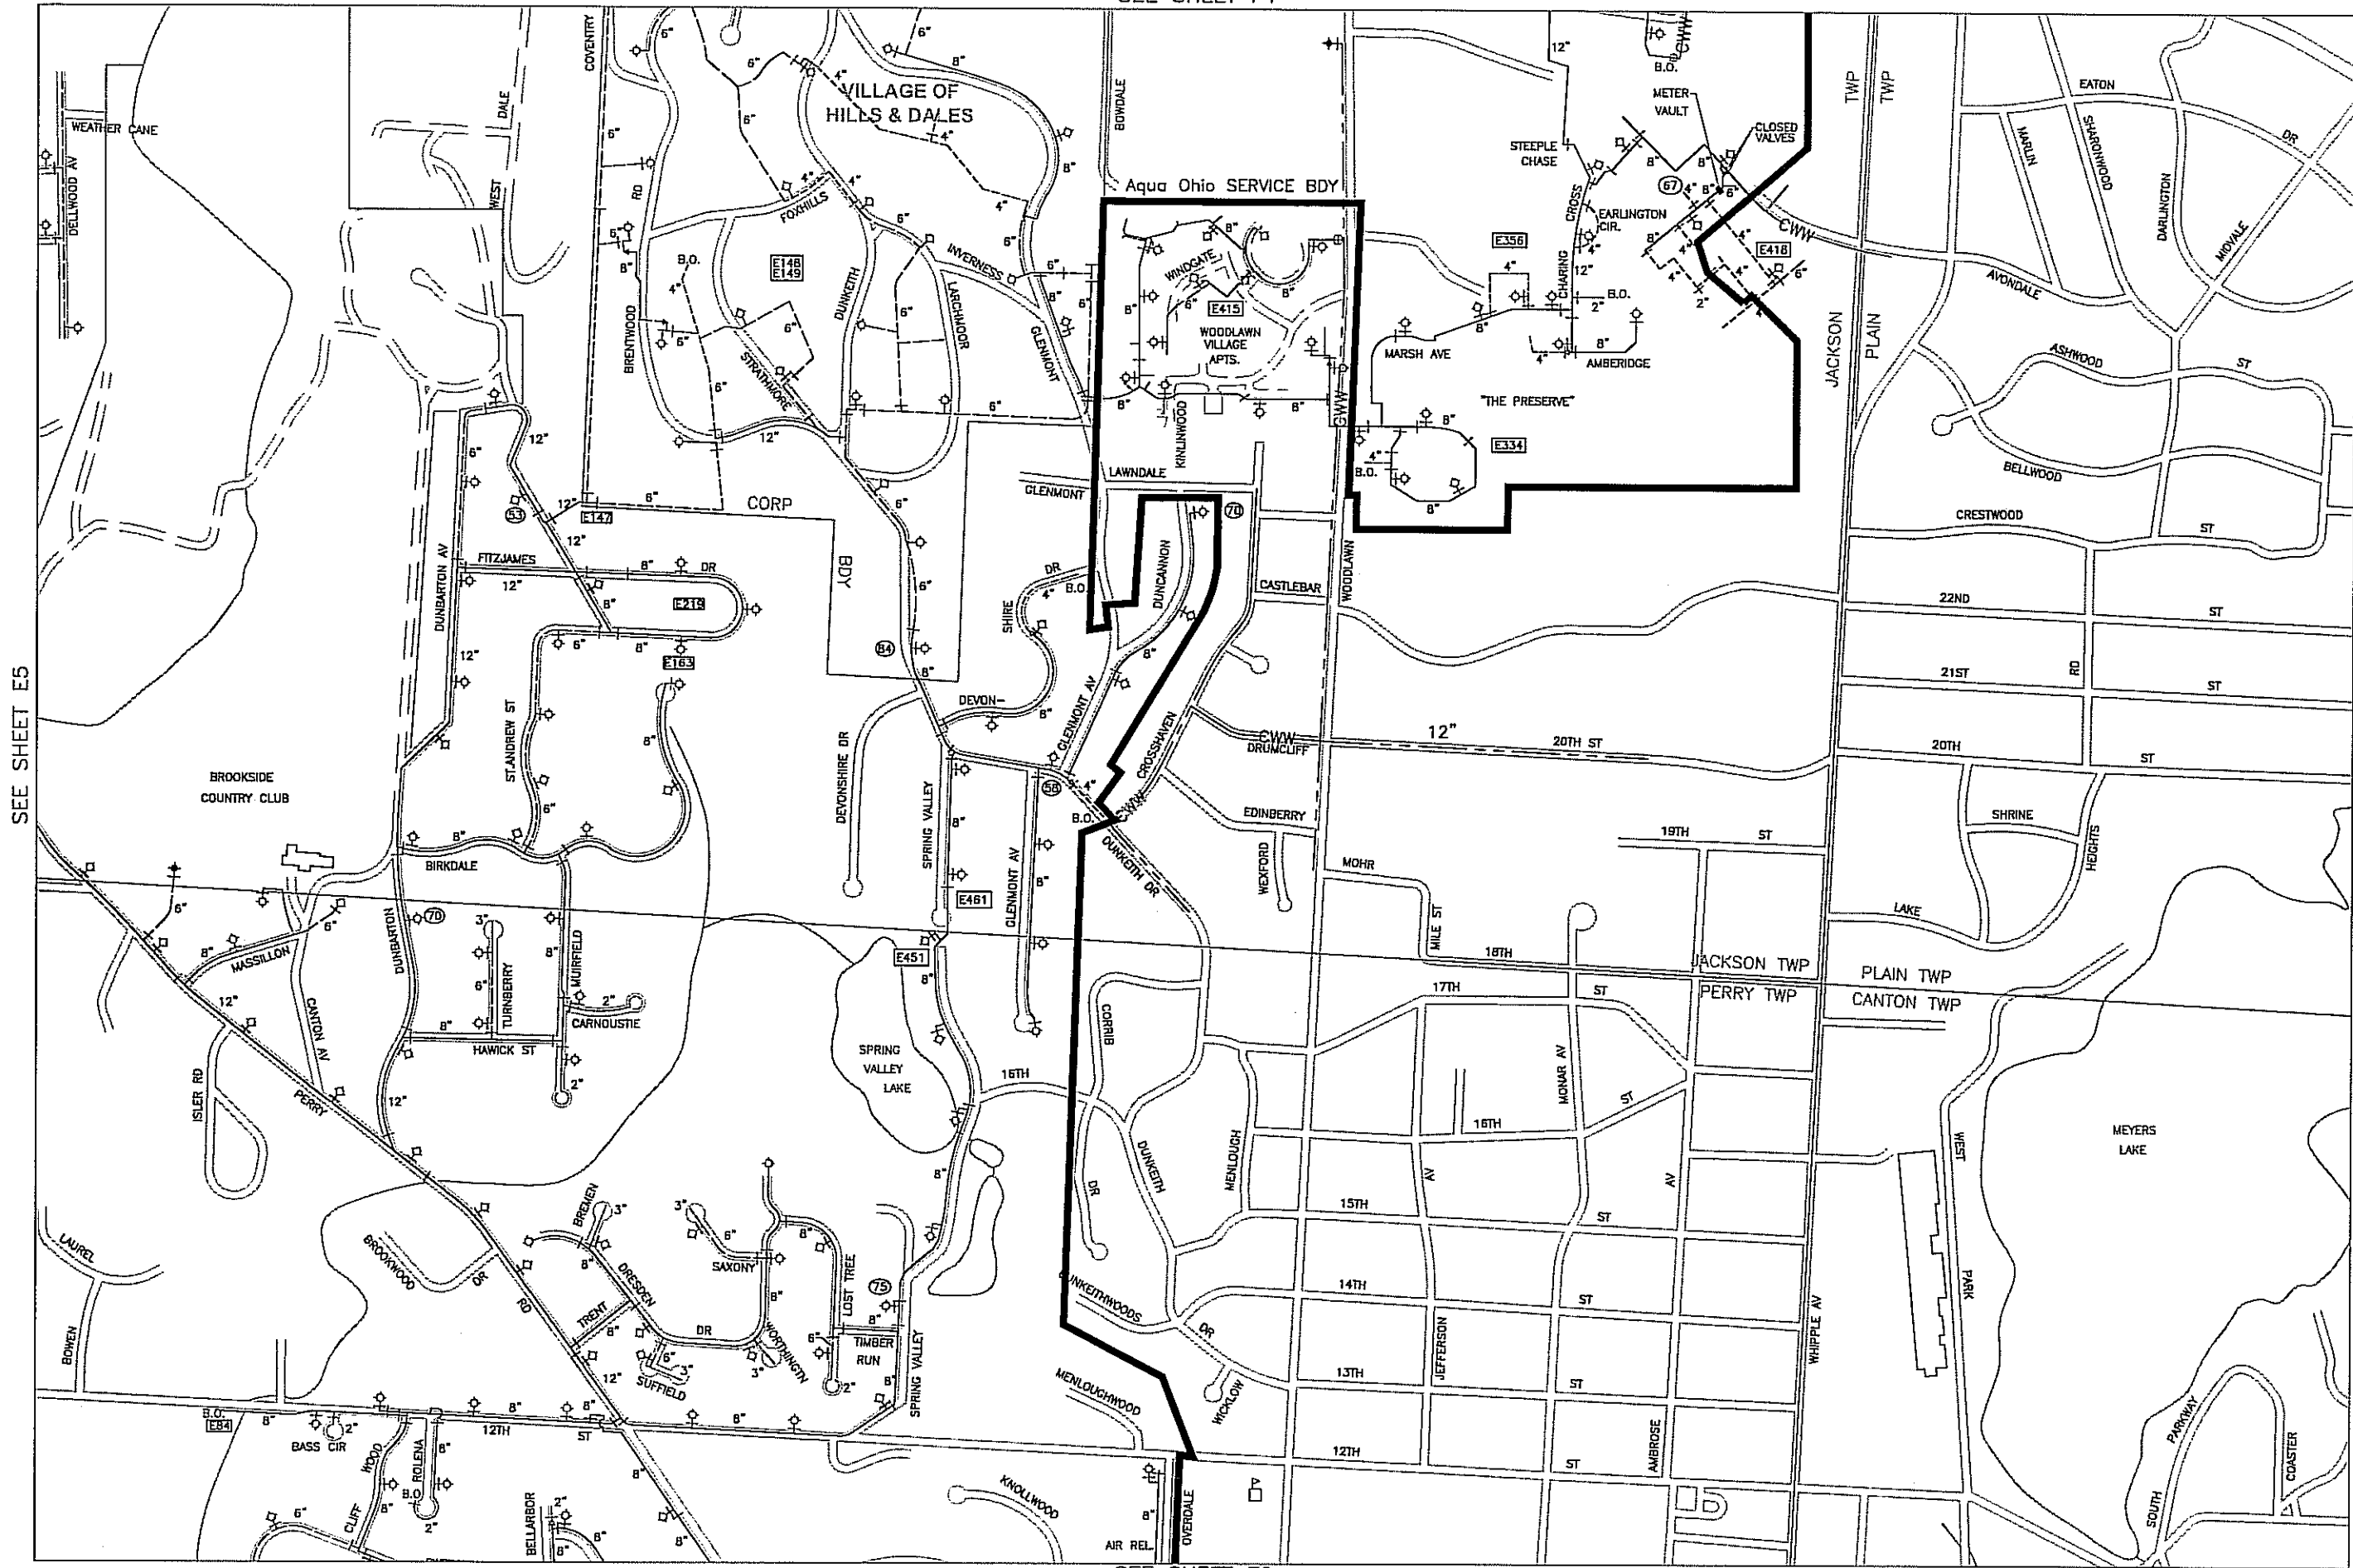

SEE SHEET E5


SEE SHEET F6

LINE LEGEND
3" & SMALLER
4"
6"
8"
10" & 12"
14" & 16"
18" & 20"
24"
30"
36"
PRIVATE

DRAWN	Doug Warrick	DATE	May, 1991
CHECKED		DATE	
APPROVED		DATE	

AQUA
Ohio.

PREPARED BY:
SERVICE CENTER-ENGINEERING DEPT.
6650 SOUTH AVE. BOARDMAN OHIO 44512

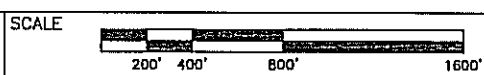

FILE NO.

DISTRIBUTION MATCHLINE MAP
STARK REGIONAL DIVISION

SHEET NO.
F5



SEE SHEET F5

UPDATED	
BY	DATE
L.A.M.	1-04
L.A.M.	2-05

CAUTION: LOW PRESSURE AREA

2ND LEVEL PRESSURE ZONE

REEDURBAN

SEE SHEET E6


SEE SHEET F7

LINE LEGEND
3" & SMALLER
4"
6"
8"
10" & 12"
14" & 16"
18" & 20"
24"
30"
36"

PRIVATE	DRAWN Doug Warrick	DATE May, 1991
CHECKED		DATE
APPROVED		DATE

AQUA Ohio.

PREPARED BY:
SERVICE CENTER - ENGINEERING DEPT.
5650 SOUTH AVE. BOARDMAN OHIO 44512

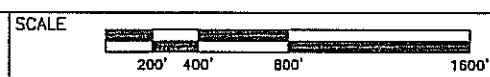

FILE NO.

DISTRIBUTION MATCHLINE MAP
STARK REGIONAL DIVISION

SHEET NO.
F6

NORTH

SEE SHEET F6

UPDATED	
BY	DATE
L.A.M.	1-04
L.A.M.	2-05

SEE SHEET E7




SEE SHEET F8

LINE LEGEND
3" & SMALLER
4"
6"
8"
10" & 12"
14" & 16"
18" & 20"
24"
30"
36"

PRIVATE	DRAWN	DATE
	Doug Warrick	May, 1991
	CHECKED	DATE
	APPROVED	DATE

AQUA
Ohio.

PREPARED BY:
SERVICE CENTER-ENGINEERING DEPT.
5650 SOUTH AVE. BOARDMAN OHIO 44512

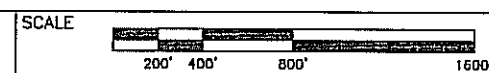


FILE NO.

DISTRIBUTION MATCHLINE MAP
STARK REGIONAL DIVISION

SHEET NO.
F7

SEE SHEET F9

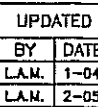[illegible]

LINE LEGEND
4"
6"
8"
10" & 12"
14" & 16"
18" & 20"
24"
30"
36"

PRIVATE	DRAWN <i>Doug Warrick</i>	DATE <i>May, 1991</i>
	CHECKED	DATE
	APPROVED	DATE

AQUA
Ohio

PREPARED BY:
SERVICE CENTER-ENGINEERING DEPT.
6650 SOUTH AVE. BOARDMAN OHIO 44512

SCALE




FILE NO.

DISTRIBUTION MATCHLINE MAP
STARK REGIONAL DIVISION

SHEET NO.
F8



SEE SHEET F8

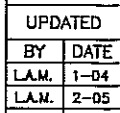

UPDATED	
BY	DATE
L.A.M.	1-04
L.A.M.	2-05

63 LEHS 73S
SEE SHEET E9

LINE LEGEND

3" & SMALLER

4th

6"

B²

10" & 12"

14" & 15"

18th & 20th

24th

30"

36"

PRIVATE

----- PRIVATE -----

AQUA
Ohio.

PREPARED BY:
SERVICE CENTER-ENGINEERING DEPT.
6650 SOUTH AVE. BOARDMAN OHIO 44512


SCALE



FILE NO.	
----------	--

DISTRIBUTION MATCHLINE MAP
STARK REGIONAL DIVISION

SHEET NO.
F9

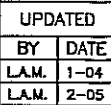[illegible]

LINE LEGEND
4"
6"
8"
10" & 12"
14" & 16"
18" & 20"
24"
30"
36"

PRIVATE	DRAWN <i>Doug Warrick</i>	DATE <i>May, 1991</i>
	CHECKED	DATE
	APPROVED	DATE

AQUA
Ohio.

PREPARED BY:
SERVICE CENTER-ENGINEERING DEPT.
6650 SOUTH AVE. BOARDMAN OHIO 44512

SCALE




200' 400' 800' 1600'

FILE NO.

DISTRIBUTION MATCHLINE MAP
STARK REGIONAL DIVISION

SHEET NO.
G-2

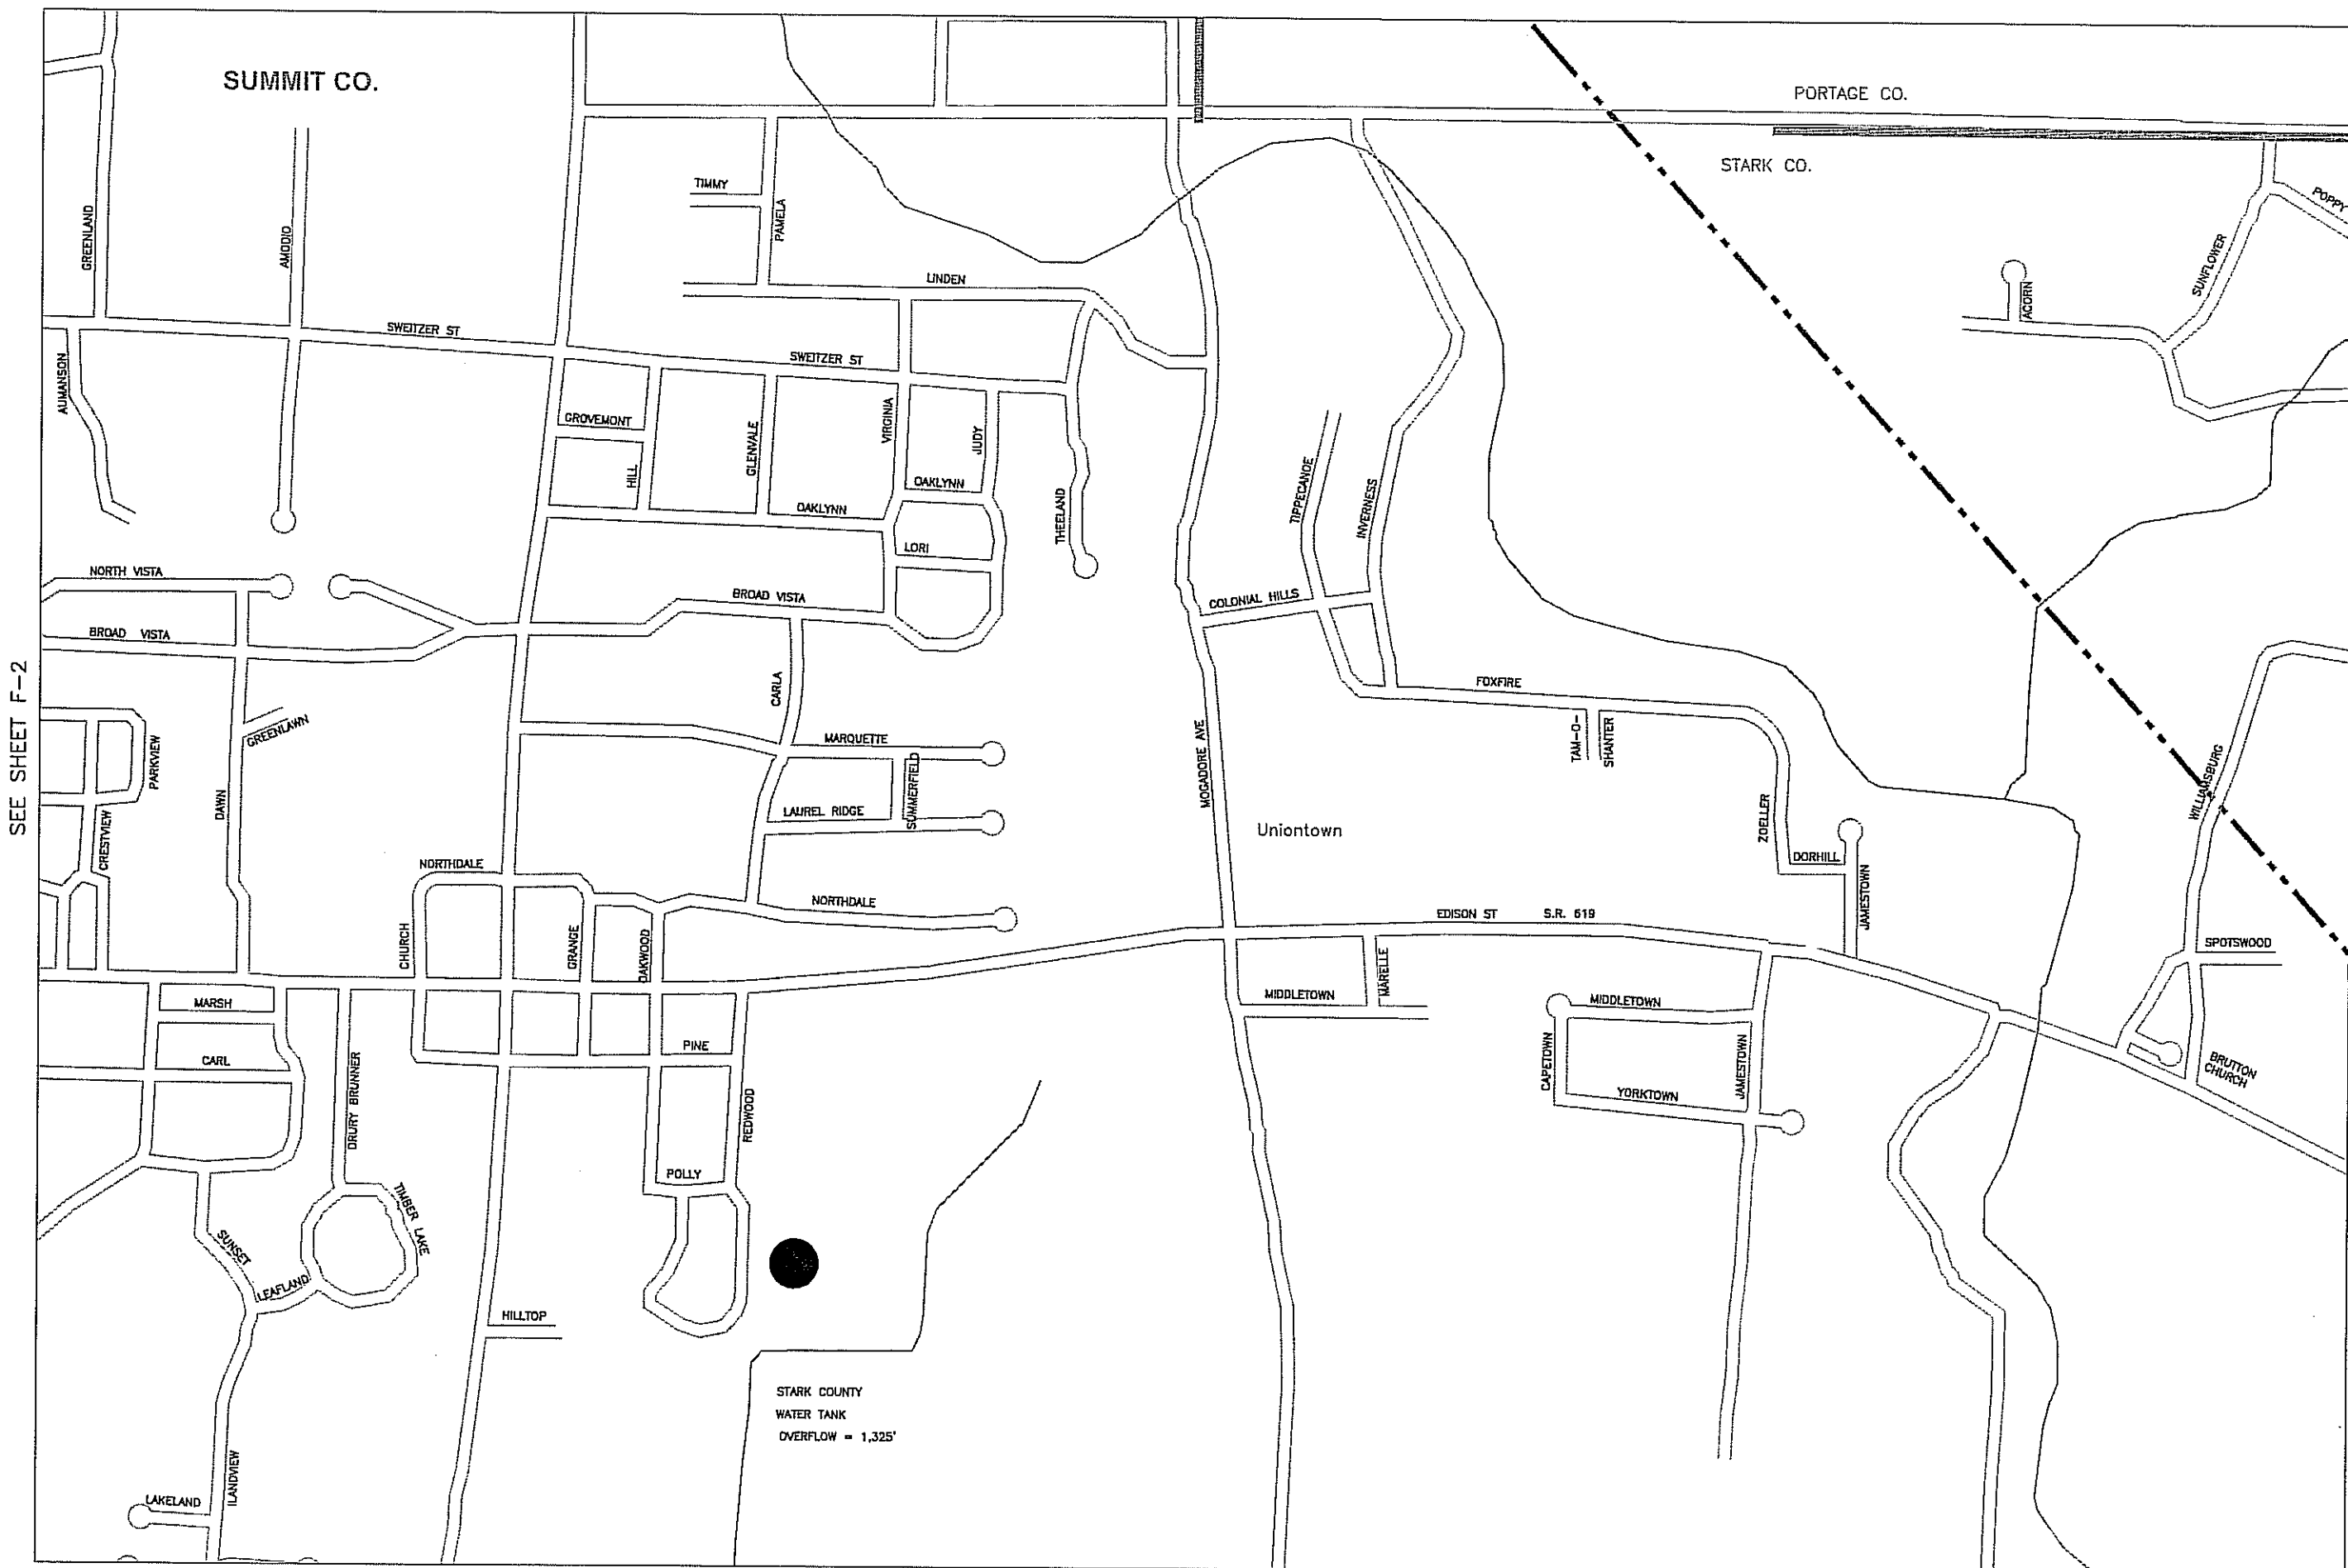

NORTH



SEE SHEET G-2

UPDATED	
BY	DATE
L.A.M.	1-04
L.A.M.	2-05

SEE SHEET F-1



SEE SHEET H-1

SEE SHEET G-0

LINE LEGEND	
3" & SMALLER	
4"	
6"	
8"	
10" & 12"	
14" & 16"	
18" & 20"	
24"	
30"	
36"	
PRIVATE	

DRAWN	Doug Warrick	DATE	May, 1991
CHECKED		DATE	
APPROVED		DATE	

AQUA
Ohio.

PREPARED BY:
SERVICE CENTER-ENGINEERING DEPT.
6650 SOUTH AVE. BOARDMAN OHIO 44512

SCALE

FILE NO.

DISTRIBUTION MATCHLINE MAP
STARK REGIONAL DIVISION

SHEET NO.
G-1

SEE SHEET G2

LINE LEGEND
3" & SMALLER
4"
6"
8"
10" & 12"
14" & 16"
18" & 20"
24"
30"
36"

SEE SHEET F1

SEE SHEET H1

SEE SHEET G2


200' 400' 800' 1600'

DISTRIBUTION MATCHLINE MAP
STARK REGIONAL DIVISION

SHEET NO.
G1

AQUA
Ohio.


PREPARED BY:
SERVICE CENTER-ENGINEERING DEPT.
6650 SOUTH AVE. BOARDMAN OHIO 44512

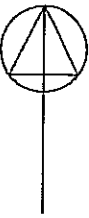

UPDATED	
BY	DATE
L.A.M.	1-04
L.A.M.	2-05

[illegible]

SEE SHEET G-1

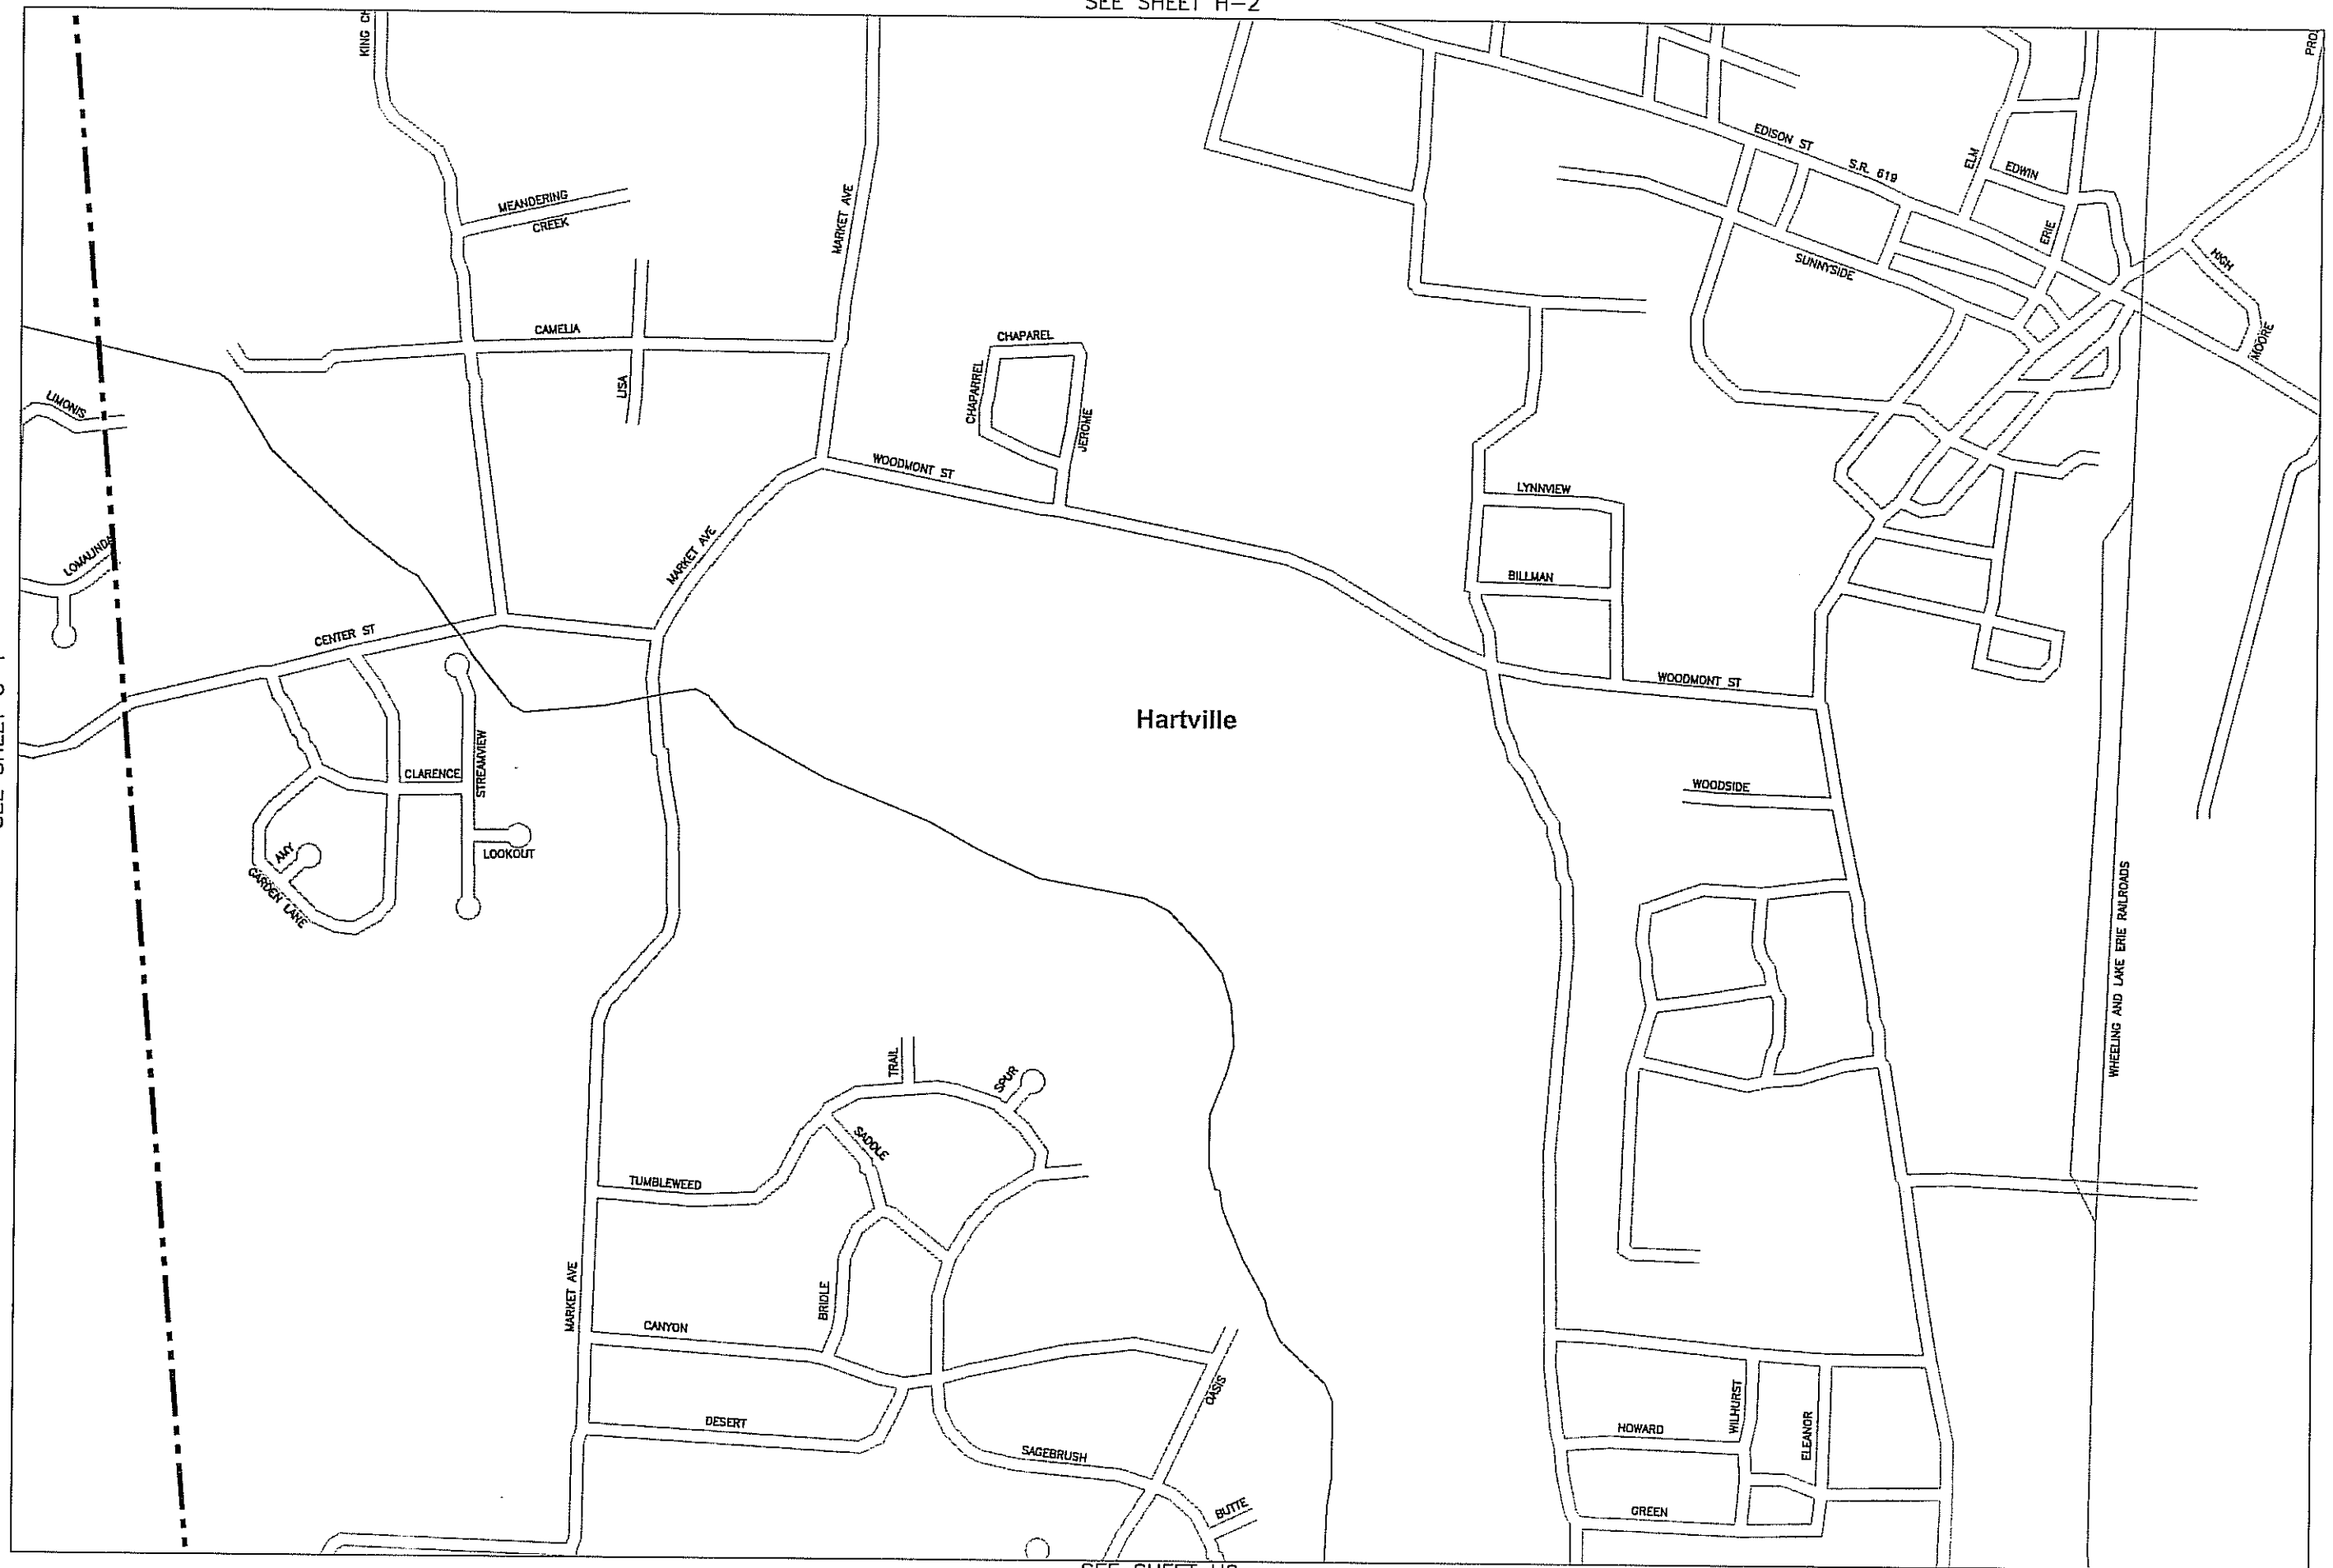

SEE SHEET HO

LINE LEGEND
3" & SMALLER
4"
6"
8"
10" & 12"
14" & 16"
18" & 20"
24"
30"
36"

DRAWN <i>Doug Warrick</i>	DATE <i>May, 1991</i>
CHECKED	DATE
APPROVED	DATE

AQUA
Ohio.

PREPARED BY:
SERVICE CENTER-ENGINEERING DEPT.
6650 SOUTH AVE. BOARDMAN OHIO 44512

SCALE



200' 400' 800' 1600'

FILE NO.	
----------	--

DISTRIBUTION MATCHLINE MAP
STARK REGIONAL DIVISION

SHEET NO.
H-1

SEE SHEET H-1

UPDATED	
BY	DATE
L.A.M.	1-04
L.A.M.	2-05

[illegible]

SEE SHEET GO

LINE LEGEND
3" & SMALLER
4"
6"
8"
10" & 12"
14" & 16"
18" & 20"
24"
30"
36"

DRAWN <i>Doug Warrick</i>	DATE <i>May 1991</i>
CHECKED	DATE
APPROVED	DATE

AQUA
Ohio.

PREPARED BY:
SERVICE CENTER-ENGINEERING DEPT.
6650 SOUTH AVE. BOARDMAN OHIO 44512

SCALE




FILE NO.

DISTRIBUTION MATCHLINE MAP
STARK REGIONAL DIVISION

SHEET NO.
HO

NORTH

SEE SHEET H0

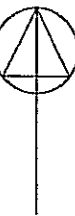

UPDATED

BY	DATE
L.A.M.	1-04
L.A.M.	2-05

SEE SHEET G1



LINE LEGEND

3" & SMALLER

4"
6"
8"
10" & 12"
14" & 16"
18" & 20"
24"
30"
36"

PRIVATE

DRAWN	Doug Warrick	DATE	May, 1997
CHECKED		DATE	
APPROVED		DATE	

AQUA
Ohio.

PREPARED BY:
SERVICE CENTER-ENGINEERING DEPT.
6650 SOUTH AVE. BOARDMAN OHIO 44512

SCALE



FILE NO.

DISTRIBUTION MATCHLINE MAP
STARK REGIONAL DIVISION

SHEET NO.
H1