

Aqua Ohio, Inc.

DISTRIBUTION SYSTEM MAPS

STARK REGIONAL DIVISION

Table of Contents

COVER SHEET	1
GREEN INDEX SHEET	2
NORTH INDEX SHEET	3
SOUTH INDEX SHEET	4
GREEN COMP. MAP	5
NORTH COMP. MAP	6
SOUTH COMP. MAP	7
DISTRIBUTION MATCHLINE MAP	A3 - A6
DISTRIBUTION MATCHLINE MAP	B3 - B6
DISTRIBUTION MATCHLINE MAP	C-3 - C9
DISTRIBUTION MATCHLINE MAP	D-3 - D9
DISTRIBUTION MATCHLINE MAP	E-3 - E9
DISTRIBUTION MATCHLINE MAP	F-3 - F9
DISTRIBUTION MATCHLINE MAP	G-2 - G2
DISTRIBUTION MATCHLINE MAP	H-2 - H1
SITES LAKE MATCHLINE MAPS	A1 - B2
FIRESTONE TRACE DISTRIBUTION MAP	

BOOSTER STATIONS

FORD	0.7 MGD
16th ST.	1.0 MGD (Out of Service)
23rd ST.	1.85 MGD
WALES RD.	4.0 MGD
HILLS & DALES	2.0 MGD (Out of Service)
NAVE ST.	1.0 MGD
McDONALDSVILLE	1.0 MGD
GREEN	

STORAGE TANKS


McDONALDSVILLE STANDPIPE	1.0 MG
FORD ST. RESERVOIR	2.0 MG
UNDERGROUND RESERVOIR	1.5 MG
BAILEY ELEVATED	0.5 MG
EASTLAKE STANDPIPE	1.0 MG
KENYON STANDPIPE	1.0 MG
NAVE STANDPIPE	1.0 MG
FULTON RESERVOIR	3.0 MG
GREEN TANKS	.75 MG (2)
UNIONTOWN	.75 MG

WATER SUPPLY WELLS

#1-86	4.0 MGD
#2-74	1.7 MGD
#3-56	0.5 MGD
#5-66	3.0 MGD
#7-84	3.0 MGD
#8-85	3.0 MGD
#9-88	3.0 MGD
#10-97	5.0 MGD
#11-00	3.0 MGD
#12-02	2.0 MGD
#13-05	2.0 MGD

Legend

- ★ District Office
- Filter Plant
- ▲ Underground Well
- Booster Station
- Storage Tank

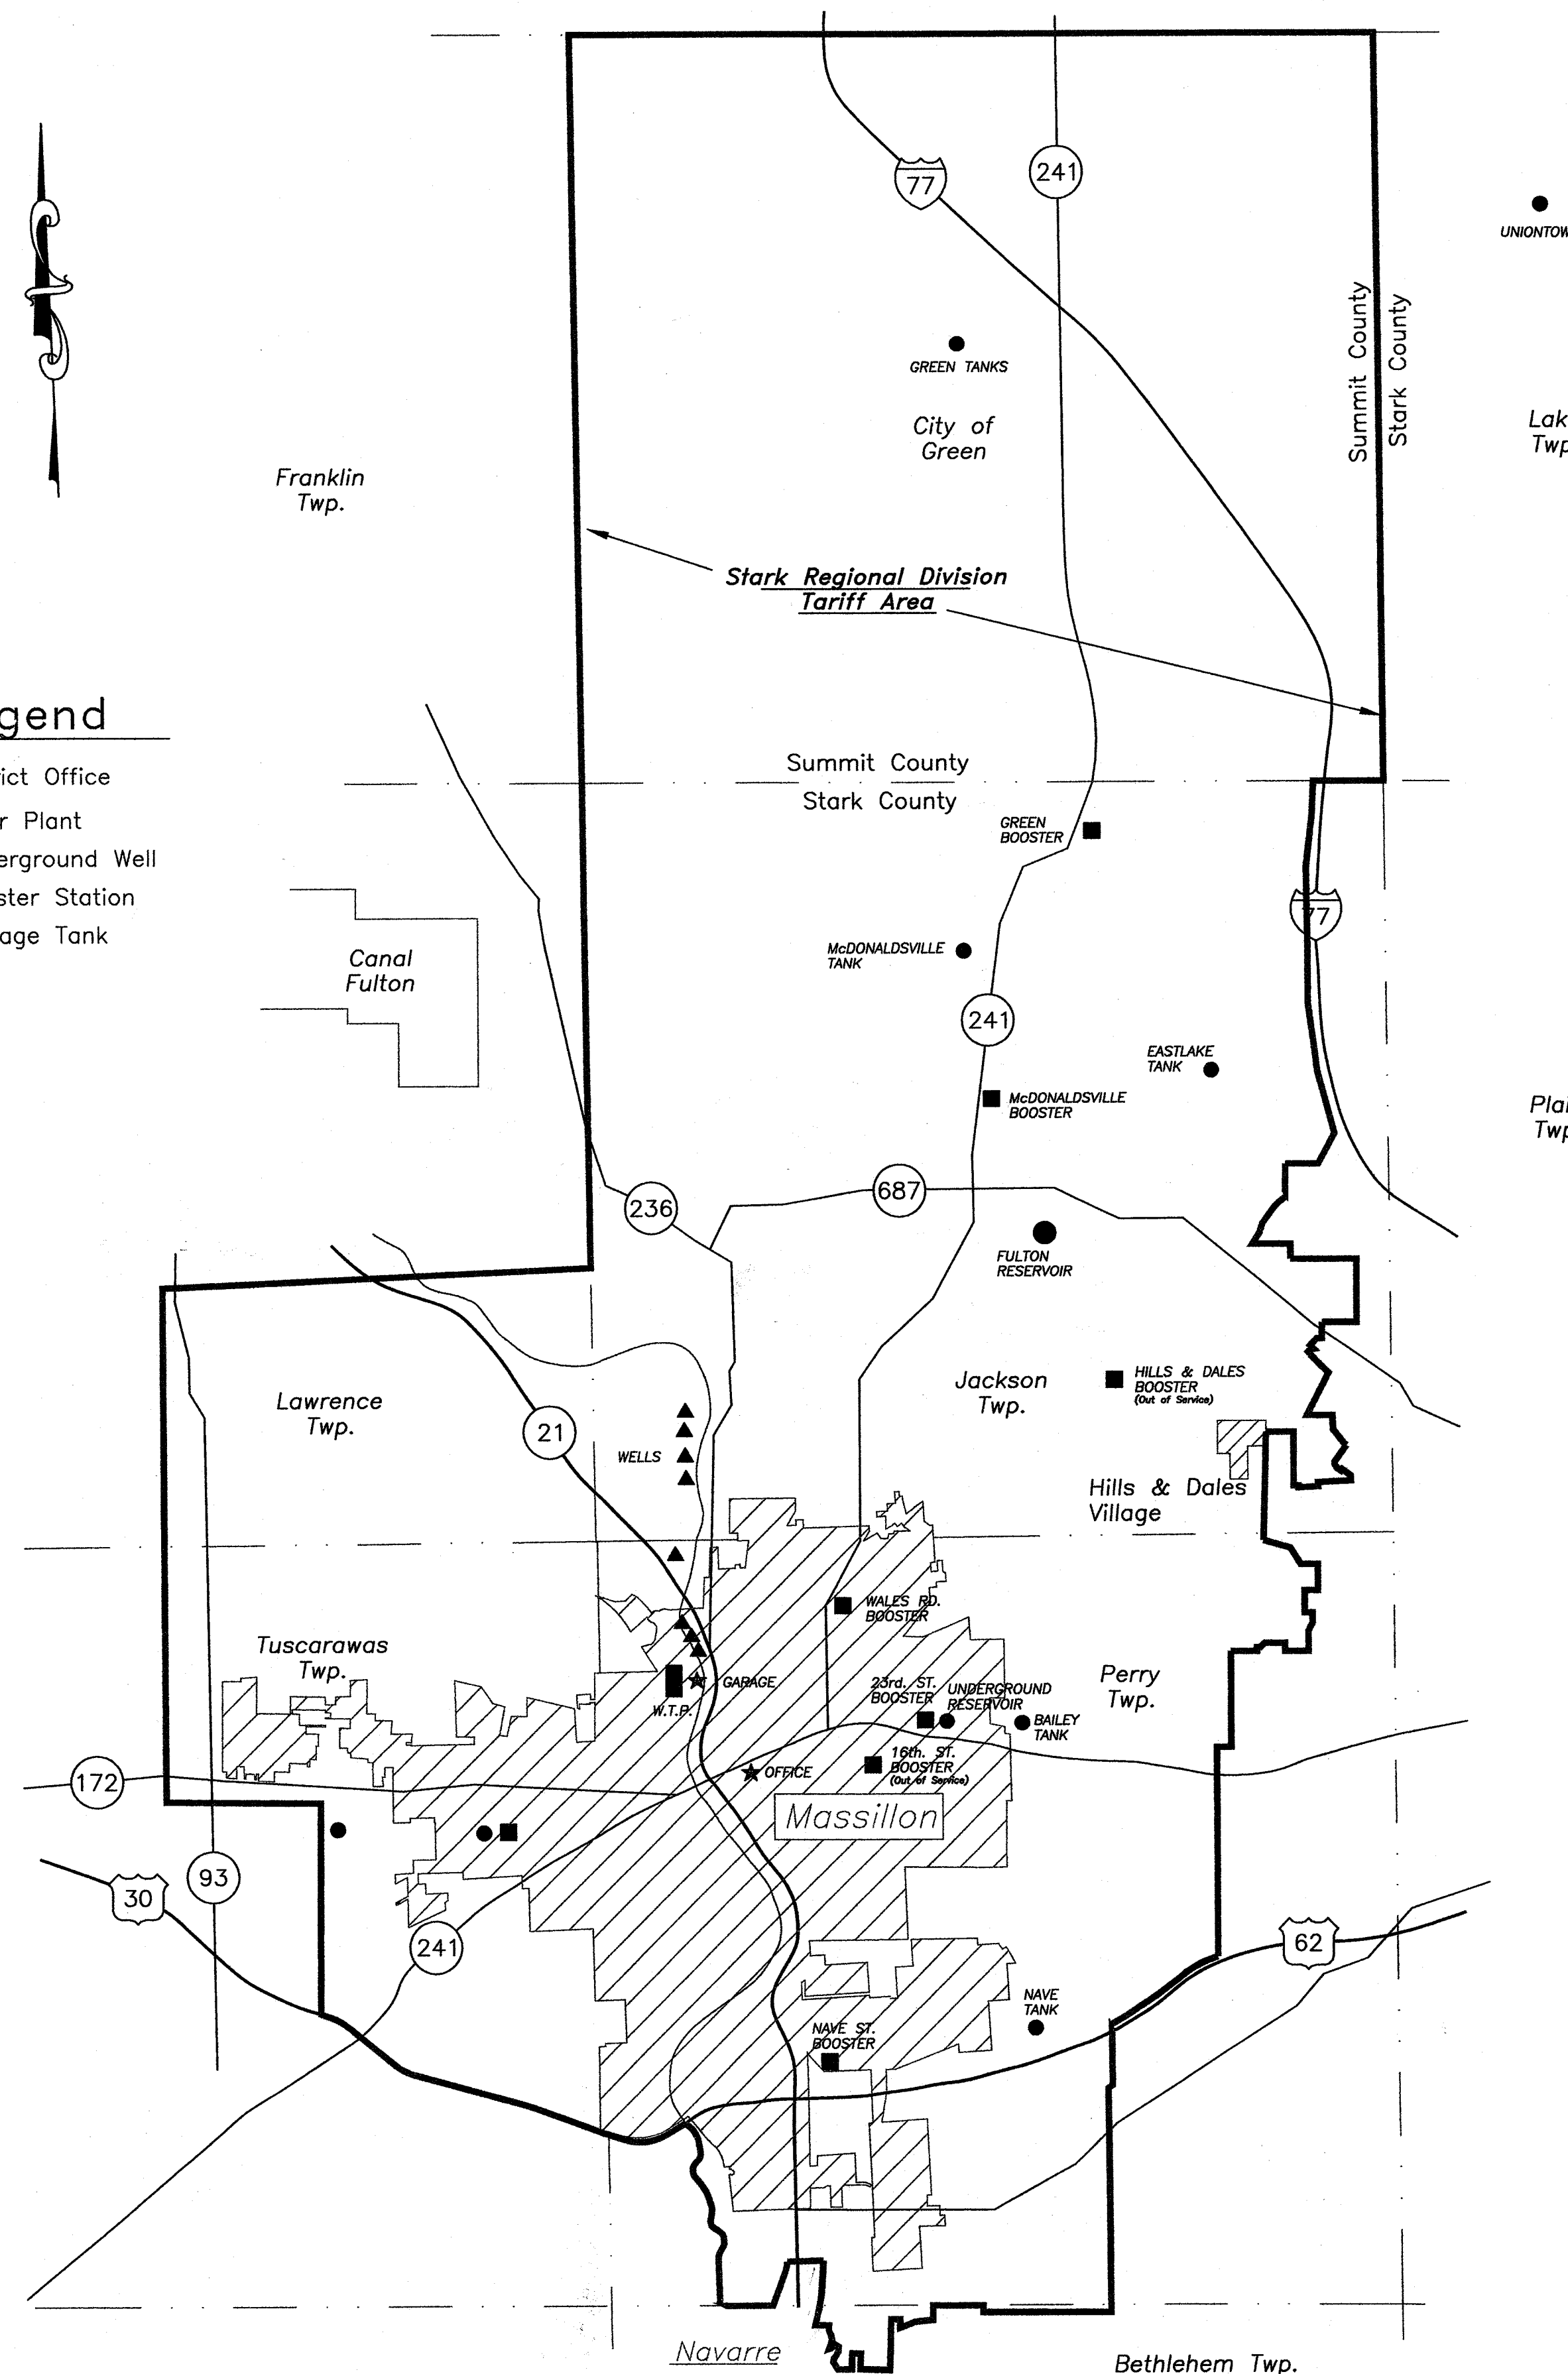

LEGEND

- ⬆ PRIVATE HYDRANT
- ⬆ HYDRANT WITH WATCH VALVE
- ⬆ HYDRANT WITHOUT WATCH VALVE
- ⬆ VALVE
- ⬆ VALVE, CLOSED
- ⬆ VALVE, PARTLY CLOSED
- ⬆ VALVE IN VAULT
- ⬆ TAPPING SLEEVE & VALVE
- ⬆ CHECK VALVE (FLOW) →
- ⬆ REGULATOR
- ⬆ B.O. BLOW OFF
- ⬆ EASEMENT
- ⬆ PRESSURE
- ⬆ WELL LOCATION & WELL NO.


- ⬆ 3"Ø & SMALLER
- ⬆ 4"Ø WATERLINE
- ⬆ 6"Ø WATERLINE
- ⬆ 8"Ø WATERLINE
- ⬆ 10"Ø WATERLINE
- ⬆ 12"Ø WATERLINE
- ⬆ 14"Ø WATERLINE
- ⬆ 16"Ø WATERLINE
- ⬆ 18"Ø WATERLINE
- ⬆ 20"Ø WATERLINE
- ⬆ 24"Ø WATERLINE
- ⬆ 30"Ø WATERLINE
- ⬆ 36"Ø WATERLINE
- ⬆ PRIVATE W/L
- ⬆ CROSS OVER
- ⬆ TEE & CROSS
- ⬆ RECORDING GAUGE
- ⬆ REDUCER
- ⬆ BENDS, HORIZONTAL

RECEIVED
MAR - 7 2008

PREPARED BY:
SERVICE CENTER ENGINEERING
JANUARY 2008


RECORD DRAWING
Locations of Waterworks facilities are approximate.
Offset information is not necessarily complete.
Locations of all abandoned facilities may not be shown.

SECURITY CHAIN OF CUSTODY
This material may not be distributed to
others without the written consent of
Aqua Ohio, Inc.

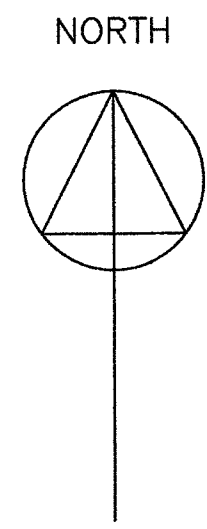


UPDATED	
BY	DATE
L.A.M.	1-04
L.A.M.	2-05
L.A.M.	1-06
L.A.M.	1-07
L.A.M.	1-08

LINE LEGEND	
3" & SMALLER	
4"	
6"	
8"	
10" & 12"	
14" & 16"	
18" & 20"	
24"	
30"	
36"	
PRIVATE	

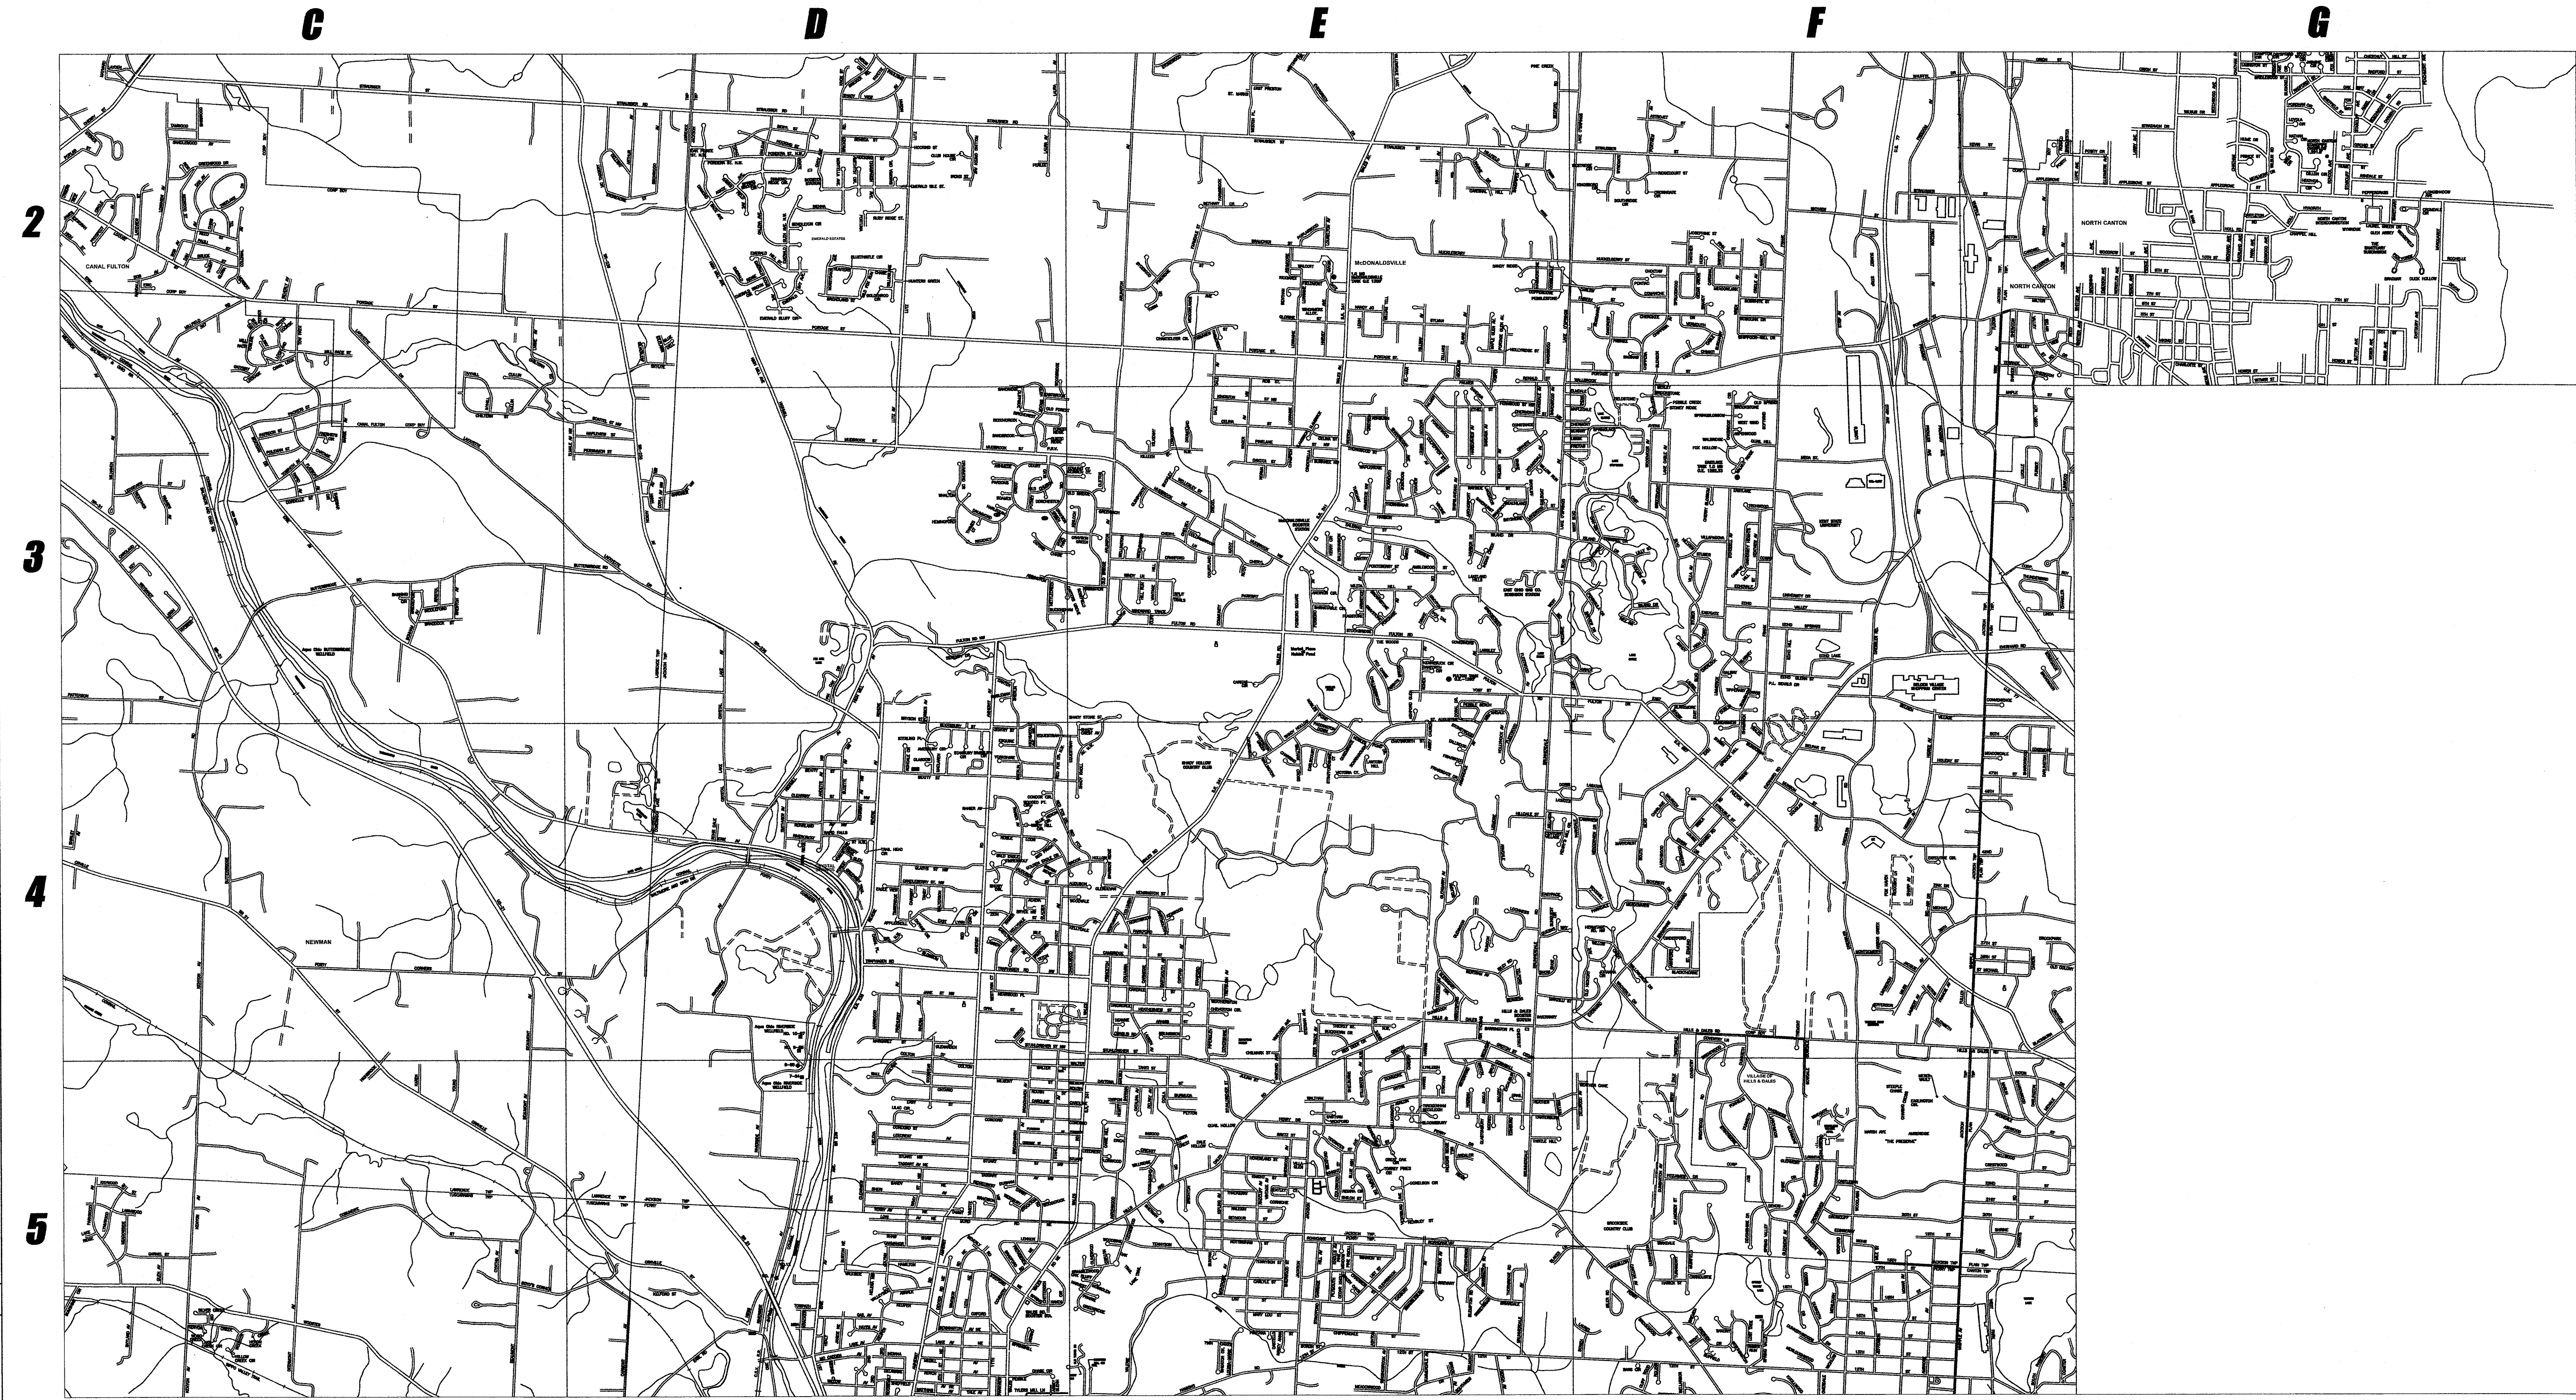

DRAWN	<i>Doug Warrick</i>	DATE	<i>May, 1991</i>
CHECKED		DATE	
APPROVED		DATE	

AQUA
Ohio

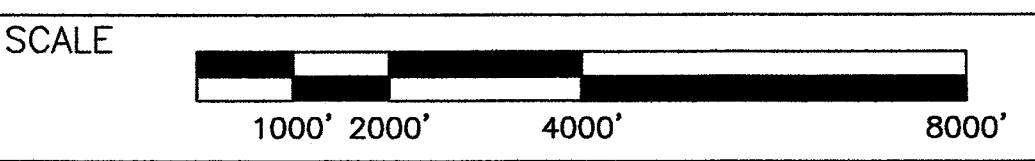


FILE NO.

NORTH INDEX MAP
STARK REGIONAL DIVISION


SHEET NO.
3

H:\Engineering\Drawings\Maps\MA\Map-disp-all.dwg, 2/15/2008 2:12:20 PM

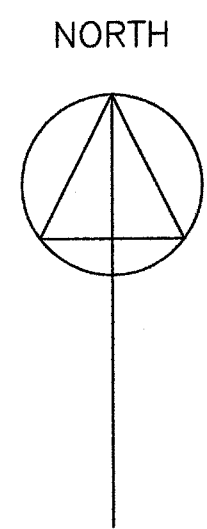


UPDATED	
BY	DATE
L.A.M.	1-04
L.A.M.	2-05
L.A.M.	1-06
L.A.M.	1-07
L.A.M.	1-08

LINE LEGEND	
3" & SMALLER	
4"	
6"	
8"	
10" & 12"	
14" & 16"	
18" & 20"	
24"	
30"	
36"	
PRIVATE	

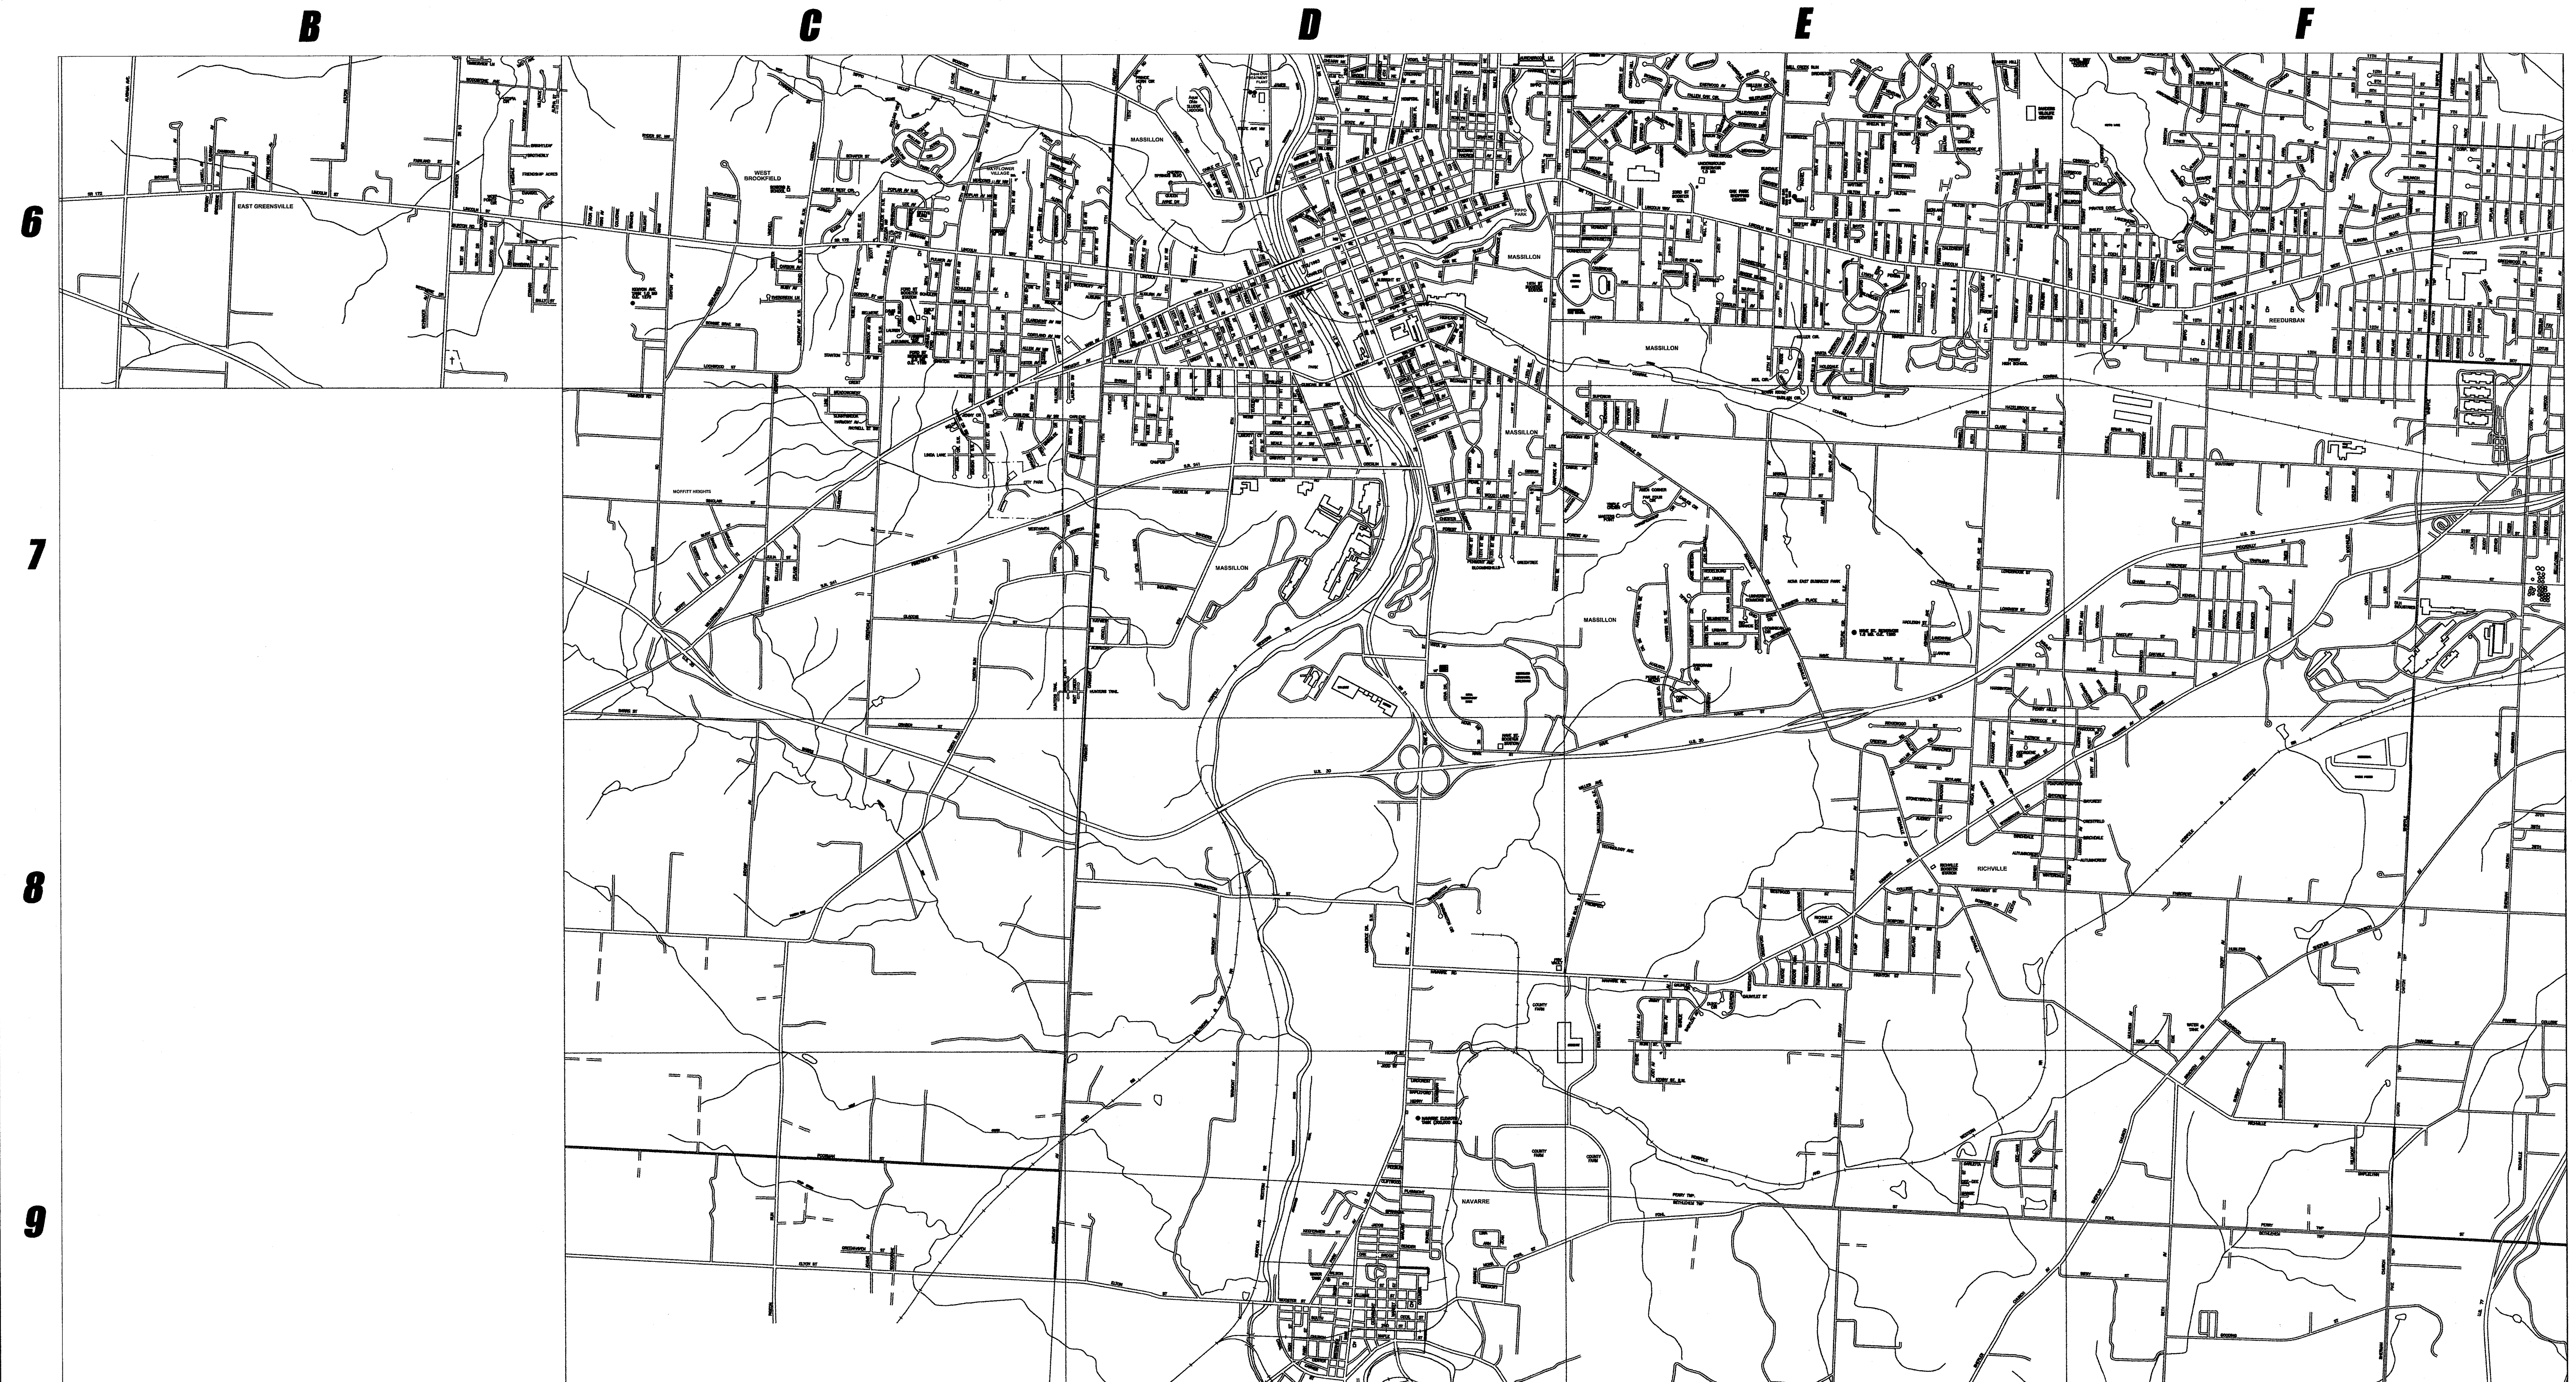

DRAWN	<i>Doug Warrick</i>	DATE	<i>May, 1991</i>
CHECKED		DATE	
APPROVED		DATE	

AQUA.
Ohio

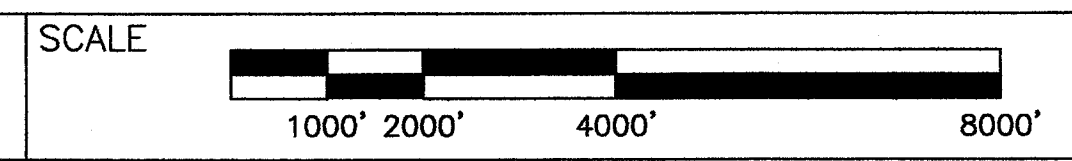


FILE NO.

SOUTH INDEX MAP
STARK REGIONAL DIVISION

SHEET NO.
4

H:\Engineering\Drawings\Maps\WA\Map-disp-all.dwg, 2/15/2008 2:23:10 PM

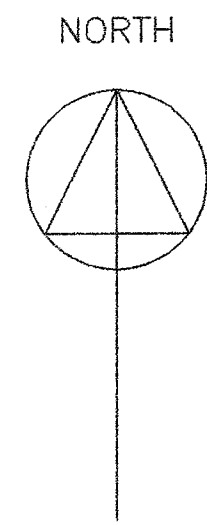

UPDATED

BY	DATE
L.A.M.	1-04
L.A.M.	2-05

LINE LEGEND

3" & SMALLER

4"

6"

8"

10" & 12"

14" & 16"

18" & 20"

24"

30"

36"


PRIVATE

DRAWN	<i>Doug Warrick</i>	DATE	<i>May, 1991</i>
CHECKED		DATE	
APPROVED		DATE	

AQUA
Ohio.

PREPARED BY:
SERVICE CENTER-ENGINEERING DEPT.
6650 SOUTH AVE. BOARDMAN OHIO 44512

SCALE

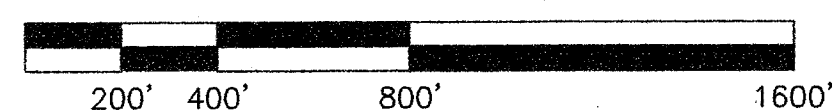

FILE NO.


DISTRIBUTION MATCHLINE MAP
STARK REGIONAL DIVISION

SHEET NO.
A6

SEE SHEET A5



SEE SHEET B6

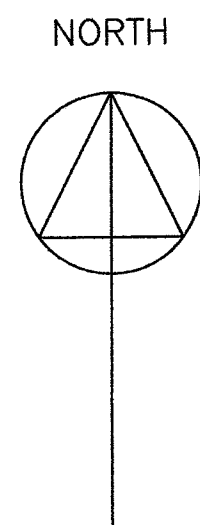

UPDATED	
BY	DATE
L.A.M.	1-04
L.A.M.	2-05
L.A.M.	1-06
L.A.M.	1-07

LINE LEGEND	
3" & SMALLER	
4"	
6"	
8"	
10" & 12"	
14" & 16"	
18" & 20"	
24"	
30"	
36"	

DRAWN	<i>Doug Warrick</i>	DATE	<i>May, 1991</i>
CHECKED		DATE	
APPROVED		DATE	

AQUA
Ohio

PREPARED BY:
SERVICE CENTER-ENGINEERING DEPT.
6650 SOUTH AVE. BOARDMAN OHIO 44512

SCALE

200' 400' 800' 1600'

FILE NO.

DISTRIBUTION MATCHLINE MAP
STARK REGIONAL DIVISION

SHEET NO.
B5

SEE SHEET B4

SEE SHEET A5






SEE SHEET C5

SEE SHEET B6

[illegible]

SEE SHEET C6

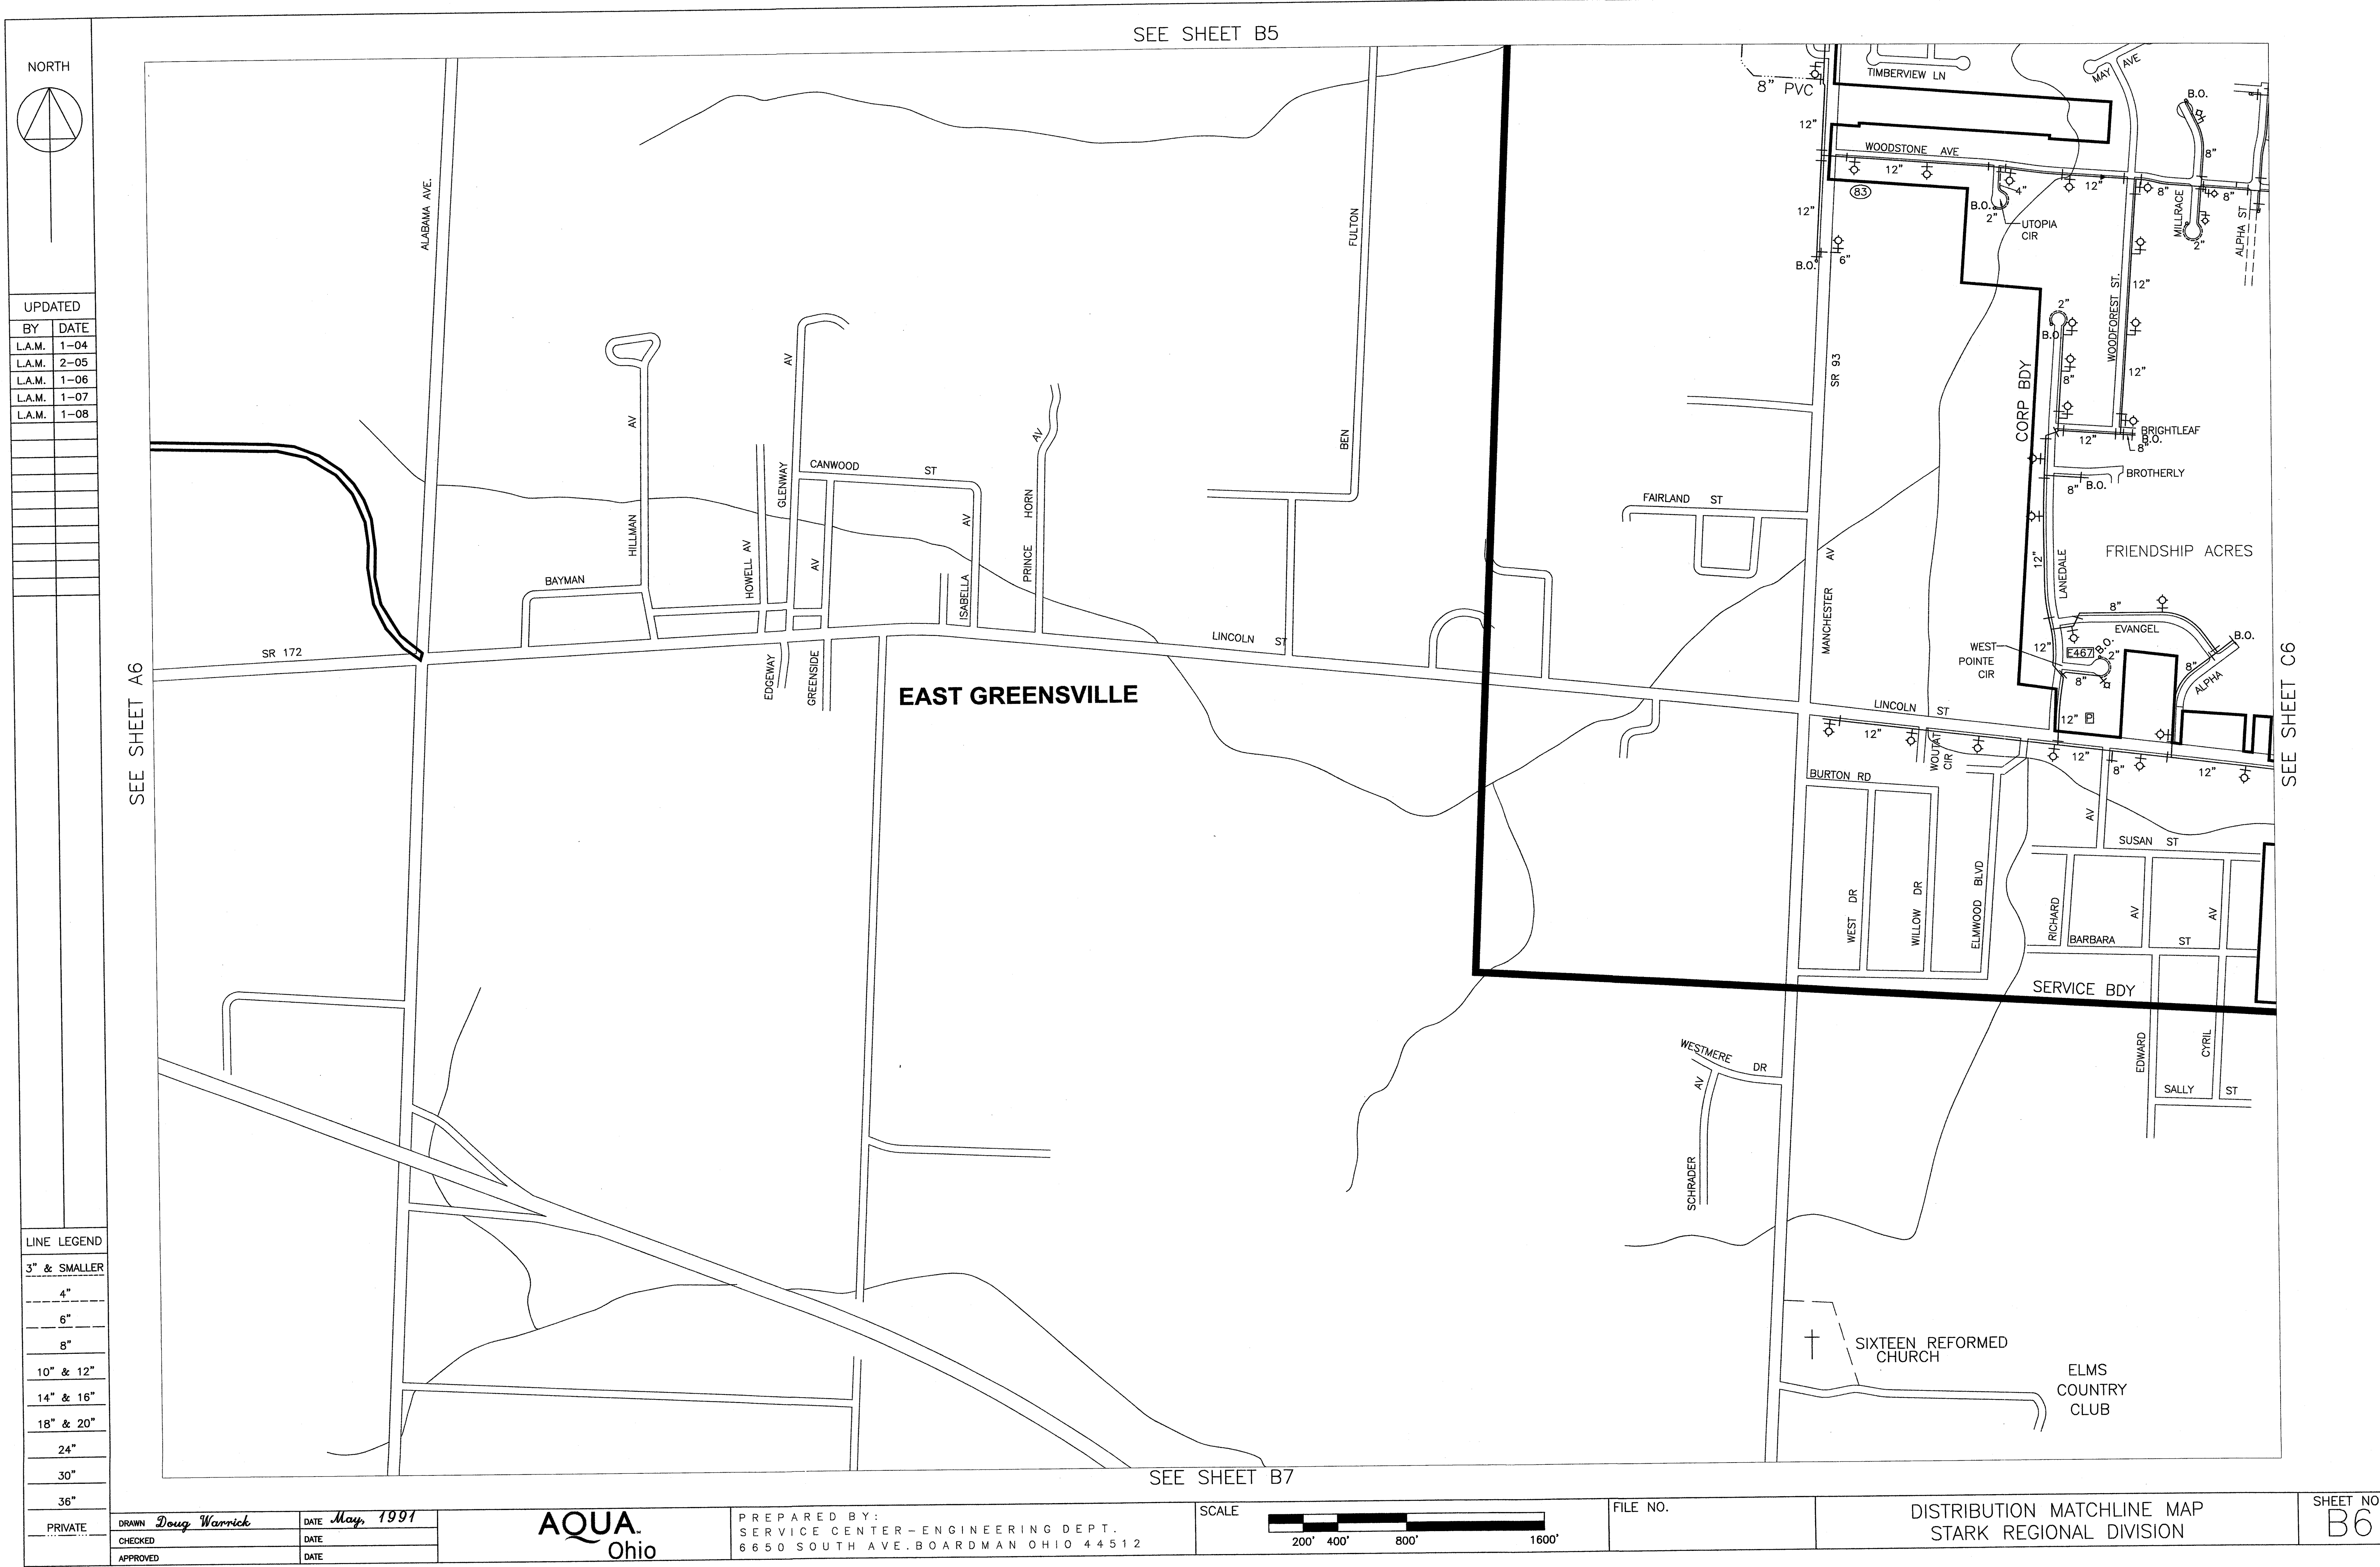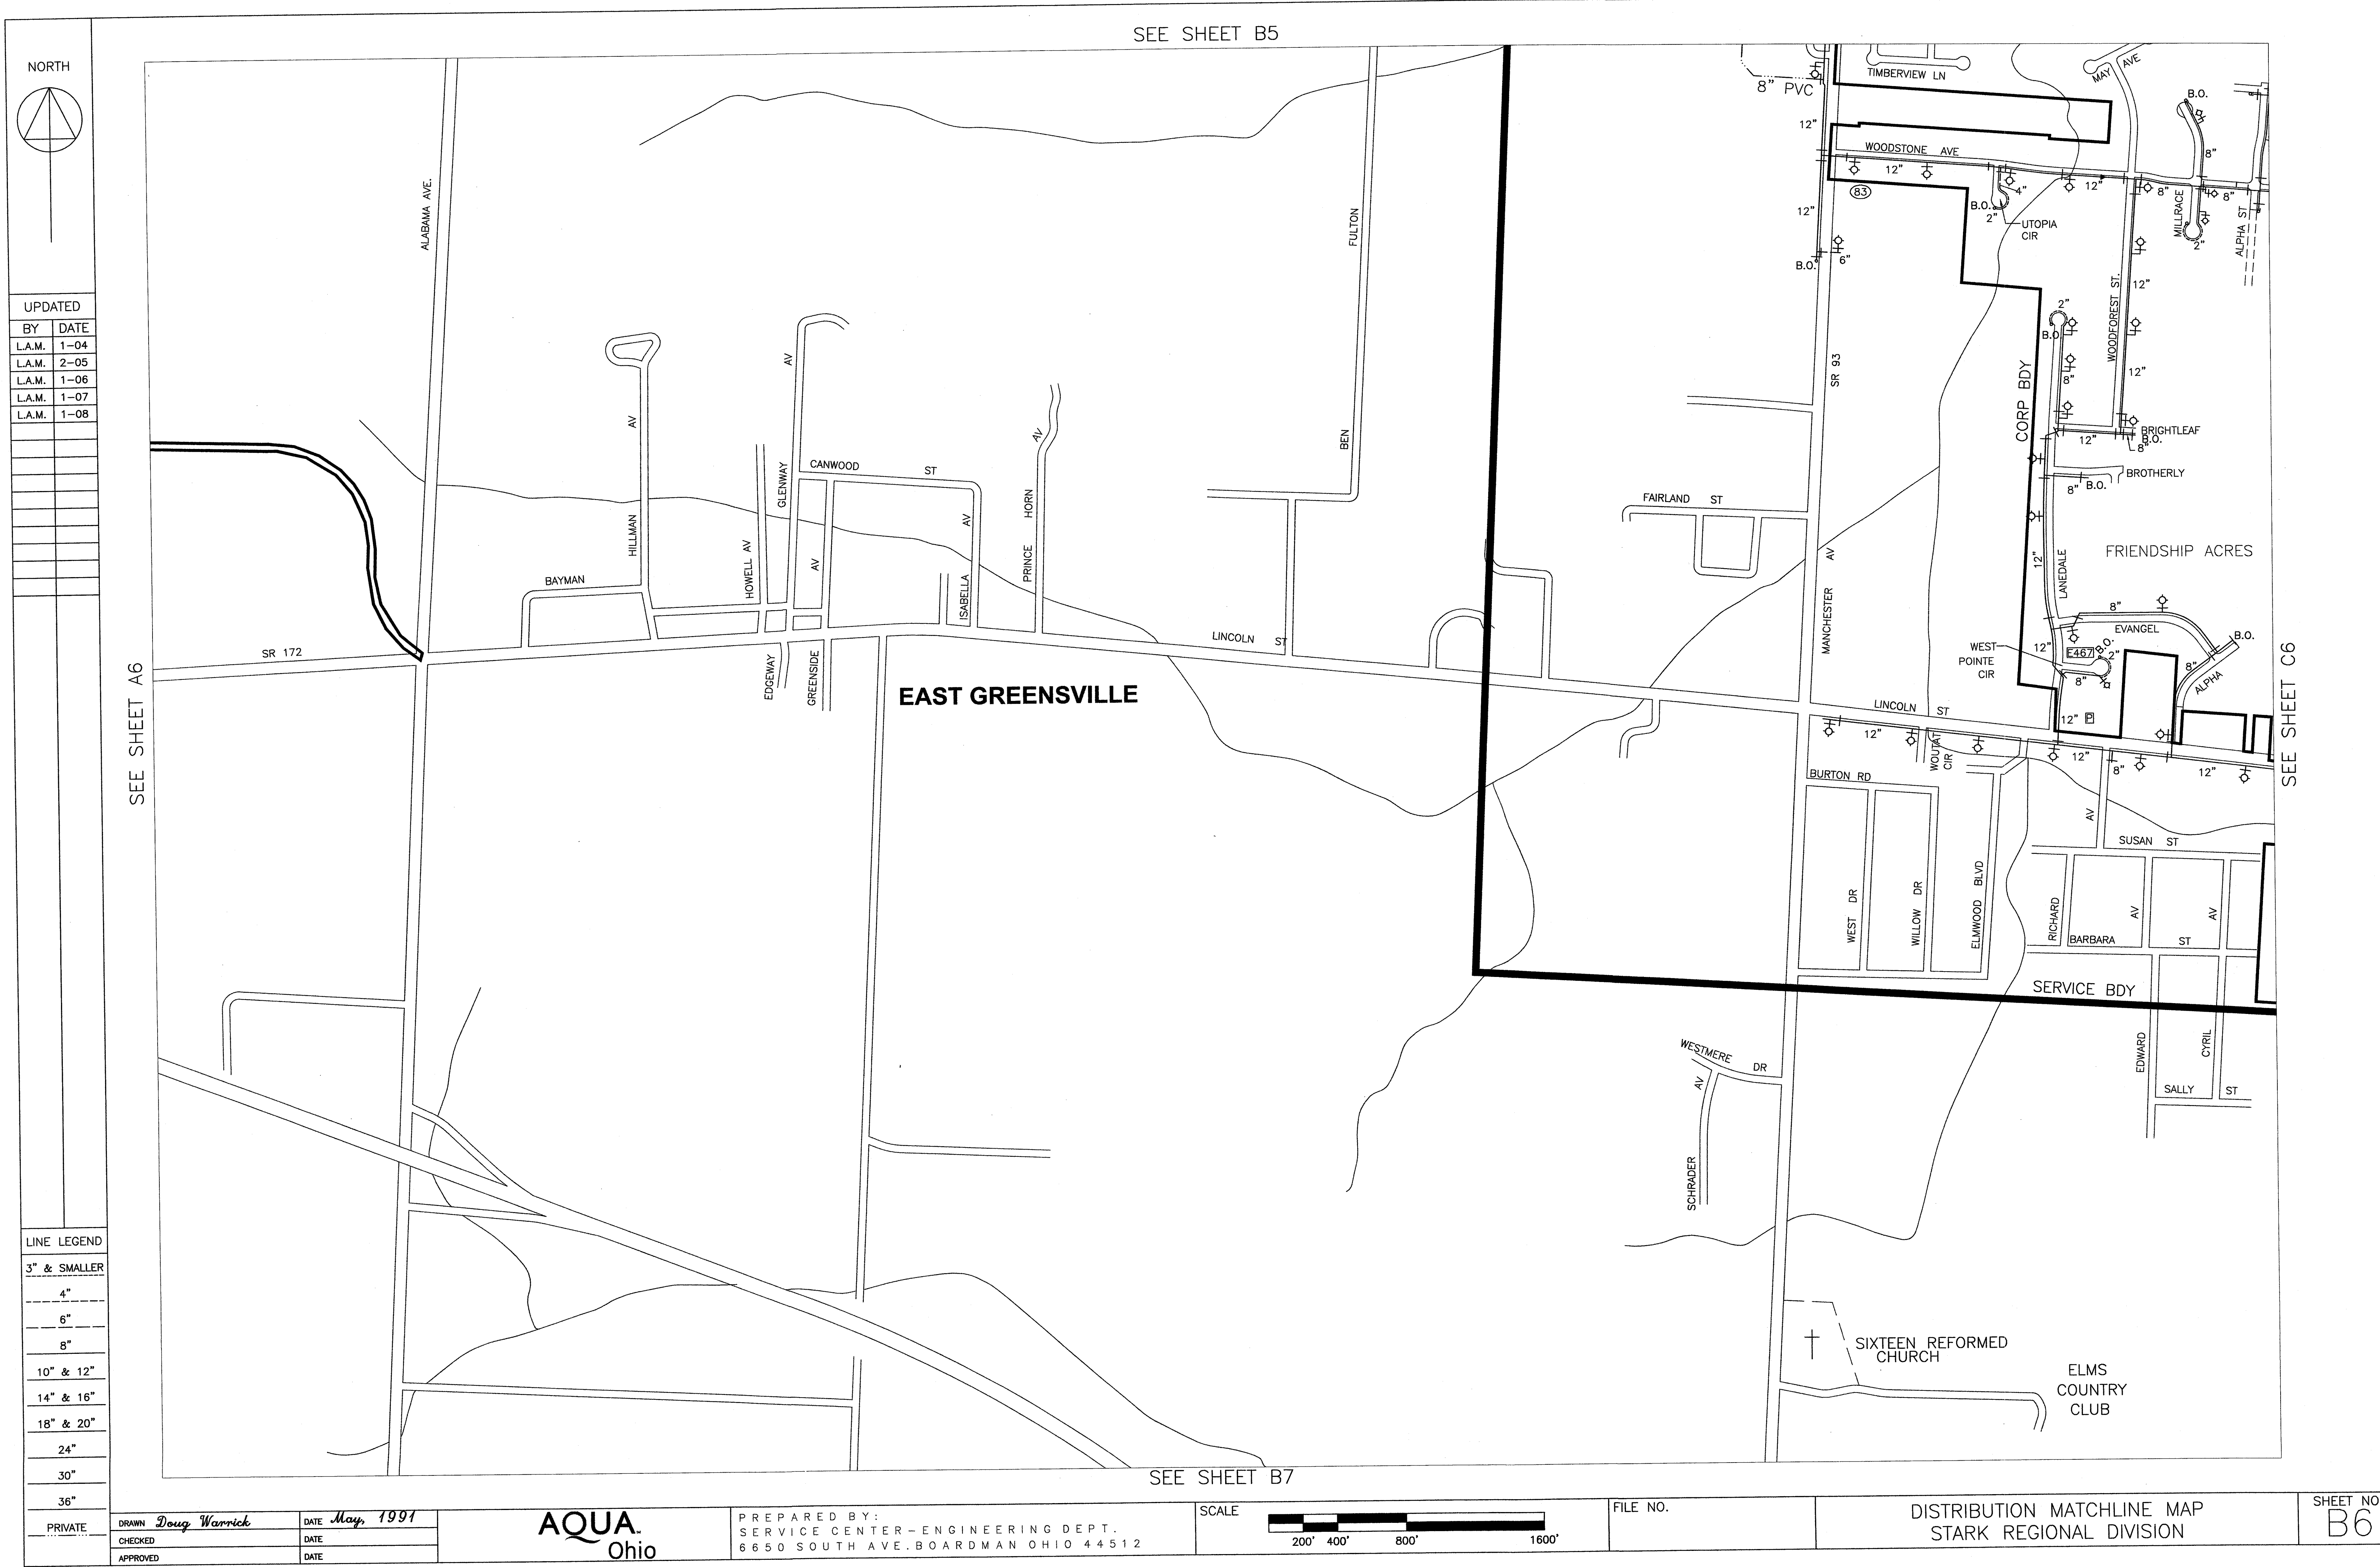[illegible][illegible][illegible][illegible][illegible][illegible]

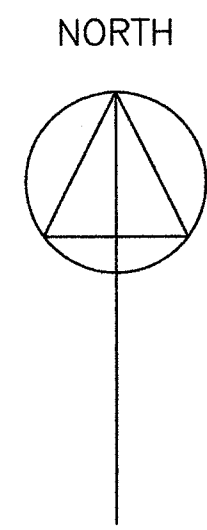

UPDATED

BY	DATE
L.A.M.	1-04
L.A.M.	2-05
L.A.M.	1-07

LINE LEGEND

3" & SMALLER
4"
6"
8"
10" & 12"
14" & 16"
18" & 20"
24"
30"
36"

PRIVATE

SEE SHEET B5

SEE SHEET C4




SEE SHEET D5

SEE SHEET C6

DRAWN	<i>Doug Warrick</i>	DATE	<i>May, 1991</i>
CHECKED		DATE	
APPROVED		DATE	

AQUA
Ohio


PREPARED BY:
SERVICE CENTER-ENGINEERING DEPT.
6650 SOUTH AVE. BOARDMAN OHIO 44512

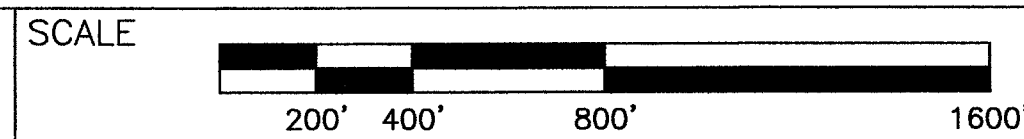

FILE NO.

DISTRIBUTION MATCHLINE MAP
STARK REGIONAL DIVISION

SHEET NO.
C5

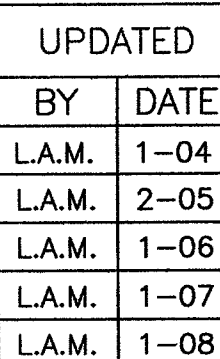

UPDATED	
BY	DATE
L.A.M.	1-04
L.A.M.	2-05
L.A.M.	1-06
L.A.M.	1-07
L.A.M.	1-08

SEE SHEET B6

LINE	LEGEND
3" & SMALLER	
4"	
6"	
8"	
10" & 12"	
14" & 16"	
18" & 20"	
24"	
30"	
36"	

DRAWN <i>Doug Warrick</i>	DATE <i>May, 1991</i>
CHECKED	DATE
APPROVED	DATE

AQUA
Ohio


PREPARED BY:
SERVICE CENTER-ENGINEERING DEPT.
6650 SOUTH AVE. BOARDMAN OHIO 44512



SCALE 

FILE NO.

DISTRIBUTION MATCHLINE MAP
STARK REGIONAL DIVISION

SHEET NO.
C6

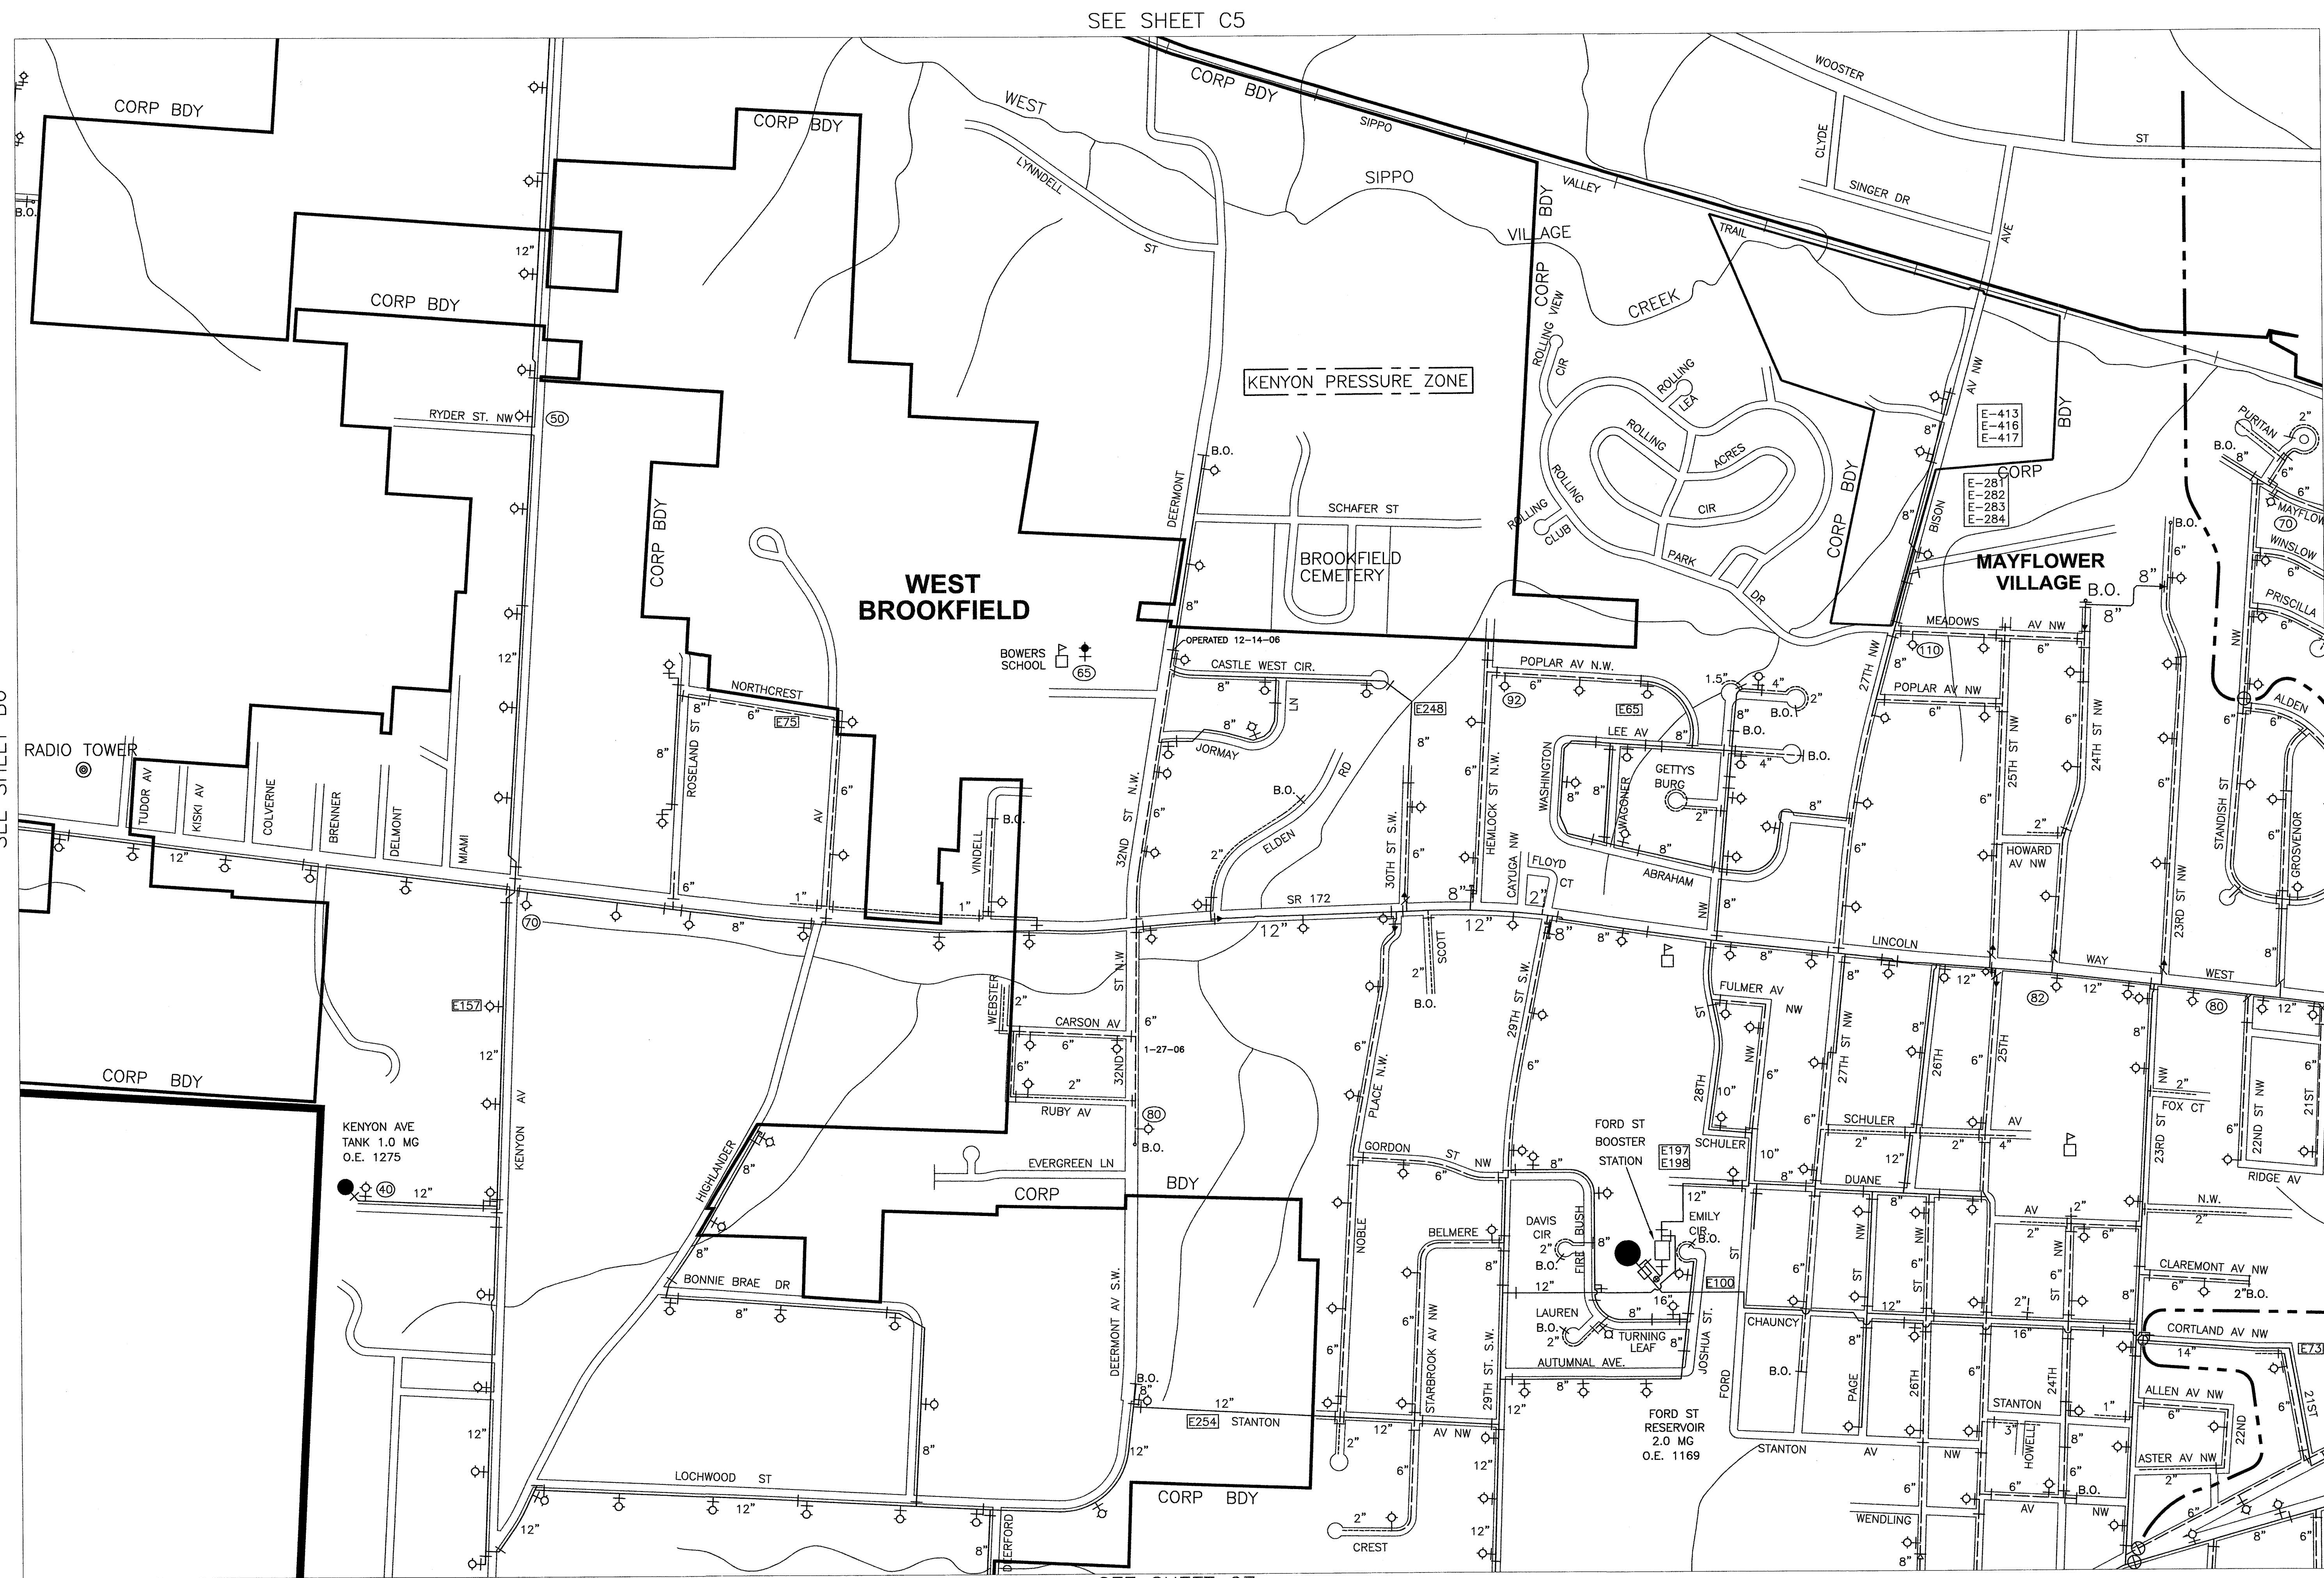

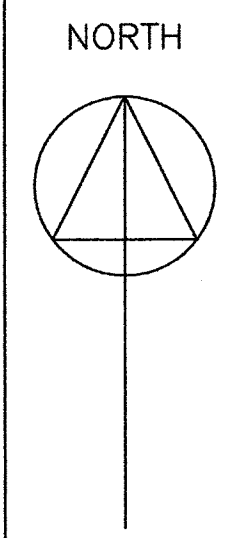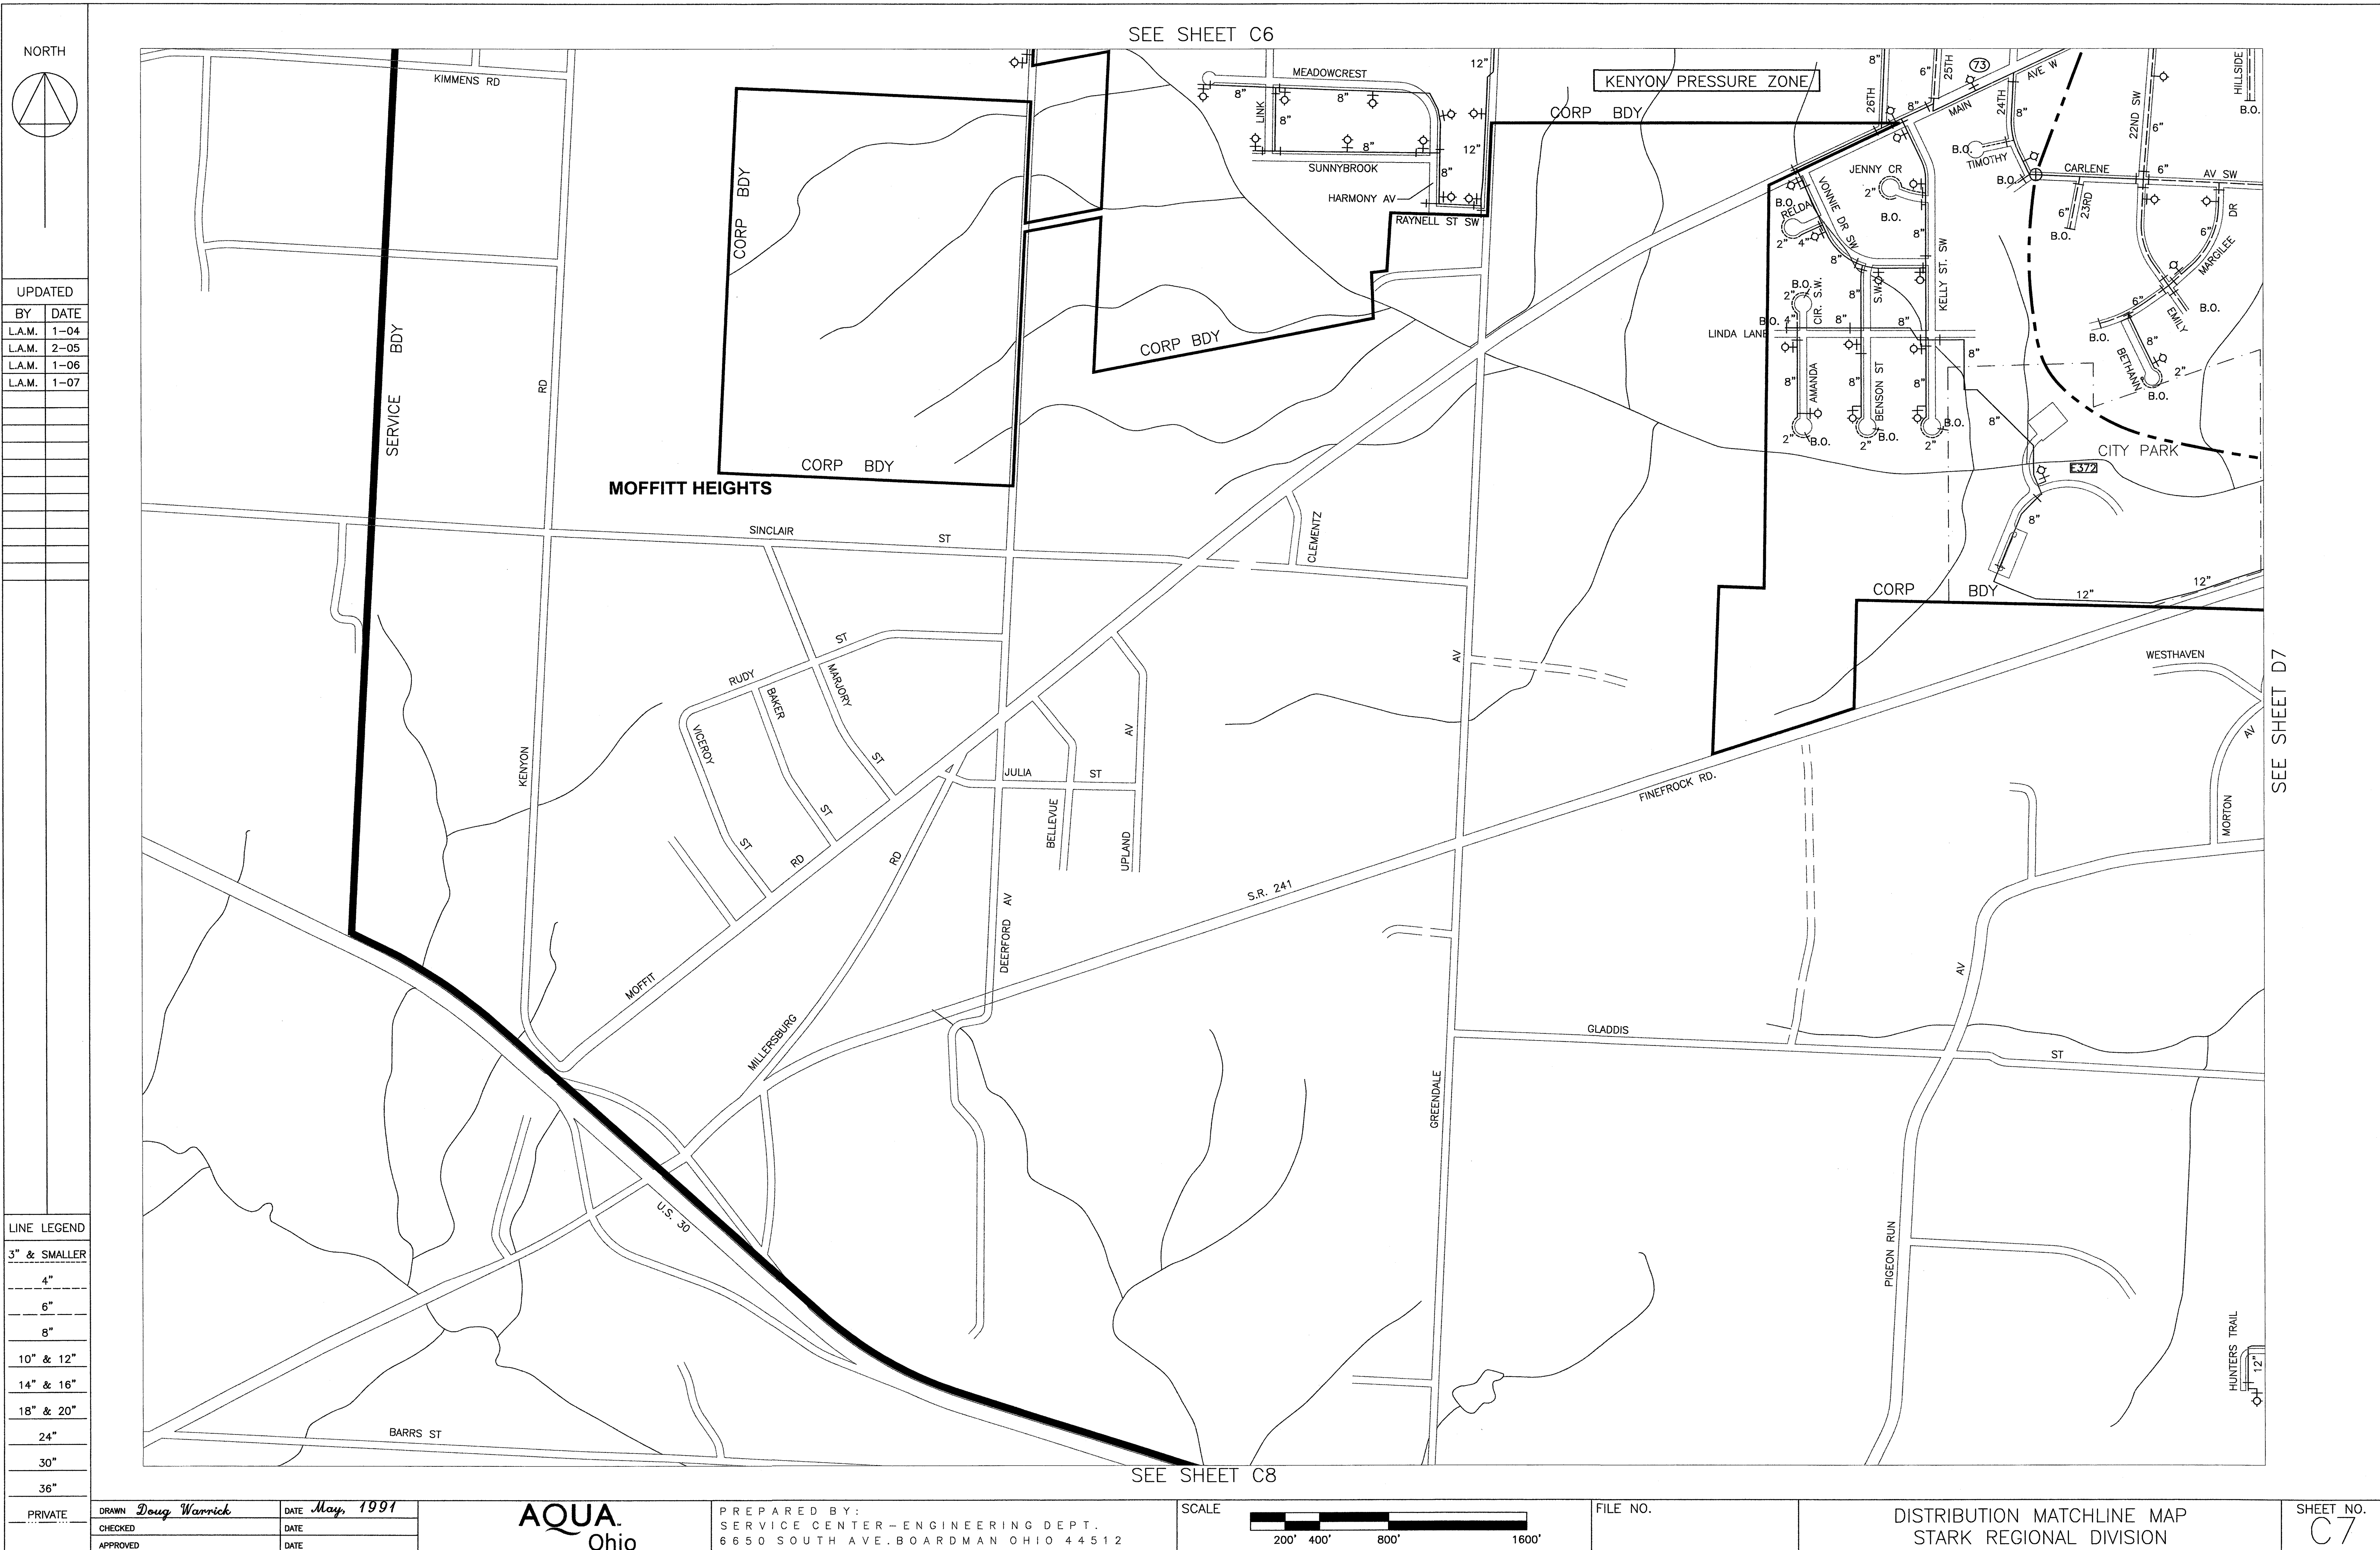


UPDATED	
BY	DATE
L.A.M.	1-04
L.A.M.	2-05
L.A.M.	1-06
L.A.M.	1-07

LINE LEGEND	
3" & SMALLER	
4"	
6"	
8"	
10" & 12"	
14" & 16"	
18" & 20"	
24"	
30"	
36"	

PRIVATE	DRAWN <i>Doug Warrick</i>	DATE <i>May, 1991</i>
	CHECKED	DATE
	APPROVED	DATE




PREPARED BY:
SERVICE CENTER-ENGINEERING DEPT.
6650 SOUTH AVE. BOARDMAN OHIO 44512

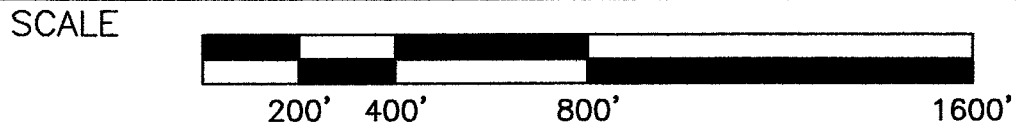

FILE NO.

DISTRIBUTION MATCHLINE MAP
STARK REGIONAL DIVISION

SHEET NO.
C7

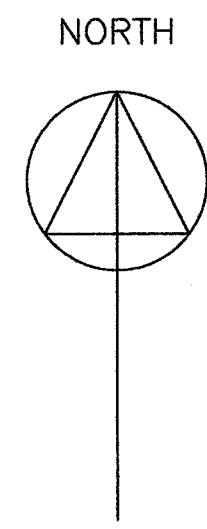


UPDATED	BY	DATE
L.A.M.	1-04	
L.A.M.	2-05	
L.A.M.	1-06	
L.A.M.	1-07	
L.A.M.	1-08	

LINE LEGEND
3" & SMALLER
4"
6"
8"
10" & 12"
14" & 16"
18" & 20"
24"
30"
36"

DRAWN	Doug Warrick	DATE	May, 1991
CHECKED		DATE	
APPROVED		DATE	



PREPARED BY:
SERVICE CENTER-ENGINEERING DEPT.
6650 SOUTH AVE. BOARDMAN OHIO 44512

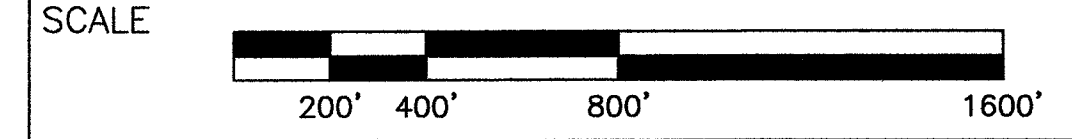

FILE NO.

DISTRIBUTION MATCHLINE MAP
STARK REGIONAL DIVISION

SHEET NO.
D5


SEE SHEET D4

SEE SHEET E5

SEE SHEET D6

SEE SHEET C5



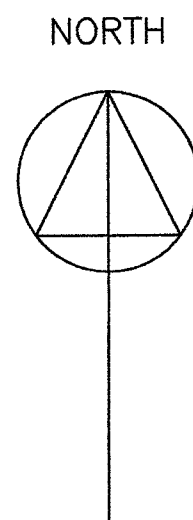


BY	DATE
L.A.M.	1-04
L.A.M.	2-05
L.A.M.	1-06
L.A.M.	1-07
L.A.M.	1-08

LINE LEGEND
3" & SMALLER
4"
6"
8"
10" & 12"
14" & 16"
18" & 20"
24"
30"
36"

PRIVATE	DRAWN <i>Doug Warrick</i>	DATE <i>May, 1991</i>
CHECKED		DATE
APPROVED		DATE

AQUA
Ohio

PREPARED BY:
SERVICE CENTER-ENGINEERING DEPT.
6650 SOUTH AVE. BOARDMAN OHIO 44512

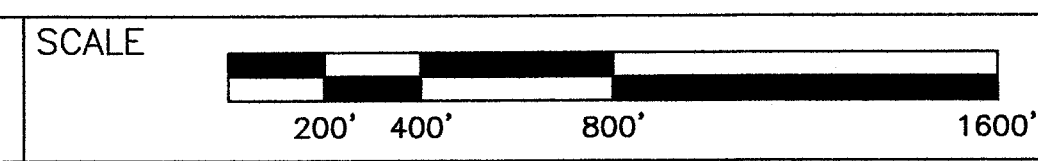

FILE NO.	DISTRIBUTION MATCHLINE MAP STARK REGIONAL DIVISION	SHEET NO. D6
----------	---	------------------------

SEE SHEET D5




SEE SHEET C6

SEE SHEET E6

SEE SHEET D7

H:\Engineering\Drawings\Maps\MA\Map-disp-all.dwg 2/14/2008 4:26:36 PM

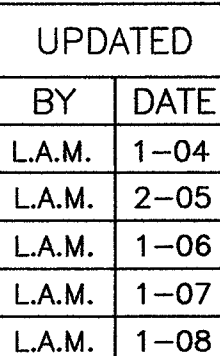

UPDATED	
BY	DATE
L.A.M.	1-04
L.A.M.	2-05
L.A.M.	1-06
L.A.M.	1-07
L.A.M.	1-08

LINE	LEGEND
3" & SMALLER	
4"	
6"	
8"	
10" & 12"	
14" & 16"	
18" & 20"	
24"	
30"	
36"	

PRIVATE	DRAWN <i>Doug Warrick</i>	DATE <i>May, 1991</i>
	CHECKED	DATE
	APPROVED	DATE

AQUA.
Ohio

PREPARED BY:
SERVICE CENTER-ENGINEERING DEPT.
6650 SOUTH AVE. BOARDMAN OHIO 44512

SCALE

200' 400' 800' 1600'

FILE NO.

DISTRIBUTION MATCHLINE MAP
STARK REGIONAL DIVISION

SHEET NO.
D7



UPDATED	
BY	DATE
L.A.M.	1-04
L.A.M.	2-05
L.A.M.	1-07
L.A.M.	1-08

SEE SHEET C8

SEE SHEET E8

LINE	LEGEND
---	3" & SMALLER
----	4"
-----	6"
-----	8"
-----	10" & 12"
-----	14" & 16"
-----	18" & 20"
-----	24"
-----	30"
-----	36"

DRAWN <i>Doug Warrick</i>	DATE <i>May, 1991</i>
CHECKED	DATE
APPROVED	DATE

AQUA.
Ohio

PREPARED BY:
SERVICE CENTER-ENGINEERING DEPT.
6650 SOUTH AVE. BOARDMAN OHIO 44512

SCALE





A horizontal scale bar with alternating black and white segments. Below the bar, tick marks indicate distances of 200', 400', 800', and 1600'.

FILE NO.

DISTRIBUTION MATCHLINE MAP
STARK REGIONAL DIVISION

SHEET NO.
D8

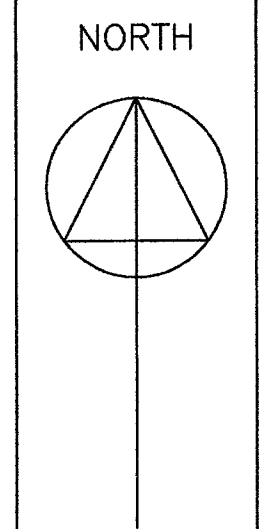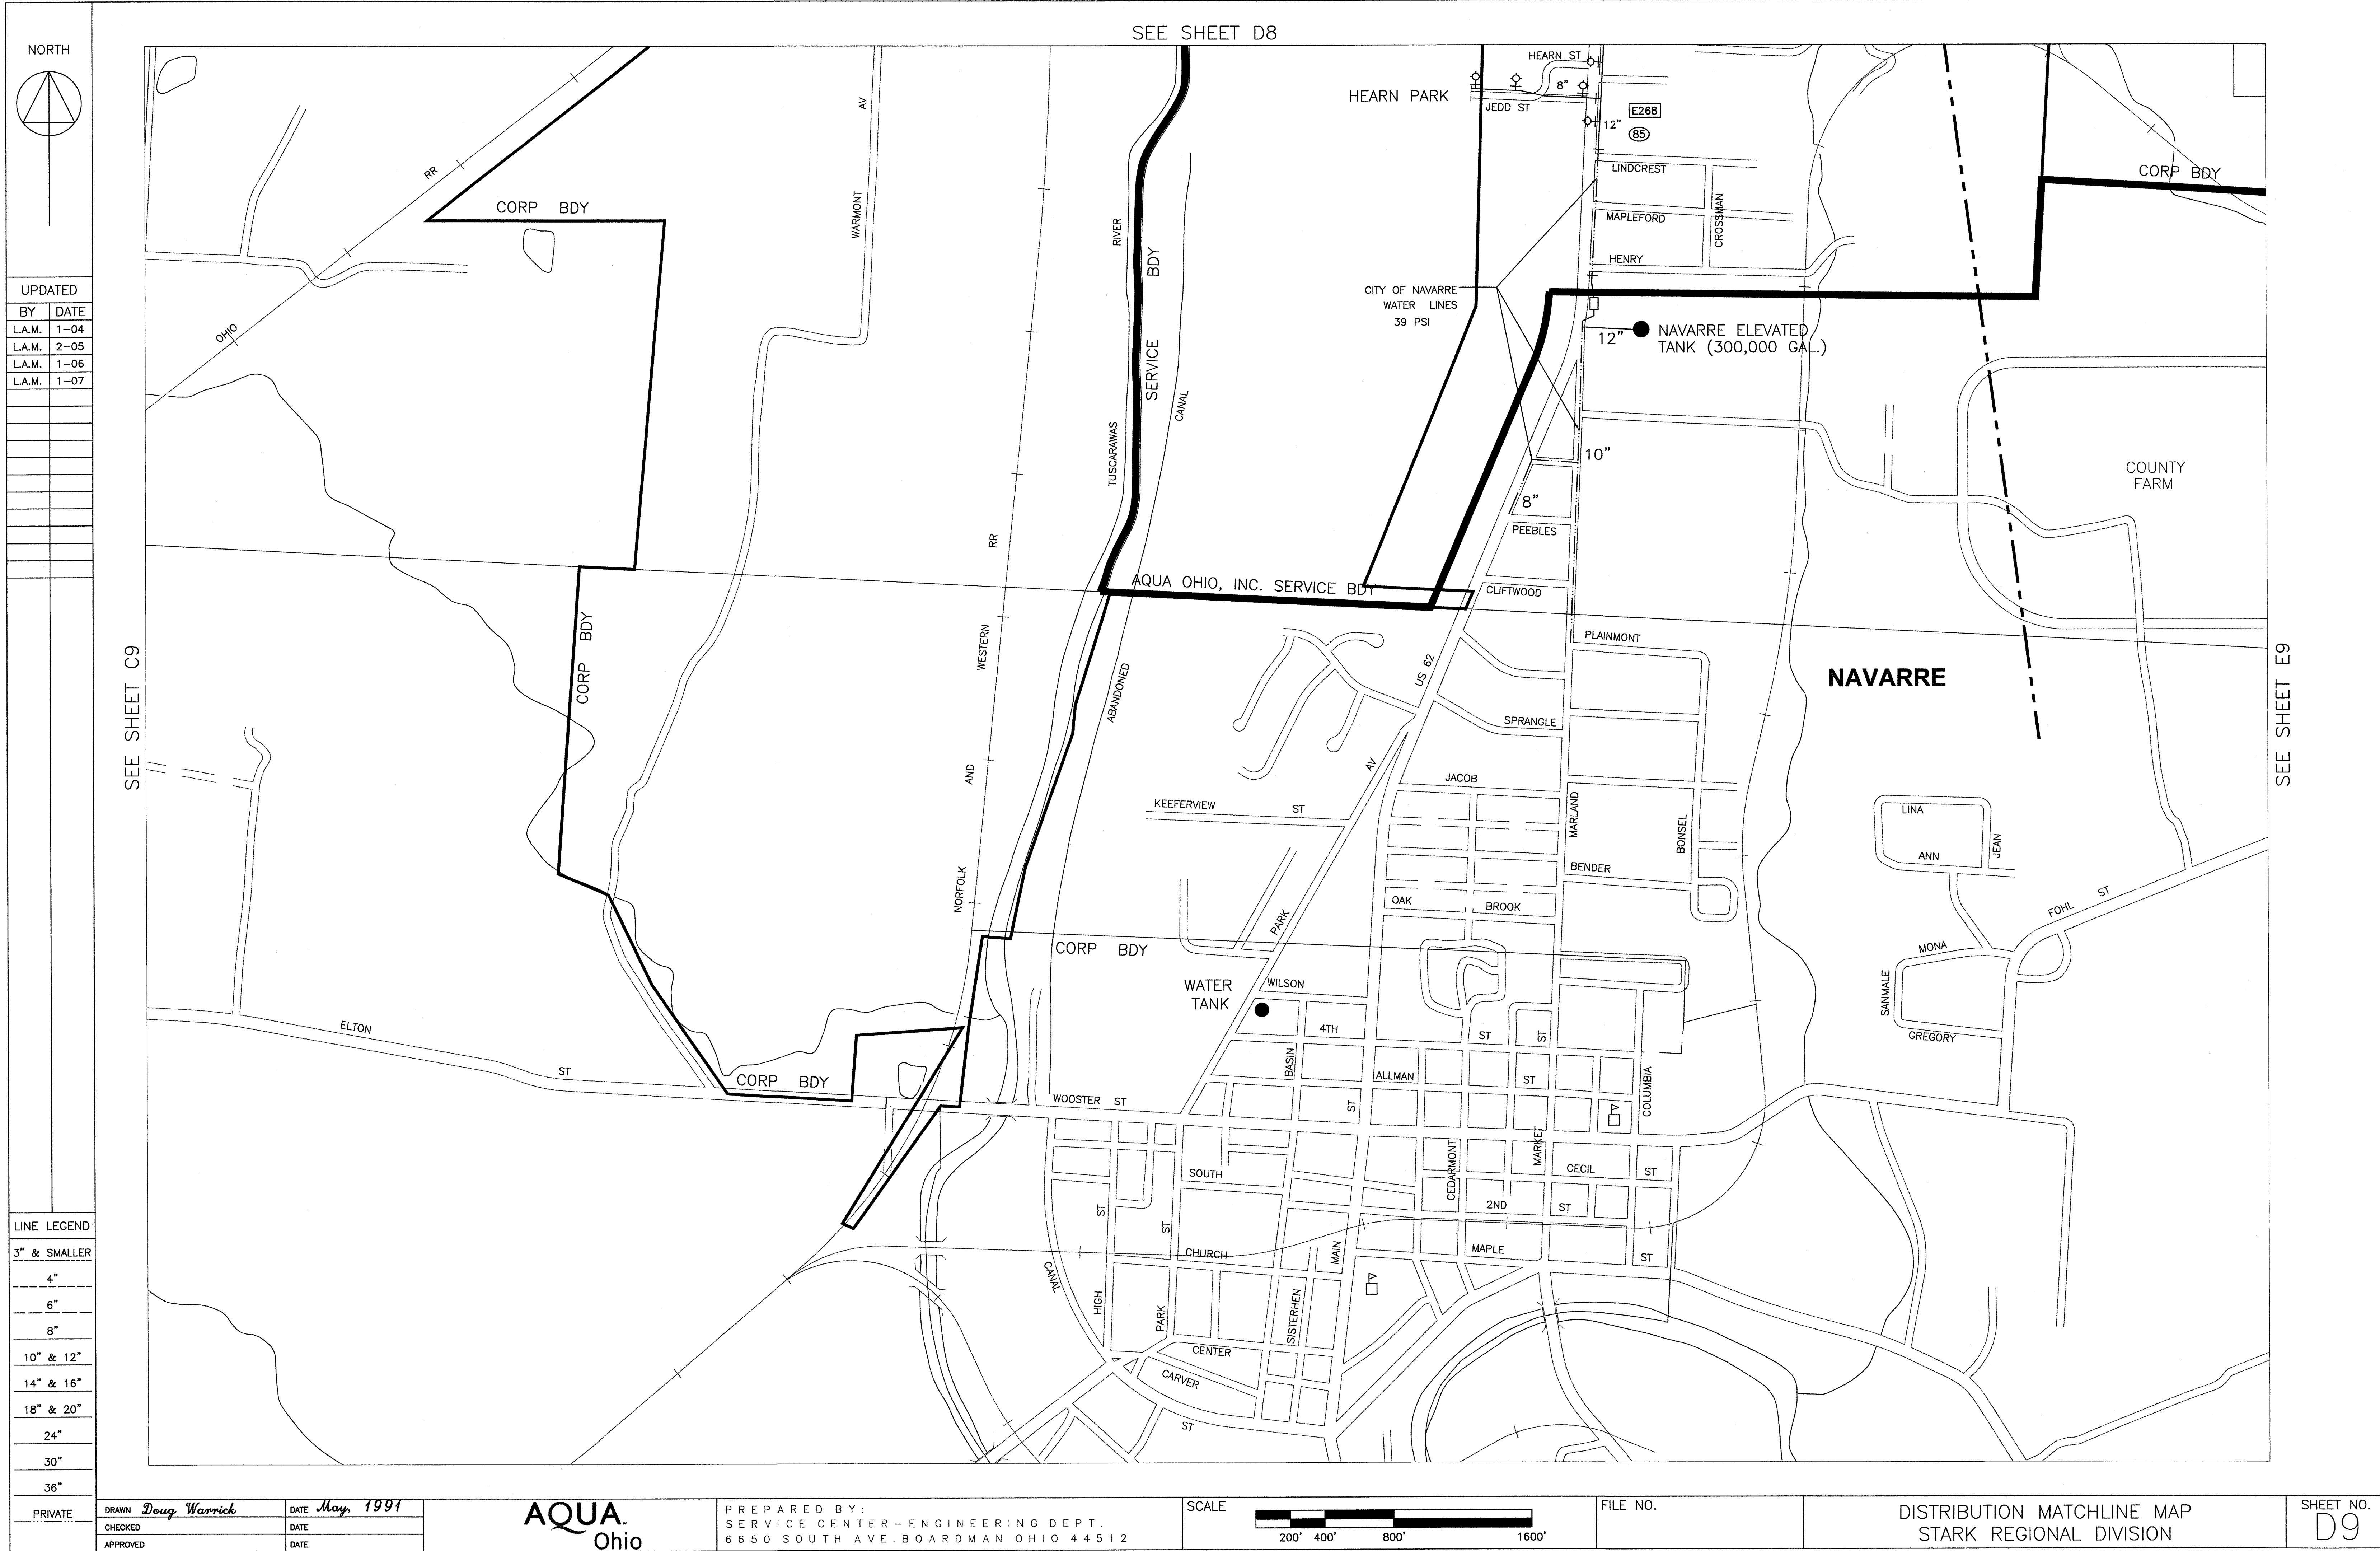


UPDATED	
BY	DATE
L.A.M.	1-04
L.A.M.	2-05
L.A.M.	1-06
L.A.M.	1-07

LINE LEGEND	
3" & SMALLER	
4"	
6"	
8"	
10" & 12"	
14" & 16"	
18" & 20"	
24"	
30"	
36"	

PRIVATE	DRAWN <i>Doug Warrick</i>	DATE <i>May, 1991</i>
CHECKED		DATE
APPROVED		DATE



PREPARED BY:
SERVICE CENTER-ENGINEERING DEPT.
6650 SOUTH AVE. BOARDMAN OHIO 44512

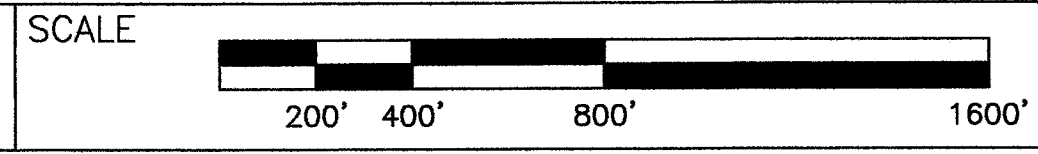


FILE NO.

DISTRIBUTION MATCHLINE MAP
STARK REGIONAL DIVISION

SHEET NO.
D9

H:\Engineering Drawings\Maps\WA\Map-disp-all.dwg, 2/15/2008 9:02:38 AM

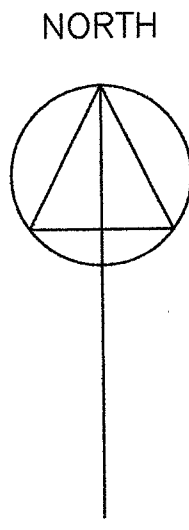


UPDATED	
BY	DATE
L.A.M.	1-04
L.A.M.	2-05
L.A.M.	1-06
L.A.M.	1-07
L.A.M.	1-08

LINE LEGEND	
3" & SMALLER	
4"	
6"	
8"	
10" & 12"	
14" & 16"	
18" & 20"	
24"	
30"	
36"	
PRIVATE	
DRAWN	Doug Warrick
CHECKED	
APPROVED	
DATE	May, 1991
DATE	
DATE	

AQUA
Ohio

PREPARED BY:
SERVICE CENTER-ENGINEERING DEPT.
6650 SOUTH AVE. BOARDMAN OHIO 44512

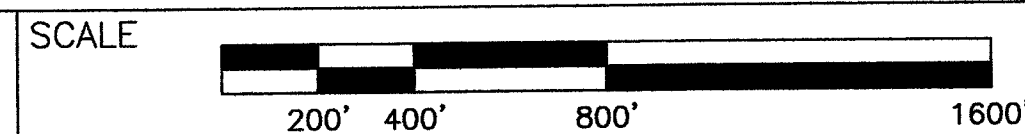

FILE NO.

DISTRIBUTION MATCHLINE MAP
STARK REGIONAL DIVISION

SHEET NO.
E5


SEE SHEET D5

SEE SHEET E4

SEE SHEET F5

SEE SHEET E6

H:\Engineering Drawings\Maps\MA Mo-disp-all.dwg, 2/15/2008 9:09:56 AM

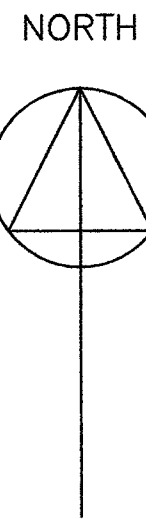

UPDATED	
BY	DATE
L.A.M.	1-04
L.A.M.	2-05
L.A.M.	1-06
L.A.M.	1-07
L.A.M.	1-08

SEE SHEET D6

LINE LEGEND	
3" & SMALLER	
4"	
6"	
8"	
10" & 12"	
14" & 16"	
18" & 20"	
24"	
30"	
36"	
PRIVATE	

DRAWN	Doug Warrick	DATE	May, 1991
CHECKED		DATE	
APPROVED		DATE	

AQUA
Ohio

PREPARED BY:
SERVICE CENTER-ENGINEERING DEPT.
6650 SOUTH AVE. BOARDMAN OHIO 44512


SCALE
200' 400' 800' 1600'

FILE NO.

DISTRIBUTION MATCHLINE MAP
STARK REGIONAL DIVISION


SHEET NO.
E6

SEE SHEET E5

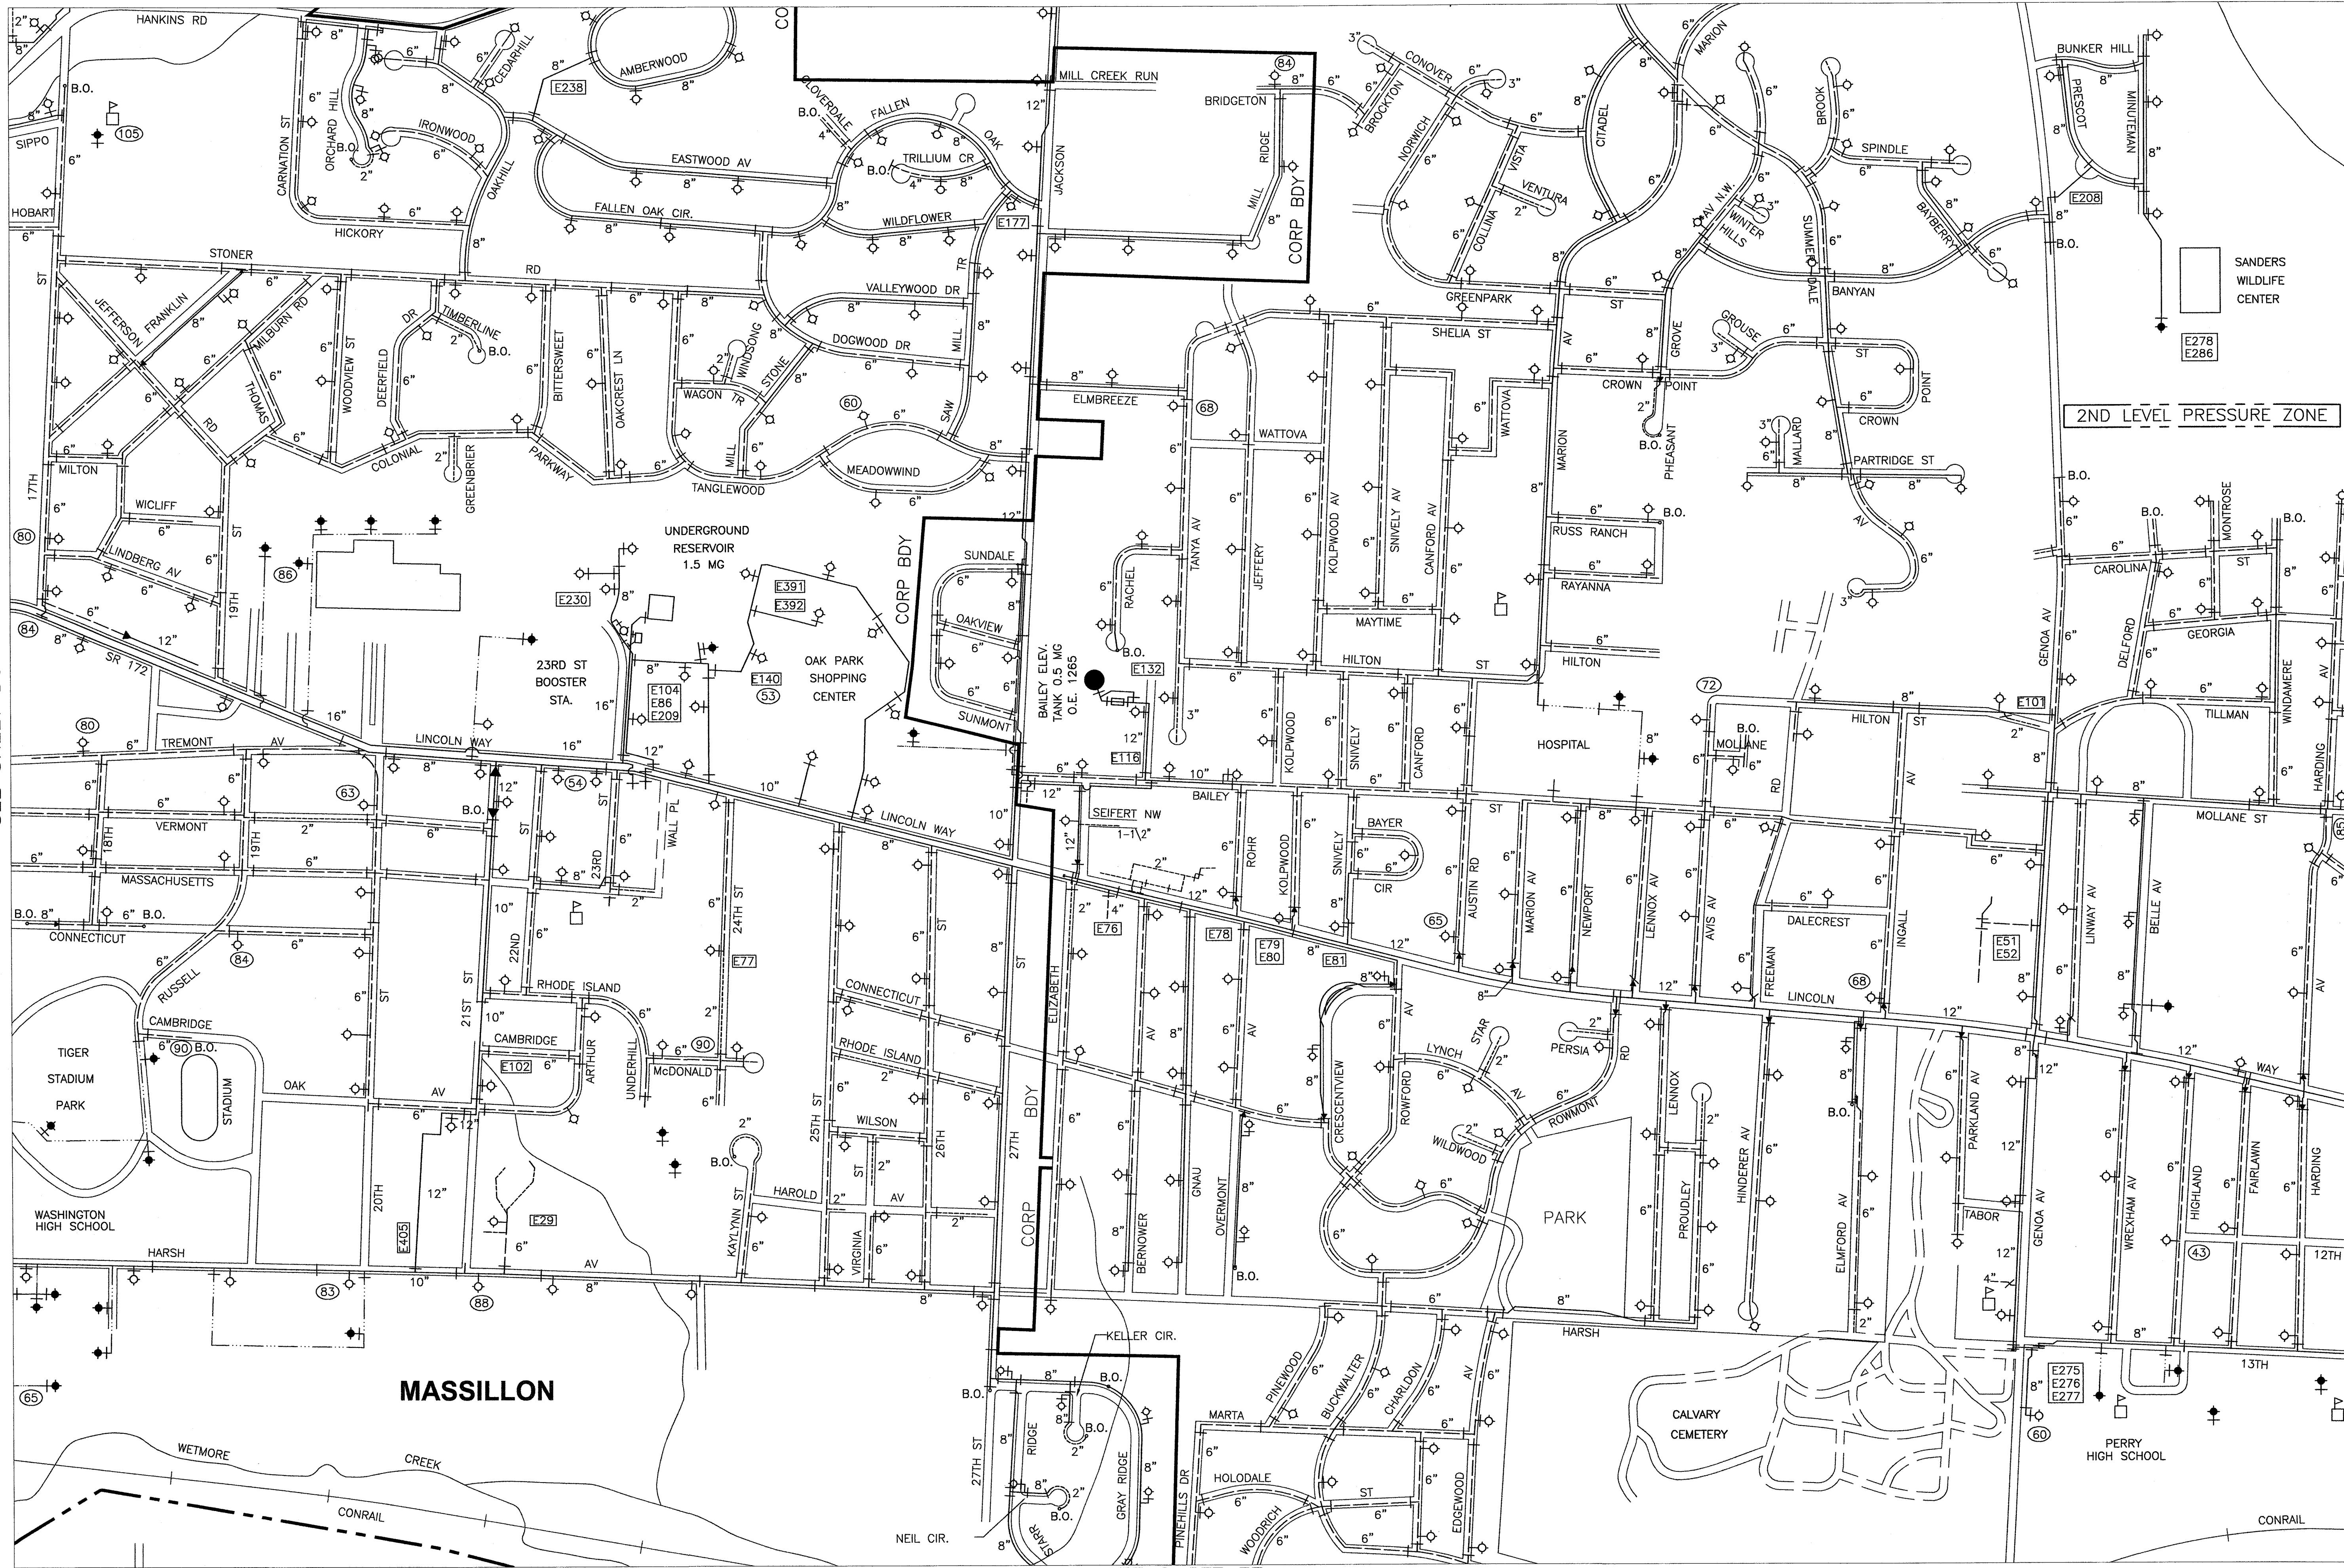

SEE SHEET F6

SEE SHEET E7

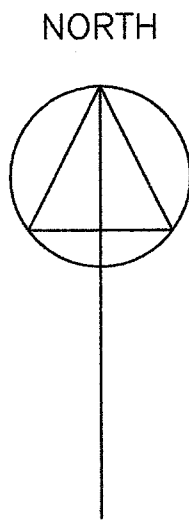


UPDATED	
BY	DATE
L.A.M.	1-04
L.A.M.	2-05
L.A.M.	1-07
L.A.M.	1-08

LINE LEGEND	
3" & SMALLER	
4"	
6"	
8"	
10" & 12"	
14" & 16"	
18" & 20"	
24"	
30"	
36"	

PRIVATE	DRAWN <i>Doug Warrick</i>	DATE <i>May, 1991</i>
	CHECKED	DATE
	APPROVED	DATE

AQUA
Ohio


PREPARED BY:
SERVICE CENTER-ENGINEERING DEPT.
6650 SOUTH AVE. BOARDMAN OHIO 44512

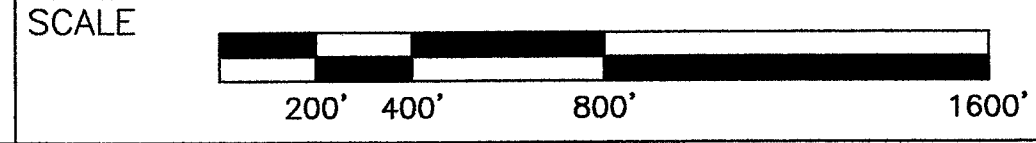


FILE NO.

DISTRIBUTION MATCHLINE MAP
STARK REGIONAL DIVISION

SHEET NO.
E7

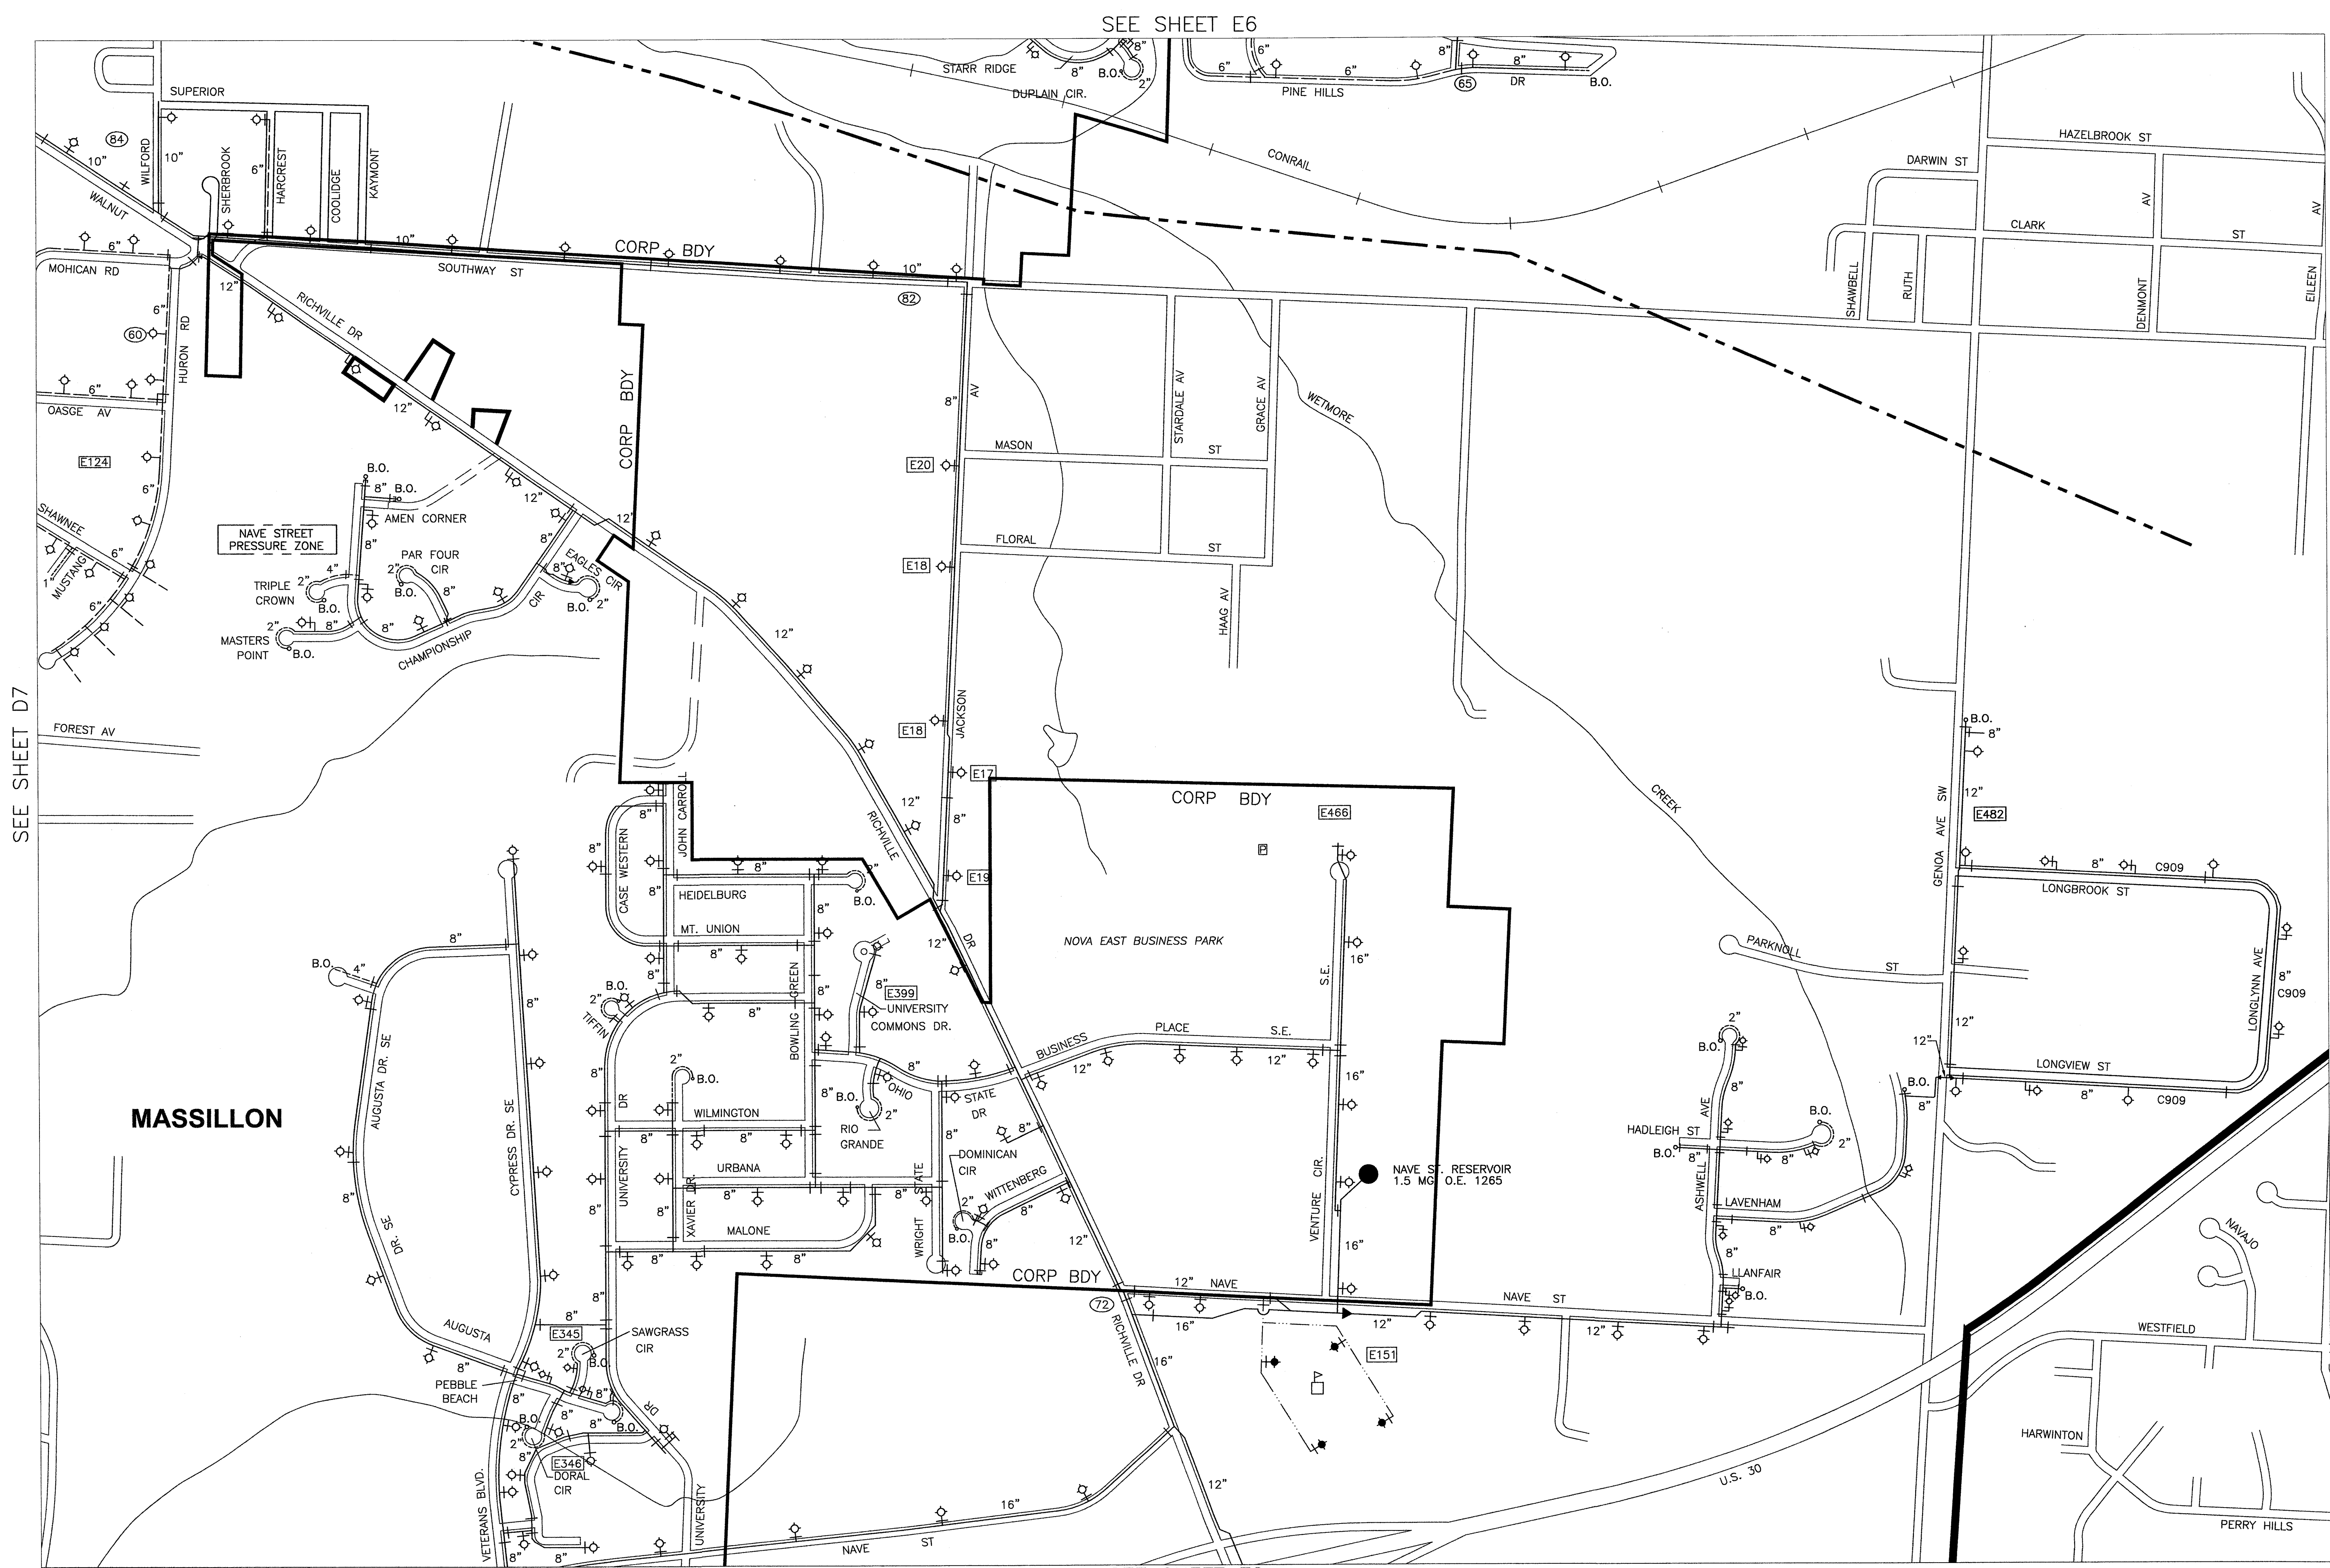


H:\Engineering Drawings Maps\MA Mo-disp-all.dwg, 2/15/2008 9:50:15 AM

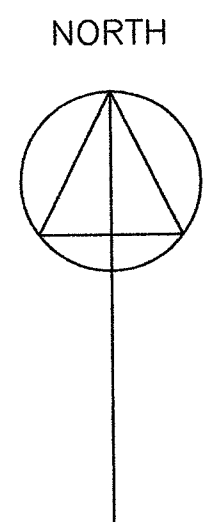

UPDATED	
BY	DATE
L.A.M.	1-04
L.A.M.	2-05
L.A.M.	1-06
L.A.M.	1-07
L.A.M.	1-08

LINE LEGEND	
3" & SMALLER	
4"	
6"	
8"	
10" & 12"	
14" & 16"	
18" & 20"	
24"	
30"	
36"	
PRIVATE	

SEE SHEET D8

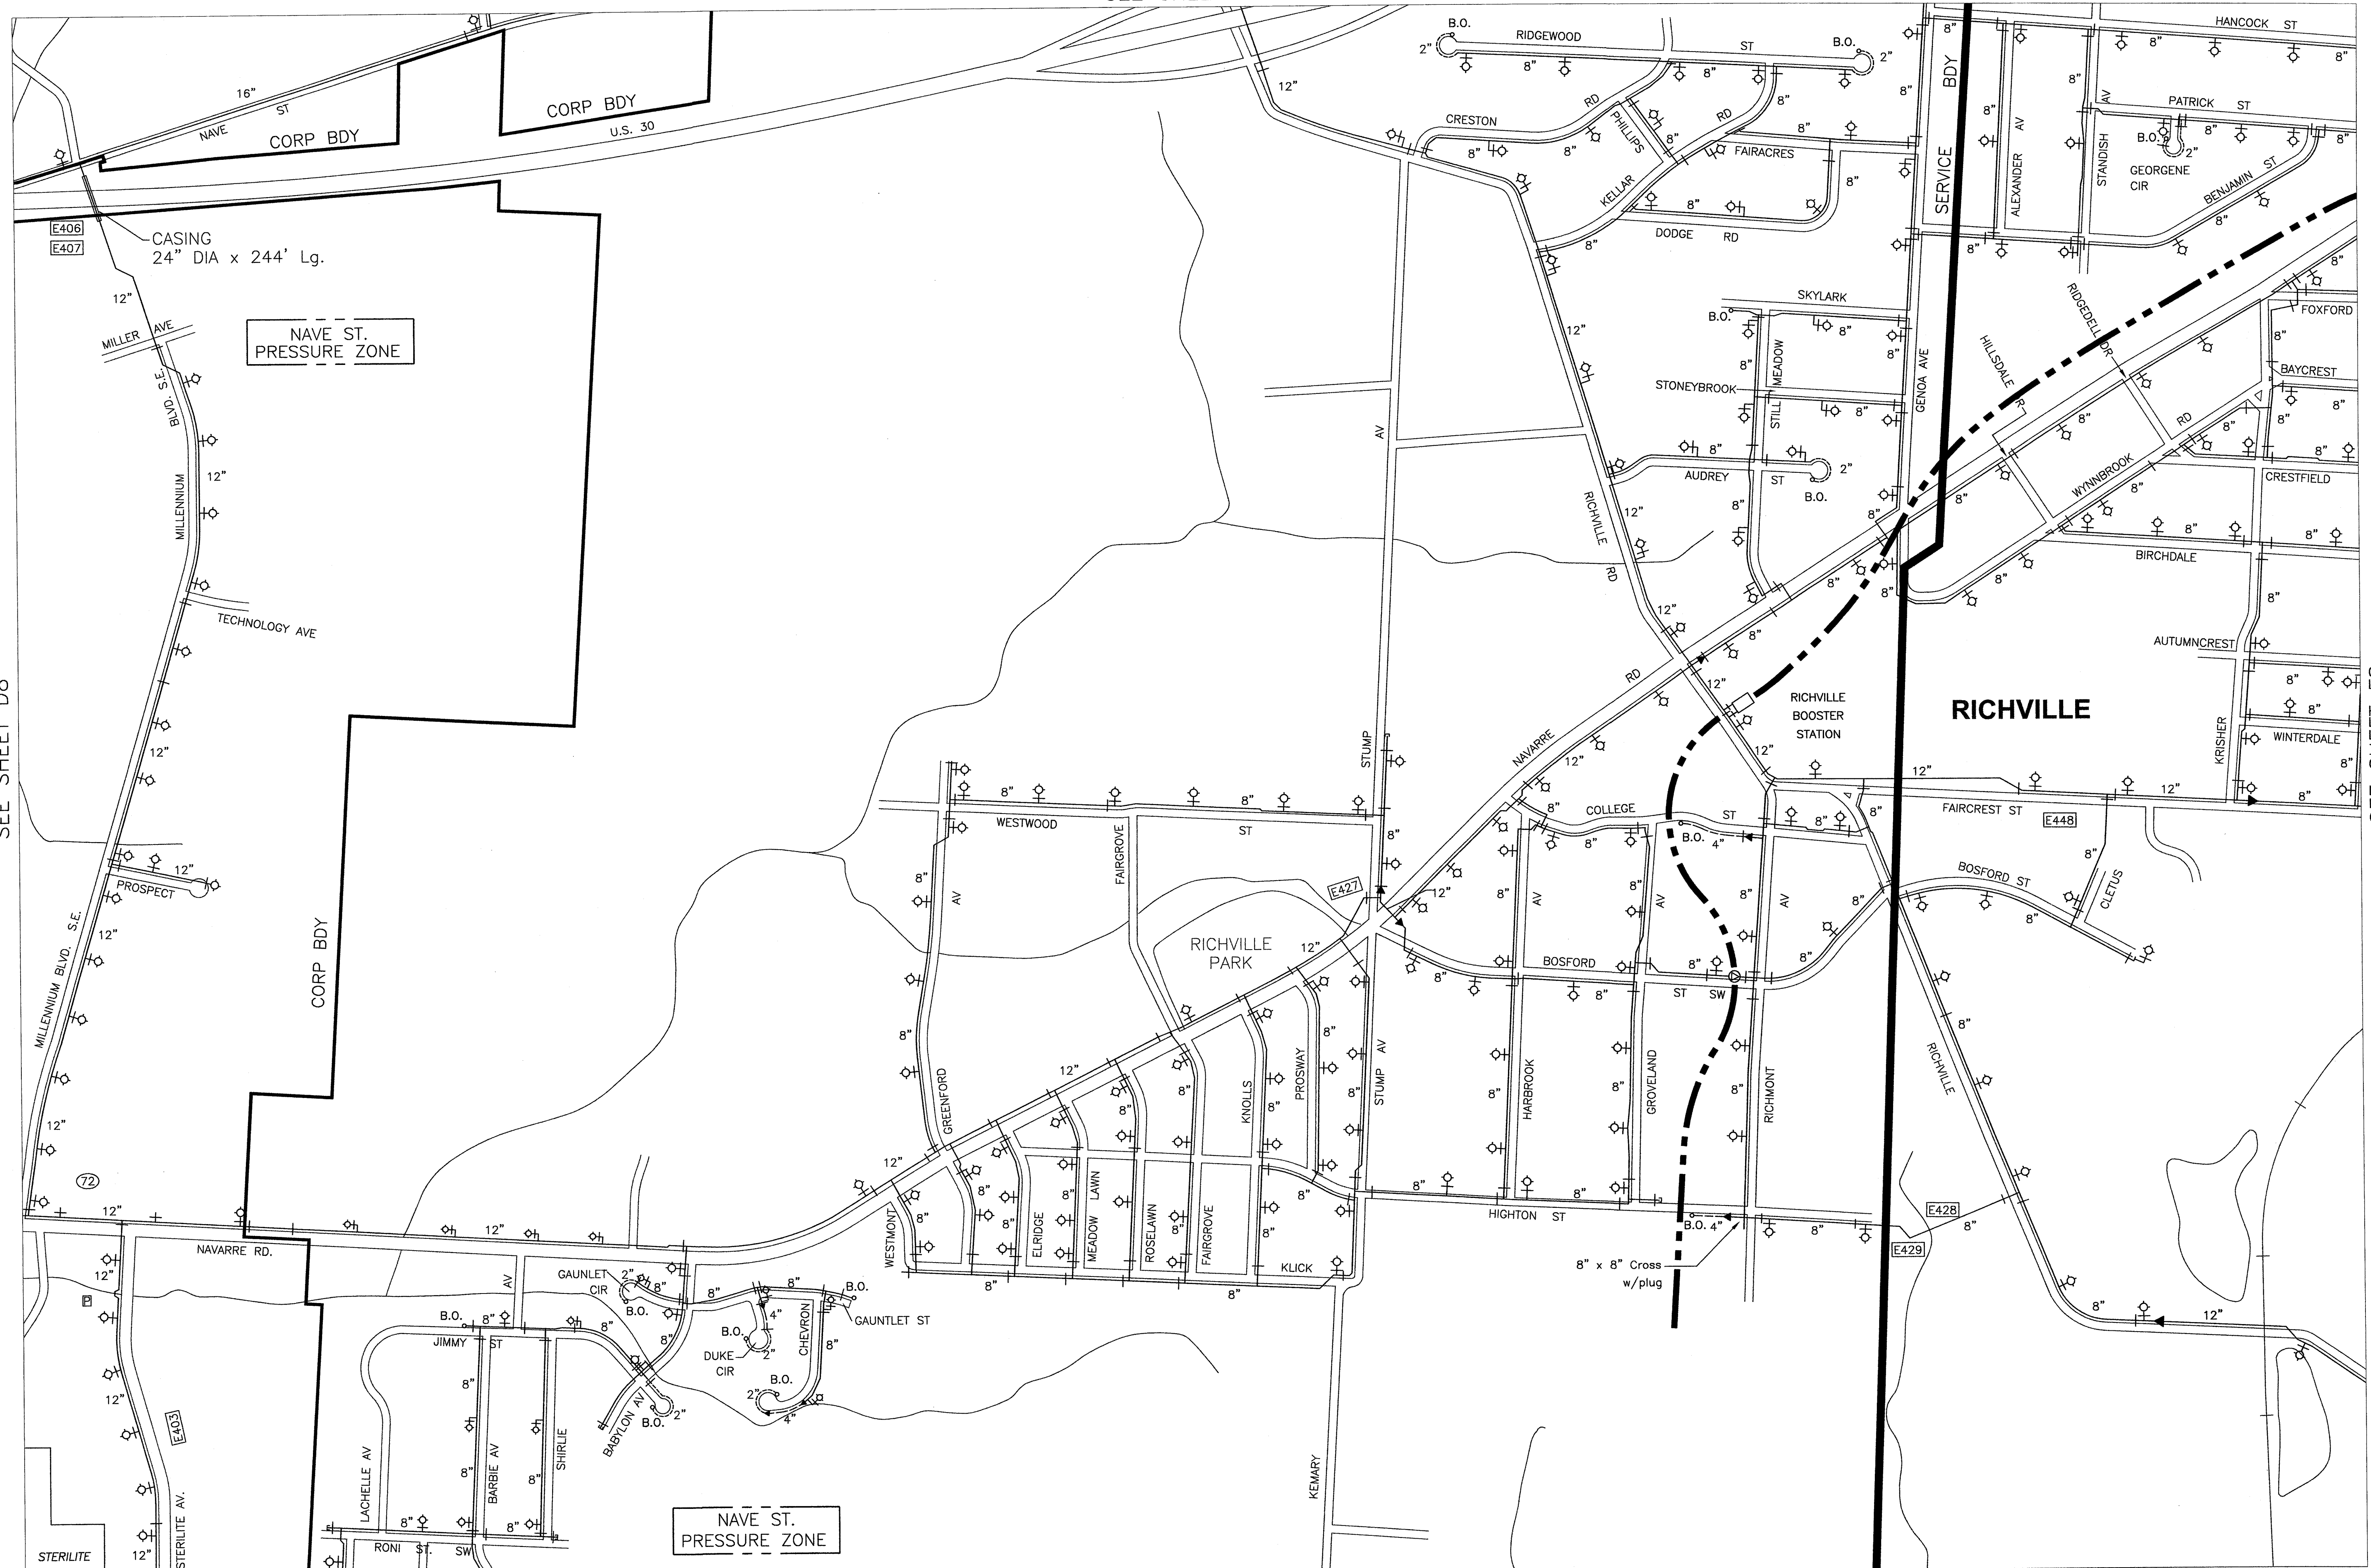


SEE SHEET F8


SEE SHEET E7

SEE SHEET E9

DRAWN	Doug Warrick	DATE	May, 1991
CHECKED		DATE	
APPROVED		DATE	

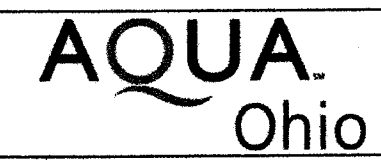


PREPARED BY:
SERVICE CENTER-ENGINEERING DEPT.
6650 SOUTH AVE., BOARDMAN OHIO 44512

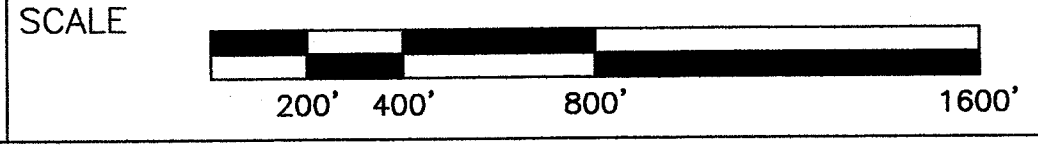

FILE NO.

DISTRIBUTION MATCHLINE MAP
STARK REGIONAL DIVISION


SHEET NO.
E8

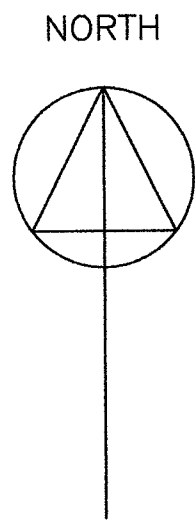

UPDATED	
BY	DATE
L.A.M.	1-04
L.A.M.	2-05
L.A.M.	1-06

LINE LEGEND	
3" & SMALLER	
4"	
6"	
8"	
10" & 12"	
14" & 16"	
18" & 20"	
24"	
30"	
36"	
PRIVATE	

SEE SHEET D9

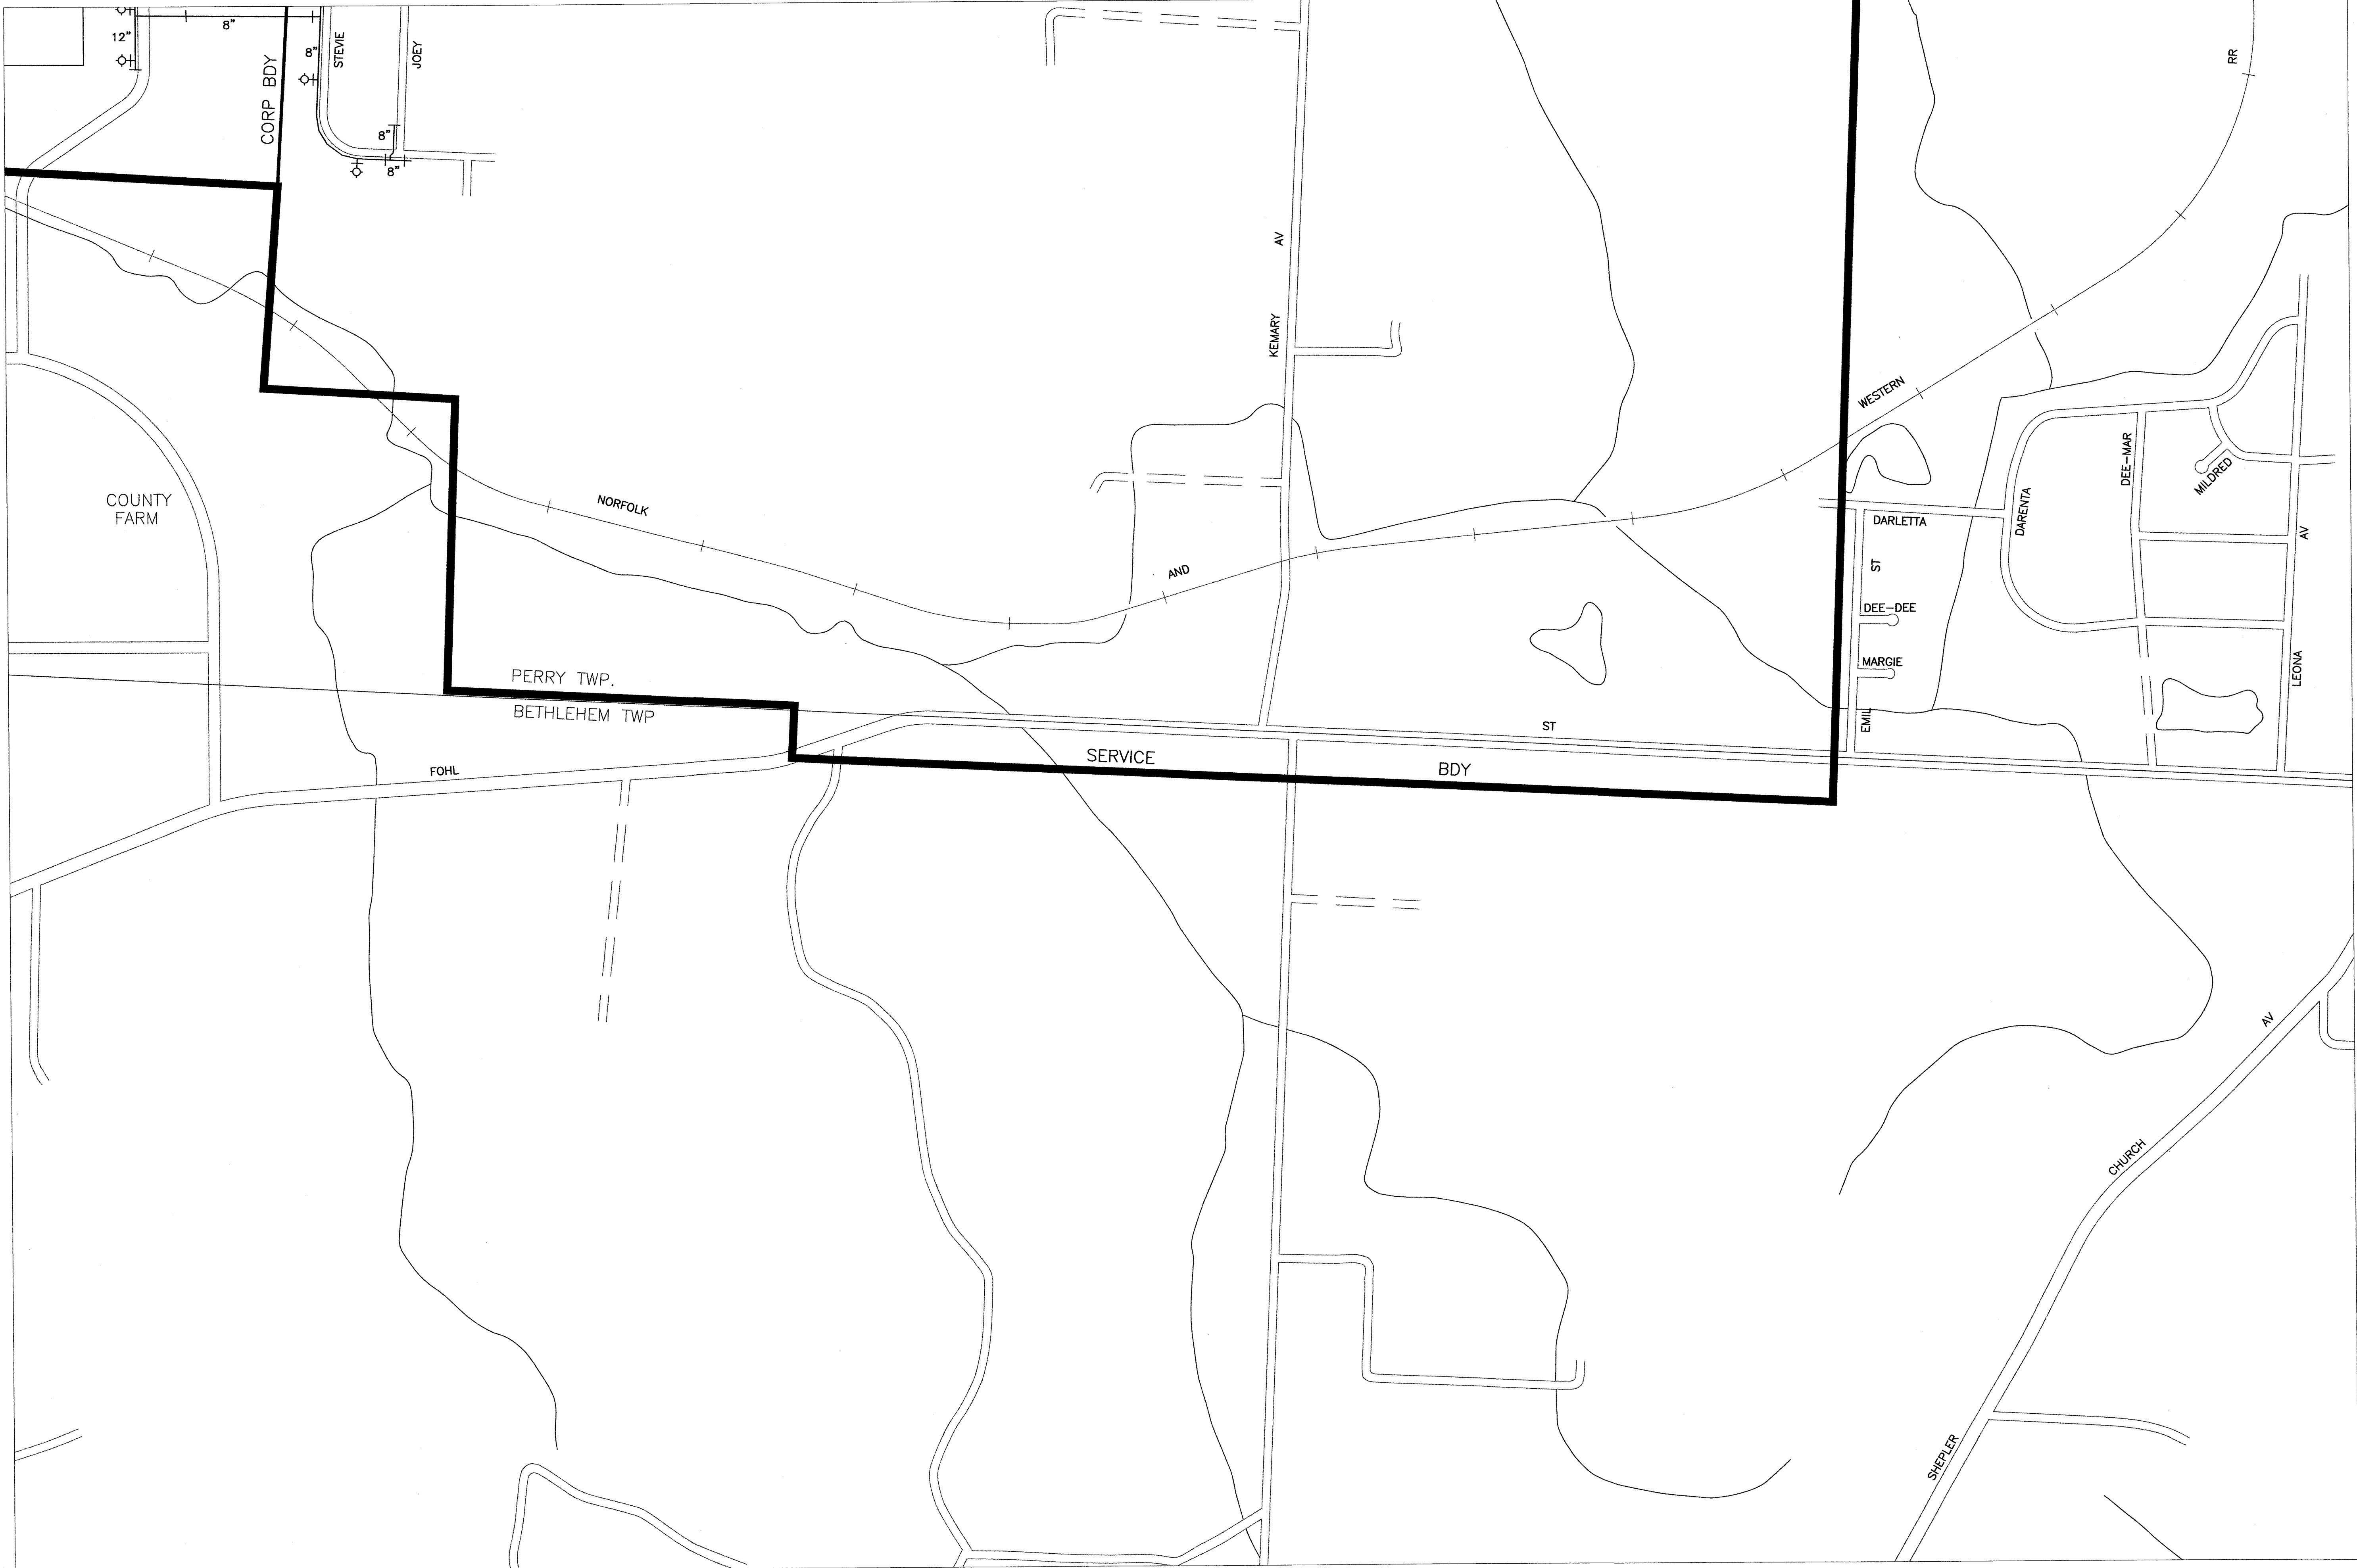

SEE SHEET F9


SEE SHEET E8

\\A:\Engineering\Drawings\Maps\Aqua\Aqua.dwg, 3/29/2006, 4:35:15 PM, LP Design\JTB\2006.dwg

DRAWN	<i>Doug Warrick</i>	DATE	<i>May, 1991</i>
CHECKED		DATE	
APPROVED		DATE	

AQUA
Ohio

PREPARED BY:
SERVICE CENTER-ENGINEERING DEPT.
6650 SOUTH AVE. BOARDMAN OHIO 44512

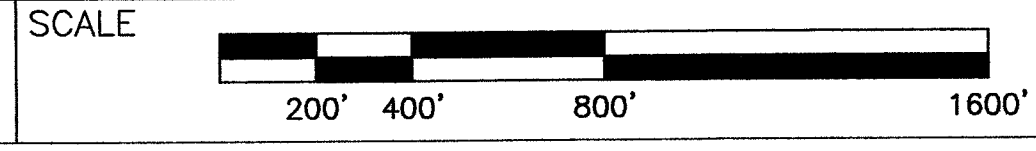

FILE NO.

DISTRIBUTION MATCHLINE MAP
STARK REGIONAL DIVISION

SHEET NO.
E9