FOLLOWING DATA TO BE ANSWERED BY INSPECTOR AND SIGNED WHEN RETURNED

No. 3764

See NOTE BOOK 125 Page 78

Date Inspected Nov. 1st 35

House No. 1651

Size of pipe used 6"

Was lateral at curb? Yes.

Was attached to main Lat" 14

I so how and location from first manhole down stream

Distance from first manhole down stream to ditch at curb line and depth 87' From M.H. SOUTH. and 7' Deep at Curb

Name of Contractor E. A. Smith

Show by diagram relation of lateral to wall of building served.

House was built before sewer investigation was made. had 6" fall in 58' from curb to house. decided to raise soil pipe in basement to give it more fall making a total of 9" fall in all.

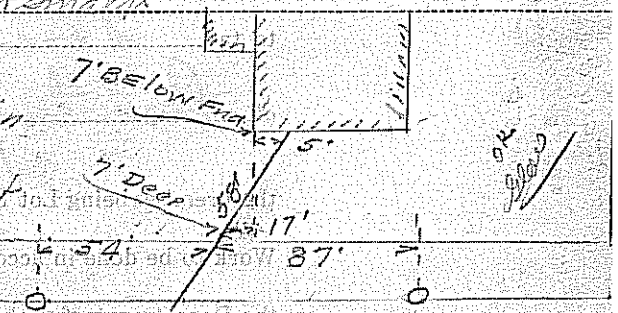

PRESS TITE CALK TITE and SERVICISED JOINTS USED

COVENTRY RD N.E.

Signed [signature] Inspector for City

Filed at Engineer's Office NOV 1 1935

Remarks: Lateral at curb is 17' S.E. of S. side of House and 3½' North From I. P. on South at curb line PROP. LINE at walk.

OFFICE OF THE DIRECTOR OF PUBLIC SERVICE

No. 3764

PERMIT TO TAP SEWER

Massillon, O., Oct 26 19

Received of L. M. Laubheim fee of $2.00

for which permission is granted L. M. Laubheim

to tap 4" tap sewer, on the Lateral

of Lincoln Way E Ave., Type of Street Asph
St.,

the premises being Lot No. 3336, House No. 1451

Work to be done in accordance with Ordinance No. 2323, duly passed by the City Council, and Ru

the Department of Public Service.

Name of Contractor L. M. Laubheim

NOTE. This permit covers work outside of building only. Any work inside walls of bu
is subject to Massillon Board of Health Regulations.