
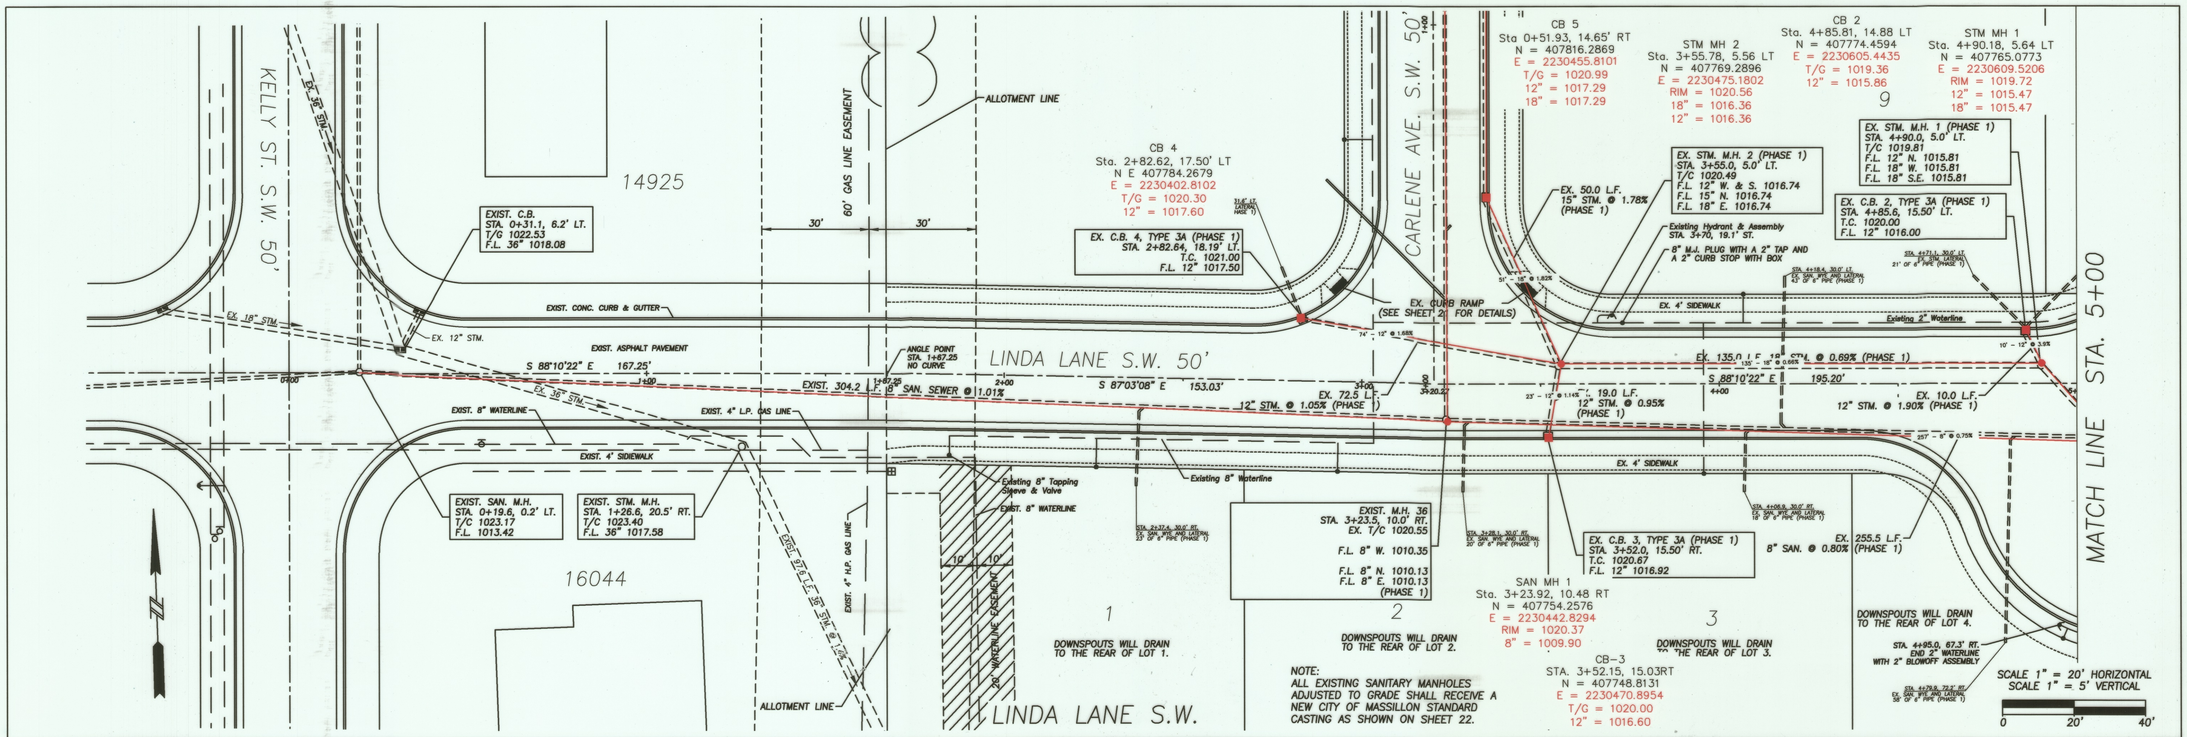


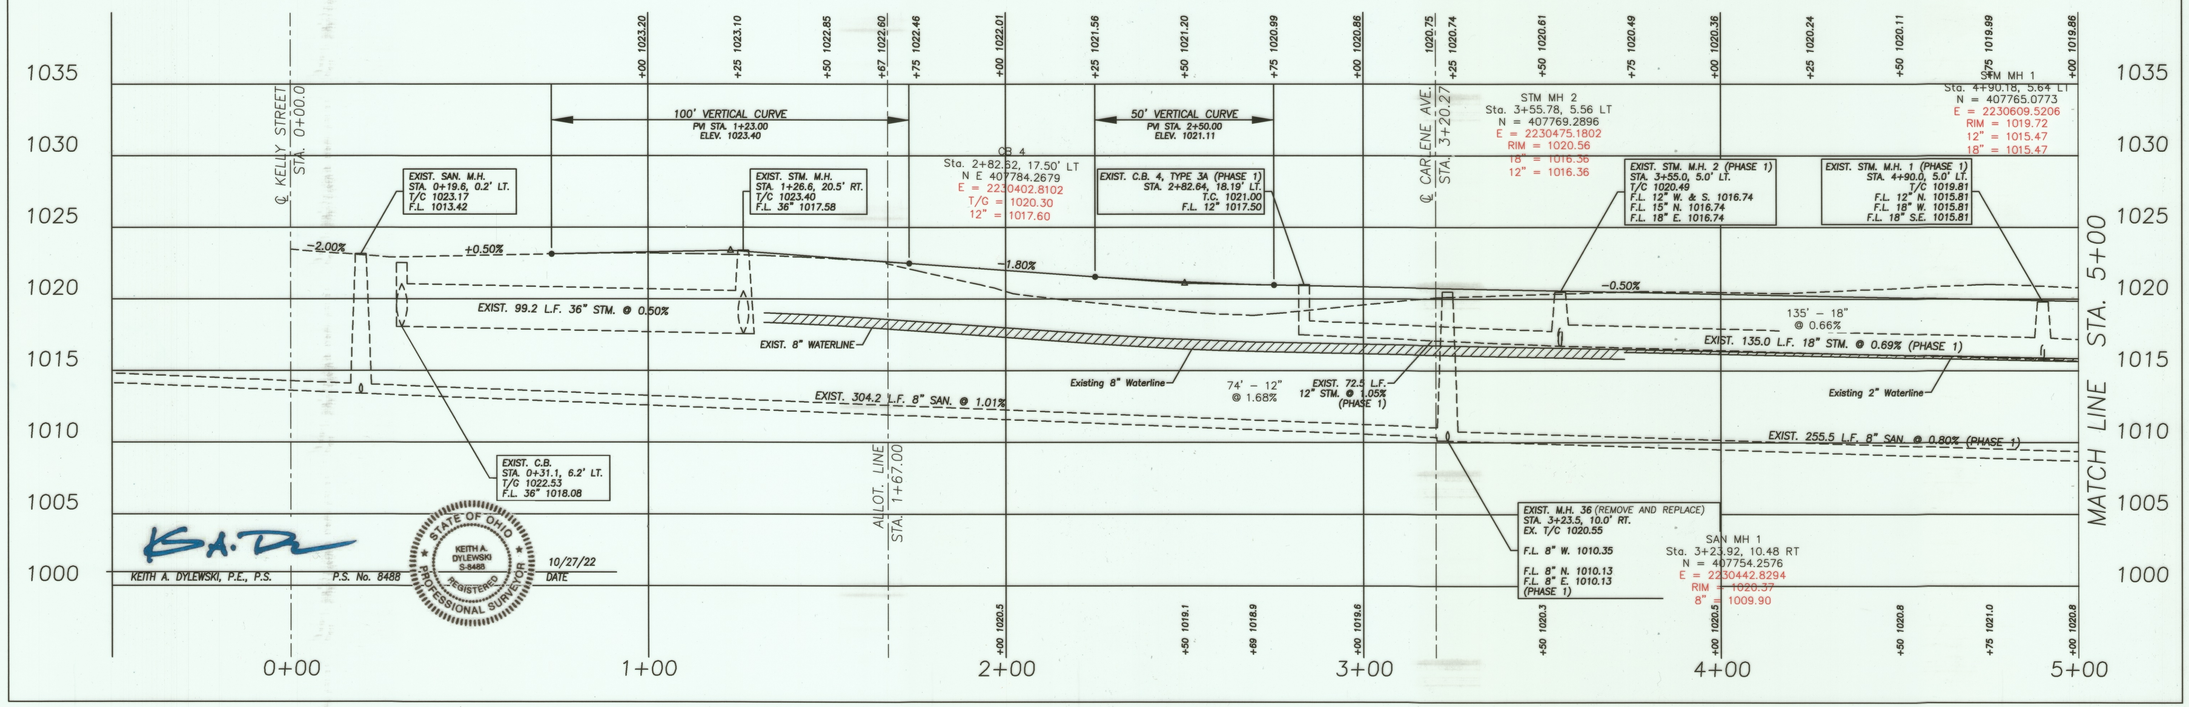

NW NE SW SE N

VERTICAL IN FEET 5 2.5 0

0 10 20 HORIZONTAL SCALE IN FEET

CHECKED BY: KAD

DATE: Sept 2022

DRAWN BY: BMH

DATE: Sept 2022

REVISIONS:

DATE	DESCRIPTION


Country View Meadows Allotment As-Built
Plan & Profile
City of Massillon
Stark County, Ohio


CIVPRO ENGINEERING
ENGINEERS · SURVEYORS · PLANNERS
4450 BELDEN VILLAGE STREET NW, SUITE 800 CANTON, OH 44718
PHONE: (234) 410-3913 EMAIL: MAIL@CIVPROENGINEERING.COM
WWW.CIVPROENGINEERING.COM

DRAWING NAME:

REF NUMBER: 4

22SD02

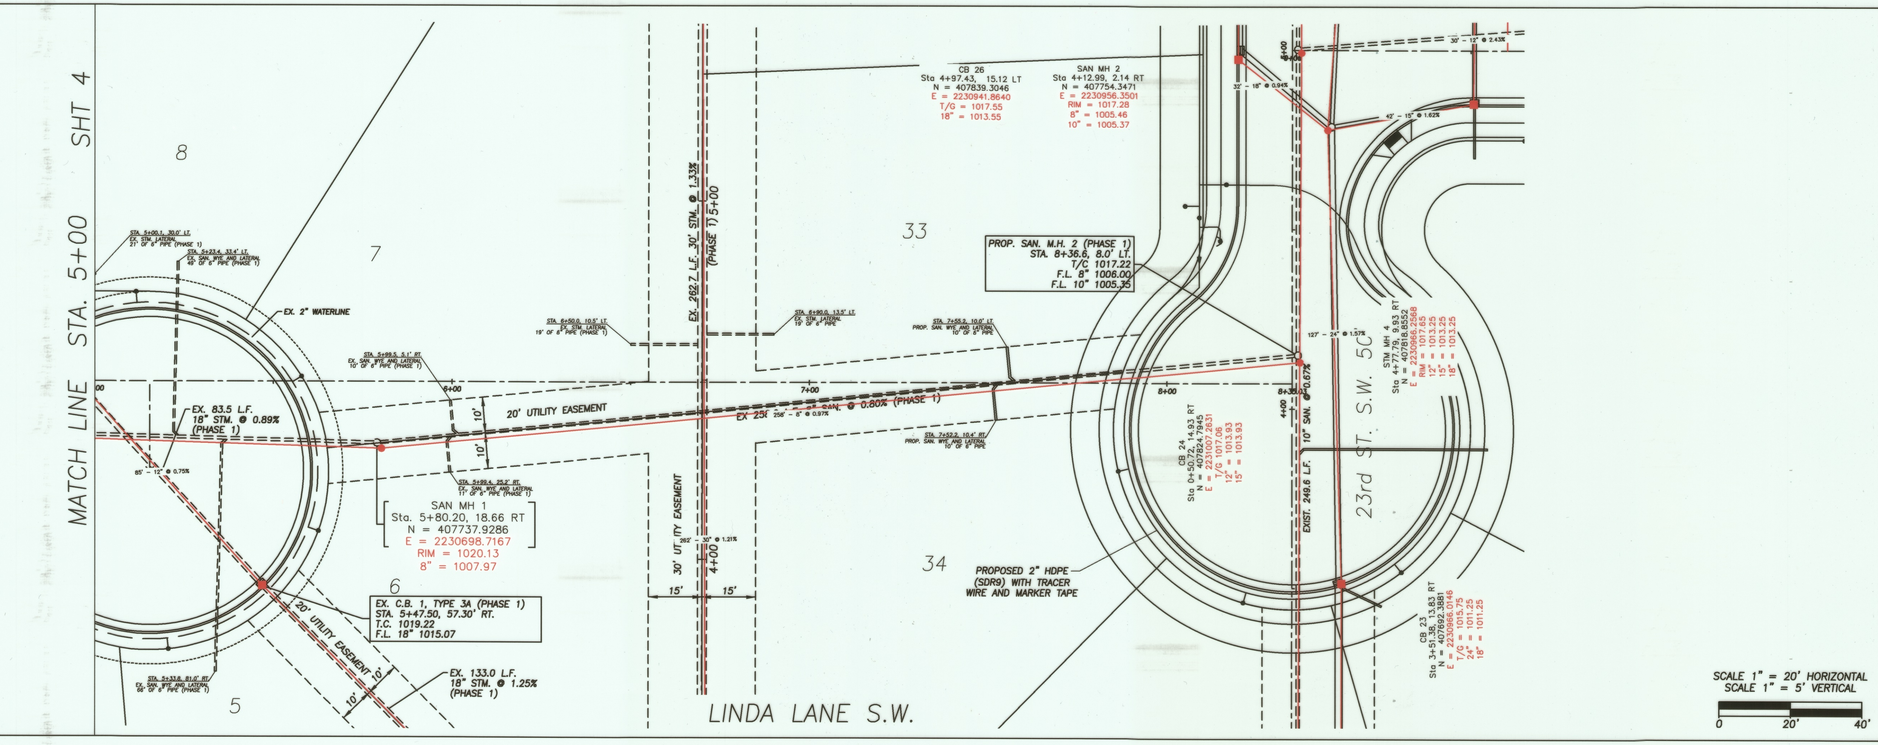

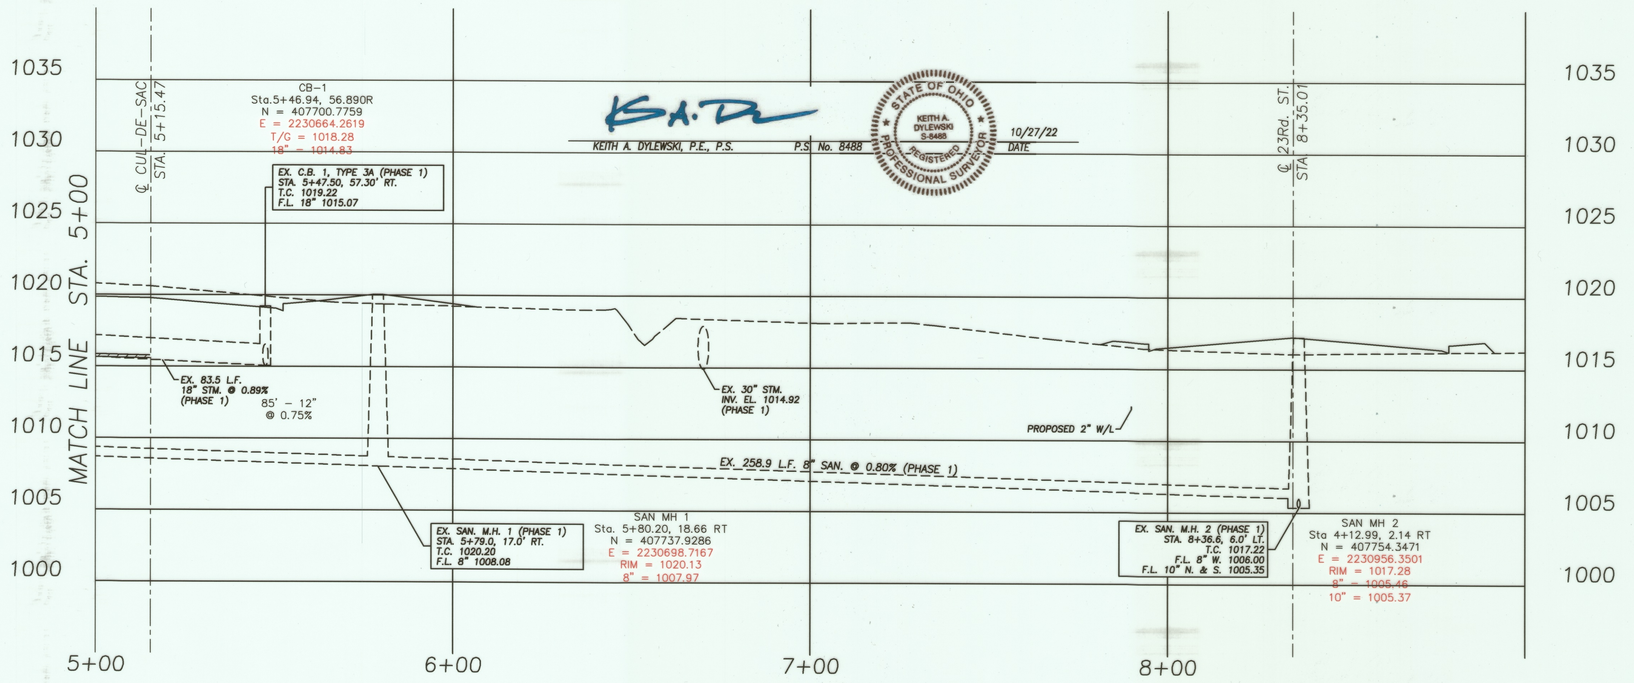

KEITH A. DYLEWSKI, P.E., P.S. P.S. No. 8488 10/27/22 DATE

STATE OF OHIO KEITH A. DYLEWSKI S-8488 REGISTERED PROFESSIONAL SURVEYOR

NW NE SW SE N

VERTICAL IN FEET 5 2.5 0

0 10 20 HORIZONTAL SCALE IN FEET

CHECKED BY: KAD

DATE: Sept 2022

DRAWN BY: BMH

DATE: Sept 2022

REVISIONS: DATE DESCRIPTION

Country View Meadows Allotment As-Builts
Plan & Profile
City of Massilon
Stark County, Ohio

CIVPRO ENGINEERING
ENGINEERS-SURVEYORS-CONSTRUCTION MANAGERS
4450 BELDEN VILLAGE STREET NW, SUITE 800 CANTON, OH 44718
PHONE (234) 418-3810 EMAIL: KADM@CIVPROENGINEERING.COM
WWW.CIVPROENGINEERING.COM

DRAWING NAME:

REF NUMBER: 5

22502

NOTE: ALL WATER LINES MUST MAINTAIN AN 18" MINIMUM CLEARANCE FROM ALL STORM AND SANITARY LATERALS AT CROSSING POINTS.

NOTE: ALL EXISTING SANITARY MANHOLES ADJUSTED TO GRADE SHALL RECEIVE A NEW CITY OF MASSILLON STANDARD CASTING AS SHOWN ON SHEET 22.

SCALE 1" = 20' HORIZONTAL
SCALE 1" = 5' VERTICAL

0 20' 40'

0 10 20
HORIZONTAL SCALE IN FEET

VERTICAL IN FEET 5 2.5 0

CHECKED BY: KAD
DATE: Sept 2022
DRAWN BY: BMH
DATE: Sept 2022


REVISIONS:
DATE DESCRIPTION


Country View Meadows Allotment As-Builts
Plan & Profile
City of Massillon
Stark County, Ohio

CIVPRO ENGINEERING
ENGINEERS-SURVEYORS-CONSTRUCTION MANAGERS
4450 BELDEN VILLAGE STREET NW, SUITE 800 CANTON, OH 44718
PHONE: (234) 410-3013 EMAIL: KADEOPKEIGHER@GMAIL.COM
WWW.CIVPROENGINEERING.COM

DRAWING NAME:
REF NUMBER:
6

22SD02

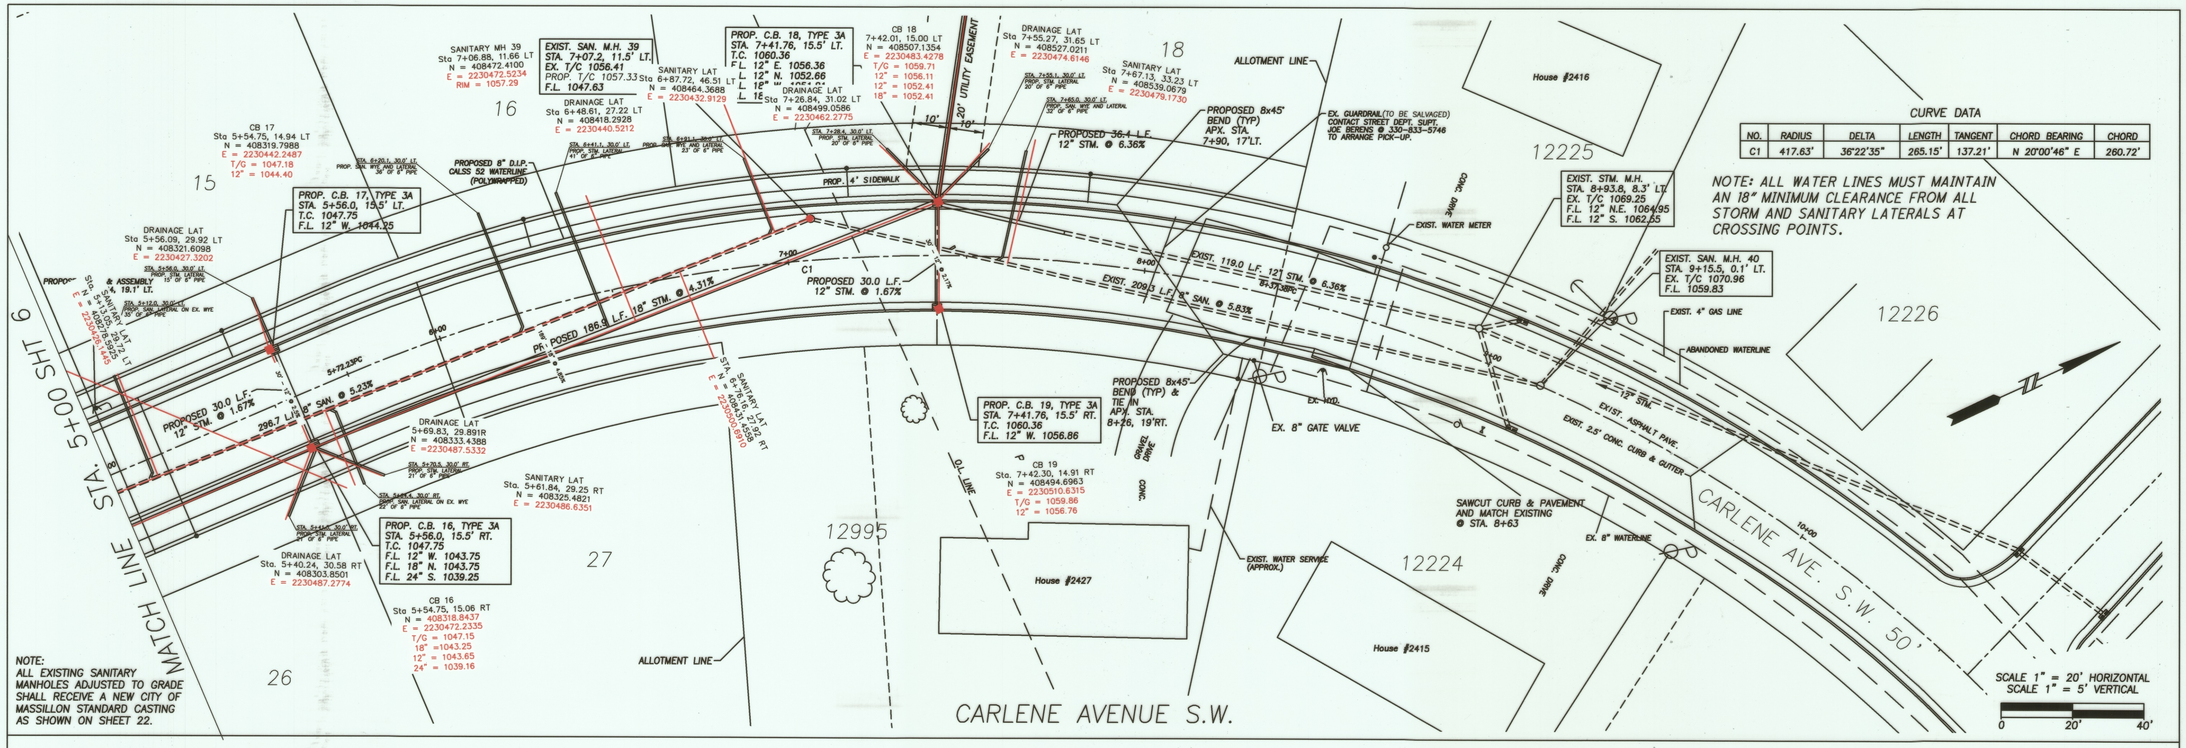

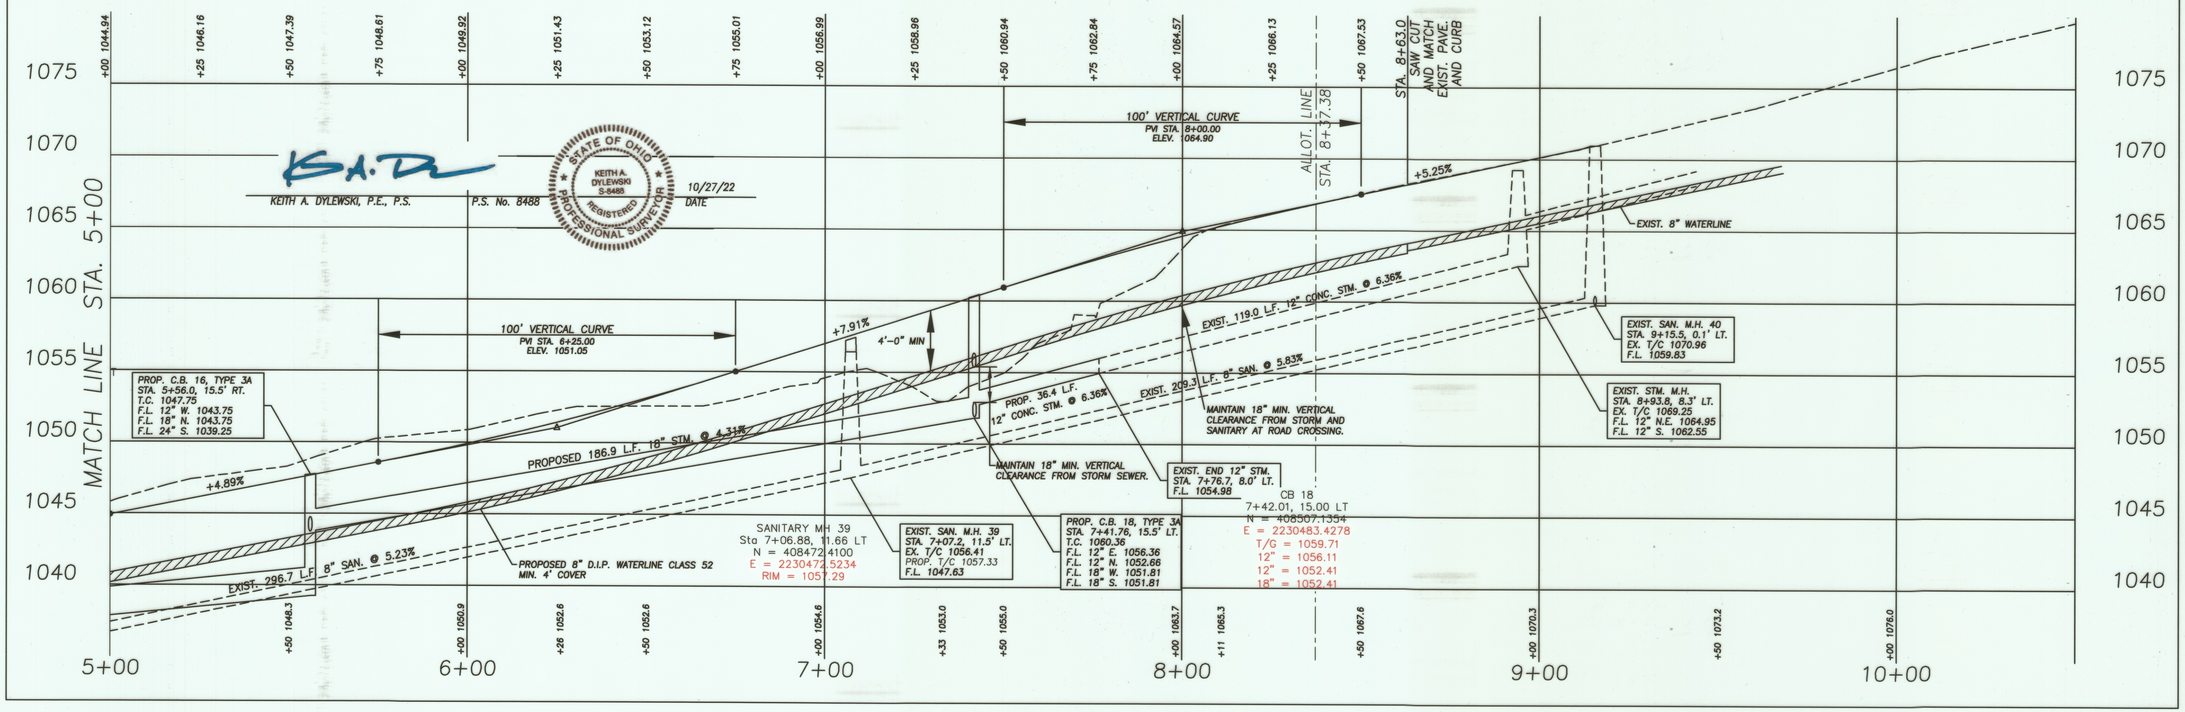

KEITH A. DYLEWSKI, P.E., P.S. P.S. No. 8488 10/27/22 DATE

STATE OF OHIO KEITH A. DYLEWSKI S-8488 REGISTERED PROFESSIONAL SURVEYOR

VERTICAL IN FEET 0 2.5 5

0 10 20 HORIZONTAL SCALE IN FEET

CHECKED BY: KAD

DATE: Sept 2022

DRAWN BY: BMH

DATE: Sept 2022

REVISIONS: DATE DESCRIPTION

Country View Meadows Allotment As-Builts

Plan & Profile
City of Massillon
Stark County, Ohio


CIVPRO ENGINEERING
ENGINEERS - SURVEYORS - CONSTRUCTION MANAGERS
4450 BELDEN VILLAGE STREET NW, SUITE 800 CANTON, OH 44718
PHONE: (234) 410-3813 EMAIL: KADAM@CIVPROENGINEERING.COM
WWW.CIVPROENGINEERING.COM

DRAWING NAME:

REF NUMBER:

7 / 7

22SD02

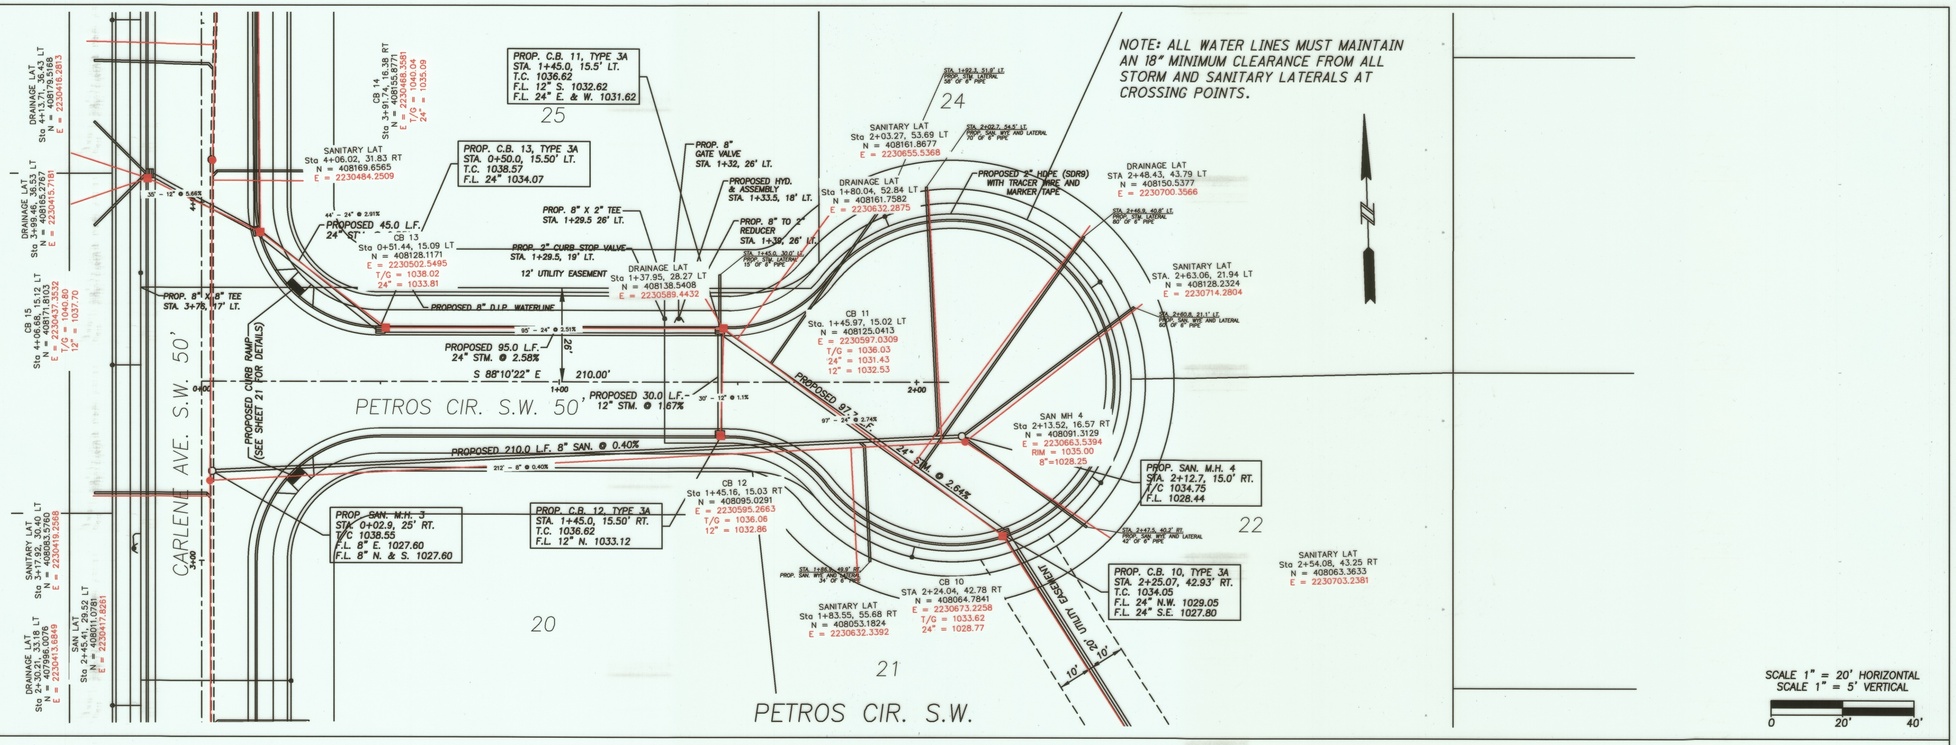

NW NE SW SE

VERTICAL IN FEET 5 2.5 0

0 10 20 HORIZONTAL SCALE IN FEET

CHECKED BY: KAD

DATE: Sept 2022

DRAWN BY: BMH

DATE: Sept 2022

REVISIONS: DESCRIPTION DATE

Country View Meadows Allotment As-Builts

Plan & Profile

City of Massillon

Stark County, Ohio

CIVPRO ENGINEERING
ENGINEERS-SURVEYORS-CONSTRUCTION MANAGERS
4450 BELDEN VILLAGE STREET NW, SUITE 800 CANTON, OH 44718
PHONE: (234) 410-3813 EMAIL: KADM@CIVPROENGINEERING.COM
WWW.CIVPROENGINEERING.COM

DRAWING NAME:

REF NUMBER: 8

2250 02

NOTE:
ALL EXISTING SANITARY MANHOLES ADJUSTED TO GRADE SHALL RECEIVE A NEW CITY OF MASSILLON STANDARD CASTING AS SHOWN ON SHEET 22.

CURVE DATA

NO.	RADIUS	DELTA	LENGTH	TANGENT	CHORD BEARING	CHORD
C2	450.08'	05°40'25"	44.57'	22.30'	N 89°02'17" E	44.55'
C3	450.08'	13°34'52"	106.68'	53.59'	N 79°24'38" E	106.44'

EXIST. SAN. M.H. 20
STA. 0+01.5, 0.3' LT.
EX. T/C 1019.63
PROP. T/C 1018.30
F.L. IN 1006.28
F.L. OUT 1005.91

CB 26
Sta 4+97.43, 15.12 LT
N = 407839.3046
E = 2230941.8640
T/G = 1017.55
18" = 1013.55

PROP. 8" X 8" MJ TEE
STA. 5+17, 24' LT.

SAN MH 2
Sta 4+12.99, 2.14 RT
N = 407754.3471
E = 2230956.3501
RIM = 1017.28
8" = 1005.46
10" = 1005.37

PROP. STM. M.H. 4
STA. 4+78.7, 11.0' RT.
T/C 1017.55
F.L. 12" N. 1013.77
F.L. 15" W. 1013.52
F.L. 18" N.W. & S. 1013.27

CB 27
Sta 5+51.76, 15.10 RT
N = 407892.6189
E = 2230973.8404
T/G 1019.59
12" = 1015.59

PROPOSED CURB RAMP (SEE SHEET 21 FOR DETAILS)

PROP. C.B. 25, TYPE 3A
STA. 0+51.0, 15.50' LT.
T.C. 1017.59
F.L. 12" 1014.19

CB 25
0+51.01, 14.72 LT
N = 407854.4183
E = 2231008.5241
T/G = 1017.28
12" = 1014.66

PROP. 8" D.I.P. WATERLINE CLASS 52 (POLYWRAPPED)

PROPOSED HYD. & ASSEMBLY STA. 1+73, 19.1' LT.

PROP. 4' SIDEWALK

PROP. 8" GATE VALVE STA. 0+46, 24'LT.

PROPOSED 40.6 L.F. 15" STM. @ 0.54%

PROPOSED 30.0 L.F. 12" STM. @ 1.50%

EXIST. 296.9 L.F. 8" SAN. @ 0.56%

PROP. C.B. 24, TYPE 3A
STA. 0+51.0, 15.50' RT.
T.C. 1017.59
F.L. 12" N. 1013.74
F.L. 15" W. 1013.74

SAN MH 20
Sta 4+98.38, 3.14 RT
N = 407839.6558
E = 2230960.1412
RIM = 1018.36
8" = 1005.73
10" = 1005.73

STM MH 4
Sta 4+77.79, 9.93 RT
N = 407818.8558
E = 2230977.2528
RIM = 1017.65
12" = 1013.25
15" = 1013.25
18" = 1013.25

PROPOSED CURB RAMP (SEE SHEET 21 FOR DETAILS)

NOTE: ALL WATER LINES MUST MAINTAIN AN 18" MINIMUM CLEARANCE FROM ALL STORM AND SANITARY LATERALS AT CROSSING POINTS.

MARGILEE DR. S.W. 50'

MARGILEE DR. S.W.

23rd ST. S.W. 50'

N 01°52'30" E 105.90'

S 89°07'30" E 144.50'

20' UTILITY EASEMENT

12' UTILITY EASEMENT

ALLOTMENT LINE

REMOVE EX. BLOWOFF
PROPOSED 8" X 6" REDUCER AT END OF EXIST. 6" WATERLINE (VALVE NORMALLY TO BE CLOSED)

REMOVE EXIST. PAVE. AND REPLACE WITH FULL DEPTH ASPHALT

EXIST. 6" WATERLINE

ASPHALT PAVE.

CONC. DRIVE

SAWCUT PAVEMENT AND MATCH EXISTING @ STA. 2+25

TAPER PAVEMENT TO END OF CURB

EXIST. 4" GAS LINE

PROPOSED 18' CONCRETE DRIVEWAY APPROACH

GRAVEL

EXIST. SAN. M.H. 23
STA. 2+99.6, 2.8' RT.
EX. T/C 1019.31
F.L. 1007.95

BETHANN AVE. S.W. 50'

House #2242

House #2245

12972

12973

12974


38

37

32

33

SCALE 1" = 20' HORIZONTAL
SCALE 1" = 5' VERTICAL
0 20' 40'

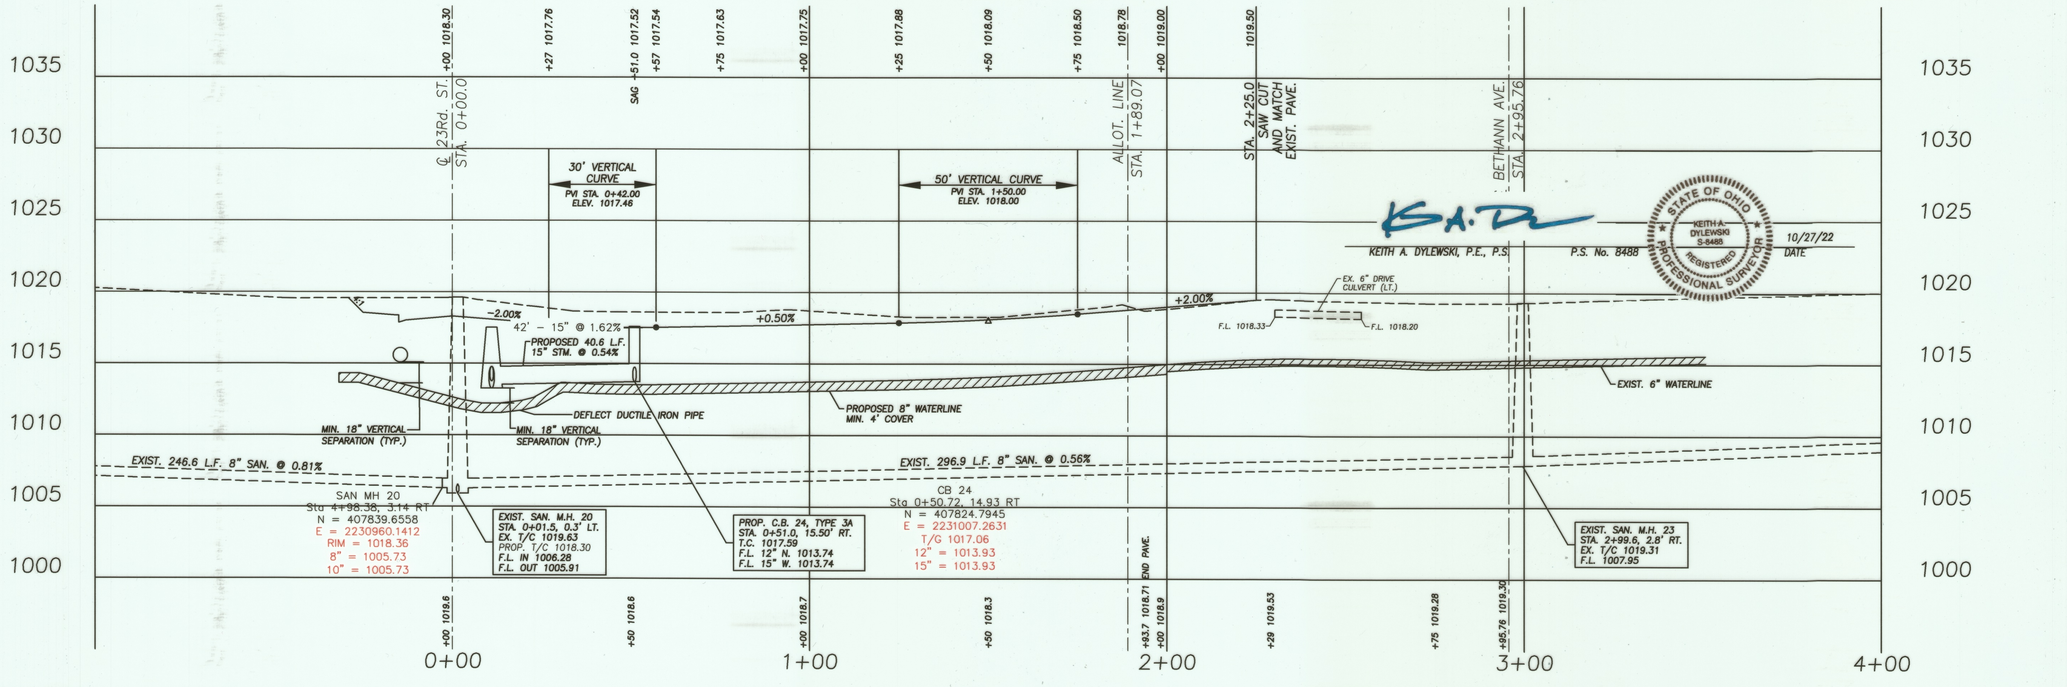

KEITH A. DYLEWSKI, P.E., P.S.

P.S. No. 8488

STATE OF OHIO
KEITH A. DYLEWSKI
S-8488
REGISTERED
PROFESSIONAL SURVEYOR

10/27/22
DATE

NW NE SW SE N

VERTICAL IN FEET 0 2.5 5

0 10 20
HORIZONTAL SCALE IN FEET

CHECKED BY: KAD
DATE: Sept 2022
DRAWN BY: BMH
DATE: Sept 2022

REVISIONS:
DATE DESCRIPTION

Country View Meadows Allotment As-Builts
Plan & Profile
City of Massillon
Stark County, Ohio


CIVPRO ENGINEERING
ENGINEERS • SURVEYORS • PLANNERS
4450 BELDEN VILLAGE STREET NW, SUITE 800 CANTON, OH 44718
PHONE: (234) 419-3013 EMAIL: MOORE@PROENGINEERING.COM
WWW.CIVPROENGINEERING.COM


DRAWING NAME:

REF NUMBER:

9

22SD02

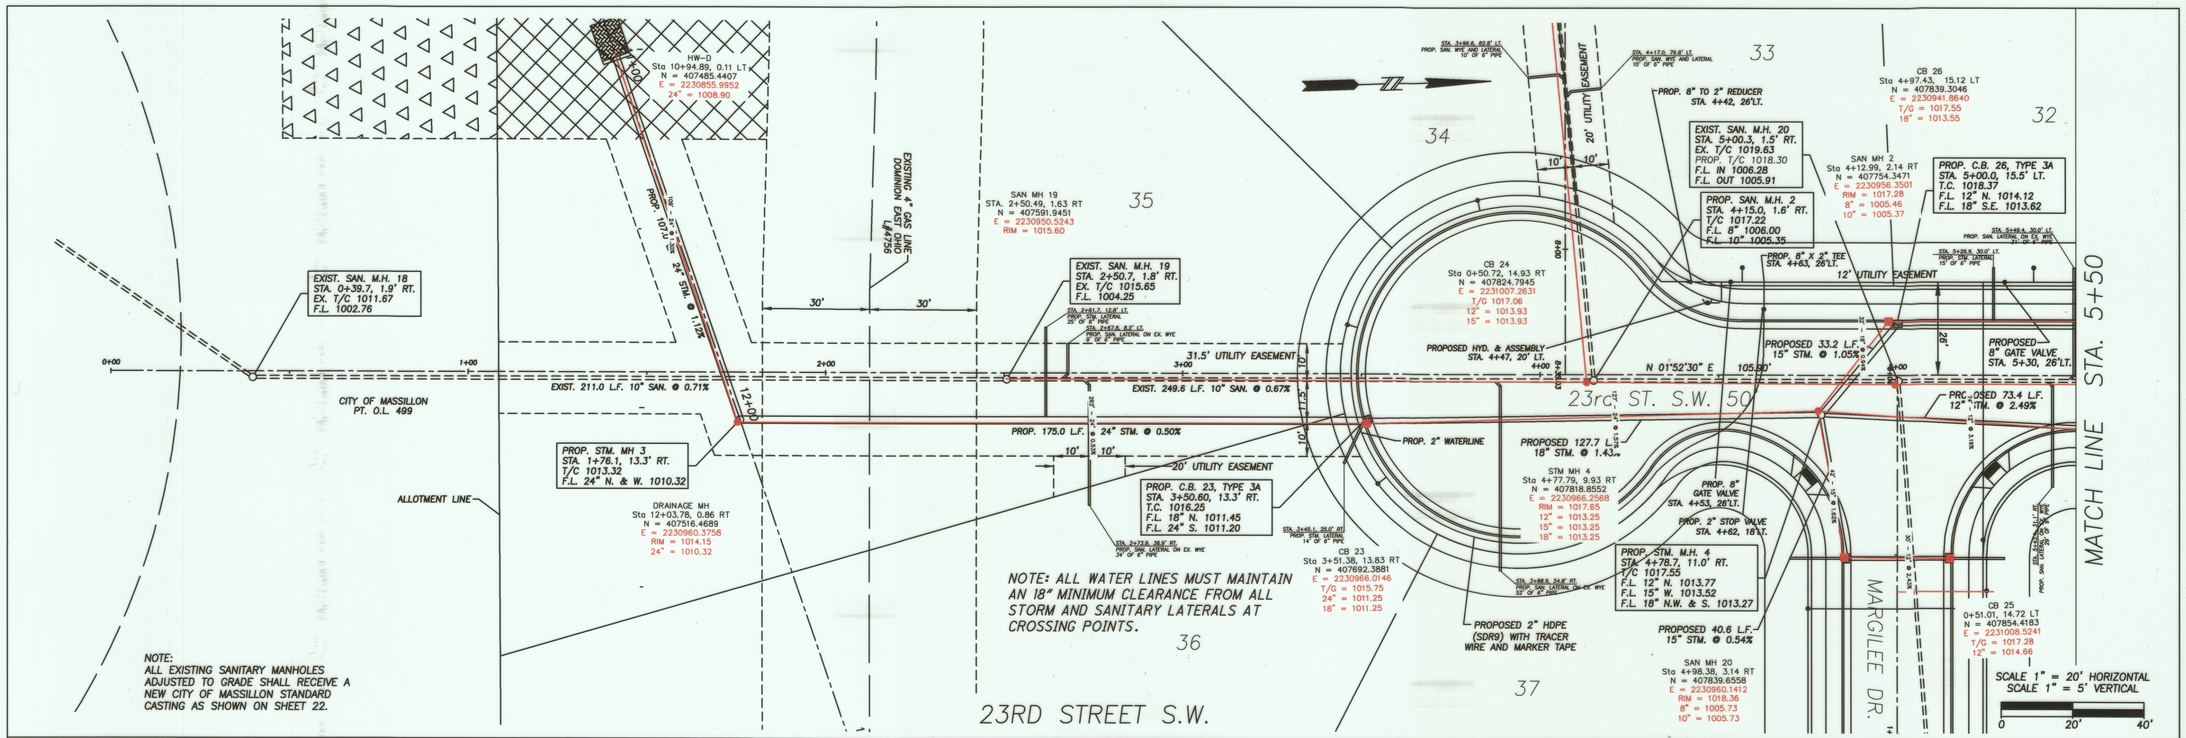

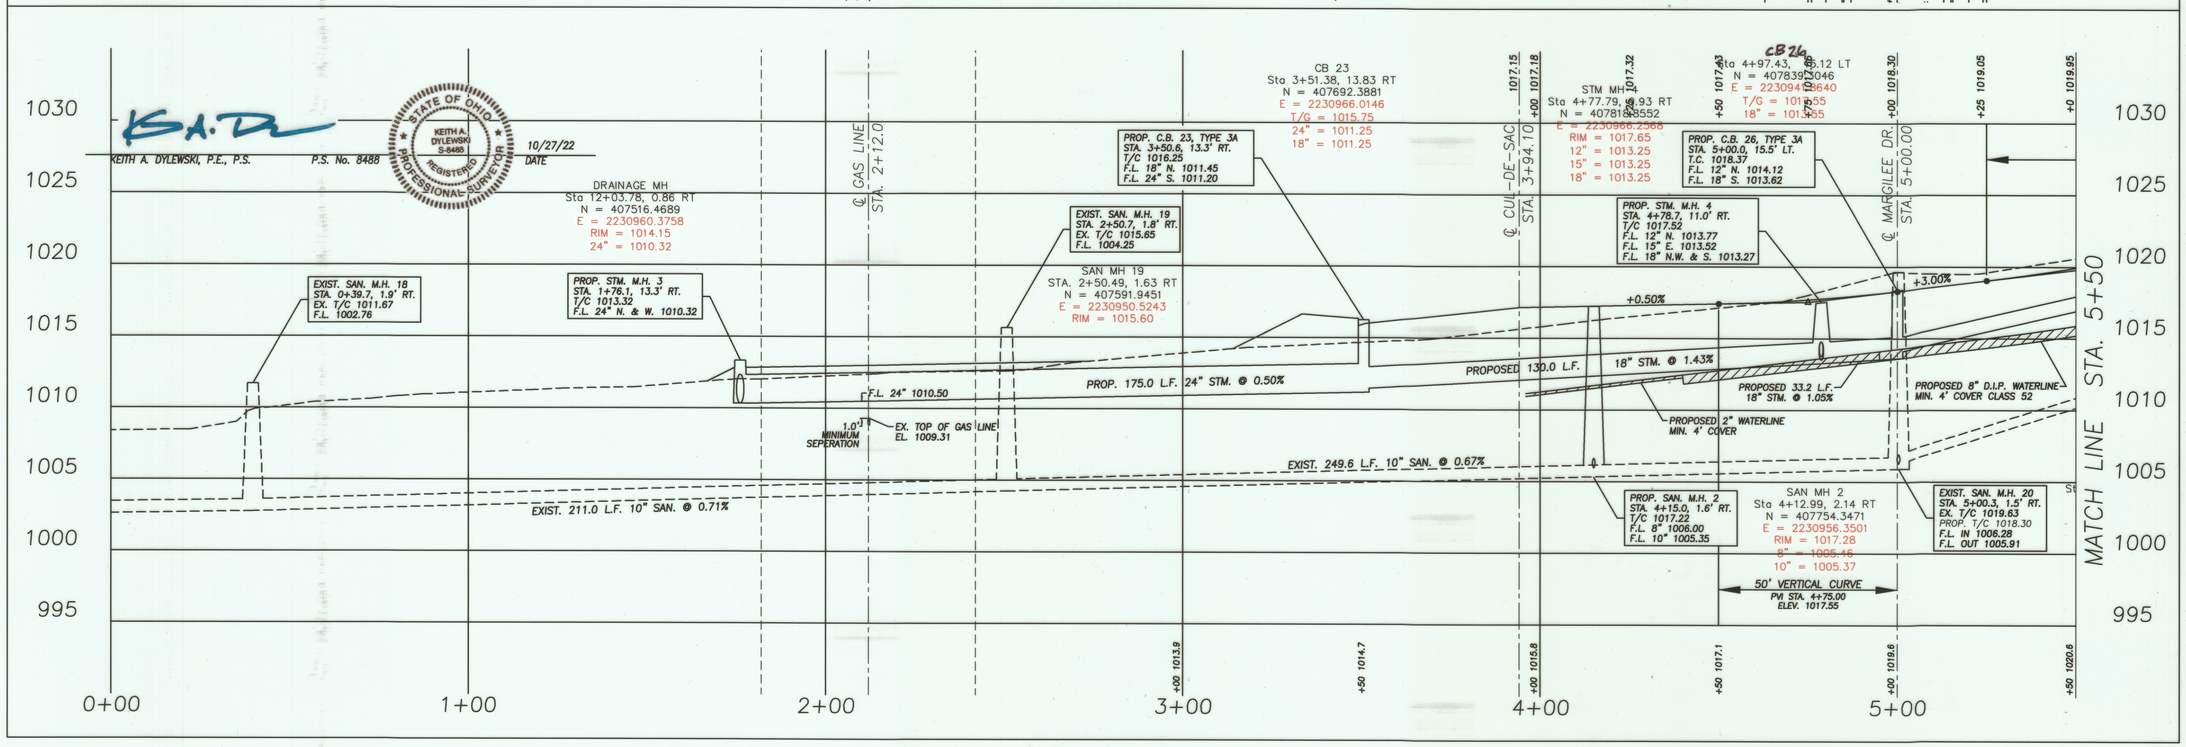

HORIZONTAL SCALE IN FEET
0 10 20
VERTICAL IN FEET
5
2.5
0

CHECKED BY: KAD
DATE: Sept 2022
DRAWN BY: BMH
DATE: Sept 2022


REVISIONS:
DATE DESCRIPTION


Country View Meadows Allotment As-Builts
Plan & Profile
City of Massillon
Stark County, Ohio

CIVPRO ENGINEERING
ENGINEERS · SURVEYORS · CONSTRUCTION MANAGERS
4455 BELDEN VILLAGE AVE. N.W., SUITE 204, CANTON, OHIO 44718
PHONE: (234) 458-3613 EMAIL: KAD@CIVPROENGINEERING.COM
WWW.CIVPROENGINEERING.COM

DRAWING NAME:
REF NUMBER:
10

2250 02

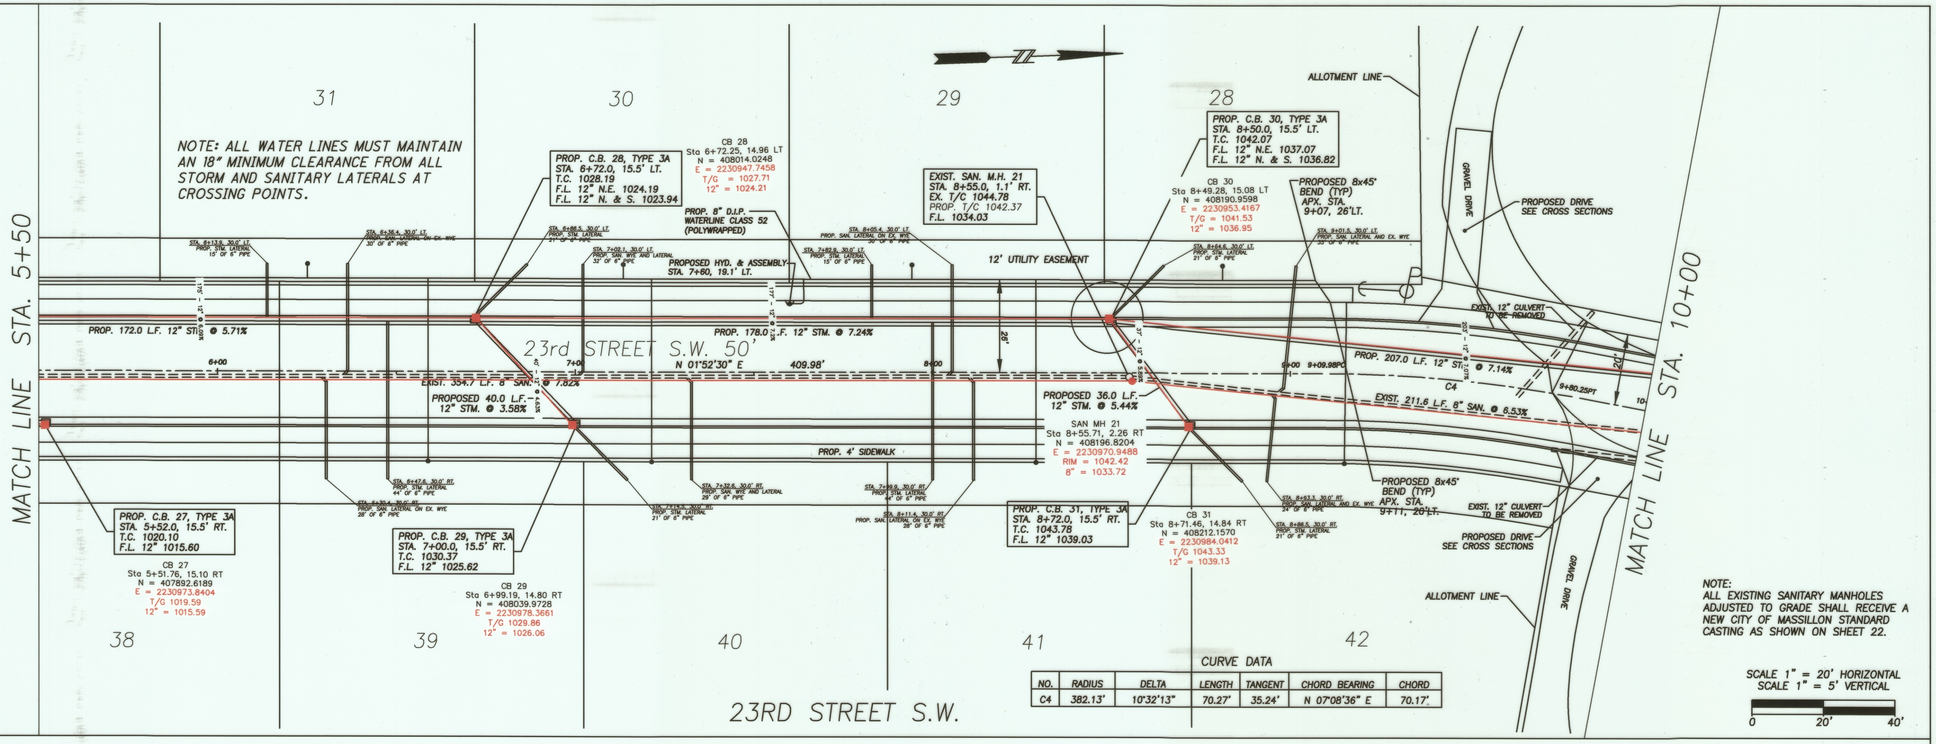

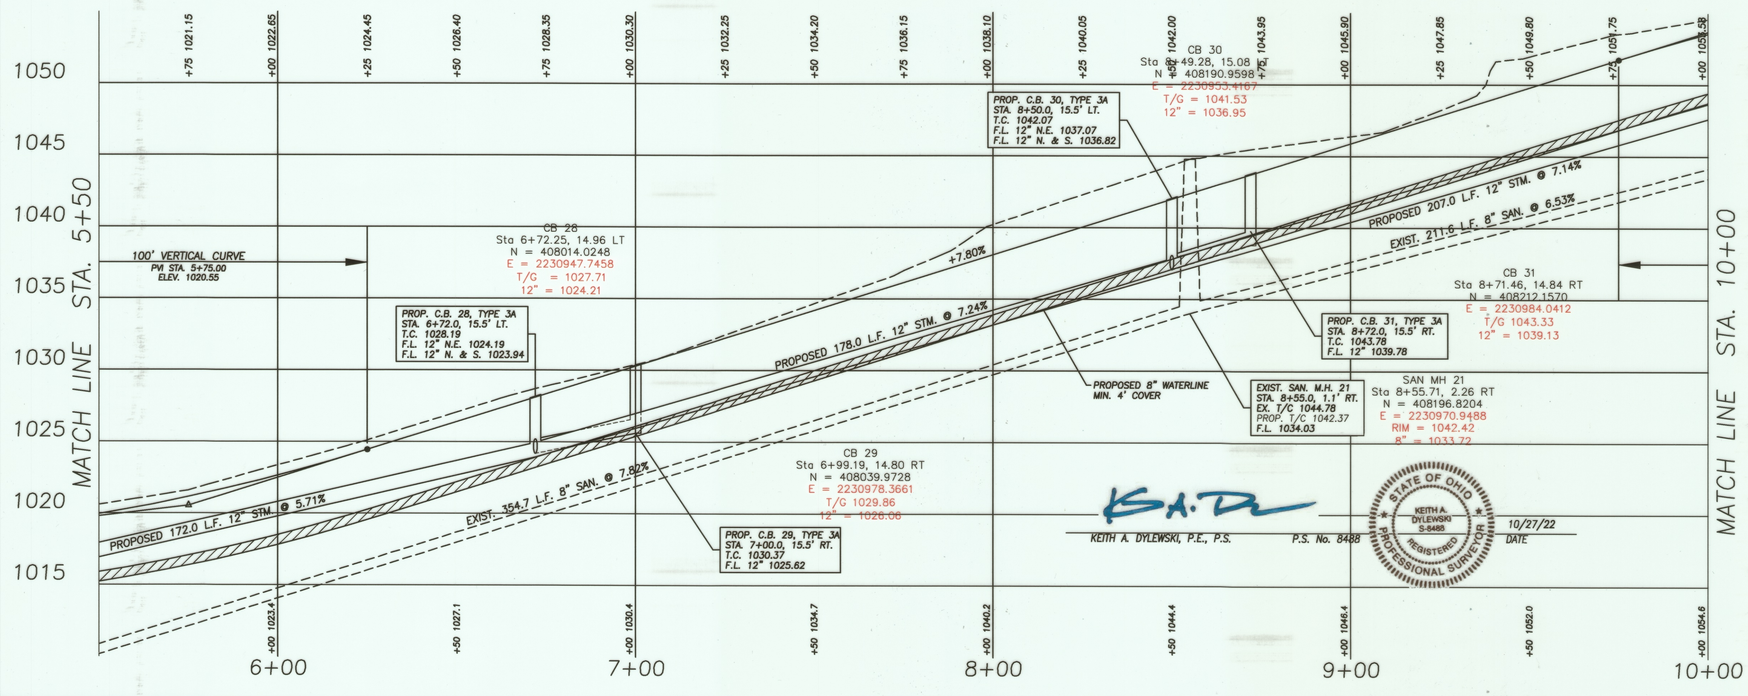

KEITH A. DYLEWSKI, P.E., P.S. P.S. No. 8488 10/27/22 DATE

STATE OF OHIO KEITH A. DYLEWSKI S-8488 REGISTERED PROFESSIONAL SURVEYOR

VERTICAL IN FEET 5 2.5 0
0 10 20
HORIZONTAL SCALE IN FEET

CHECKED BY: KAD
DATE: Sept 2022
DRAWN BY: BMH
DATE: Sept 2022


REVISIONS:
DATE DESCRIPTION


Country View Meadows Allotment As-Builts
Plan & Profile
City of Massillon
Stark County, Ohio

CIVPRO ENGINEERING
ENGINEERS-SURVEYORS-CONSTRUCTION MANAGERS
4450 BELDEN VILLAGE STREET NW, SUITE 800 CANTON, OH 44718
PHONE: (234) 410-3813 EMAIL: KADAM@CIVPROENGINEERING.COM
WWW.CIVPROENGINEERING.COM

DRAWING NAME:
REF NUMBER: 11

22 SD 02

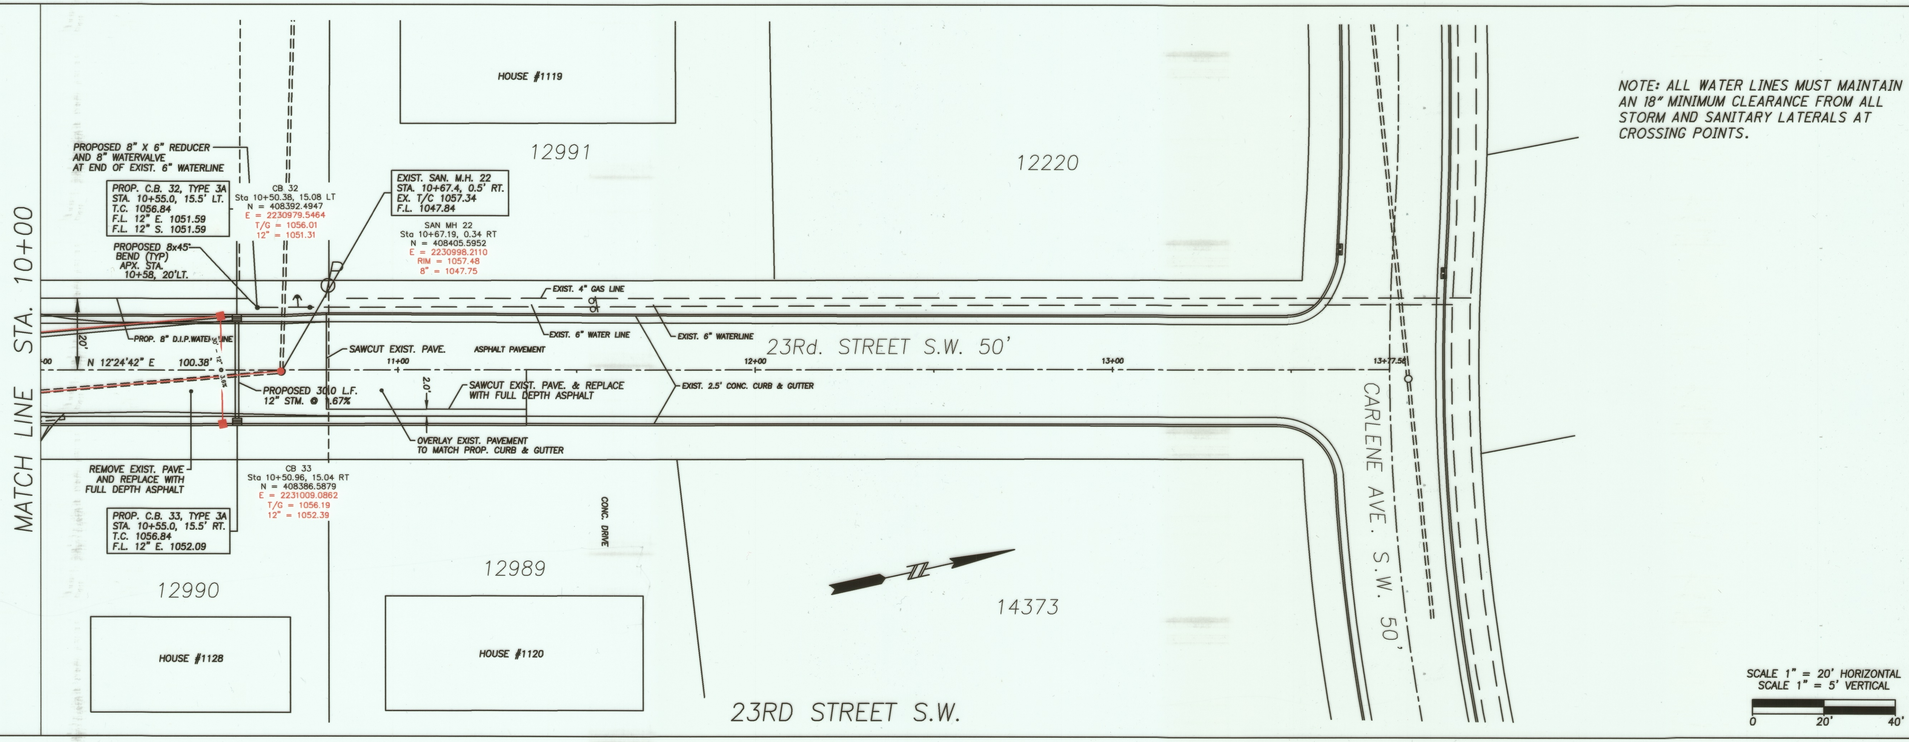

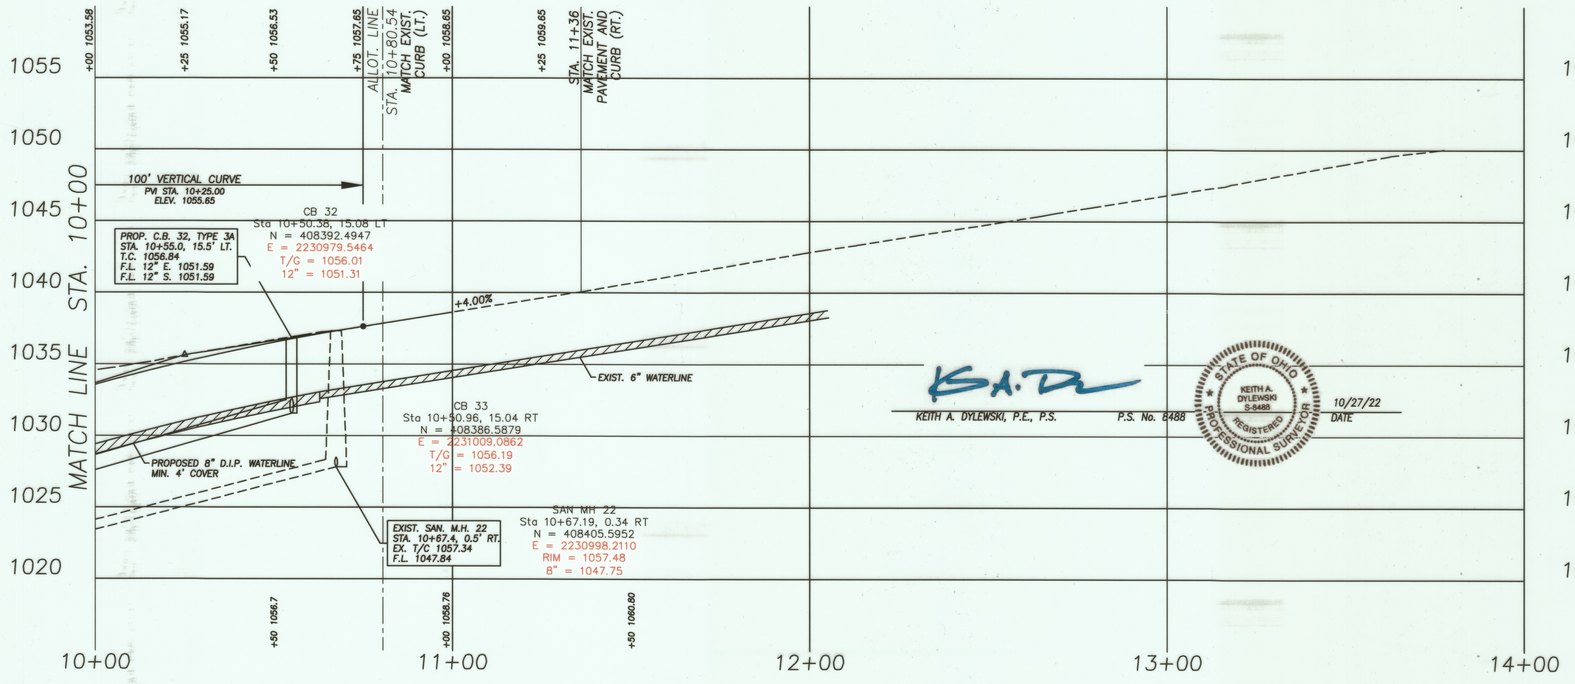

KEITH A. DYLEWSKI, P.E., P.S. P.S. No. 8488

STATE OF OHIO
KEITH A. DYLEWSKI
S-8488
REGISTERED
PROFESSIONAL SURVEYOR

10/27/22
DATE

NW NE SW SE

VERTICAL IN FEET 5 2.5 0

0 10 20
HORIZONTAL SCALE IN FEET

CHECKED BY: KAD
DATE: Sept 2022
DRAWN BY: BMH
DATE: Sept 2022

REVISIONS:
DATE | DESCRIPTION

Country View Meadows Allotment As-Builts
Plan & Profile
City of Massillon
Stark County, Ohio

CIVPRO ENGINEERING
ENGINEERS-SURVEYORS-CONSTRUCTION MANAGERS
4450 BELDEN VILLAGE STREET NW, SUITE 800 CANTON, OH 44718
PHONE: (234) 410-3813 EMAIL: KADM@CIVPROENGINEERING.COM
WWW.CIVPROENGINEERING.COM

DRAWING NAME:
REF NUMBER: 12

22 SD 02