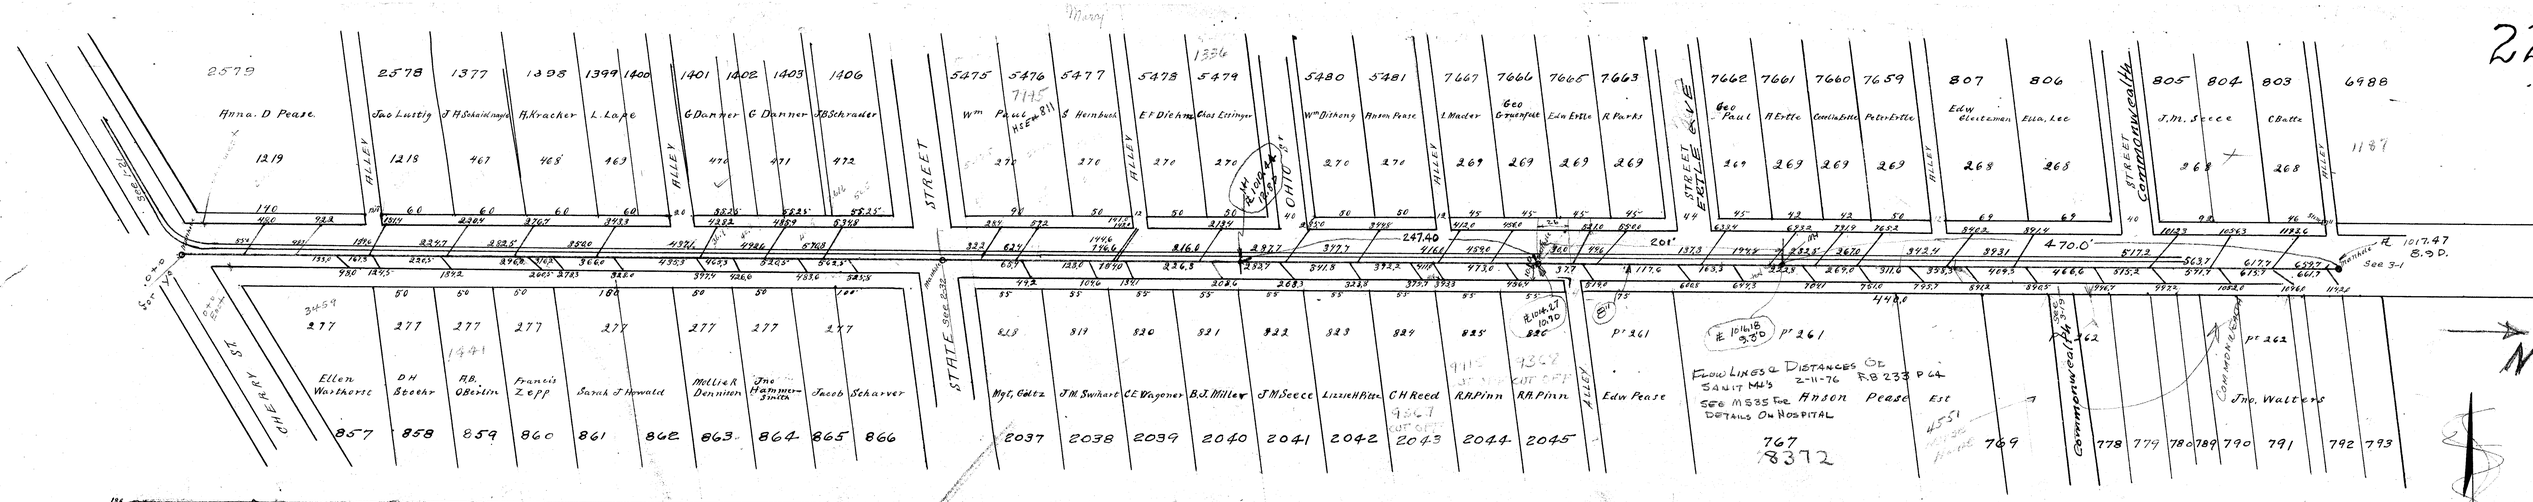

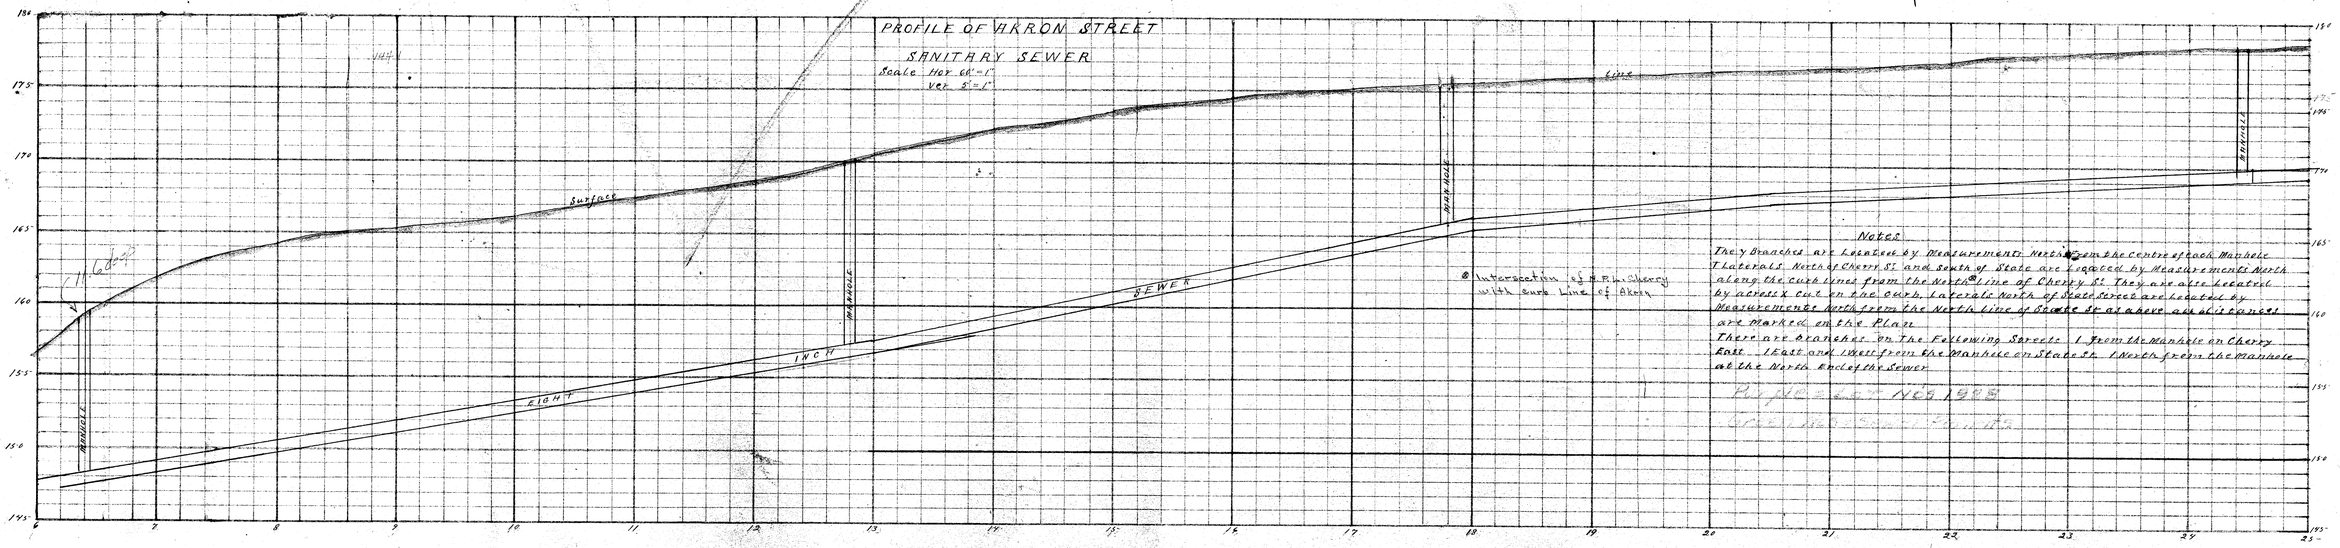

Notes

The Branches are Located by Measurements North from the Centre of each Manhole. Laterals North of Cherry St and South of State are Located by Measurements North along the curb lines from the North Line of Cherry St. They are also located by ties to cut on the curb. Laterals North of West Street are located by Measurements North from the North Line of State St as above and is noted are Marked on the Plan.

There are Branches on the Following Streets 1 from the Manhole on Cherry East. 1 East and 1 West from the Manhole on State St. 1 North from the Manhole at the North end of the Sewer.

R. Neese - Nov 1908

