Notes of the Location of Lateral & House Connections

House Connections are as Follows.

North side of Main Street

Burton Connection is 94½ feet east from the east line of Prospect Street (only one) between Lts 57 & 58
Morgenthaler " opposite the west line of W. Cedar Street Lt. 59.
Allen & Crawford " is 44½ feet east of the east line of Cedar Street Lt. 60
L. Hess " is 31 feet west of his east line Lot 61
J. D. Wetter 1st " is 24 feet east of his west line Lot 61
" " Wetter 2nd " is 47 feet west of his east line Lot 62
Mr. Reed " is 11 feet east of his west line Lot 215
Mrs. Brown 1st " is 2 feet east of the west line of Lot 216
" " " 2nd " is 57½ feet east of the west line of Lot 216
Louis Frie " is 44½ feet east of the west line of Lot 217
Mr. Kiester " is 11 feet west of the west line of his Lot house 218
Alleman " is 18 inches east of his west line of his Lot house 218
F. Crone " is 19 feet east from the west line of house 219 accompanying both buildings & Mortgage
W. B. Hamburger " is 18 inches east from his west line of Lot 220
Wm. Clay " is 19½ feet west of the east line of Lot 220
J. C. Long 1st " is 14½ feet east from his west line of Lot 221
" " " 2nd " is 29 feet west from the east line of Lot 220

South side of Main Street

House Connections are as Follows — west of High Street

John G. Warwick Connection is
Barnick " is 18 feet west from the east corner of Lot
Buckius " "
Sieble " 38 " " " " " " " " measured 3-1-30 when dug up by Tel Co C.E.R.
Web "
Baltzly "
Bayliss "

Connections east of High Street

Caroline Eberhard " is 39½ feet west from the east line of Lt. No. 496
Peter Sailer " 68 feet east from the west line of Lot No. 497
E. Howells " 67 feet east from the west line of Lot No. 498
Mrs. McCulloch " 44 feet east from the west line of Lot No. 499
Magdalena Upham 1st " 69 feet west from his east line
" " 2nd " 38 feet west from his east line } (one of the 499)
Henry Gribble " 18½ feet east from his west line
A. A. Crone " 31 feet east from his west line
F. Umbenhour & his Neighbor " 14½ feet east from west line of his Adam Ruch Lot.
Henry Beatty 1st " 69 feet east from his west line of Lot No. 502.

Lateral Connections.

Prospect Street 2 Lateral the one facing South
Cedar Street 2 Lateral the one facing North which is already Connected.
High Street 2 Lateral the one facing South is already Connected.
the one facing North
Prune Street 1 Lateral facing North is 5 feet east from the west line of Prune Street
Center Street 1 Lateral facing North
Cypress Street 1 Lateral facing North opposite the west line of Cypress Street

Plan & Profile of E. Main Street Sewer, Depth & Inclination of the Same and the Different House Connections.

Permits Nos 1928
Green Nos Sewer Permits
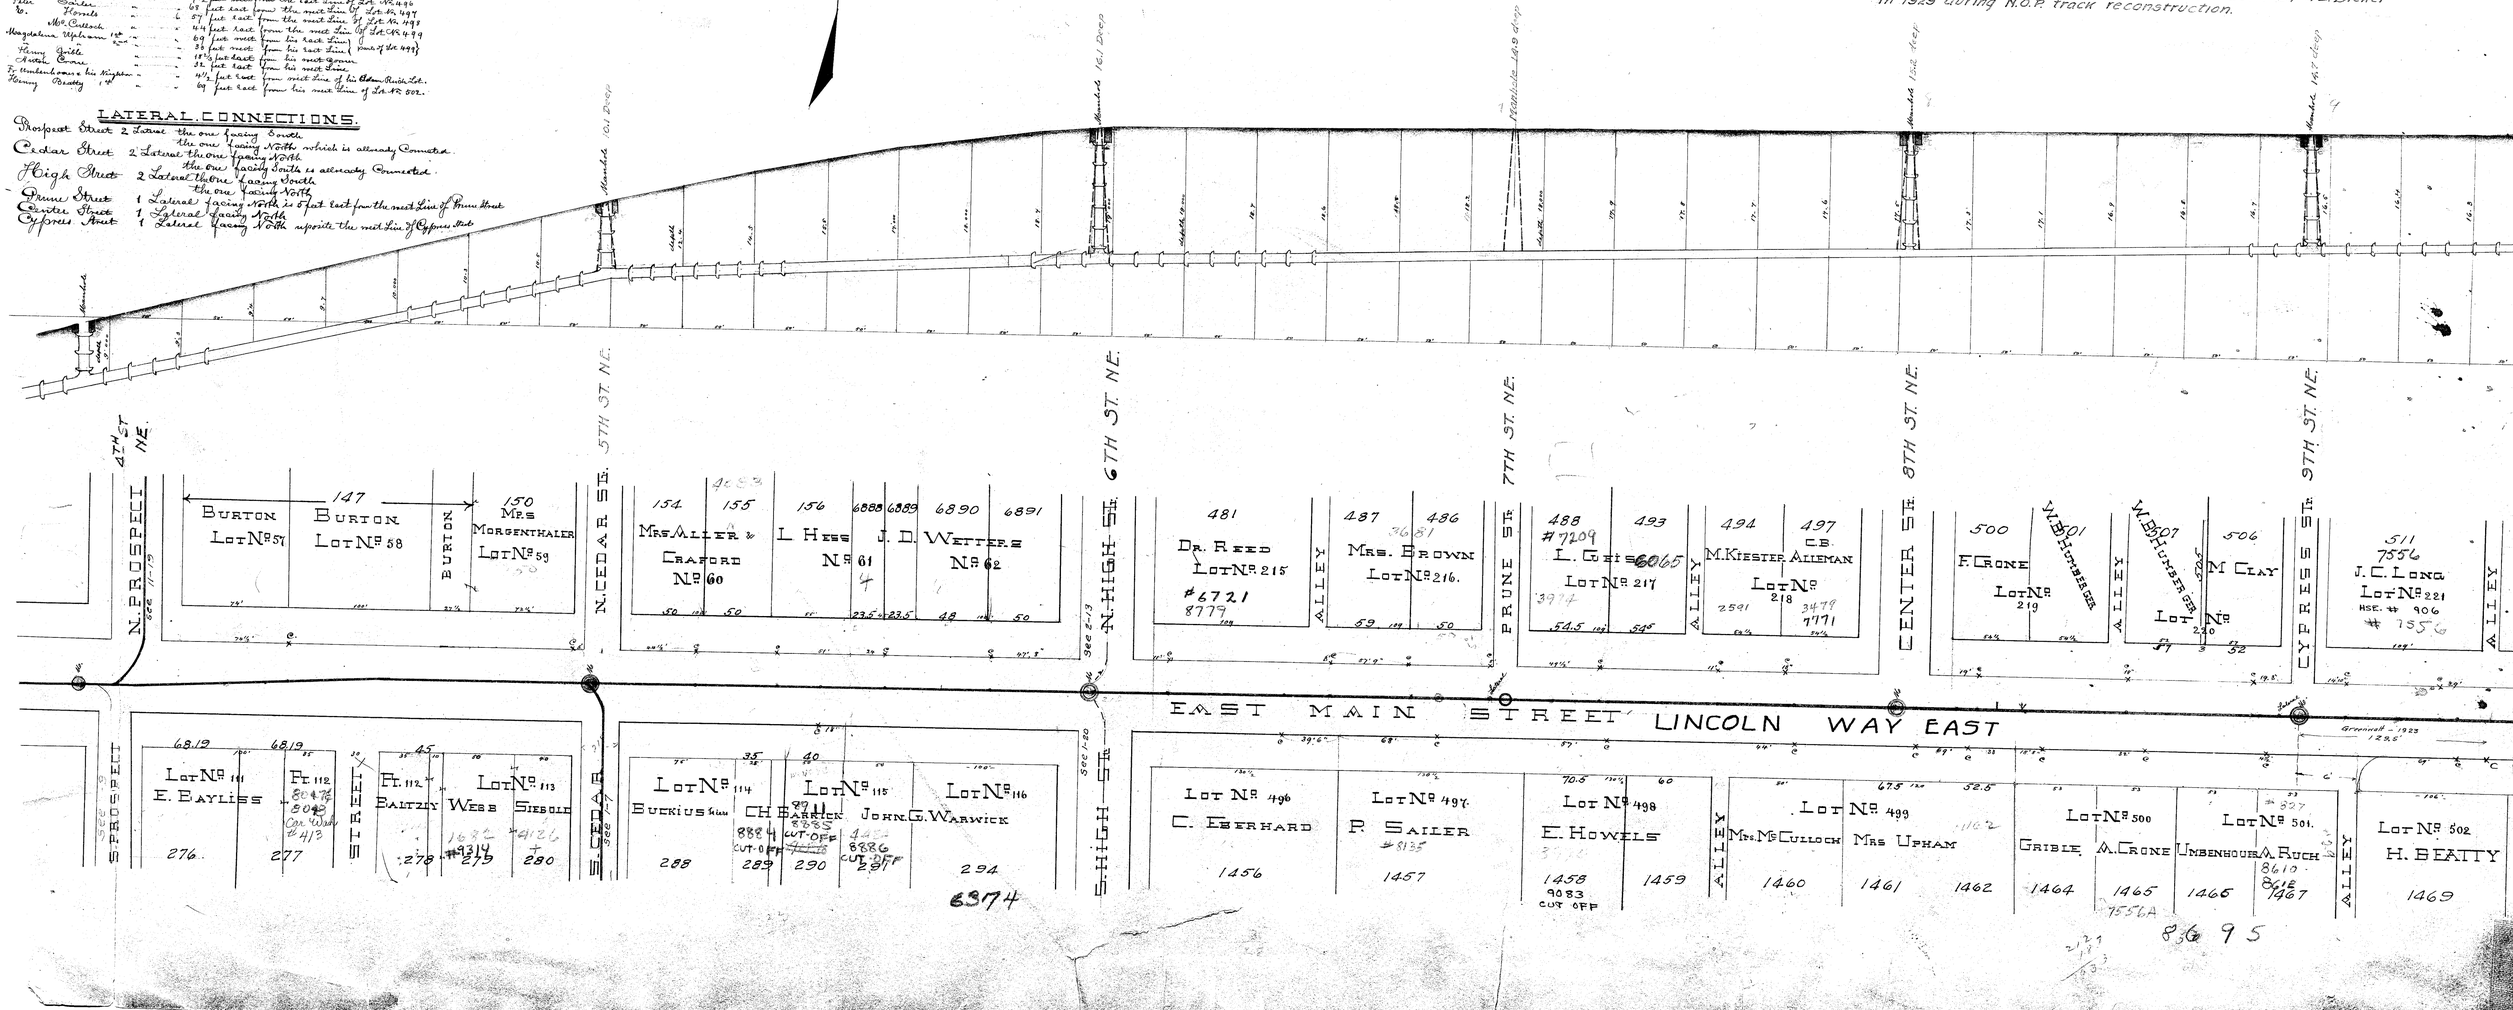
Manholes shown in green are old manholes reconstructed to standard specifications or new ones built by P.E. Bickel in 1929 during N.O.P. track reconstruction.