


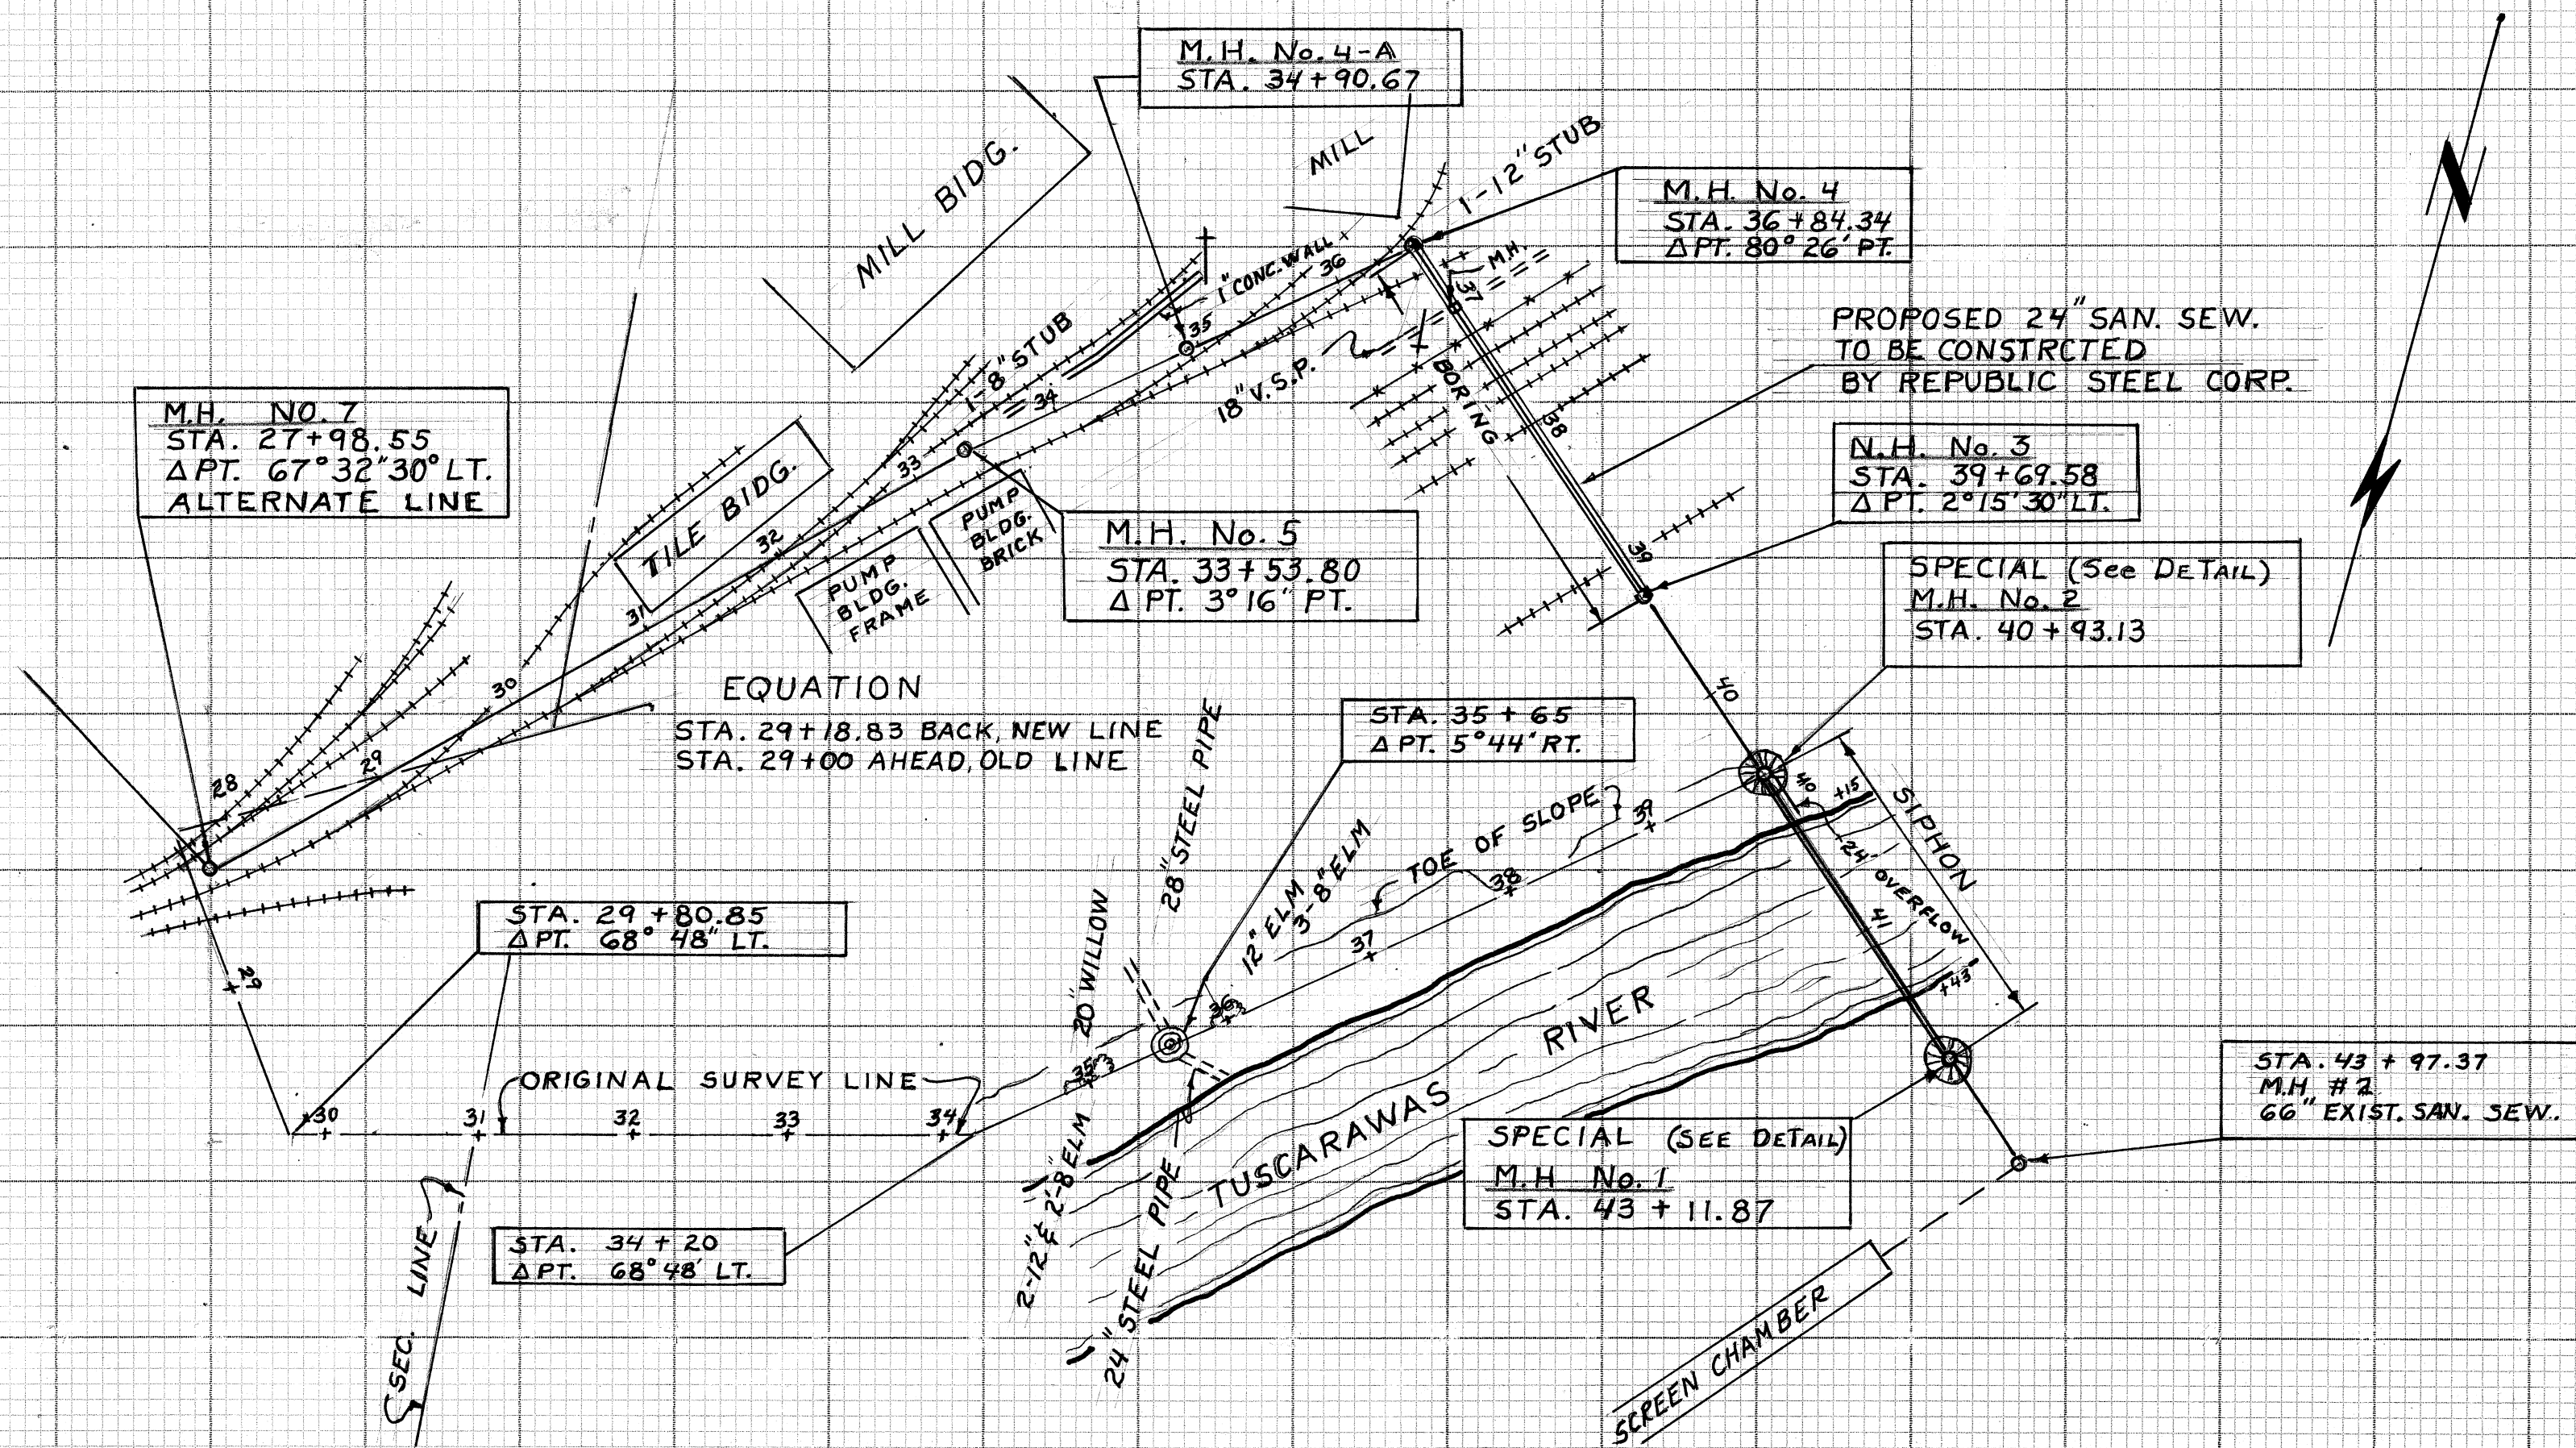

SEE COUNTY PLANS - 3454

AS OF AUGUST 18, 1986
COUNTY SEWERSANITARY SEWER-REPUBLIC STEEL CORP.
REVISED AS CONSTRUCTED 1966 MASSILLON, OCONSTRUCTED FOR STARK COUNTY FOR APPROVAL BY
THE CITY R. F. WAGONER - CITY ENGINEER

ROY LATHAM - CITY INSPECTOR

SCALE: 1" = 10' VERT.
1" = 100' HORIZ.

DR. BY RONNIE McPHERSON
DATE DEC 11, 1967

APPROVED BY THE CITY OF MASSILLON ON
THIS _____ DAY OF _____ 19__