



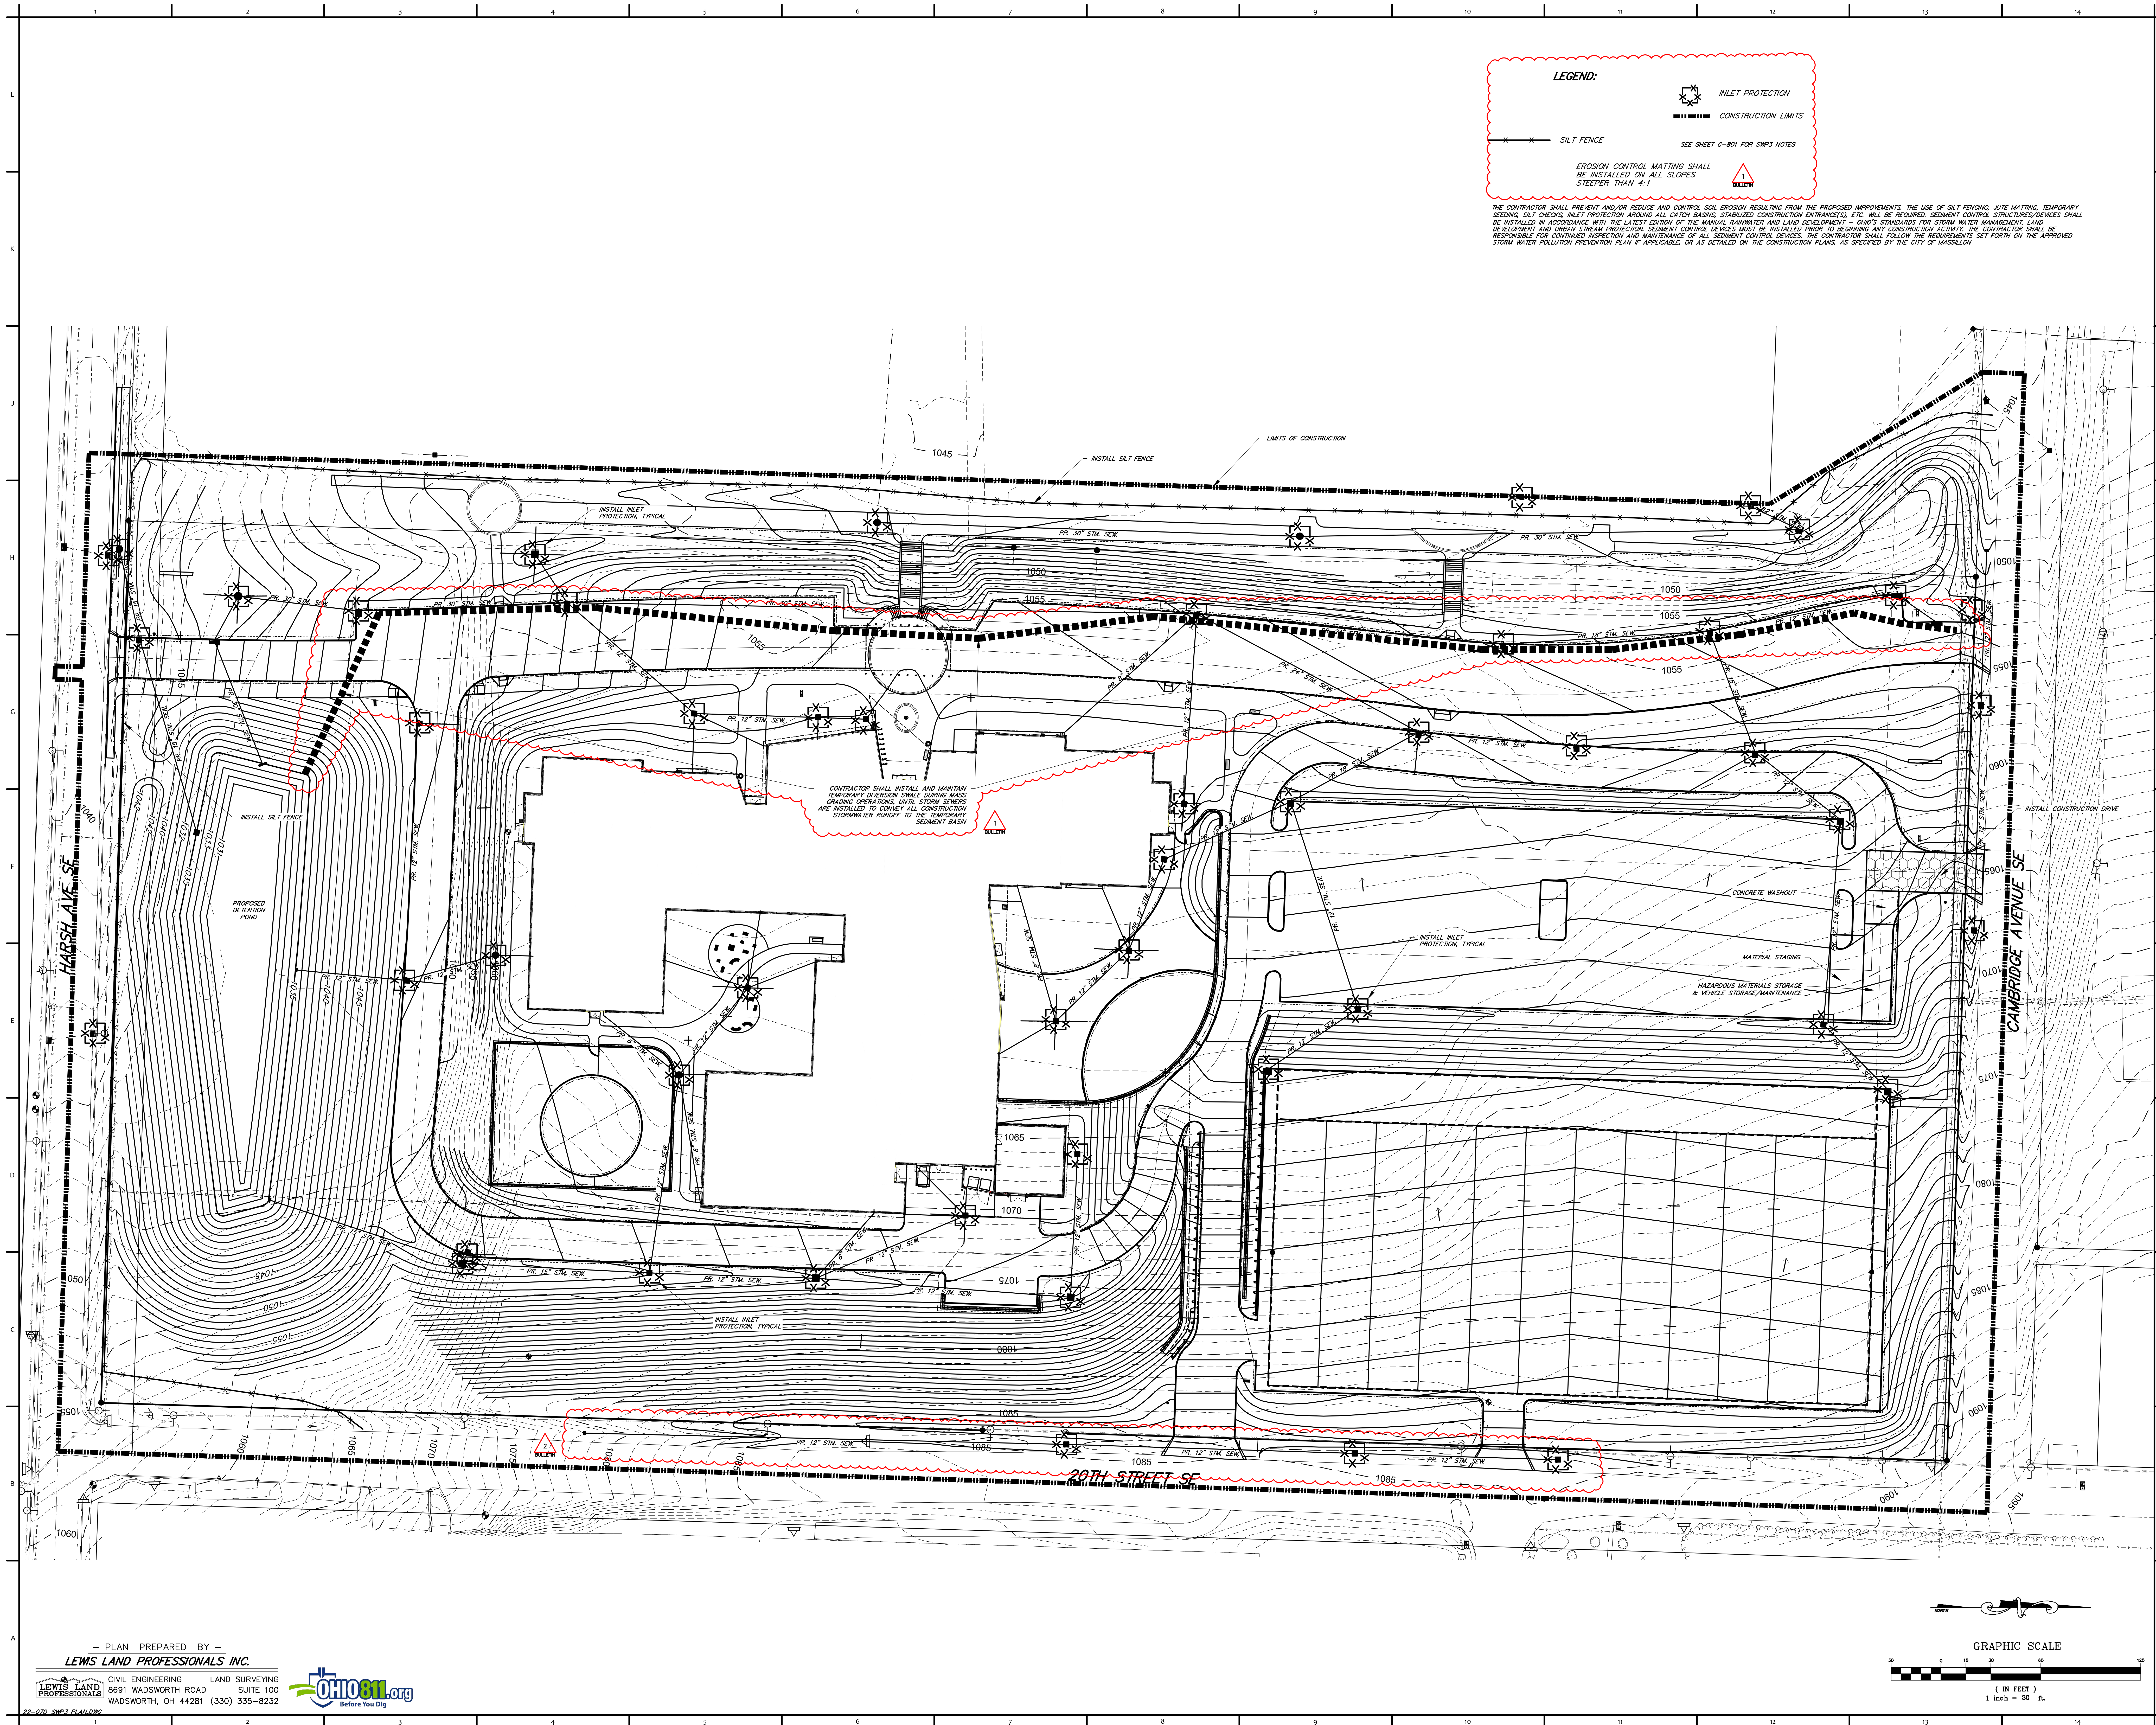


PROJECT NO
2203-2

ARCHITECTURAL VISION GROUP, LTD

ARCHITECTS • PLANNERS

23850 SPERRY DRIVE CLEVELAND, OHIO 44145

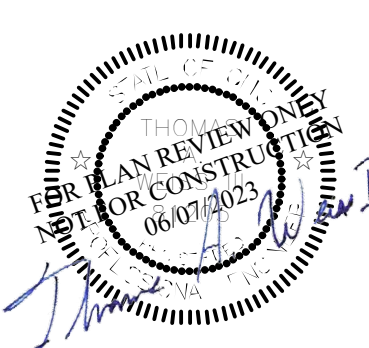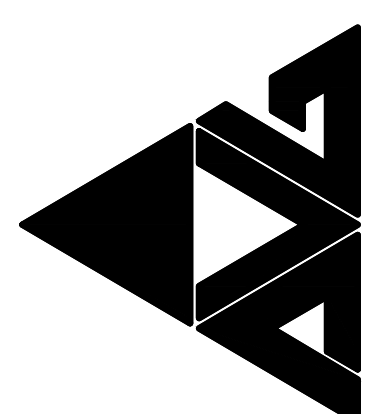

LEWIS LAND PROFESSIONALS
INC.

Civil Engineering & Land Surveying

8691 WADSWORTH ROAD
SUITE 100
WADSWORTH, OH 44281
PH (330) 335-8232
FX (330) 335-0242
WWW.LANDPROSINC.COM

Massillon East Site PK-3

Eastside PK-3 Elementary School

1 Paul E Brown Drive SE

MASSILLON CITY SCHOOL DISTRICT MASSILLON, OHIO

	MARK	DATE	DESCRIPTION
		06.13.23	BULLETIN 2
		05.02.23	BULLETIN 1
		04.24.23	ADDENDUM 1
		03.30.23	PLAN REVIEW & ESP

PROJECT NO	2203-2
DRAWN BY	
CHECKED BY	
DATE	03.17.2023

TORMWATER
OLLUTION
REVENTION
LAN

SHEET NO
C-800