


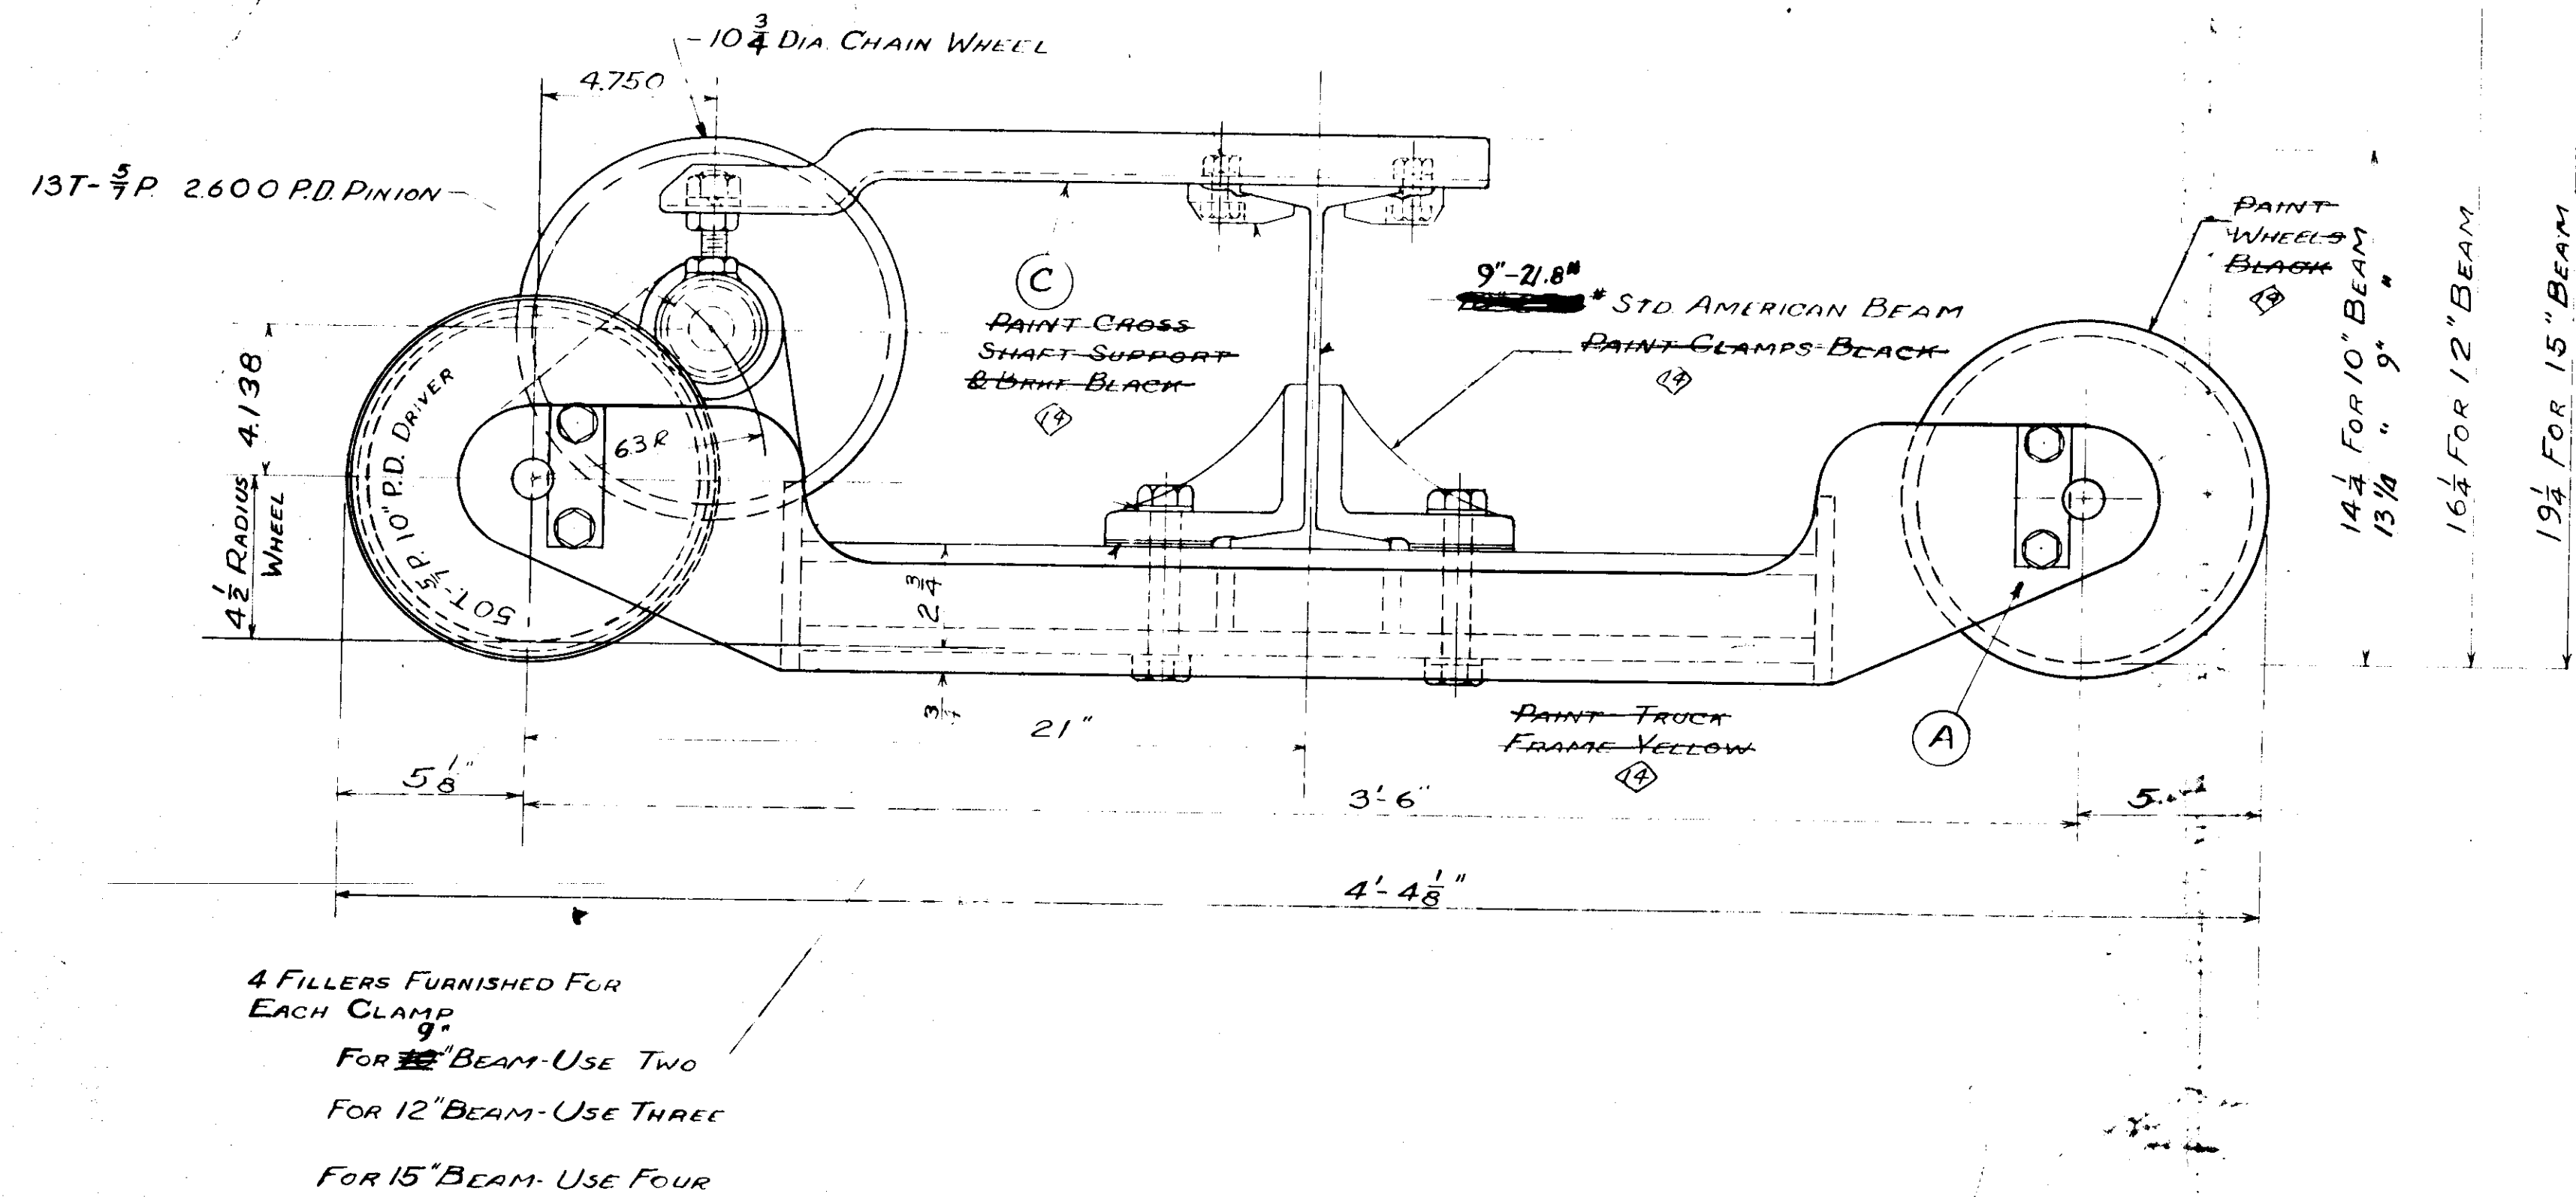


ALL CRANE KITS BUILT TO THIS DRAWING
STAMPED M225 CAT NO. 42

NOTE:
THE ENTIRE BRIDGE MUST BE
PAINTED ~~GREEN~~

PART NO.	QTY	DESCRIPTION	UNIT	PRICE	TOTAL
SA72	A	RH TRUCK FRAME	ST	84.218.88	
SA73	B	LH TRUCK FRAME	ST	84.218.89	
SA74	C	CHASSIS FRAME ASSEMBLY	ST	1.550.42	
NO457	D	CHAIN WHEEL	ST	84.117.2	
NO458	E	CHAIN WHEEL GUIDE	ML	134.117.2	
NO459	F	HAND CHAIN SET	ST	134.420.58	
NO460	G	CHASSIS	ST	134.420.58	
NO461	H	CHASSIS GREASE	ST		PACK IN WHEELS
NO462	I	CHASSIS SET SCREW	ST		
NO422	K	FILLERS	ST	82.218.5	1/2 x 2 1/2 x 7 1/2
NO423	L	CLAMP CLAMPS	ST	82.218.27	8 204
NO463	M	5/8 x 5/8 RUN THROUGH BOLTS	ST		
NO464	N	ELASTIC STOP NUTS	ST		CAT #29U101
NO428	S	DRIVER WHEELS	CL	83.203.30	BR. 35
NO429	T	TRAILER WHEELS	CL	83.203.30	BR. 36
NO388	U	BRGS. (NATL 207) (ROLLWAYD 207.15) (RBL 207)	ST		
NO430	V	AXLES	ST	82.214.53	35MM DIA x 0.2 IN
NO432	W	1/2 x 3/4 TAP BOLTS	ST		
NO433	Y	1/2 STD. LOCKWASHERS	ST		
NO434	Z	PINIONS 13T 3/4 P	ST	82.103.20	1/4 x 5/2 RGN
NO435	AA	PINION BUSHINGS	ST	82.103.20	1/4 x 5/2 RGN
NO436	AB	LR SHAFT COUPLING	CL	82.106.18	106
NO437	AD	2 3/8 STD. LOCKWASHERS	ST		
NO438	AE	2 3/8 STD. HEX NUT	ST		
NO439	AF	8 3/8 x 3/4 SET SCREW	ST		30 HD CUP POINT
NO440	AG	6 3/8 ALUM. HULL FITT	ST		
NO2875	AH	NAME PLATE	ST	1.103.49	
NO67	AJ	2 1/4 x 1/4 DRIVE SCREWS	ST		
NO441	AK	8 KEY PLATES	ST	82.109.2	
NO3885	AL	2 BURLAP BAGS	ST		12 x 20 x 10 SE
SA2214	AM	1 PACKAGING LITERATURE	ST	1.550.223	
AM					
AP					
AR					
AS					
AT					
AU					
AV					
		THIS MAT NOT INCLUDED IN M225			
M387	AW	EXTRA LR SHAFT BRKT. SUPPORT	ST	81.215.12	
M388	AY	EXTRA COUPLING	ST	81.215.12	

PRINTING #1802 BIN 100

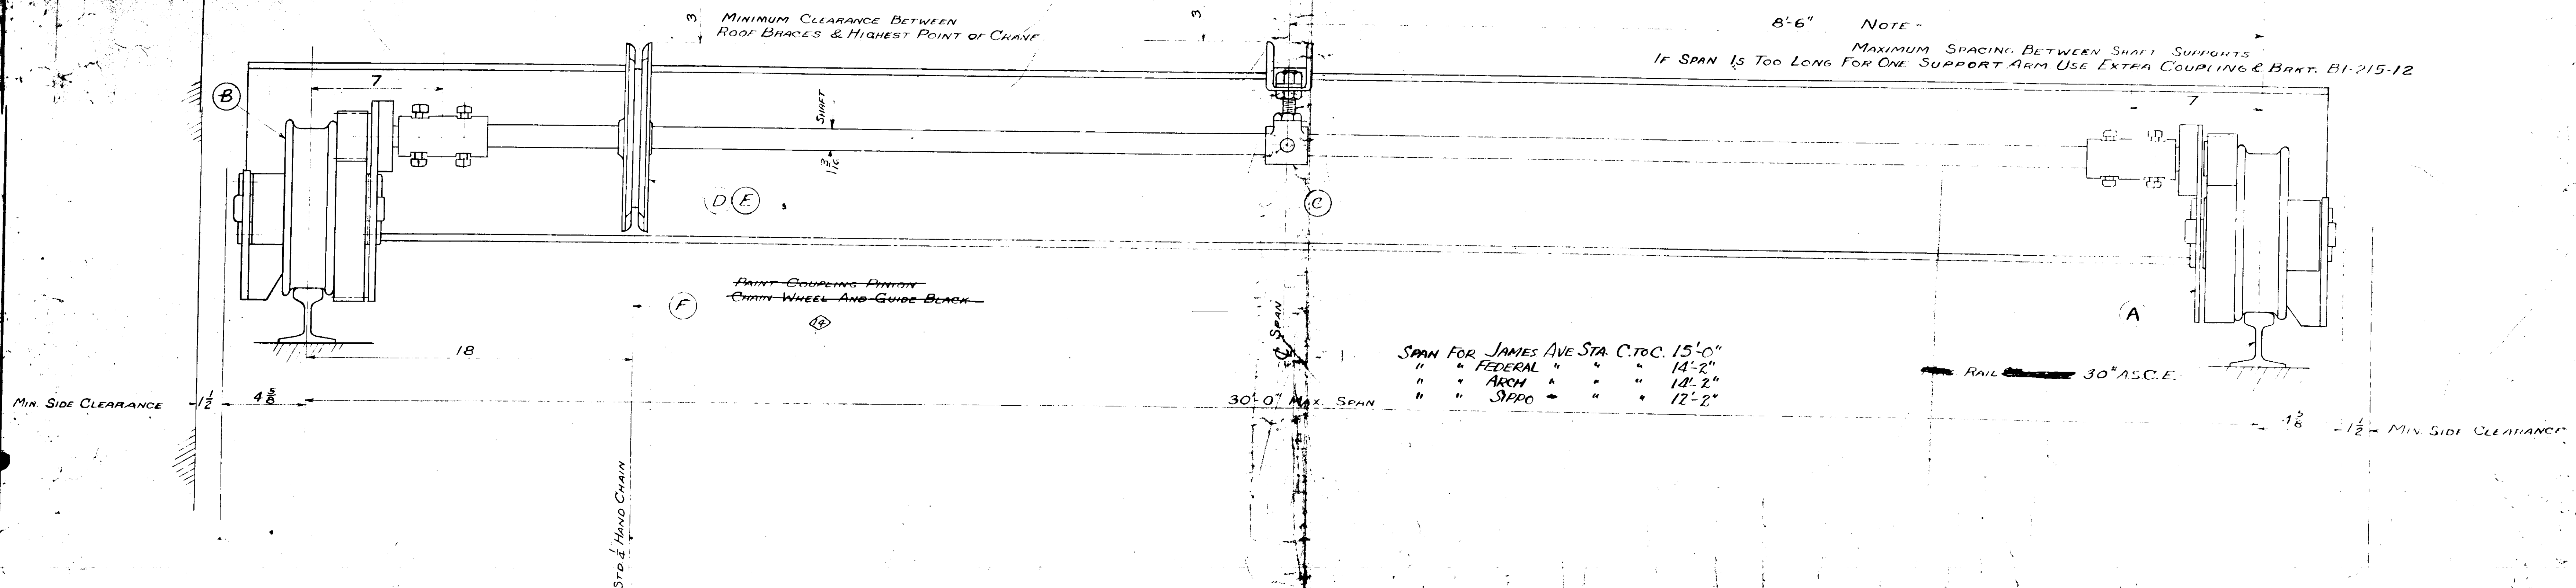

SPAN FOR JAMES AVE STA. C.T.C. 15'-0"
" " FEDERAL " " 14'-2"
" " SHPO " " 12'-2"

NOTE -
MAXIMUM SPACING BETWEEN SHAFT SUPPORTS
IF SPAN IS TOO LONG FOR ONE SUPPORT ARM USE EXTRA COUPLING & BRKT. B1-215-12

RAIL 30" A.S.C.E.

✓ 40 812 WAS 10.7085.44 ALIGNED
W/INSTR AT 10.7085.44 10.7085.44

✓ ALL CHANGING LITERATURE


