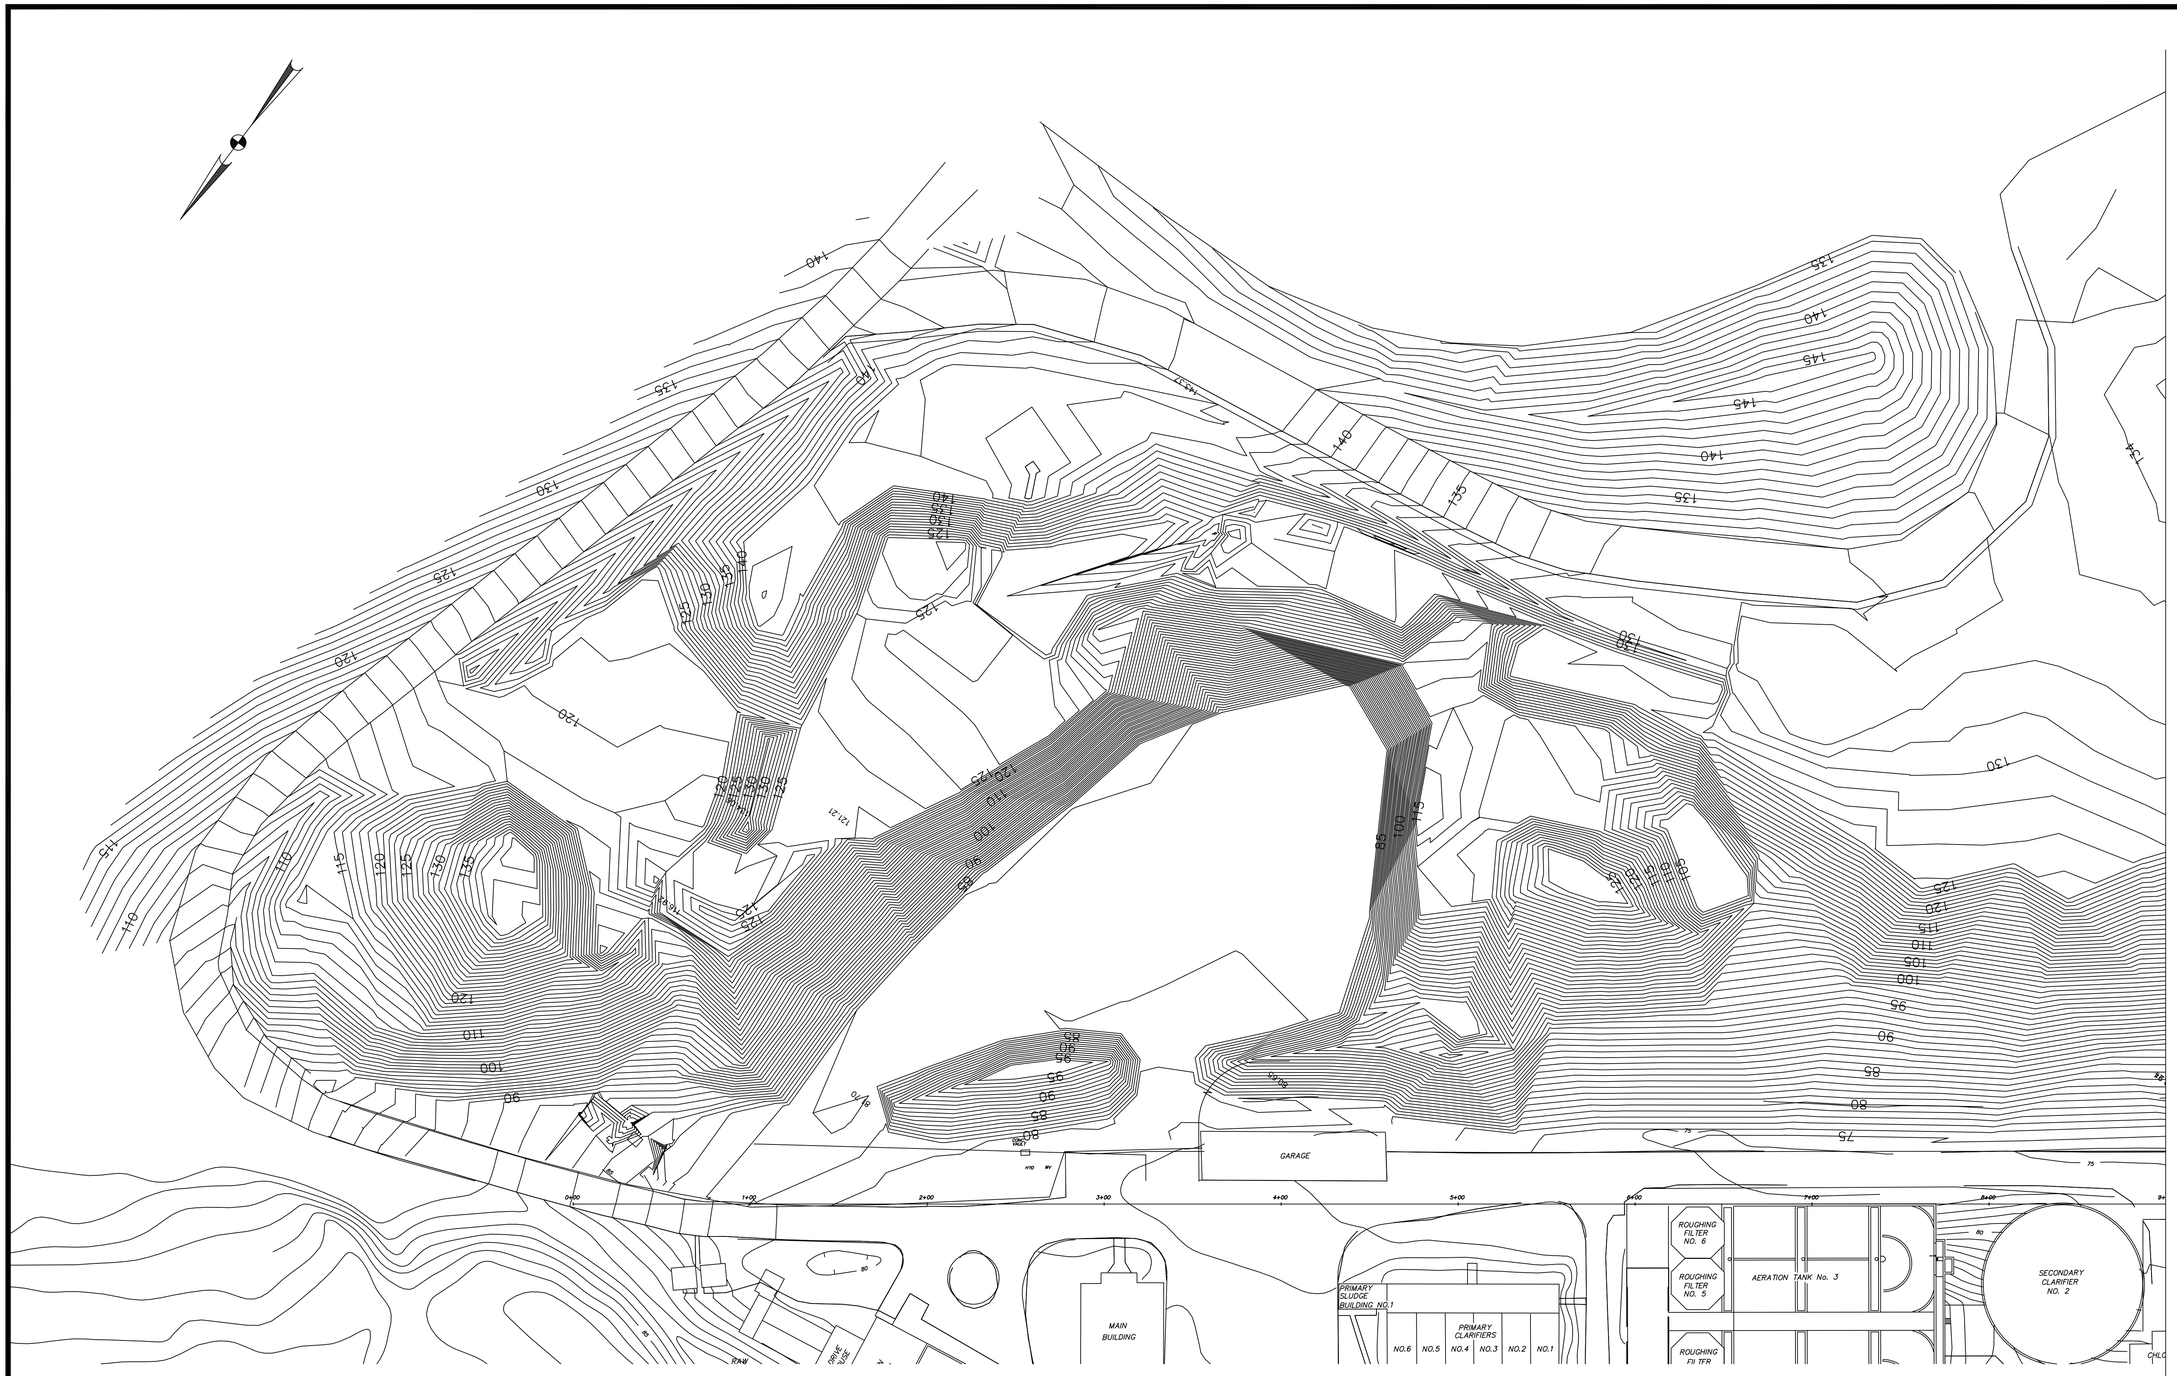

THESE RECORD DOCUMENTS HAVE BEEN PREPARED BASED ON INFORMATION PROVIDED BY OTHERS. CTI ENVIRONMENTAL HAS REVIEWED THE INFORMATION SUBMITTED AND BELIEVES IT REFLECTS THE WORK AS CONSTRUCTED. HOWEVER, ALL PERSONS SHALL VERIFY INFORMATION TAKEN FROM THIS DRAWING.

THIS DRAWING IS AN INSTRUMENT OF SERVICE OWNED BY CTI ENVIRONMENTAL, INC. AND SHALL BE DEEMED THE AUTHOR AND WHICH SHALL RETAIN ALL STATUTORY AND COMMON LAW RIGHTS, INCLUDING COPYRIGHTS. THIS DRAWING SHALL NOT BE LOANED, COPIED OR DISTRIBUTED TO OTHERS IN ANY FORM OR USED FOR ANY PURPOSE OTHER THAN THAT AUTHORIZED BY CTI ENVIRONMENTAL, INC. WITHOUT PRIOR WRITTEN CONSENT OF CTI ENVIRONMENTAL, INC. CTI ENVIRONMENTAL, INC. CANNOT GUARANTEE THAT ELECTRONIC COPIES OF THIS DRAWING ARE EXACT DUPLICATES OF THE SEALED ORIGINAL DRAWING. IN CASE OF A CONFLICT, THE SEALED ORIGINAL SHALL GOVERN.

REVISIONS

NO.	DESCRIPTIONS	DATE	BY	APP'D
1	ADDENDUM NO. 1	9/12	AJP	WAD
2	RECORD DRAWINGS	12/28	AJP	WAD

DESIGNED BY	DRAWN BY	CHECKED BY	APPROVED BY
AJP	AJP	WAD	WAD

ENVIRONMENTAL, INC.
ENGINEERS IN WATER AND EARTH SCIENCES
UNIONTOWN, OHIO

CITY OF MASSILLON, OHIO
WWTP UPGRADE 2000
EXISTING CONTOURS–HILLSIDE

JOB NO.
E9031
DATE
8/13/01
SCALE
1"=40'
SHEET
C10

E:/E9031/ep9031/grading-hill/9031EXGRD.DWG