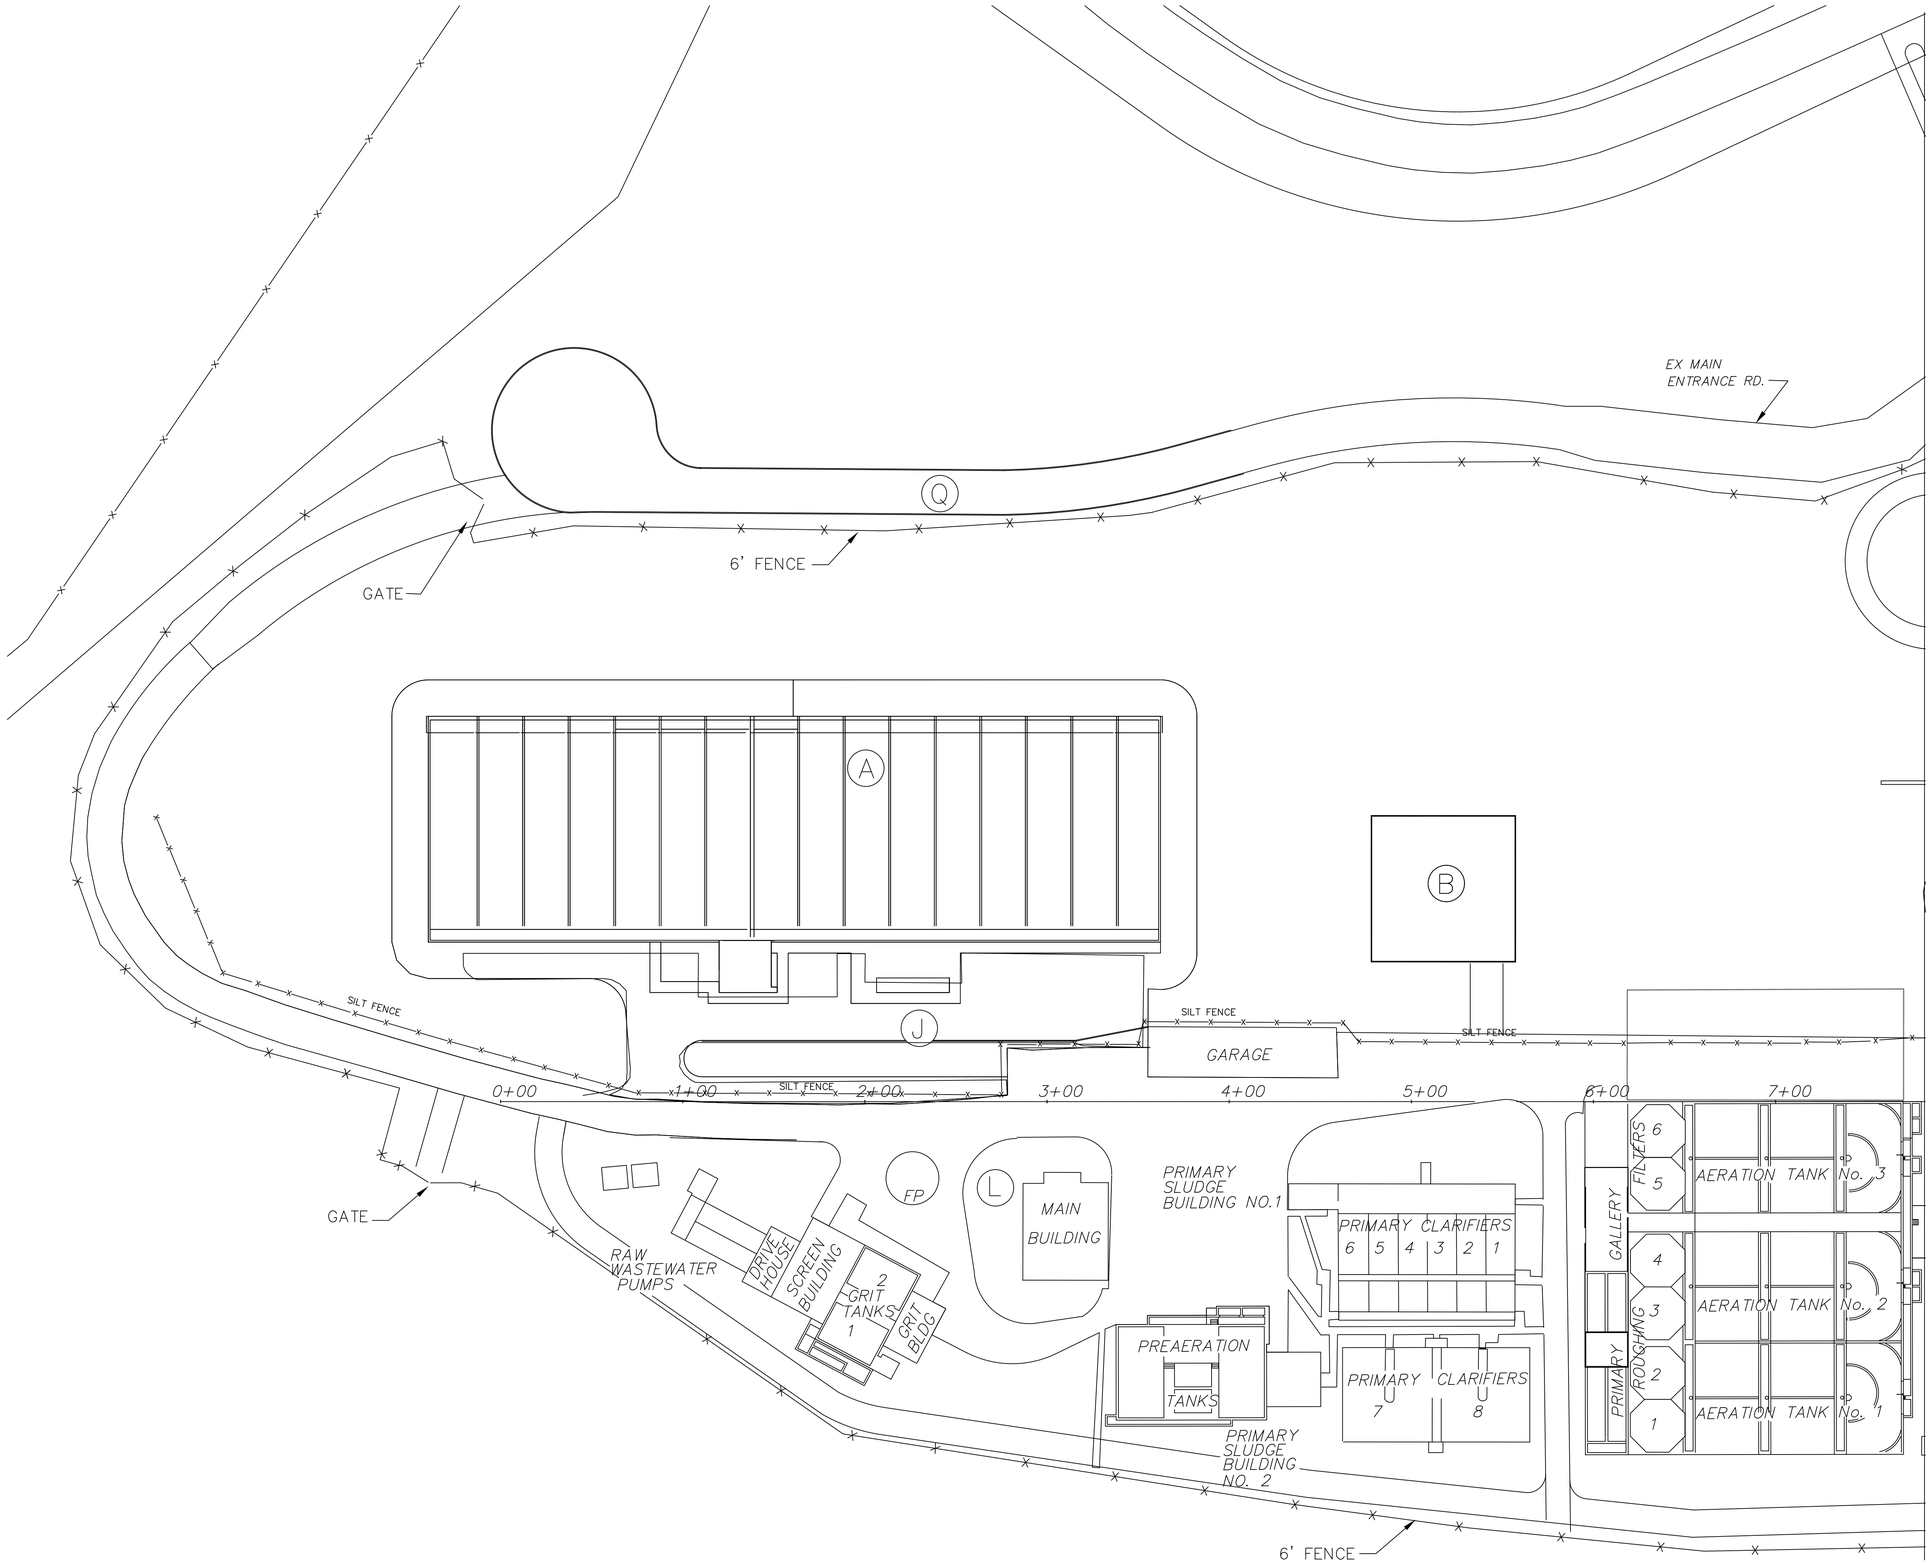

CONTINUATION SEE SHEET C13

THESE RECORD DOCUMENTS HAVE BEEN PREPARED BASED ON INFORMATION PROVIDED BY OTHERS. CTI ENVIRONMENTAL HAS REVIEWED THE INFORMATION SUBMITTED AND BELIEVES IT REFLECTS THE WORK AS CONSTRUCTED. HOWEVER, ALL PERSONS SHALL VERIFY INFORMATION TAKEN FROM THIS DRAWING.

REVISIONS

NO.	DESCRIPTIONS	DATE	BY	APP'D
1	RECORD DRAWING	12/16	RWR	WAD

DESIGNED BY ELR/AJP
DRAWN BY ELR/AJP
CHECKED BY MGW
APPROVED BY WAD

ENVIRONMENTAL, INC.
ENGINEERS IN WATER AND EARTH SCIENCES
UNIONTOWN, OHIO

CITY OF MASSILLON, OHIO
WWTP UPGRADE 2000
STORM WATER POLLUTION PREVENTION PLAN

JOB NO. E9031
DATE 8/13/00
SCALE 1"=40'
SHEET C12

E:/E9031/2000-SITE/9031SWWP3.DWG