
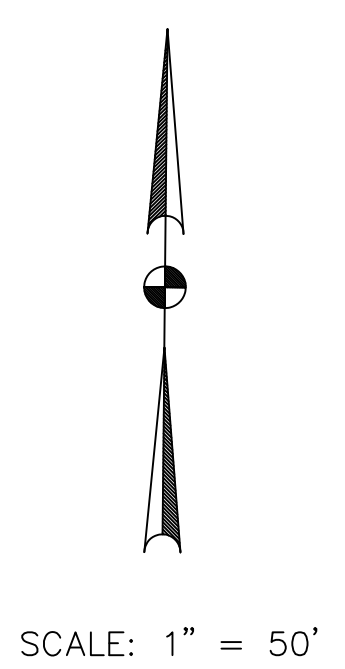


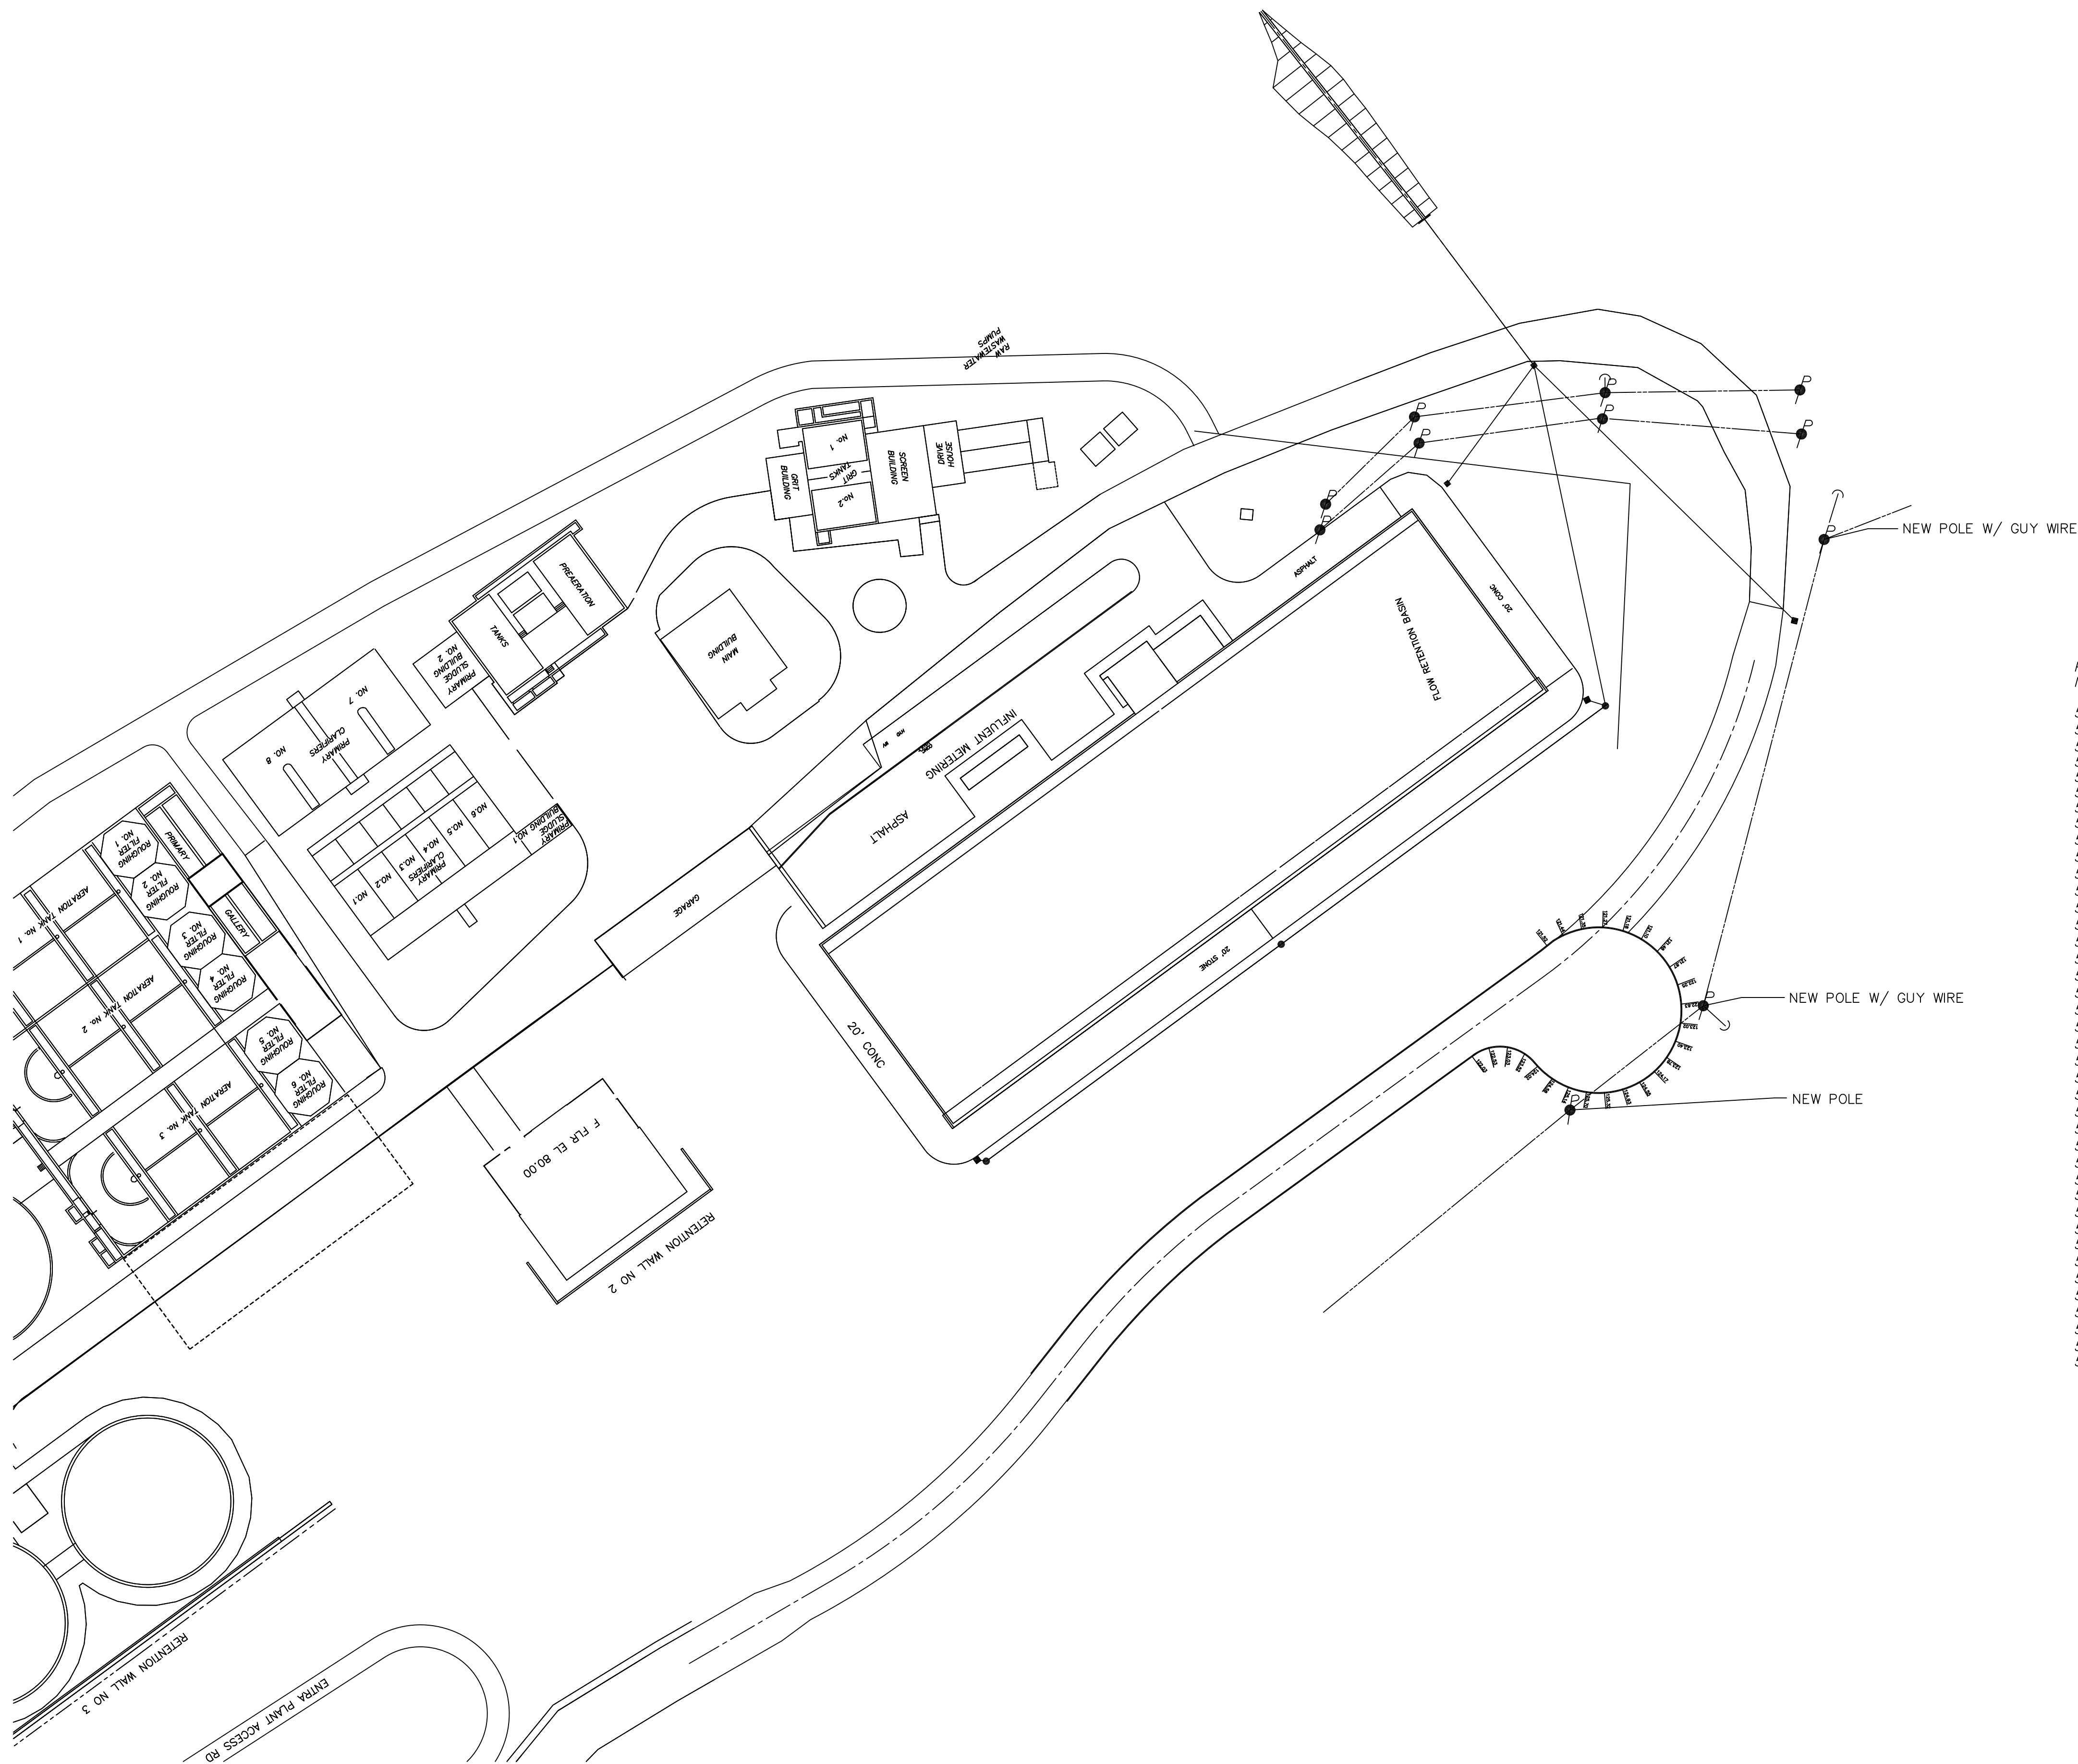

PT NO	NORTHING	EASTING	ELEV	DESCRIPTION
500	403501.4040	2239287.3760	126.11	REBAR
5010	403236.5618	2238664.7019	74.86	3/BAR
5011	403325.3187	2238785.3863	74.99	4/BAR
5013	403659.4298	2239251.3070	83.64	FE
5014	403638.7408	2239255.3634	84.22	FE
5015	403644.0578	2239262.5938	84.56	FE
5016	403641.8720	2239303.8189	88.79	FE
5017	403655.3143	2239305.2150	87.20	FE
5018	403641.4009	2239311.4450	88.19	NEW/PP
5019	403655.4313	2239314.5281	88.13	NEW/PP
5020	403688.7915	2239365.5708	90.55	NEW/PP
5021	403703.1093	2239363.0747	90.37	NEW/PP
5022	403788.9468	2239597.2493	122.98	IPS/NFW
5023	403653.5309	2239222.8179	82.24	5/BAR
5024	403716.3488	2239467.2223	99.39	NEW/PP
5025	403702.0437	2239465.7846	99.95	NEW/PP
5026	403724.4775	2239467.1367	99.04	GUY/WIRE
5027	403717.8335	2239573.6537	111.52	NEW/PP
5028	403693.7491	2239574.4912	109.54	NEW/PP
5029	403636.1538	2239586.8615	115.37	NEW/PP
5030	403661.1342	2239594.5400	116.30	GUY/WIRE
5031	403655.7419	2239612.7653	118.35	GUY/WIRE
5032	403673.5206	2239641.5531	117.05	GUY/WIRE
5033	403654.7043	2239634.3893	117.43	OLD/PP
5034	403381.4099	2239520.8651	129.28	NEW/PP
5035	403370.3835	2239532.9684	132.45	GUY/WIRE
5036	403578.5729	2239430.1324	138.81	PP CUT OFF NEAR GRD
5037	403641.9516	2239411.1738	127.82	PP CUT NEAR GRD
5038	403324.4385	2239448.0335	131.27	NEW/PP
5039	403359.8249	2239400.4507	142.13	IPS (SURVEY)
5040	403788.9193	2239597.2367	122.80	IPS/NEW(SURVEY)
5041	403501.4060	2239287.1936	126.11	100/IPS (SURVEY)
5042	403471.4392	2239324.3298	134.09	MH
5043	403364.6232	2239378.6504	142.98	PP CUT OFF NEAR GRD
5044	403359.9312	2239394.5005	142.88	PP CUT OFF NEAR GRD
5045	403213.9077	2239313.3596	145.20	OLD/PP
5046	403175.0335	2239282.6795	142.15	OLD/PP
5047	403157.6351	2239269.6878	141.74	OLD/PP
5048	403126.7592	2239245.4530	141.87	OLD/PP
5049	403129.5894	2239261.0890	143.36	MH

ADDENDUM NO. 1

CITY OF MASSILLON, OHIO
WWTP UPGRADE 2000

SK-C16-001