


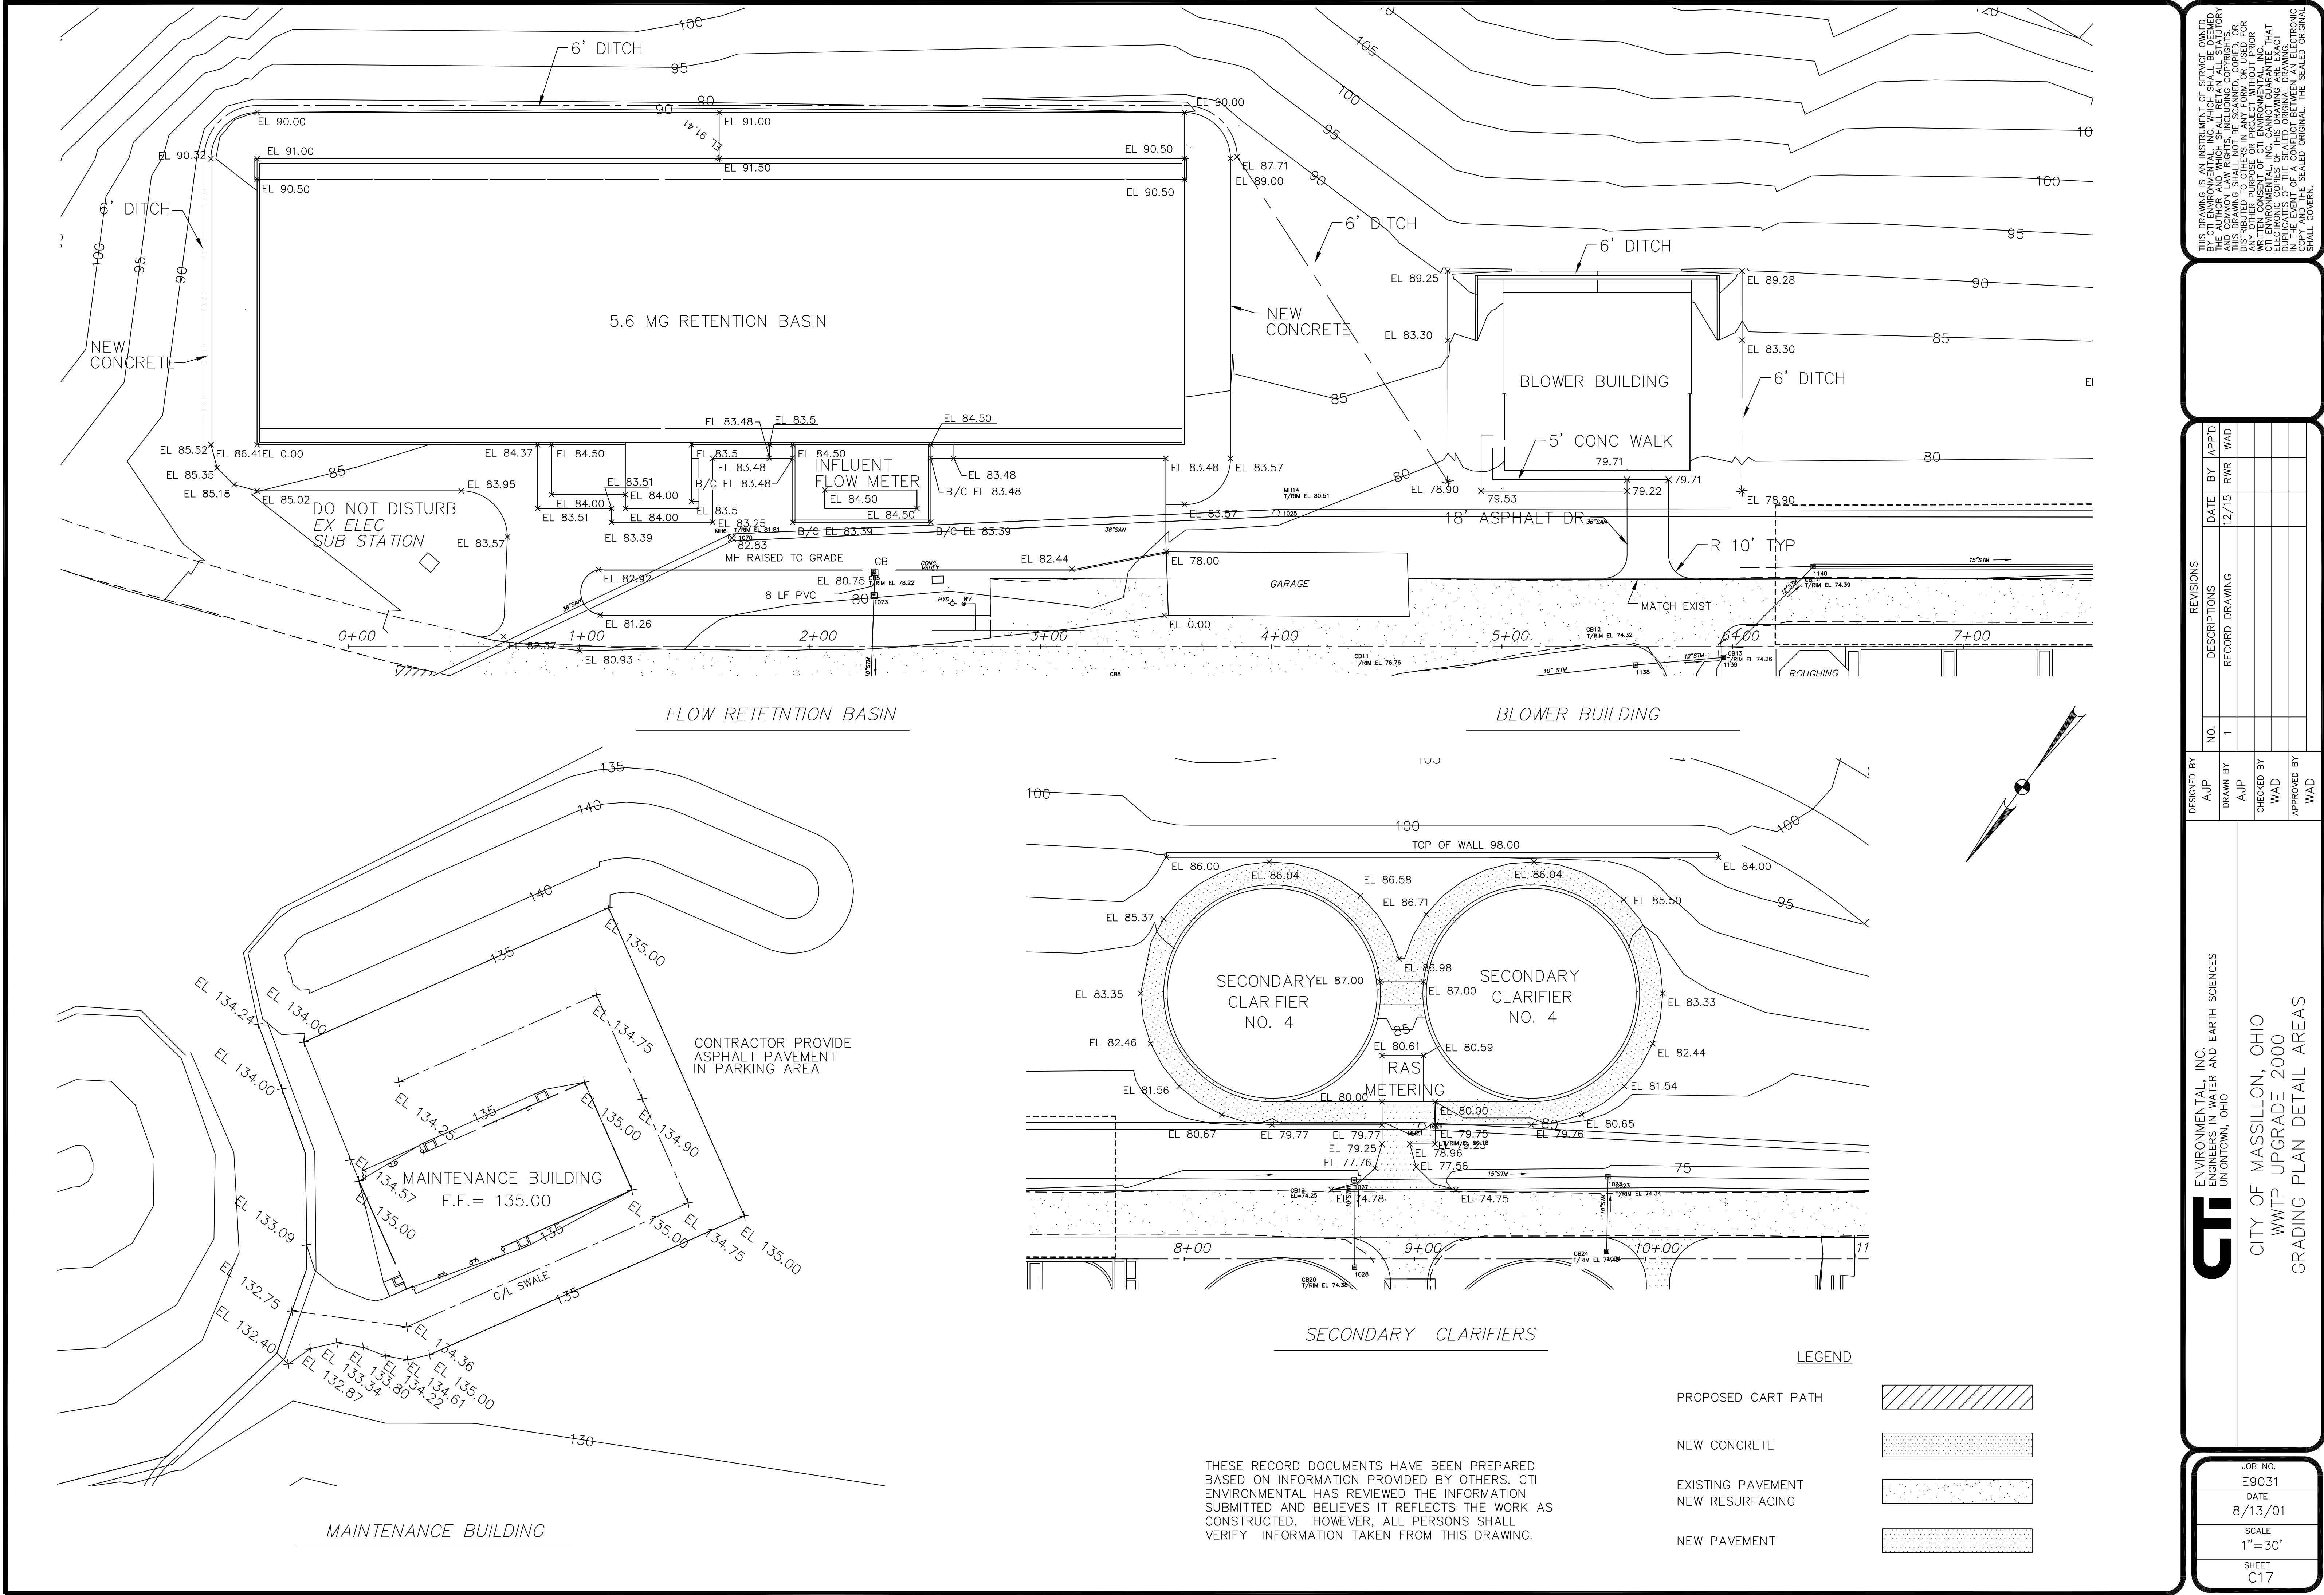




NO.	REVISIONS	DATE	BY	APP'D
1	DESCRIPTIONS	12/15	RWR	WAD

DESIGNED BY	DRAWN BY	CHECKED BY	APPROVED BY
AJP	AJP	WAD	WAD

NO.	REVISIONS	DATE	BY	APP'D
1	DESCRIPTIONS	12/15	RWR	WAD

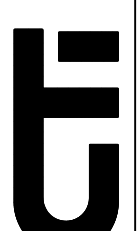

CTI ENVIRONMENTAL, INC.
ENGINEERS IN WATER AND EARTH SCIENCES
UNIONTOWN, OHIO

CITY OF MASSILLON, OHIO
WWTP UPGRADE 2000
GRADING PLAN DETAIL AREAS

JOB NO. E9031
DATE 8/13/01
SCALE 1"=30'
SHEET C17