NUMBER	DEFLECTION ANGLE	DELTA ANGLE	DEGREE OF CURVE – ARC	CHORD DIRECTION	TANGENT	RADIUS	ARC LENGTH	CHORD LENGTH
C1	24°02'14"	24°02'14"	14°19'26"	N 50°15'58" E	85.1589	400.0000	167.8123	166.5844
C2	14°25'27"	14°25'27"	14°19'26"	N 45°27'35" E	50.6177	400.0000	100.7001	100.4344
C3	40°39'17"	40°39'17"	19°05'55"	N 33°45'13" E	111.1359	300.0000	212.8670	208.4296

NOTE:
1. PROPOSED FENCE LOCATION SHALL BE OUTSIDE OF POWER POLES AND GUY WIRES UNLESS NOTED OTHERWISE.
2. CONTRACTOR SHALL FIELD VERIFY EXIST SAN SEWER ELEV @ LOCATIONS OF PROP SAN MH #3 PRIOR TO CONSTRUCTION OF SAN SEWER IMPROVEMENTS UPSTREAM OF PROP SAN MH #6.
3. STORM SEWER PIPE SHALL BE RCP OR PVC SDR35.

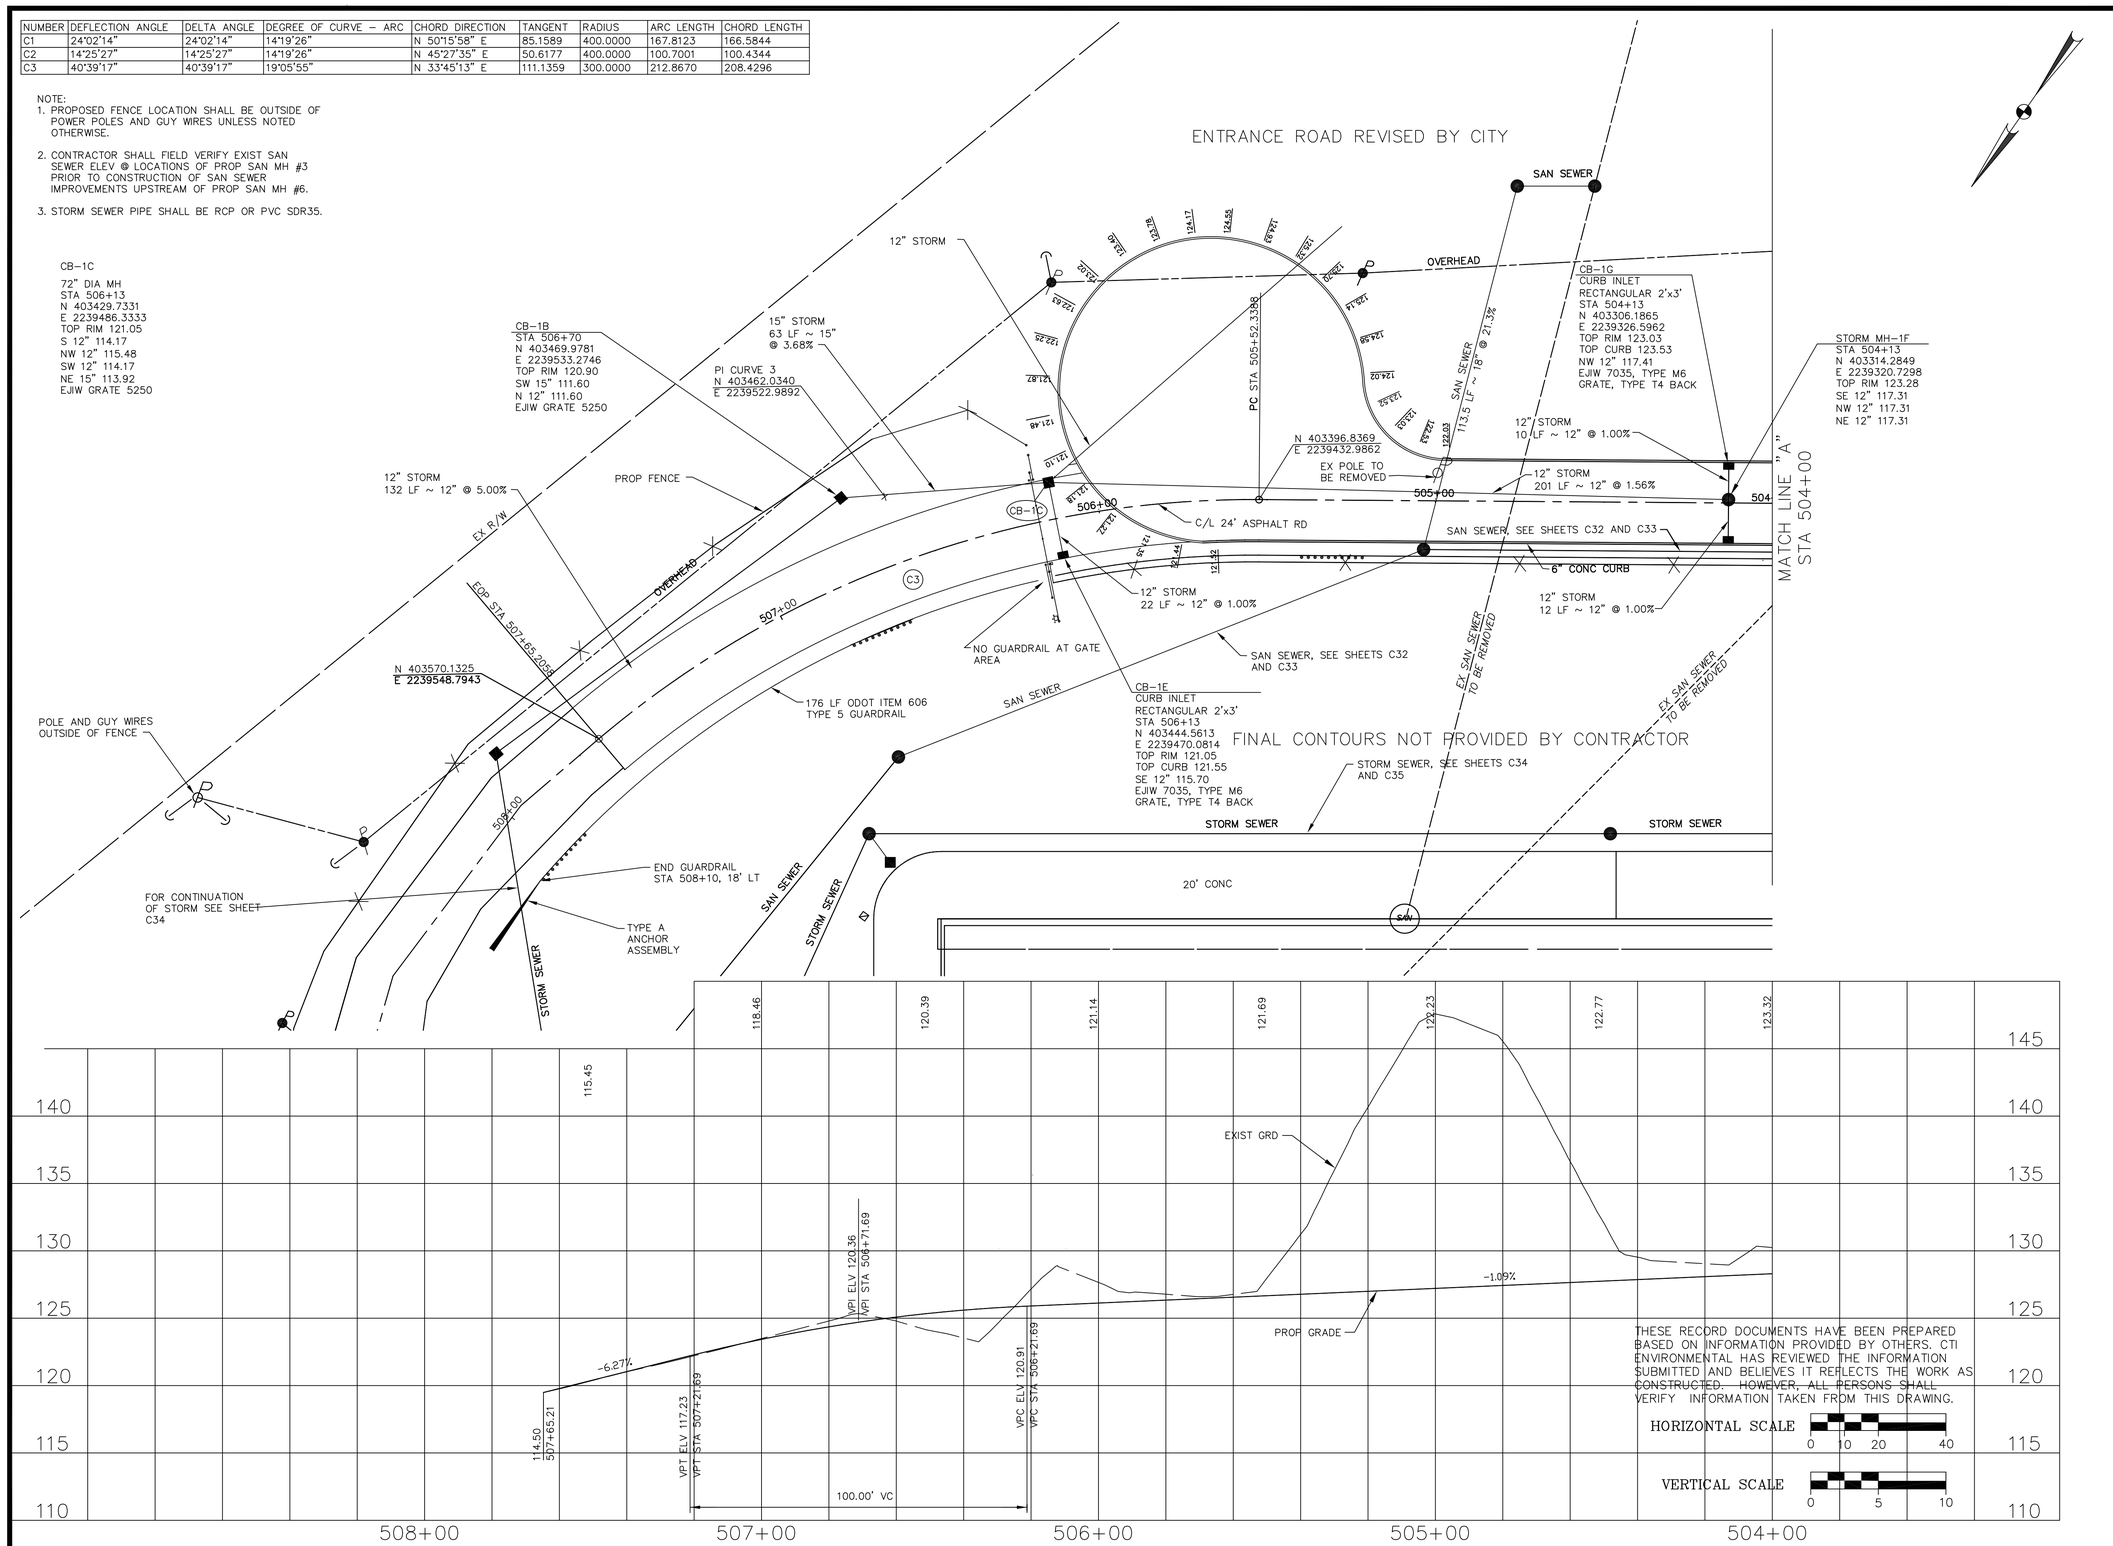

THIS DRAWING IS AN INSTRUMENT OF SERVICE OWNED BY CTI ENVIRONMENTAL, INC. WHICH SHALL BE DEEMED THE AUTHOR OF SUCH, AND MAINTAINS STATUTORY AND COMMON LAW RIGHTS, INCLUDING COPYRIGHTS. THIS DRAWING SHALL NOT BE SOLD OR OTHERWISE DISTRIBUTED TO OTHERS IN ANY FORM OR USED FOR ANY OTHER PURPOSE OR PROJECT WITHOUT PRIOR WRITTEN CONSENT OF CTI ENVIRONMENTAL, INC. CTI ENVIRONMENTAL, INC. CANNOT GUARANTEE THAT DUPLICATES OF THE SEALED ORIGINAL DRAWING, DUPLICATES OF THE CONTRACTOR'S DRAWING, AND COPY AND PRINTS OF THE SEALED ORIGINAL, THE SEALED ORIGINAL SHALL GOVERN.

REVISIONS

NO.	DESCRIPTIONS	DATE	BY	APP'D
1	ADDENDUM	9/13	AJP	WAD
2	RECORD DRAWING	12/15	RWR	WAD

DESIGNED BY MGW
DRAWN BY AJP/JAM
CHECKED BY WAD
APPROVED BY WAD

CTI ENVIRONMENTAL, INC.
ENGINEERS IN WATER AND EARTH SCIENCES
UNIONTOWN, OHIO

CITY OF MASSILLON, OHIO
WWTP UPGRADE 2000
REVISED ENTRANCE ROAD
PLAN & PROFILE

JOB NO. E9031
DATE 3/19/02
SCALE AS SHOWN
SHEET C19

E:/E9031/ep9031/grading-hill/relocated entrance rd/rehill.DWG