
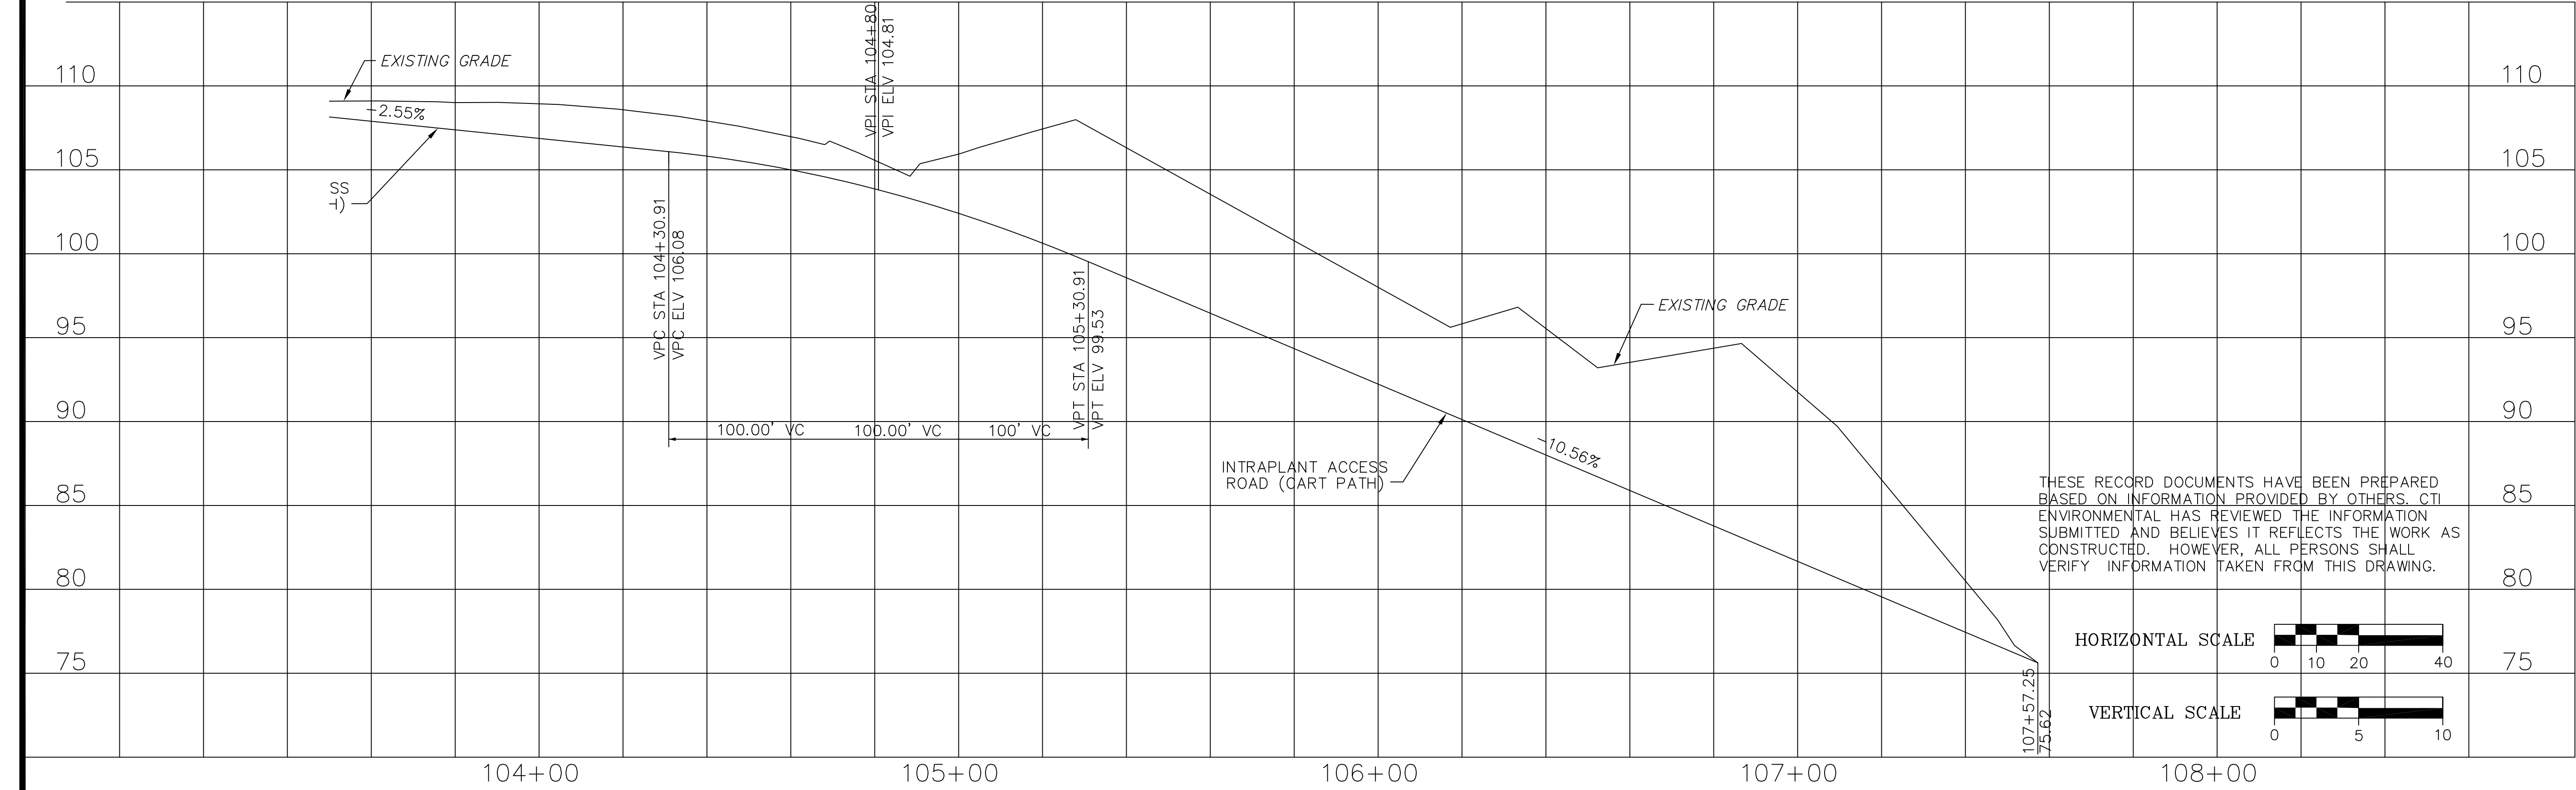


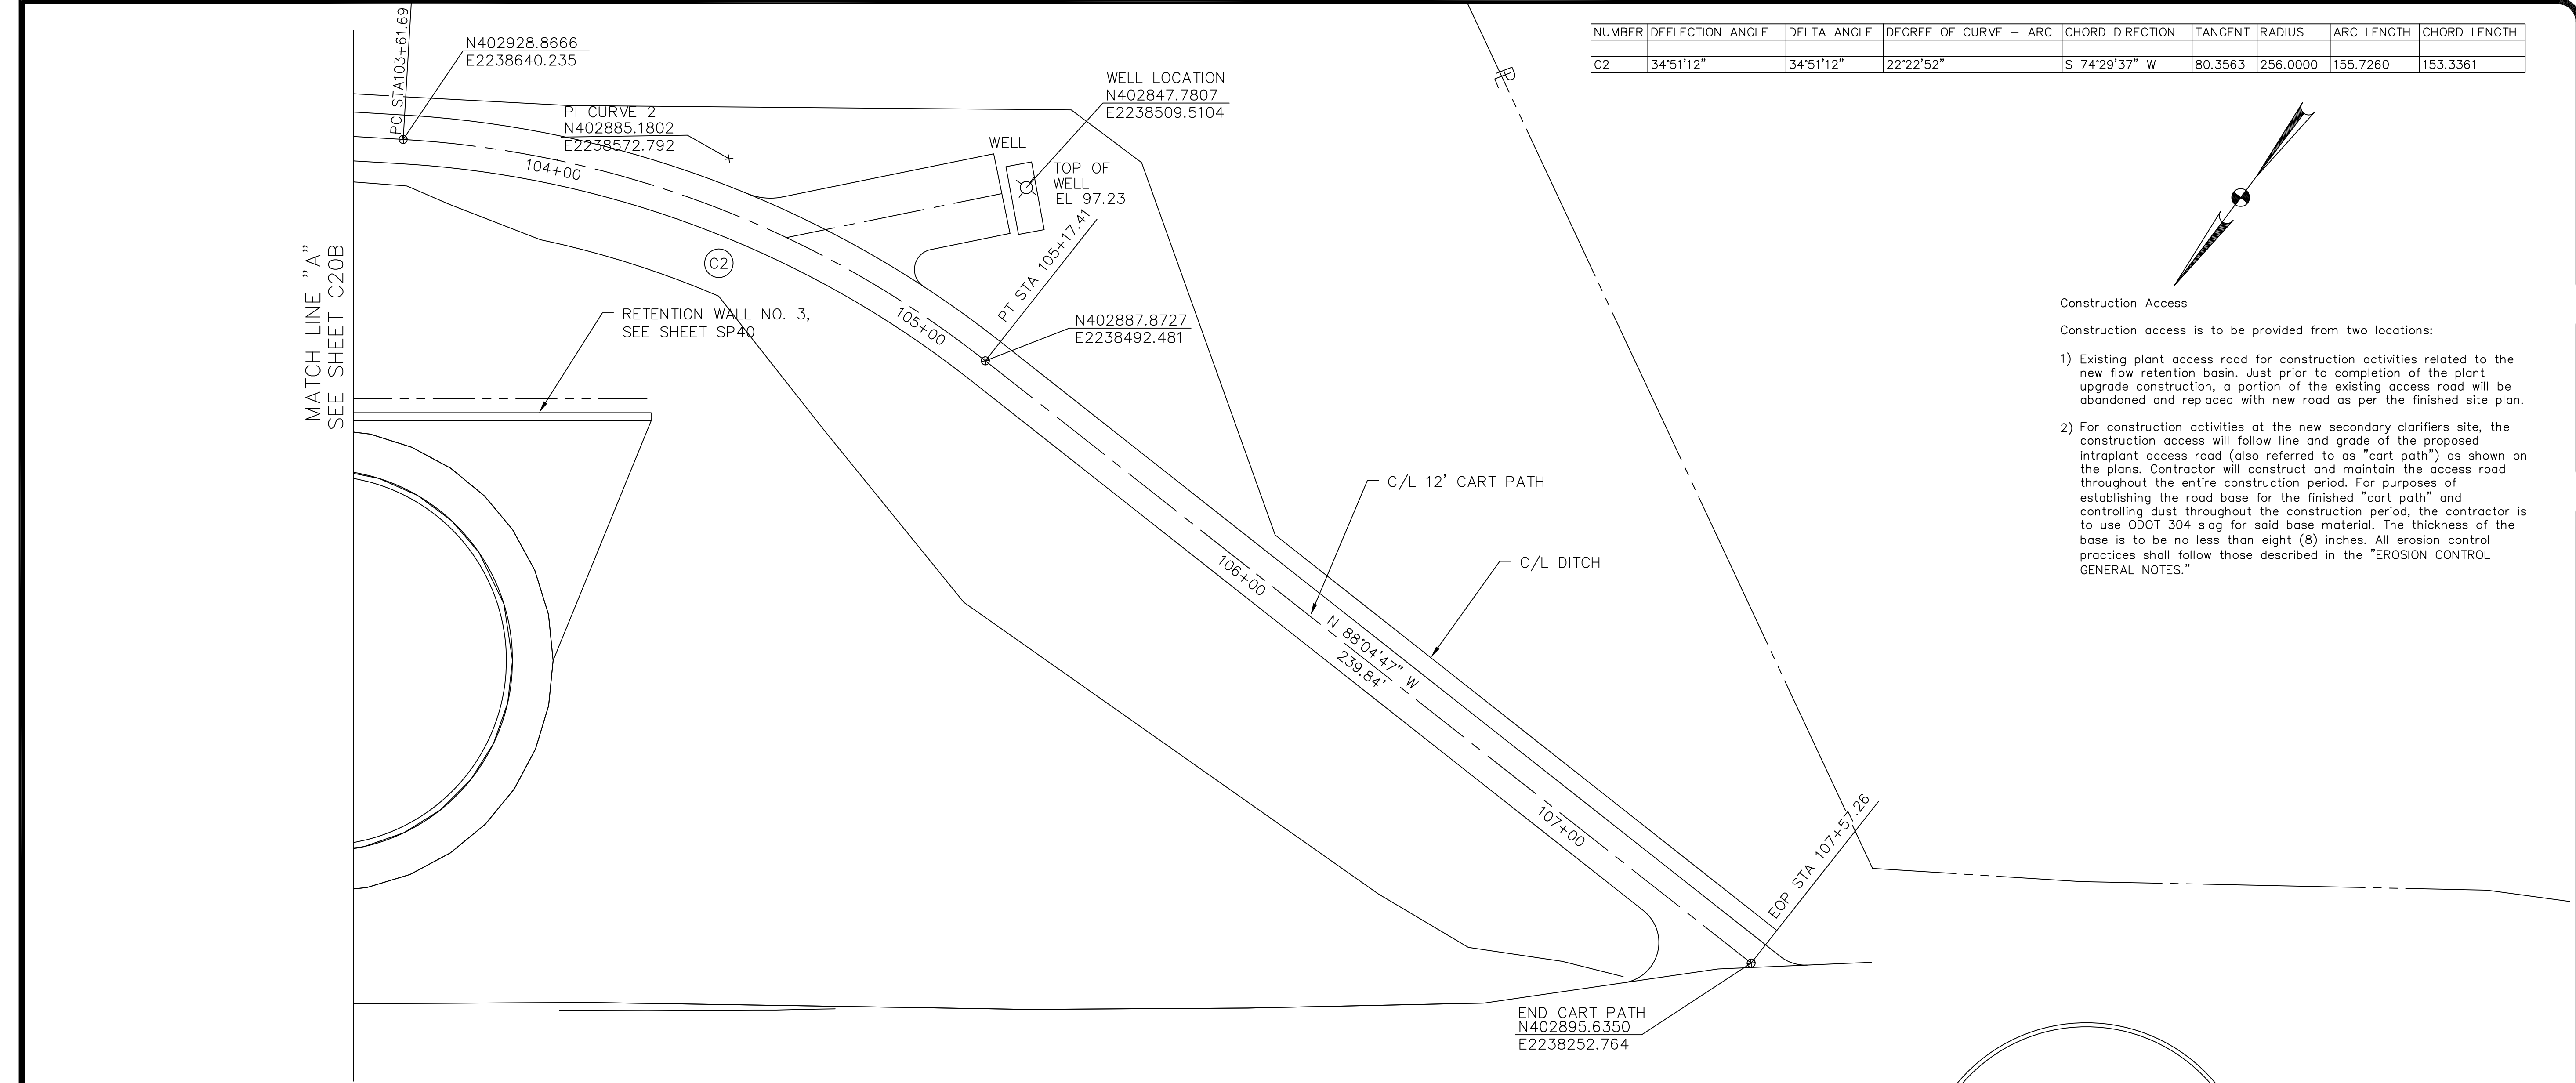



DESIGNED BY
AJP

DRAWN BY
AJP

CHECKED BY
WAD

APPROVED BY
WAD

REVISIONS			
NO.	DESCRIPTIONS	DATE	BY
1	ADDENDUM NO. 1	9/14	AJP
2	ADDENDUM NO. 2	9/21	AJP

ENVIRONMENTAL, INC.
ENGINEERS IN WATER AND EARTH SCIENCES
UNIONTOWN, OHIO

CTI

CITY OF MASSILLON, OHIO
WWTP UPGRADE 2000
INTRAPLANT ACCESS ROAD (CART PATH)
PLAN & PROFILE

JOB NO. E9031
DATE 9/21/01
SCALE AS SHOWN
SHEET C20C