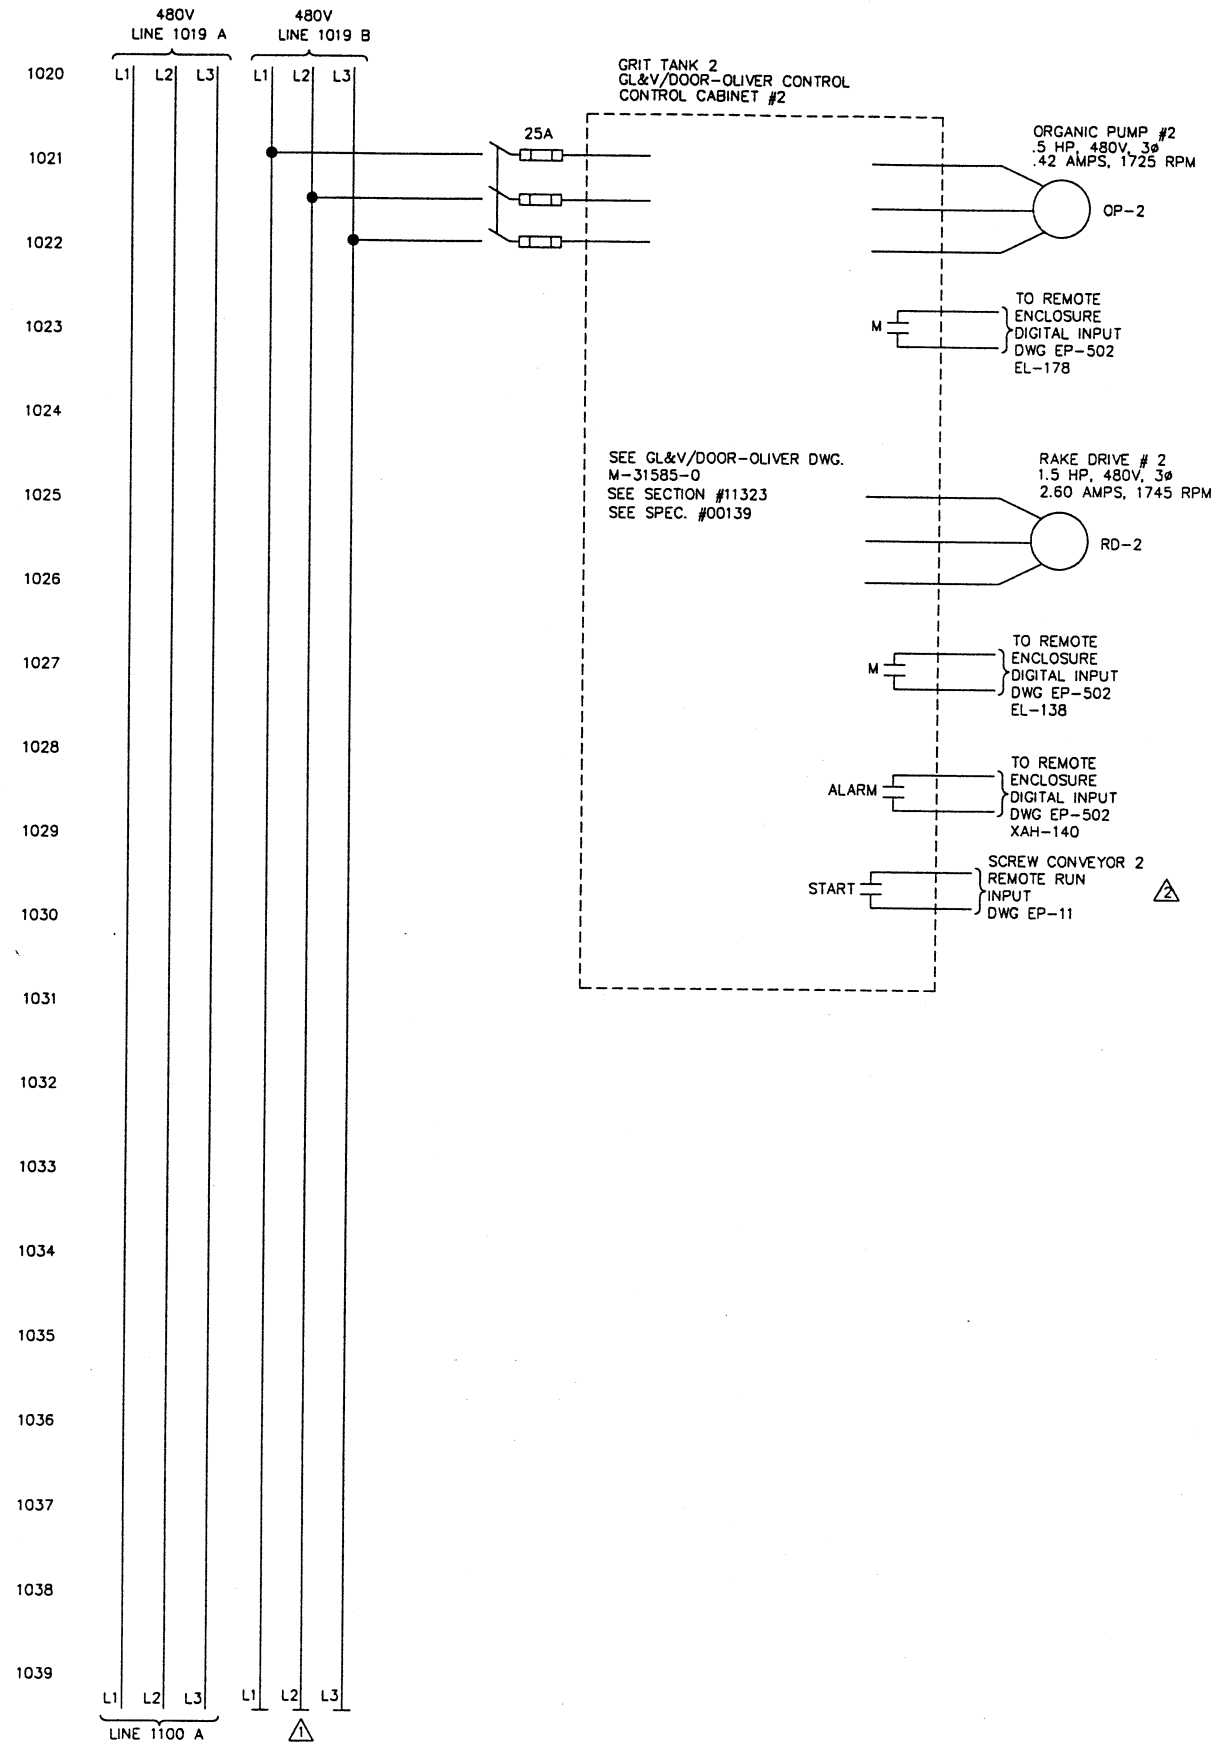
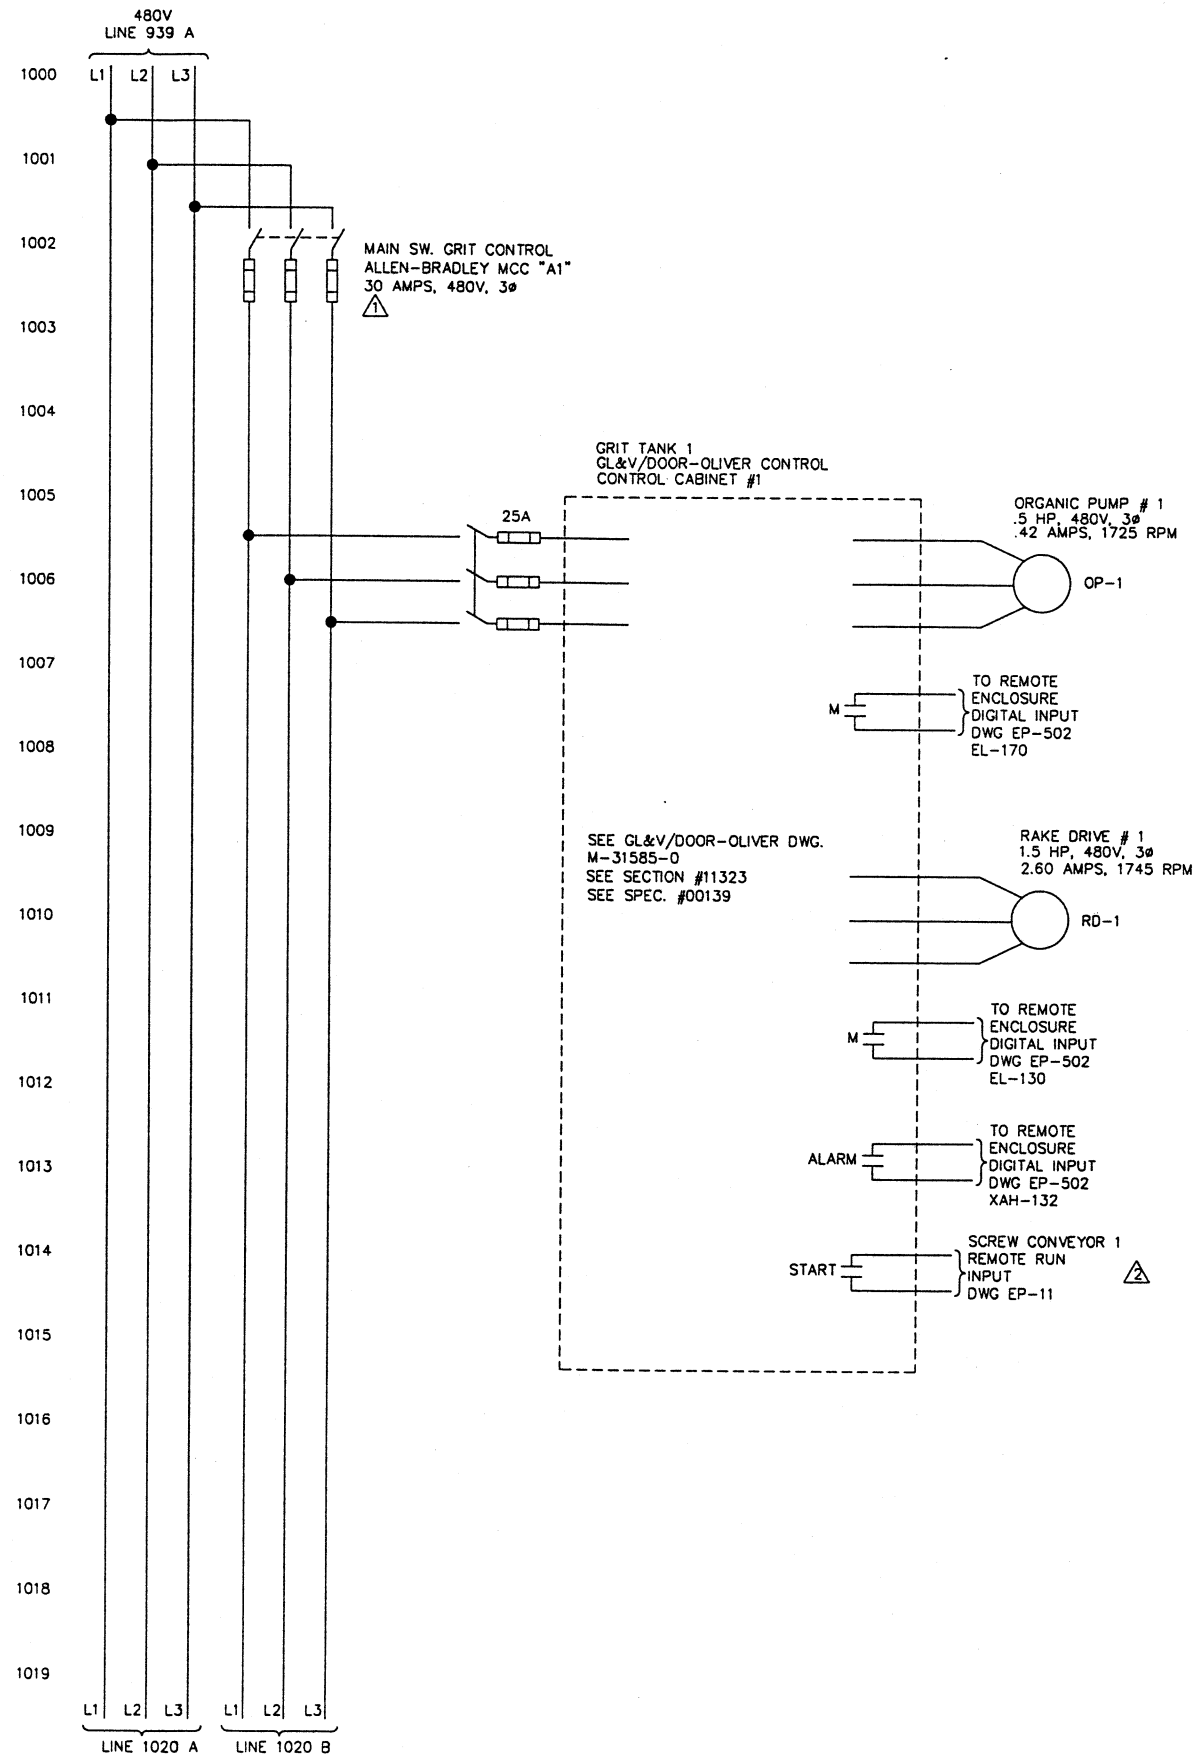


ENVIRONMENTAL, INC.
ENGINEERS IN WATER AND EARTH SCIENCES
UNIONTOWN, OHIO

CITY OF MASSILLON, OHIO
WWTP UPGRADE 2000
TRANSFORMER "A1" MCC-A1
GRIT TANK #1 & #2 SCHEMATIC DIAGRAM

JOB NO.
9031
DATE
2/16/01
SCALE
N/A
SHEET
EP10-2

9031SCHE10.DWG