


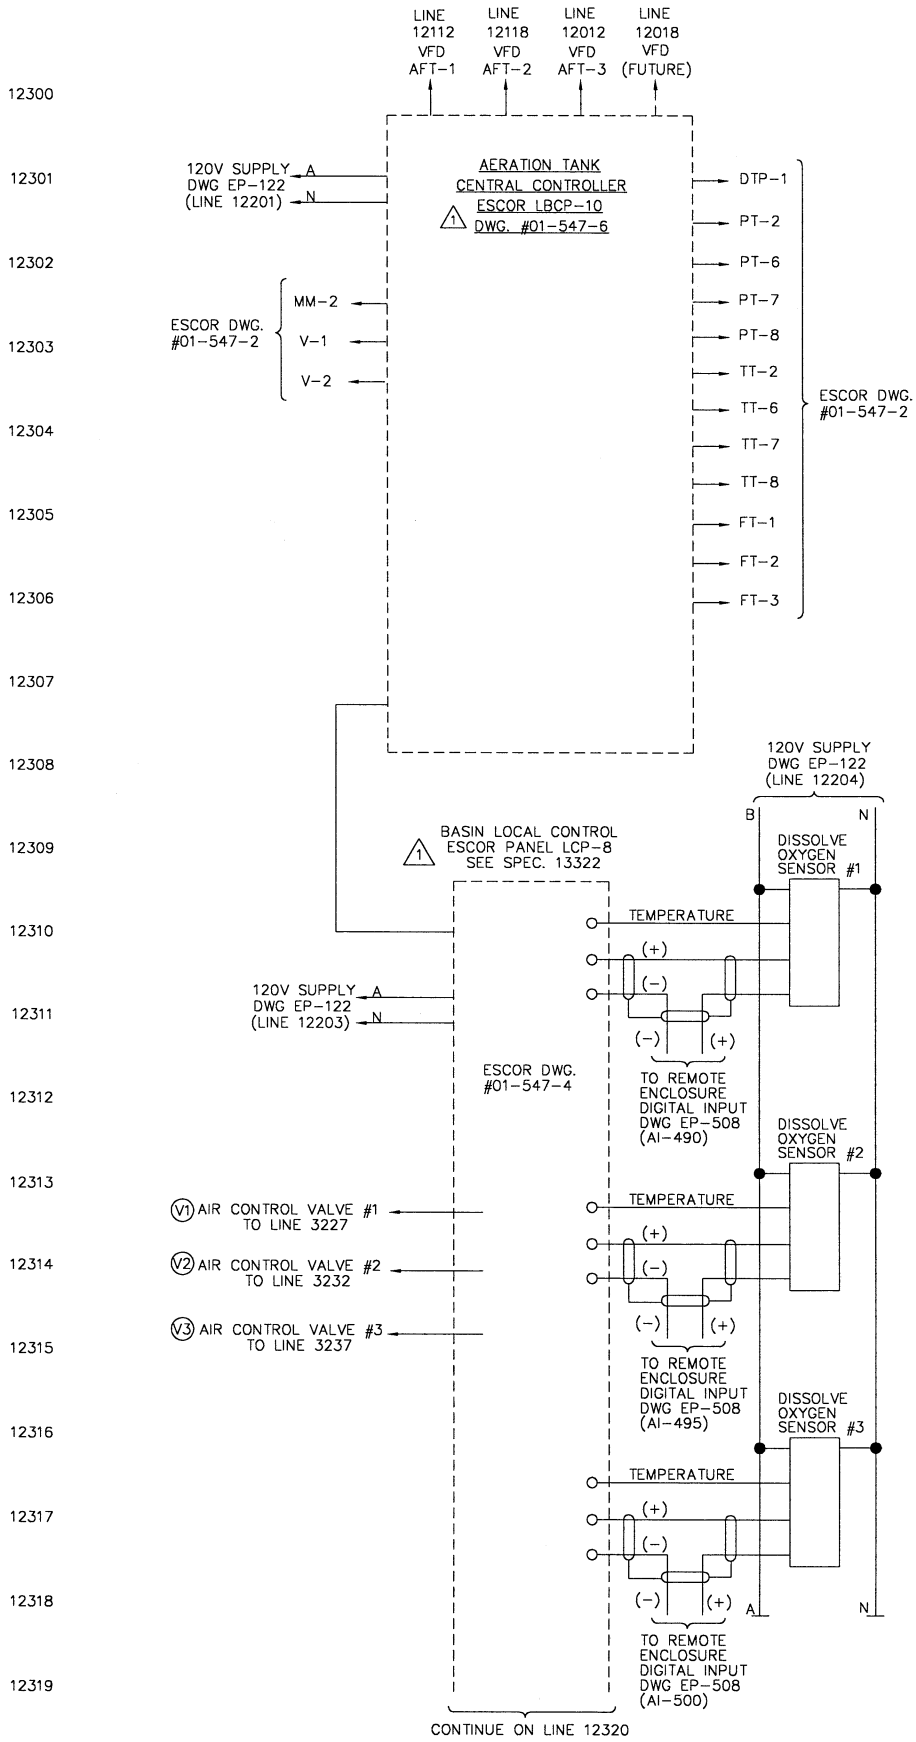

12320

12321

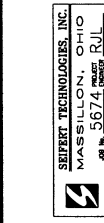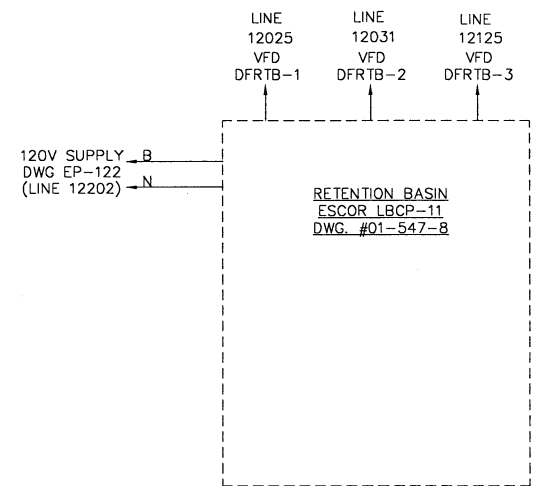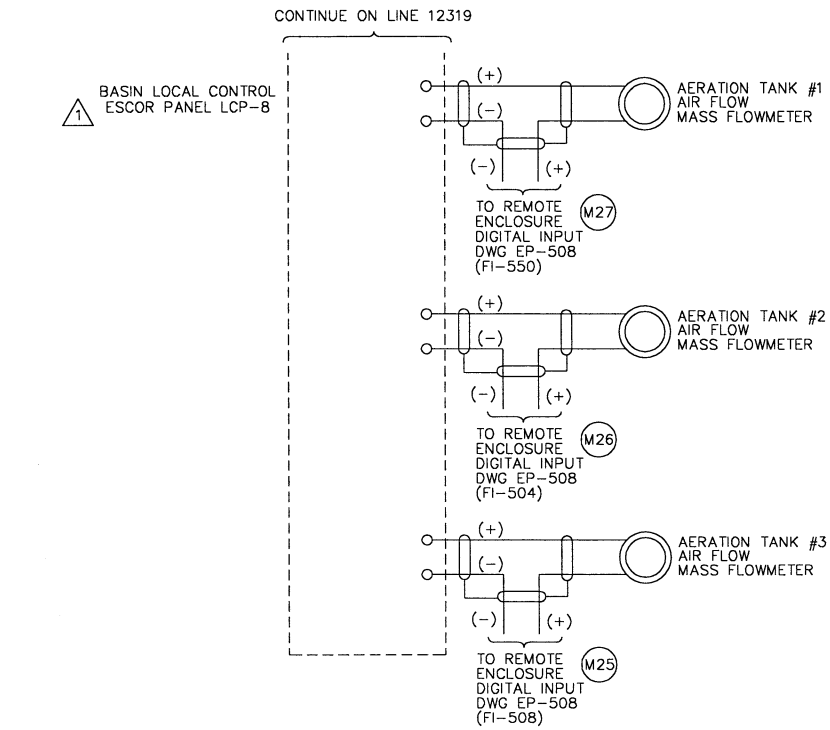

| DESIGNED BY |                            | REVISIONS |        | DATE |      | BY  |      |
|-------------|----------------------------|-----------|--------|------|------|-----|------|
| NO.         | DESCRIPTIONS               | NO.       | DATE   | BY   | DATE | BY  | DATE |
| 1           | REVISED AS PER ESCOR DWG'S | 1         | 7/9/03 | TSS  |      | R/L |      |

ENVIRONMENTAL, INC.  
ENGINEERS IN WATER AND EARTH SCIENCES  
UNIONTOWN, OHIO

CITY OF MASSILLON, OHIO  
WWTP UPGRADE 2000  
TRANSFORMER "E2", MCC-E2  
CENTRAL CONTROLLERS SCHEMATIC DIAGRAM

|                  |
|------------------|
| JOB NO.<br>E9031 |
| DATE<br>3/1/01   |
| SCALE<br>N/A     |
| SHEET<br>EP123-1 |