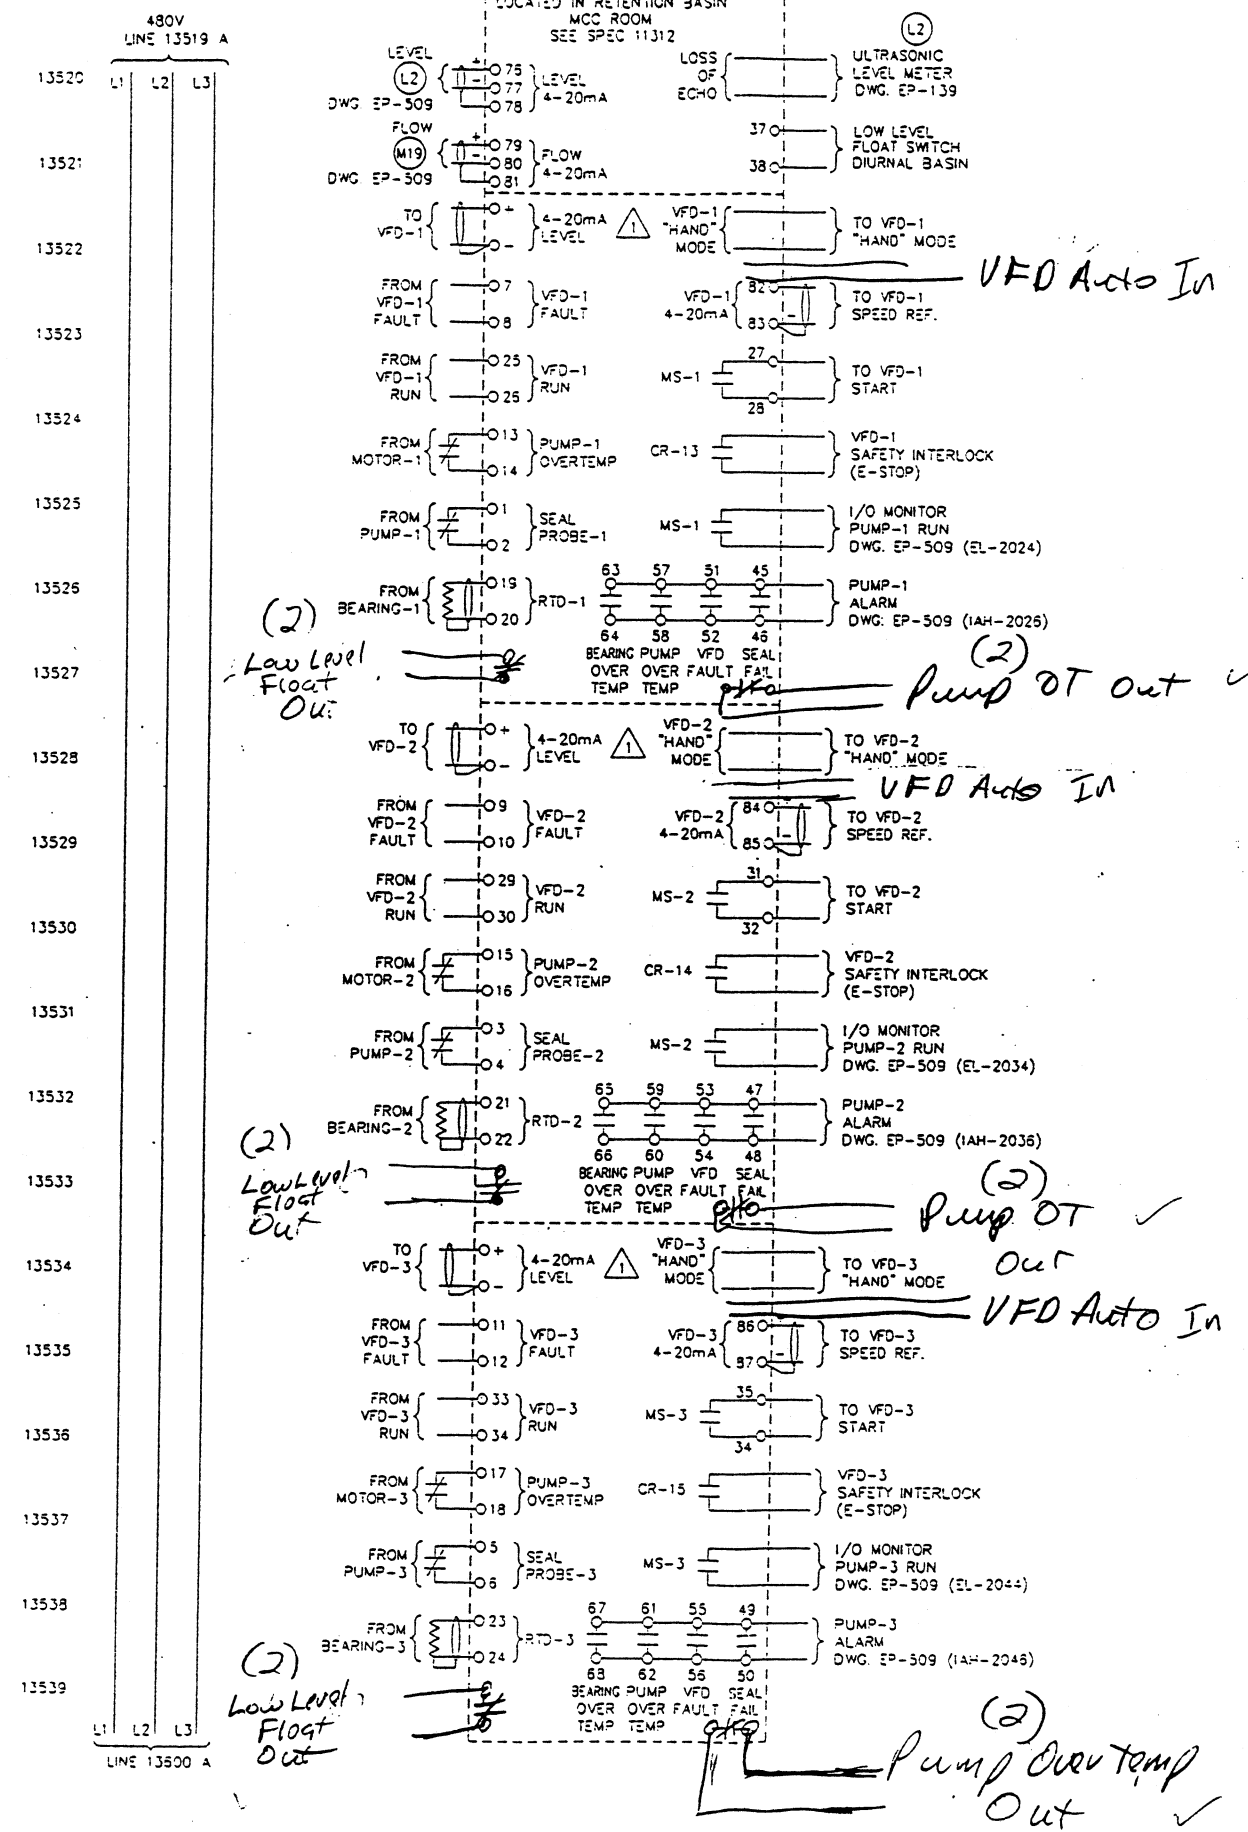


[illegible][illegible]

DESIGNED BY	STI/RRR
DRAWN BY	STI/RRR
CHECKED BY	STI/RJL
APPROVED BY	

ENCES

INC.
AND EARTH SCI
ON, OHIO
2000
1", MCC-1

ENVIRONMENTAL,
ENGINEERS IN WATER
TOWN, OHIO

0

1

JOB NO.
E9031
DATE

3/2/01
SCALE
N/A
SHEET
EP135-1