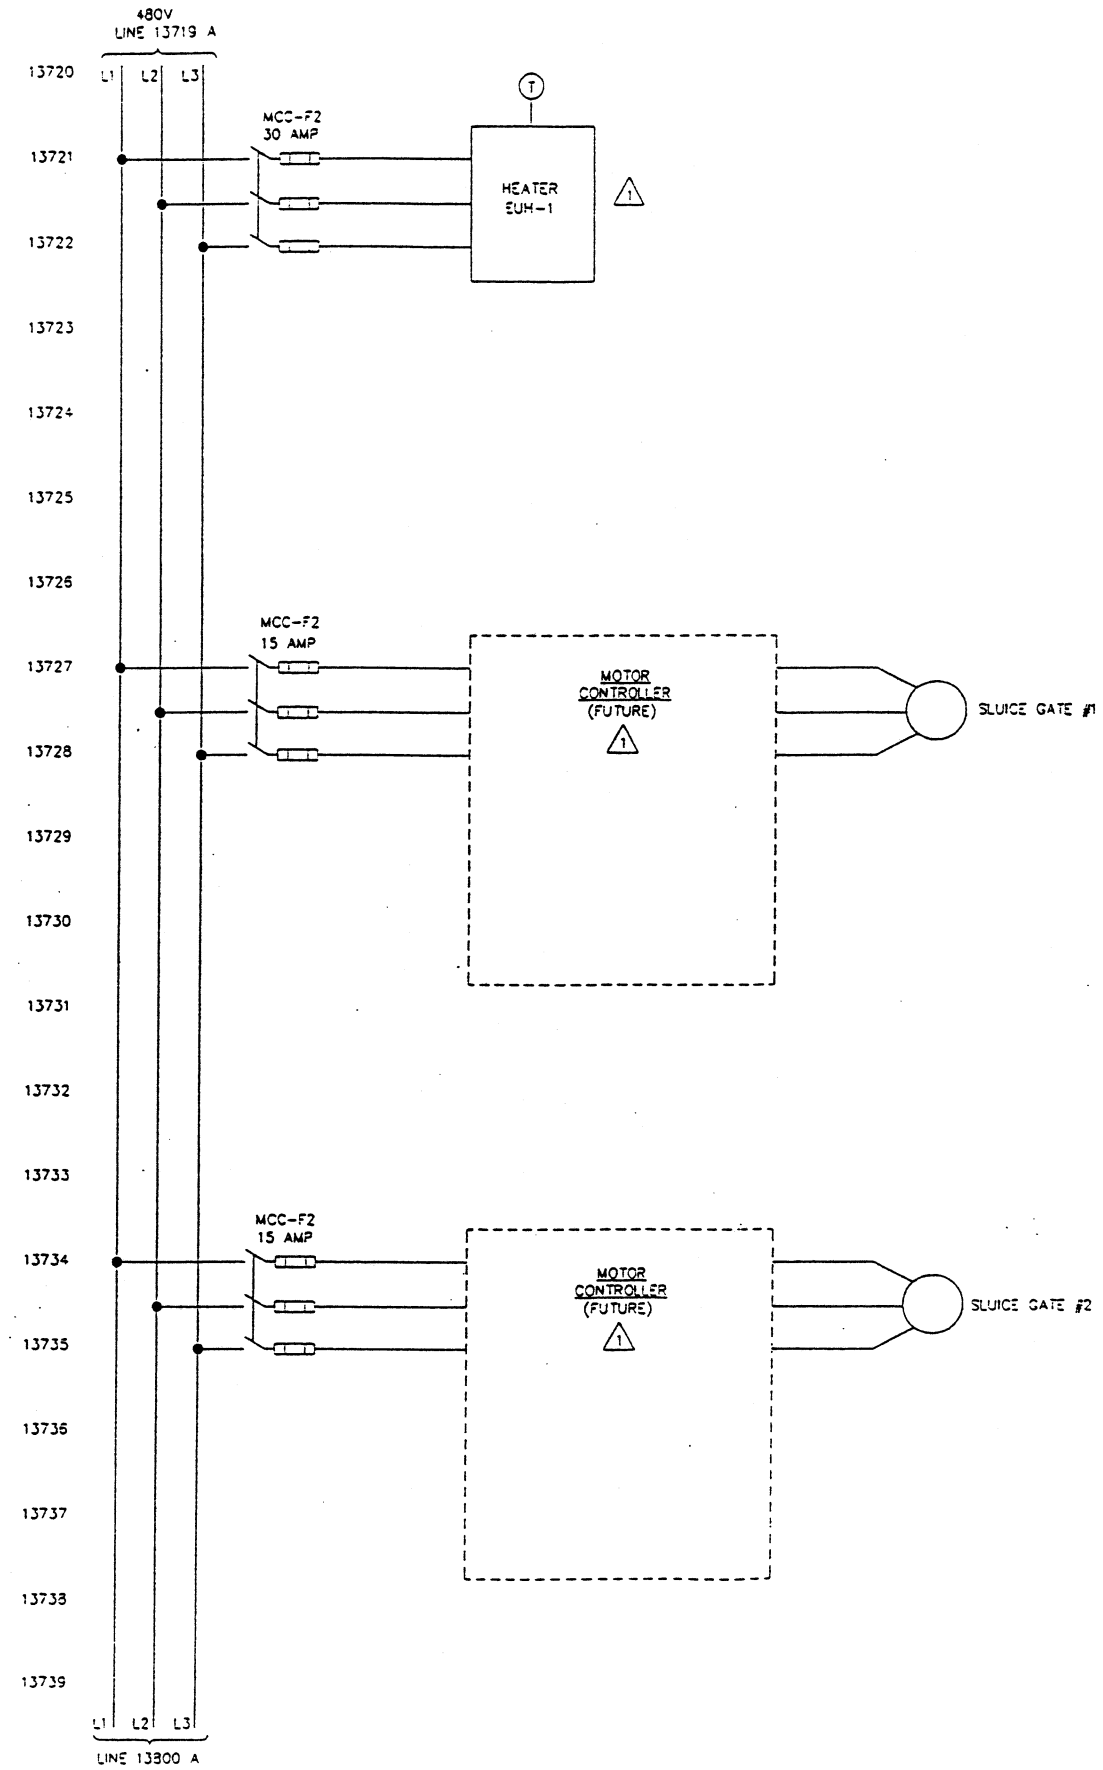
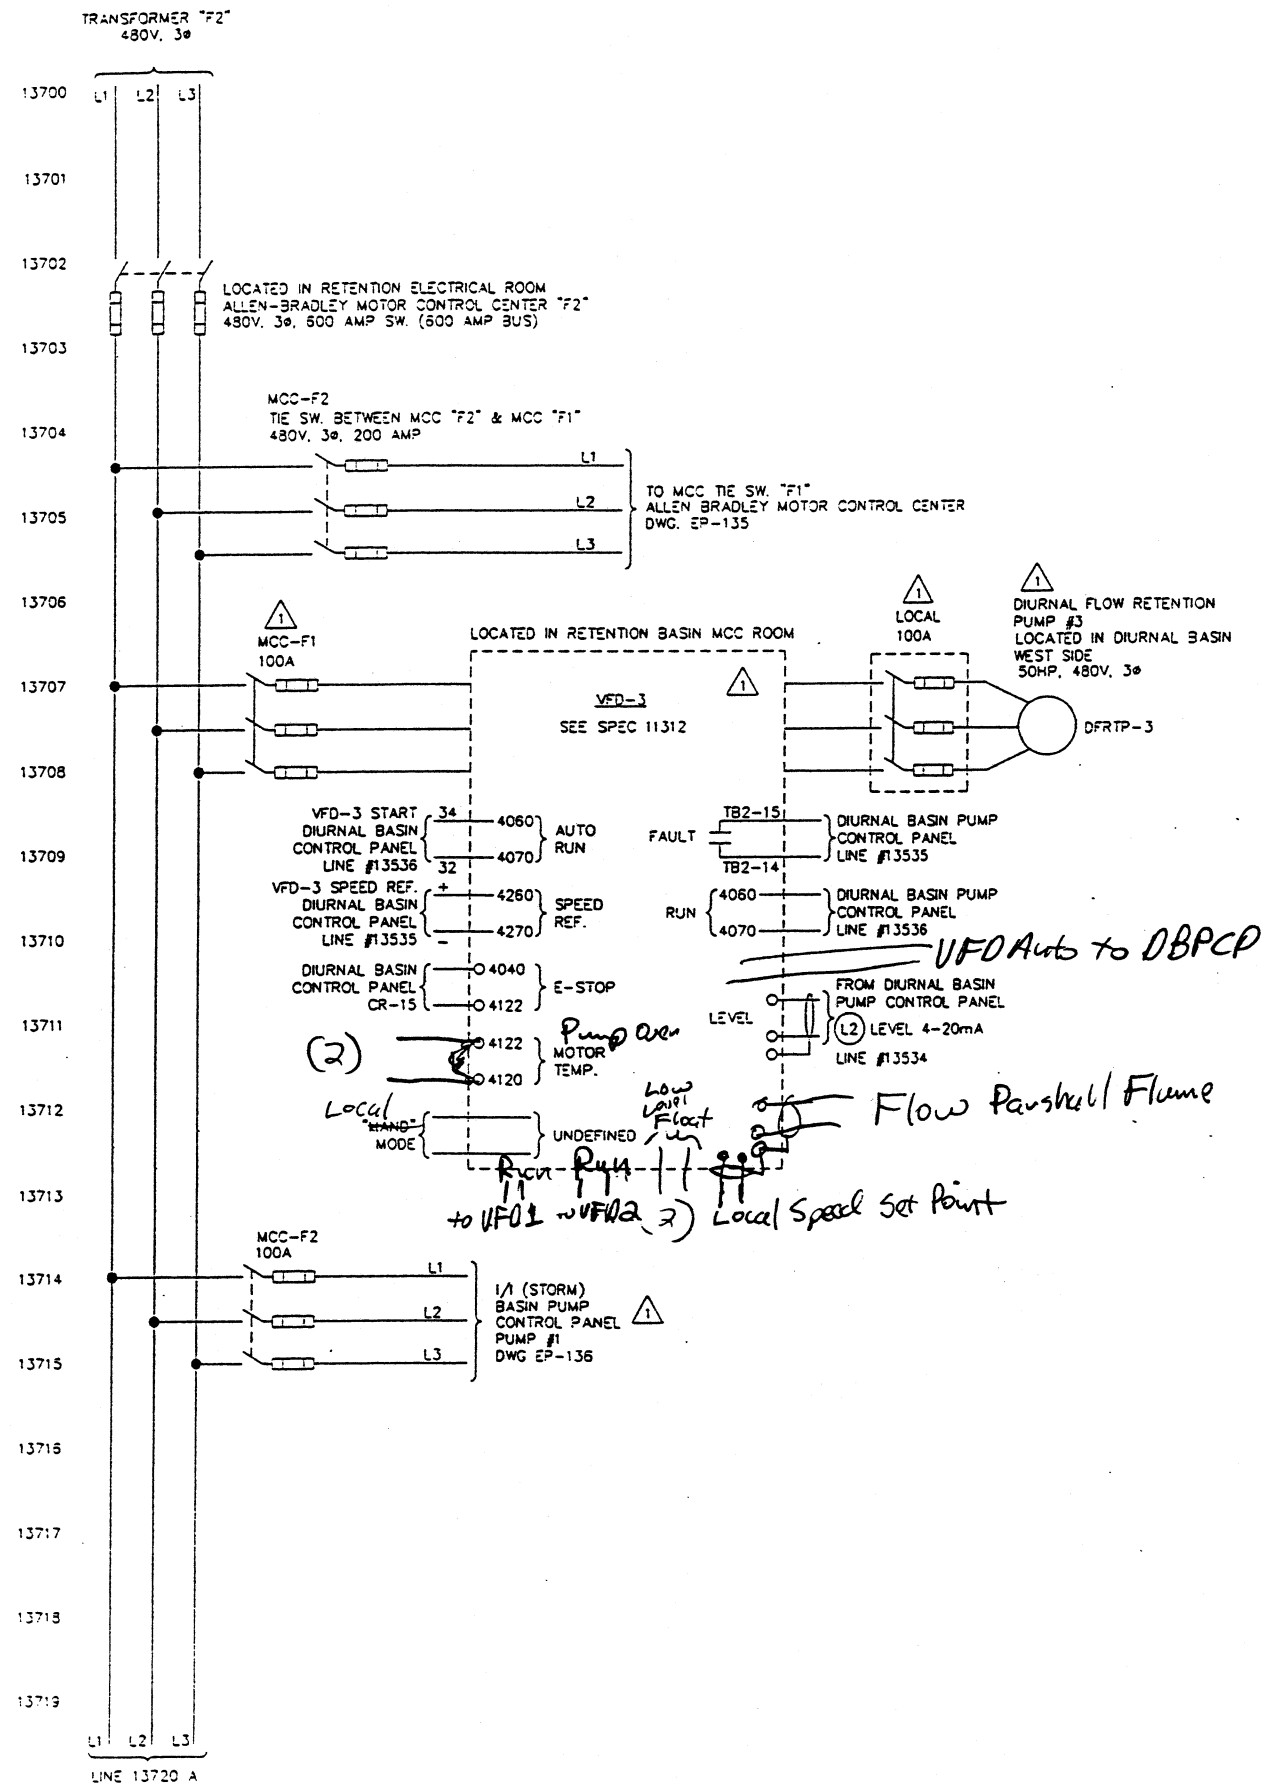


ENVIRONMENTAL, INC.
ENGINEERS IN WATER AND EARTH SCIENCES
UNIONTOWN, OHIO

CITY OF MASSILLON, OHIO
WWTP UPGRADE 2000
TRANSFORMER "F2", MCC-F2
RETENTION TANKS SCHEMATIC DIAGRAM

NO.	DESCRIPTIONS	REVISIONS		
		DATE	BY	APP'D
1	REVISED FOR CONSTRUCTION	MM/DD	CD	R/A

DESIGNED BY	STI/RRR
DRAWN BY	STI/RRR
CHECKED BY	STI/RL
APPROVED BY	STI/RL

JOB NO.	E9031
DATE	3/2/01
SCALE	N/A
SHEET	EPI37-1

9031 SCHE137.DWG