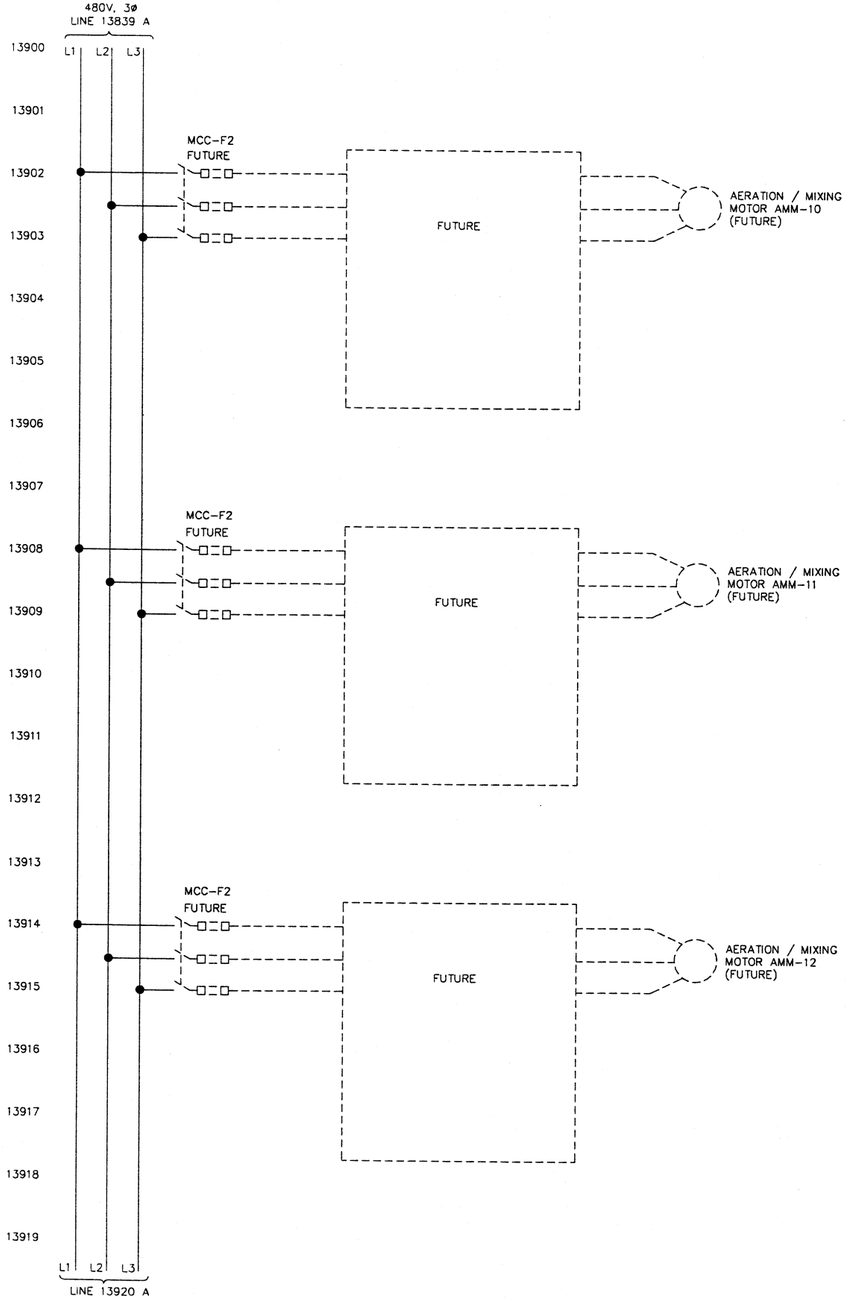

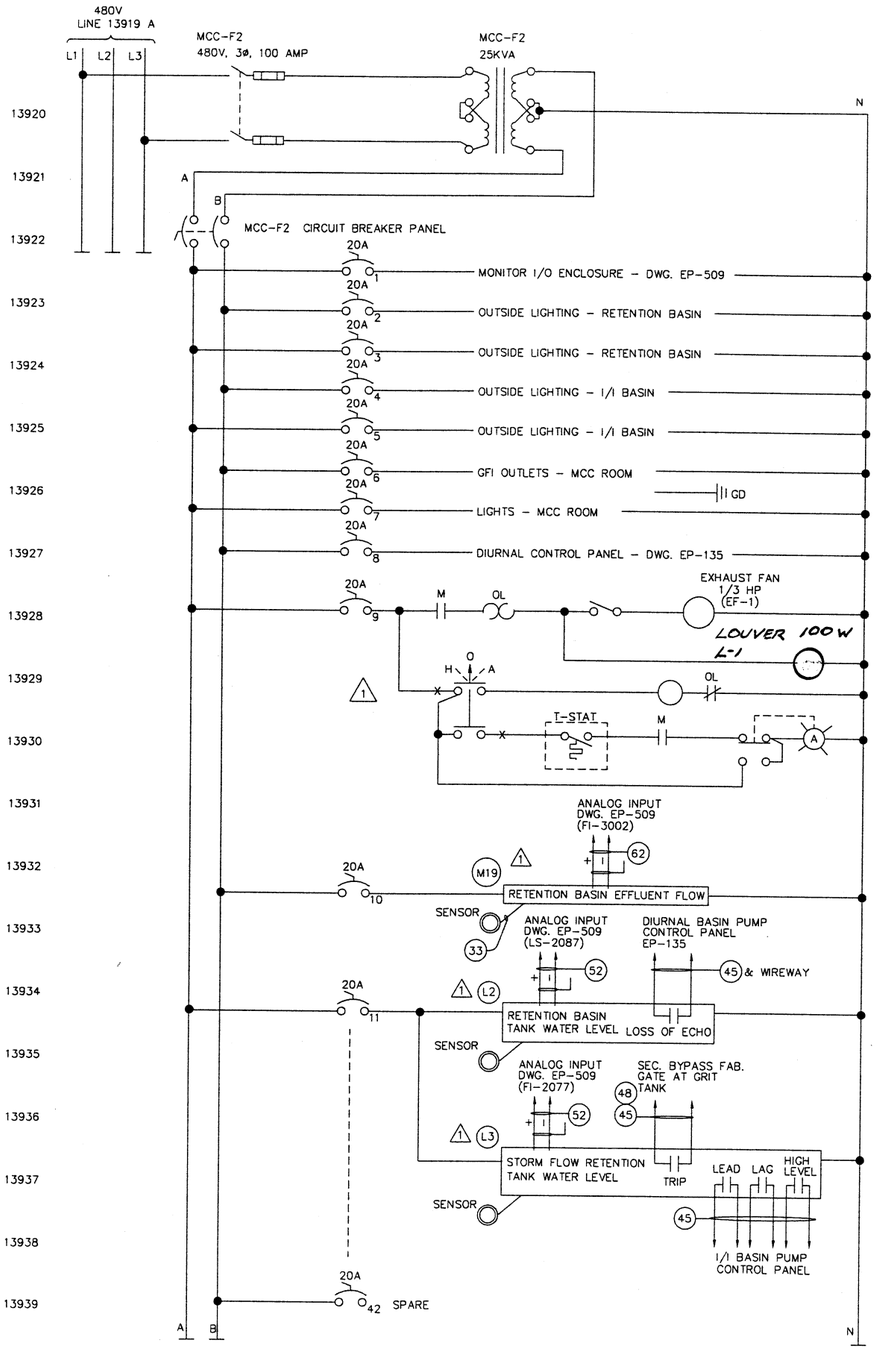

SEIBERT TECHNOLOGIES, INC.
MASSILLON, OHIO
as 5674 RJL

NO.	DESCRIPTIONS	DATE	BY	APP'D
1	REVISED FOR CONSTRUCTION	5/5/01	CD	RJL

REVISIONS

DESIGNED BY ST1/RKRR
DRAWN BY ST1/RKRR
CHECKED BY ST1/RJL
APPROVED BY ST1/RJL

ENVIRONMENTAL, INC.
ENGINEERS IN WATER AND EARTH SCIENCES
MIDDLEBURG, OHIO

CITY OF MASSILLON, OHIO
WWTP UPGRADE 2000
TRANSFORMER "F2", MCC-F2
AERATION / MIXING MOTORS & 120 VAC SCHEMATIC DIAGRAM

JOB NO. E9031
DATE 3/2/01
SCALE N/A
SHEET EP139-1

9031SCHE139.DWG