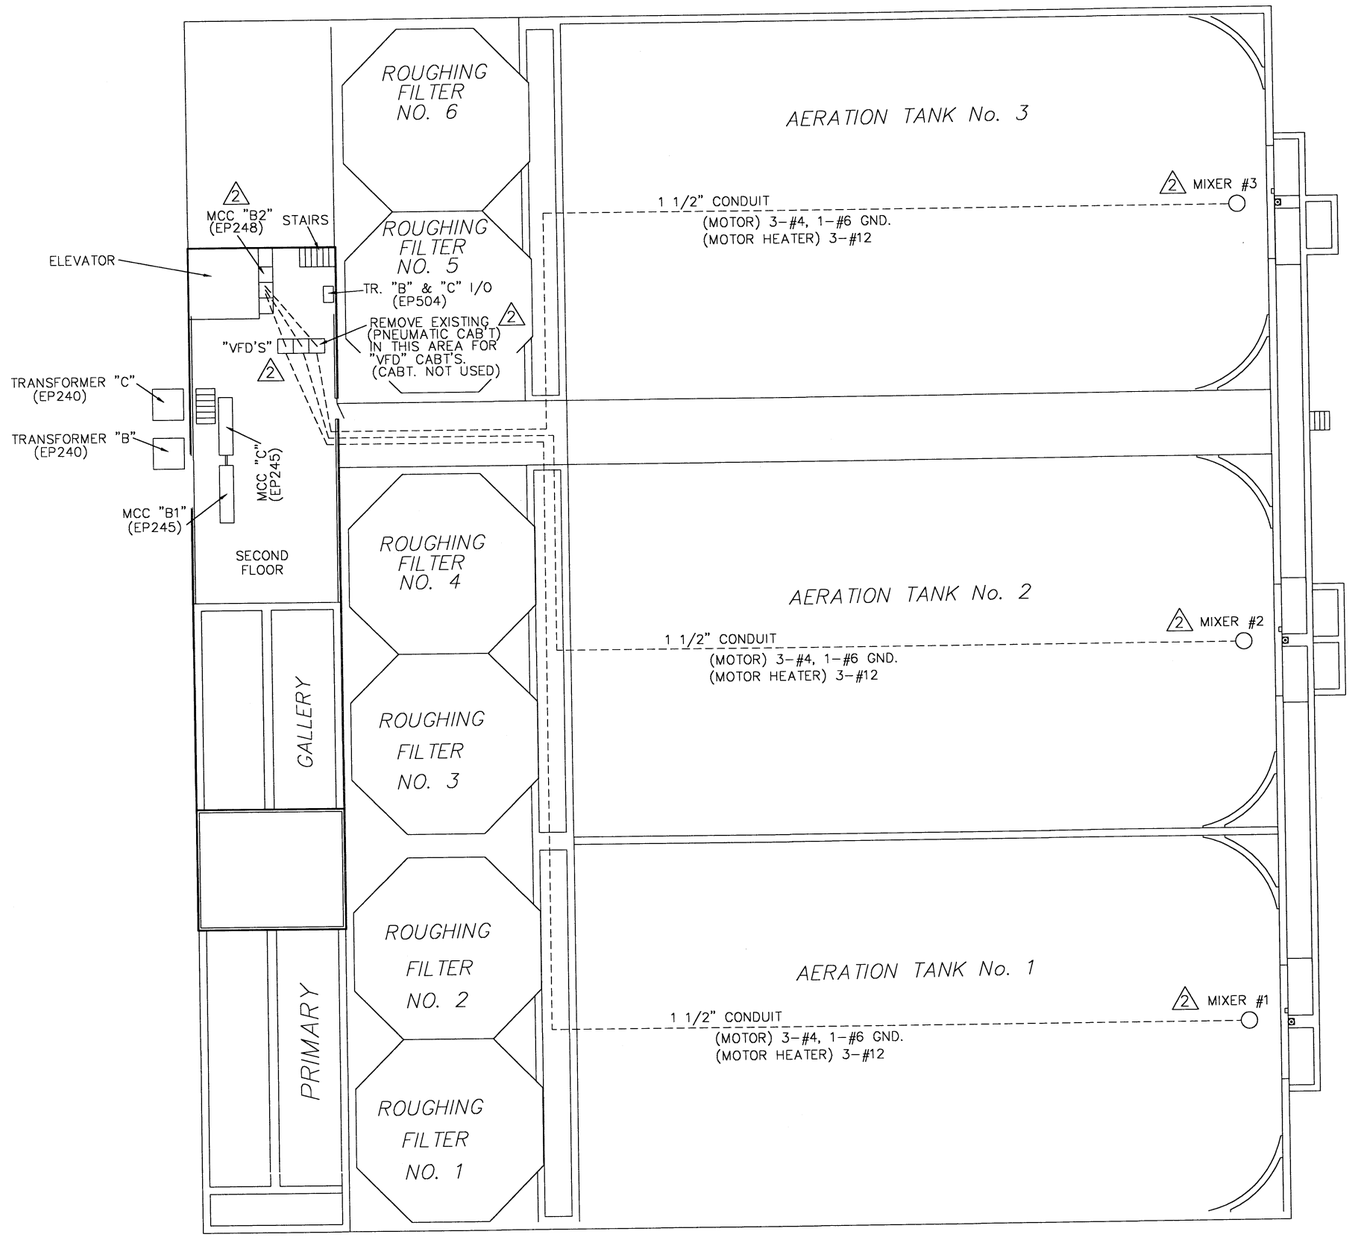

SEIFERT TECHNOLOGIES, INC.
MASSILLON, OHIO
JOB NO. 5674 DRAWN BY RJL

REVISIONS

NO.	DESCRIPTIONS	DATE	BY	APP'D
1	MARKED UP PRINTS	10/28/02	TSS	RJL
2	ADDED AERATION TANK MIXER VFD'S	3/21/03	TSS	RJL

DESIGNED BY RJL
DRAWN BY TSS
CHECKED BY TSS
APPROVED BY RJL

ENVIRONMENTAL, INC.
ENGINEERS IN WATER AND EARTH SCIENCES
UNIONTOWN, OHIO

CITY OF MASSILLON, OHIO
WWTP UPGRADE 2000
PRIMARY GALLERY BLDG.
PLAN VIEW OF AERATION TANK MIXER "VFD'S"

JOB NO. E9031
DATE 3/04/03
SCALE N/A
SHEET EP257-2

9031SPLE257.DWG.