


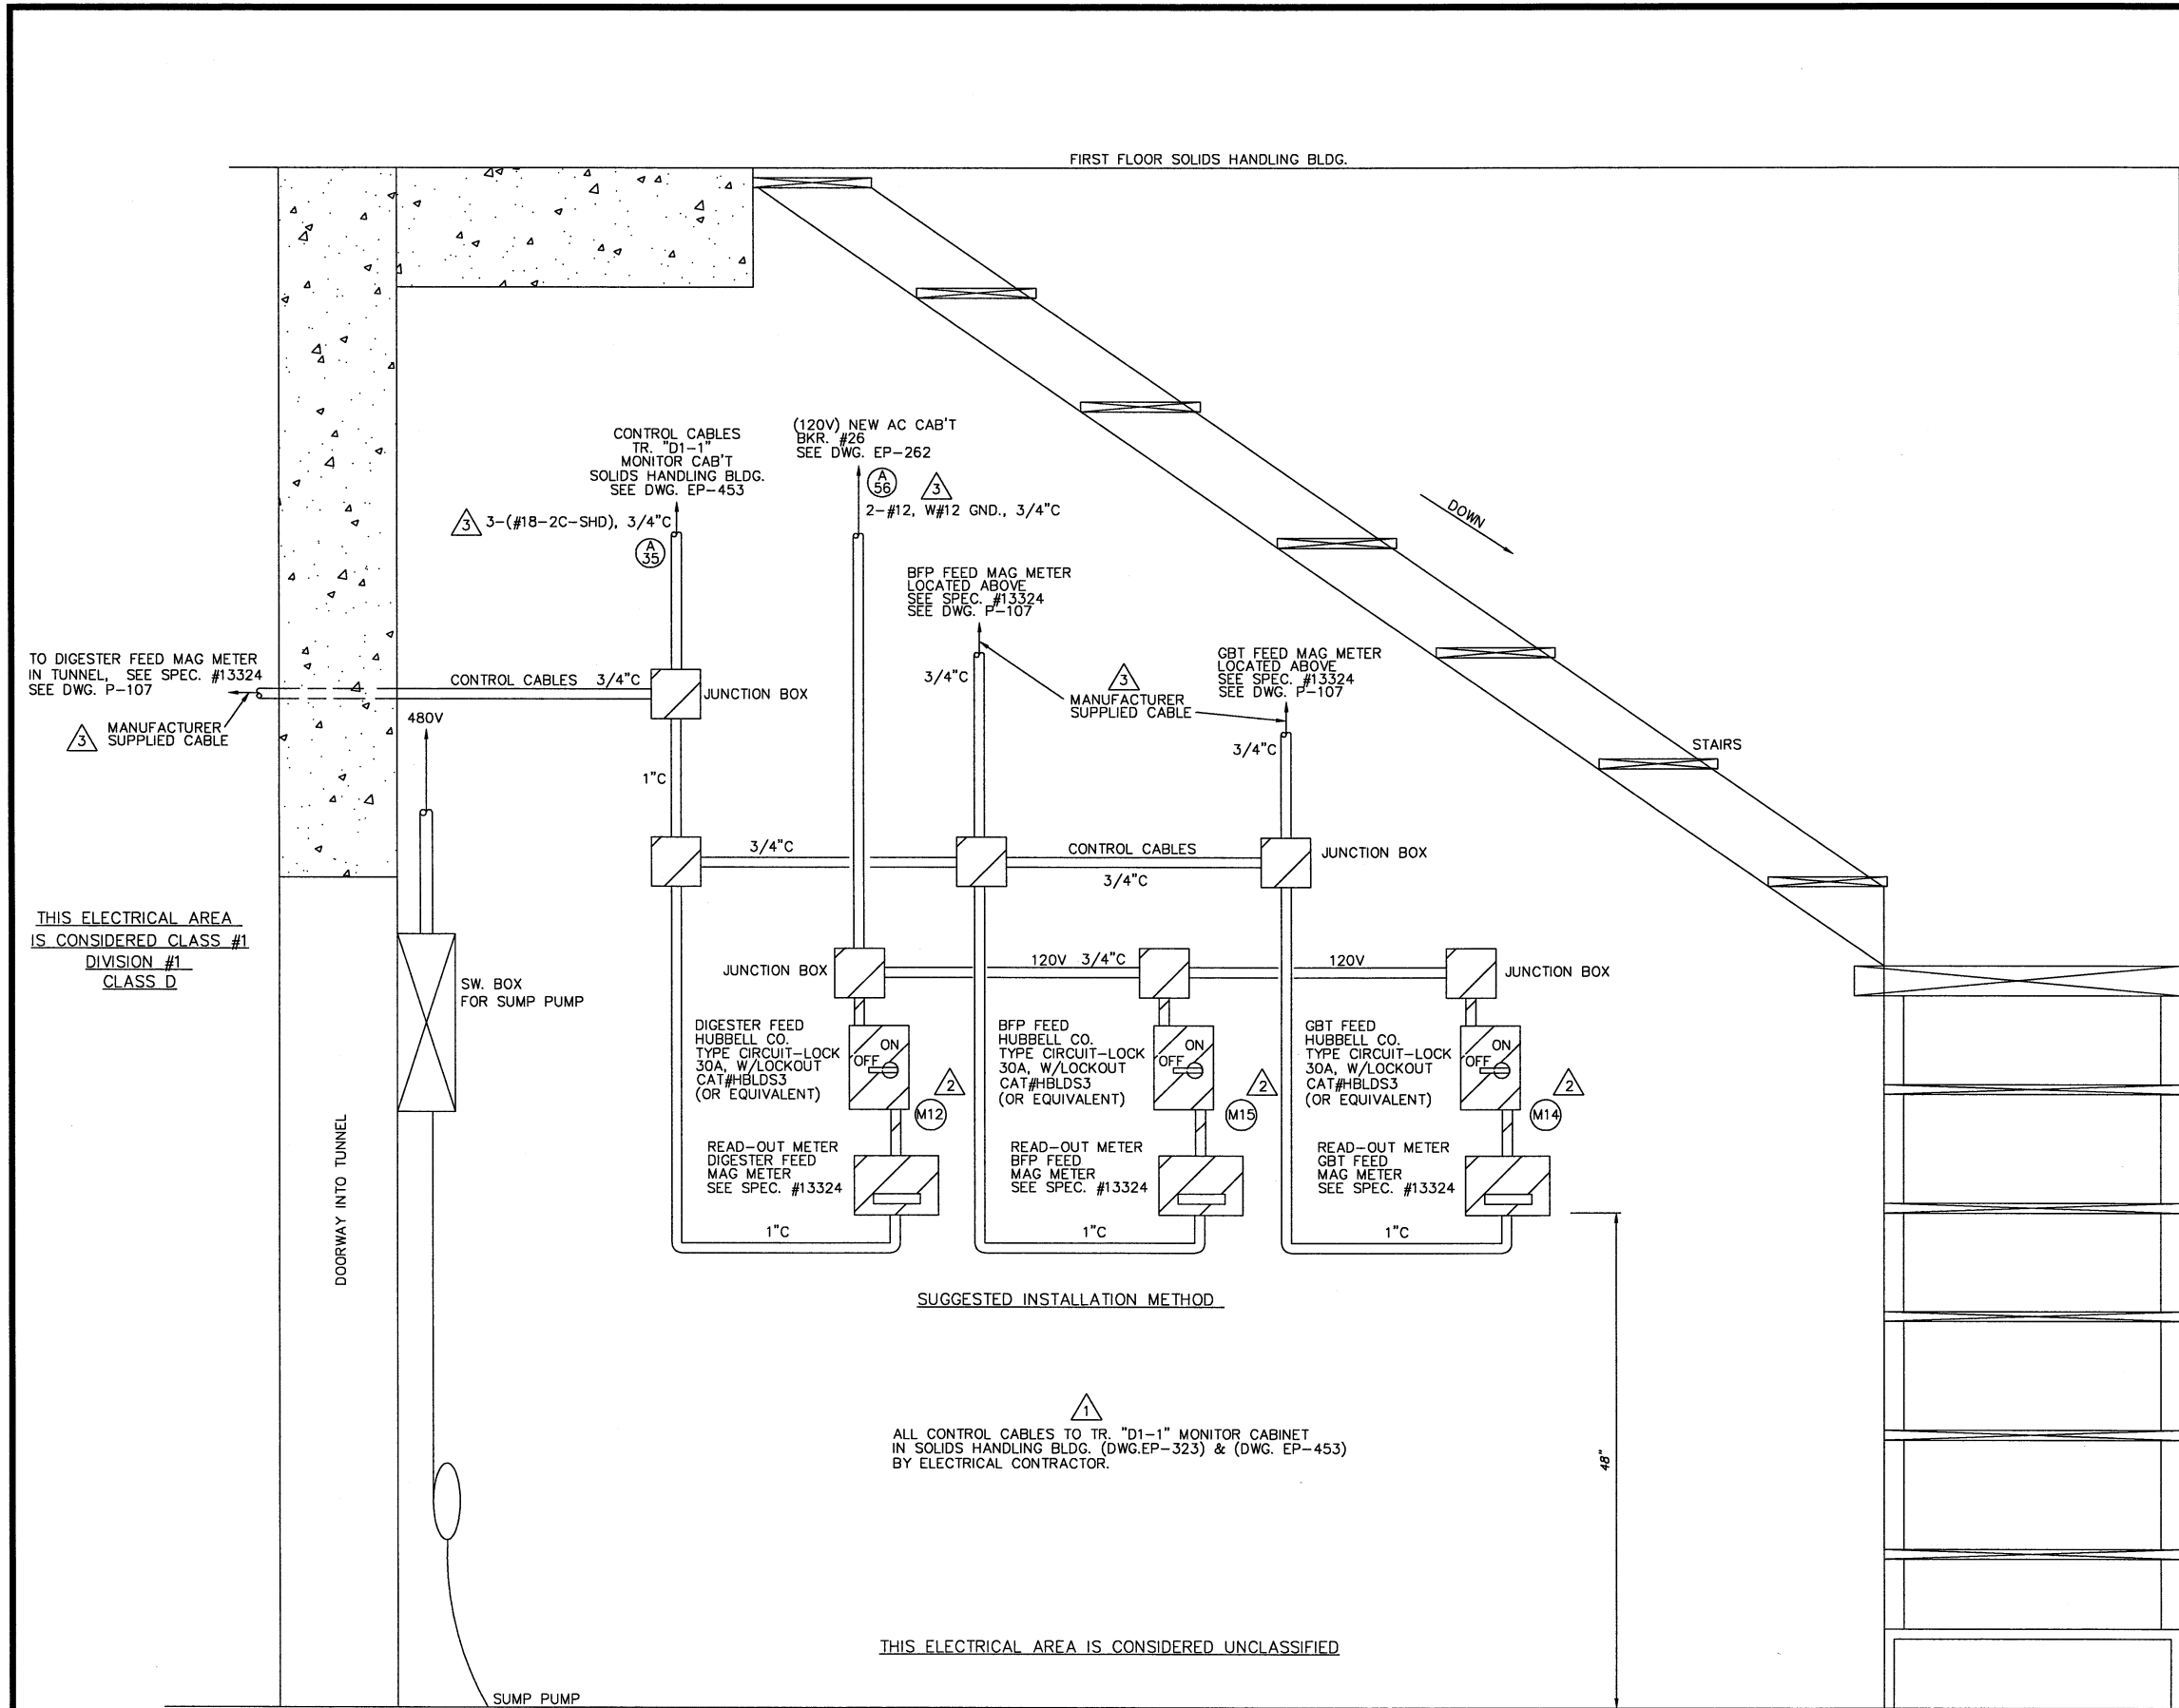

NOTES
1. ITEMS FOR ADDITION

STI TECHNOLOGIES, INC.
 MASSILLON, OHIO
 330 567-1100

ENVIRONMENTAL, INC.
 ENGINEERS IN WATER AND EARTH SCIENCES
 UNICHTOWN, OHIO

CITY OF MASSILLON, OHIO
 WWTU UPGRADE 2000
 TRANSFORMER "D1", MAG METERS & SUMP PUMP
 BOTTOM OF STAIRS INTO TUNNEL, SOLIDS HANDLING BLDG.

DESIGNED BY
 STI/TSS

DRAWN BY
 STI/TSS

CHECKED BY
 STI/TSS

APPROVED BY
 STI/R/L

NO.
 1
 2
 3

DESCRIPTIONS
 1 ADDED CONTROL CABLE NOTE
 2 REVISED AS PER CONSTRUCTION
 3 ADDED CONDUIT AND CABLE SIZES/NOTES

DATE
 9/00/01
 10/01/01
 5/11/01

BY
 R/L
 LMC
 TSS

JOB NO.
 E9031

DATE
 5/11/01

SCALE
 1 1/2" = 12"

SHEET
 EP275-3