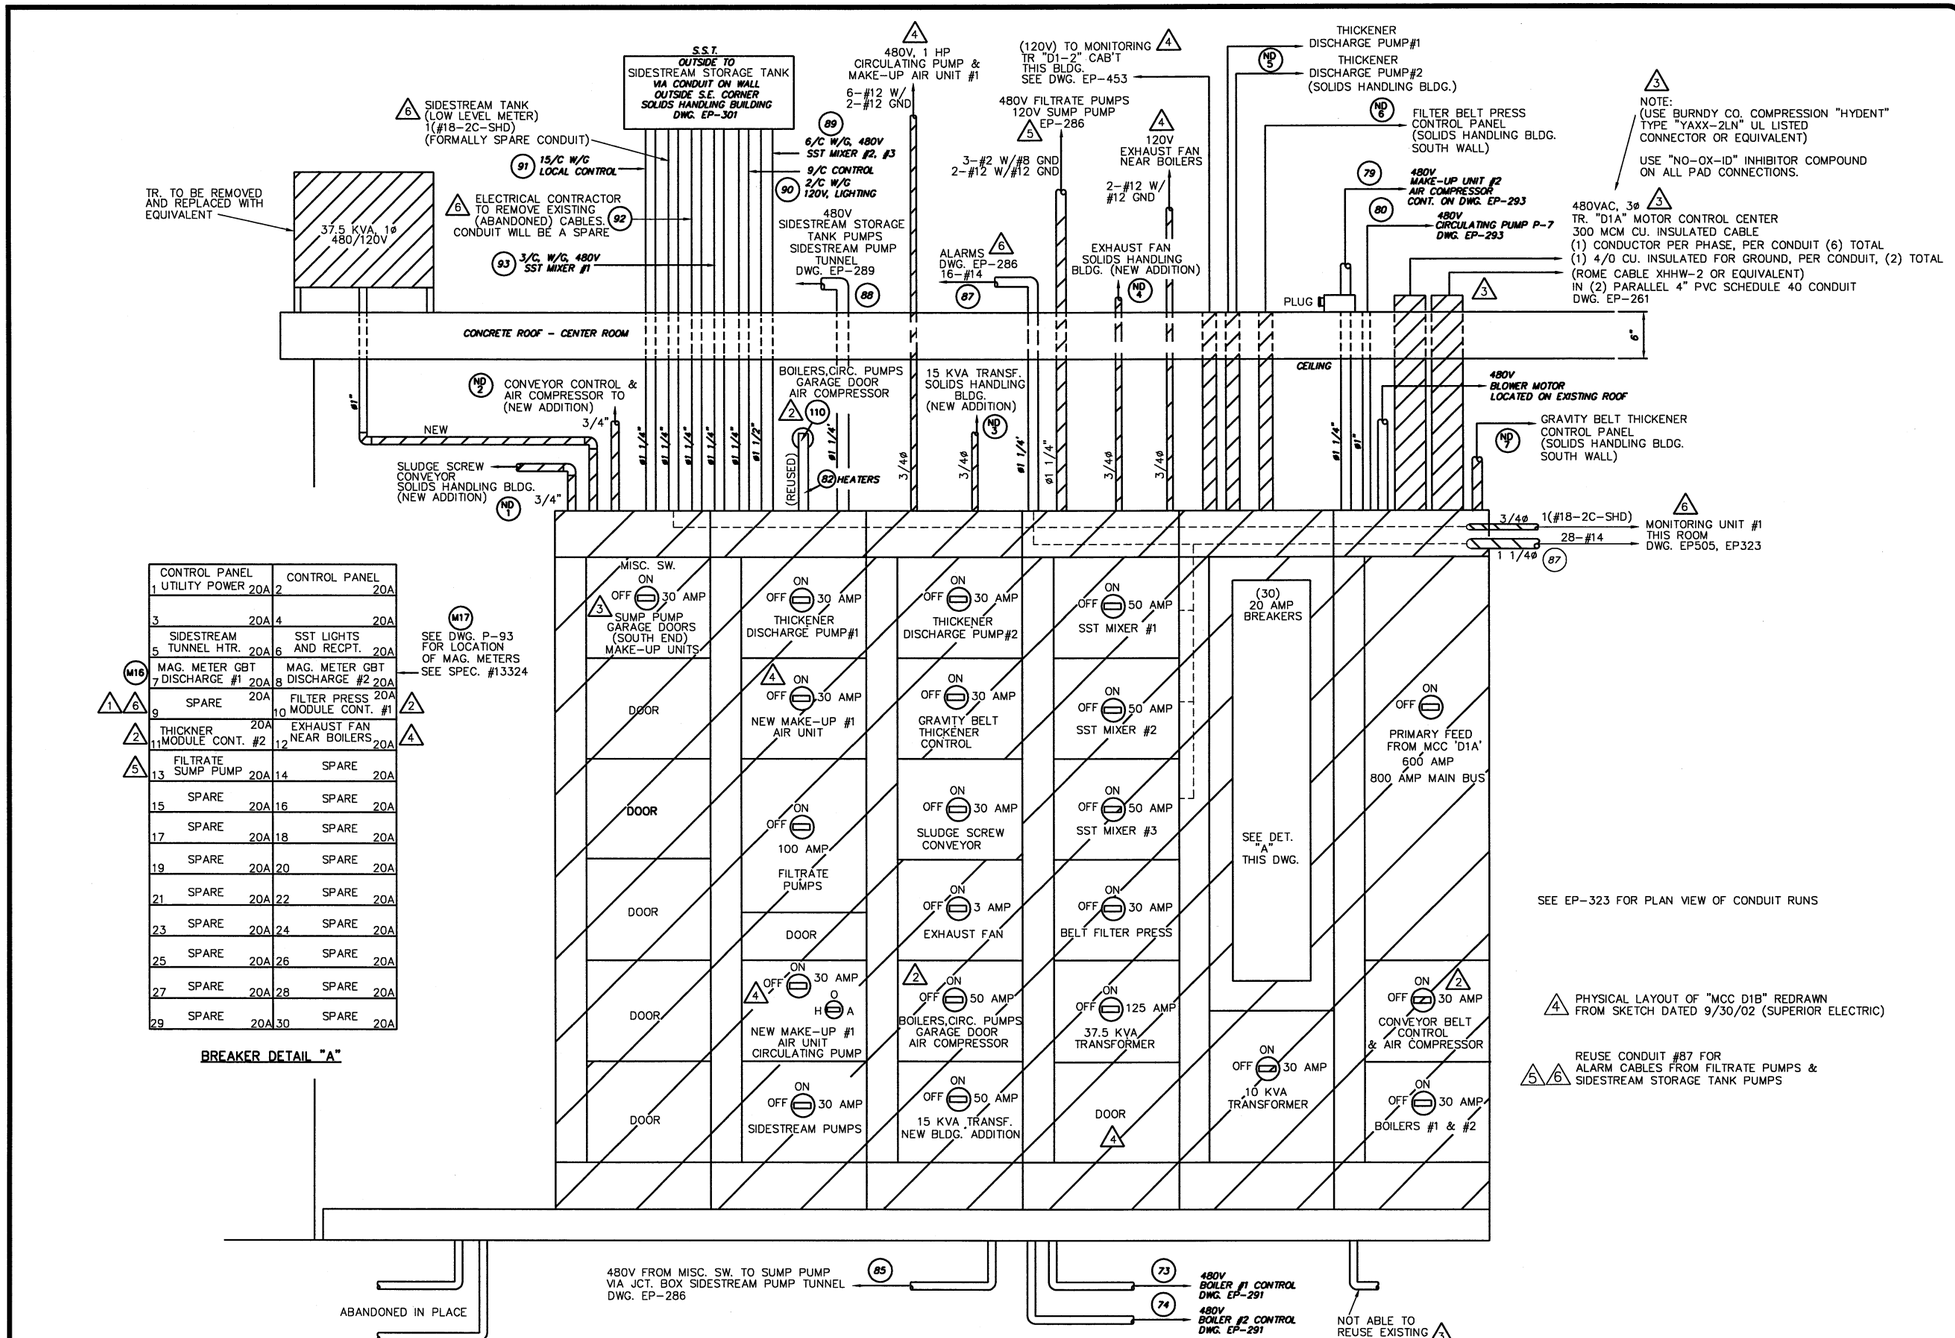

CONTROL PANEL UTILITY POWER	20A	CONTROL PANEL	20A
	20A		20A
SIDESTREAM TUNNEL HTR.	20A	SST LIGHTS AND RECPT.	20A
MAG. METER GBT DISCHARGE #1	20A	MAG. METER GBT DISCHARGE #2	20A
SPARE	20A	FILTER PRESS MODULE CONT. #1	20A
THICKNER MODULE CONT. #2	20A	EXHAUST FAN NEAR BOILERS	20A
FILTRATE SUMP PUMP	20A	SPARE	20A
SPARE	20A	SPARE	20A
SPARE	20A	SPARE	20A
SPARE	20A	SPARE	20A
SPARE	20A	SPARE	20A
SPARE	20A	SPARE	20A
SPARE	20A	SPARE	20A
SPARE	20A	SPARE	20A
SPARE	20A	SPARE	20A

M16 — M17 SEE DWG. P-93 FOR LOCATION OF MAG. METERS SEE SPEC. #13324

BREAKER DETAIL "A"

ALLEN BRADLEY MOTOR CONTROL CENTER "D1B"
LOCATED CENTER ROOM SOLIDS HANDLING BLDG

SEIFERT TECHNOLOGIES, INC.
MASSILLON, OHIO
R.J.L.

REVISIONS			
NO.	DESCRIPTIONS	DATE	BY	APP'D
1	CHANGED DWG. NO. A.C. CABT.	9/30/01	TSS	RJL
2	REVISED AS PER CONSTRUCTION	9/24/02	TSS	RJL
3	REVISED AS PER CONSTRUCTION	10/9/02	TSS	RJL
4	REVISED PER NEW CONSTRUCTION	10/29/02	TSS	RJL
5	REVISED AS PER CONSTRUCTION	11/11/02	JDH	RJL
6	REVISED FOR CONSTRUCTION	1/09/03	TSS	RJL

DESIGNED BY STI/TSS
DRAWN BY STI/TSS
CHECKED BY STI/TSS
APPROVED BY STI/RJL

ENVIRONMENTAL, INC.
ENGINEERS IN WATER AND EARTH SCIENCES
UNIONTOWN, OHIO

CITY OF MASSILLON, OHIO
WWTP UPGRADE 2000
TRANSFORMER "D1" MOTOR CONTROL CENTER "D1B"
SOLIDS HANDLING BLDG. – MCC LAYOUT

JOB NO. E9031
DATE 05/16/01
SCALE 1 1/2" = 12"
SHEET EP281-6

9031SPLE281.DWG