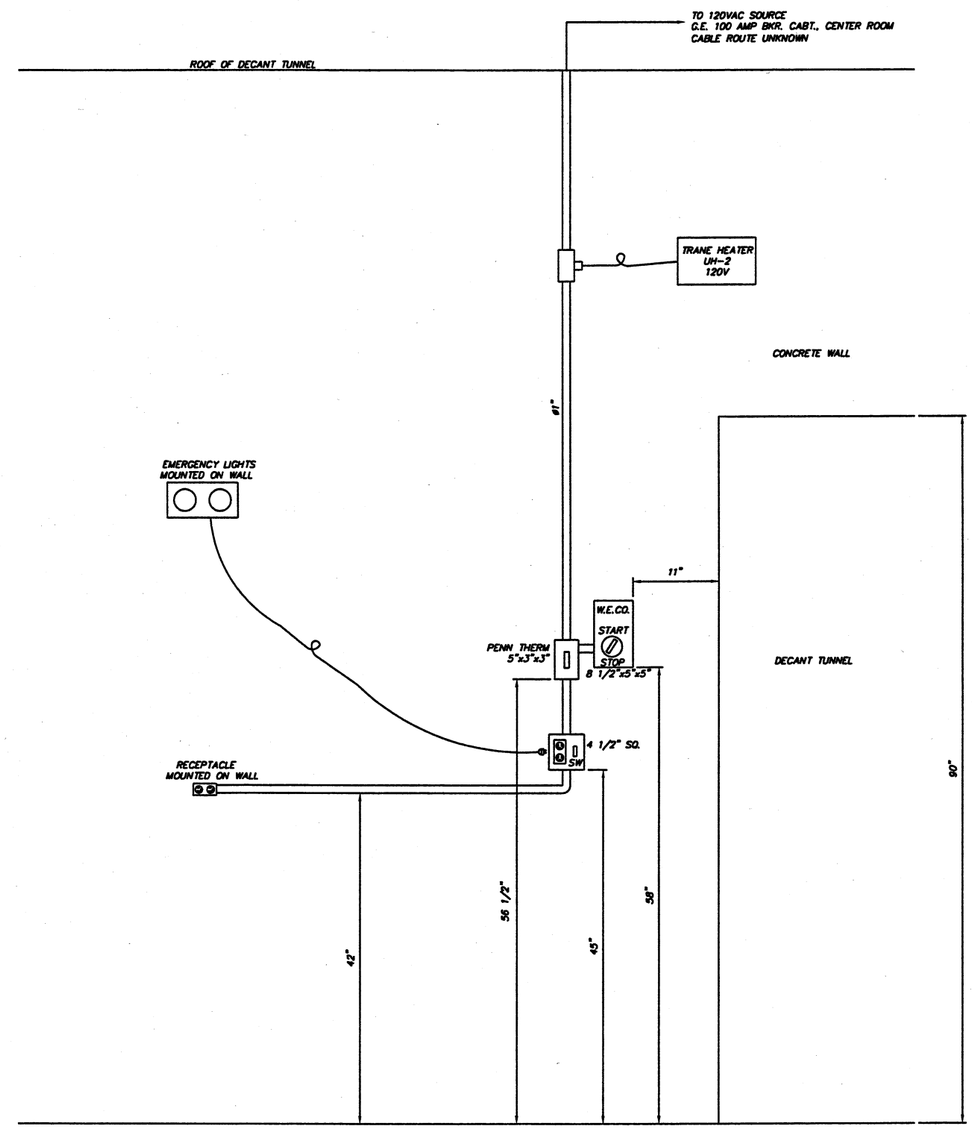


LOCATED AT END OF DECANT TUNNEL
SOLIDS HANDLING BUILDING

JEFFERS TECHNOLOGIES, INC.
MASSILLON, OHIO
#5674 DWG R.J.L.

| REVISIONS | | | |
|---|---|---|---|
| NO. | DESCRIPTIONS | DATE | BY | APP'D |

DESIGNED BY STI/TSS
DRAWN BY STI/RRR
CHECKED BY STI/TSS
APPROVED BY STI/RJL

CTI ENVIRONMENTAL, INC.
ENGINEERS IN WATER AND EARTH SCIENCES
UNIONTOWN, OHIO

CITY OF MASSILLON, OHIO
WWTP UPGRADE 2000
SOLIDS HANDLING BUILDING
LOCATED AT END OF DECANT TUNNEL

JOB NO. E9031
DATE 10/16/00
SCALE 1 1/2" = 12"
SHEET EP287

9031SPLE287.DWG

W:\ACAD14\CTI Envi\5674\Completed Dwgs\200-299\9031SPLE287.dwg Thu Aug 09 16:35:34 2001