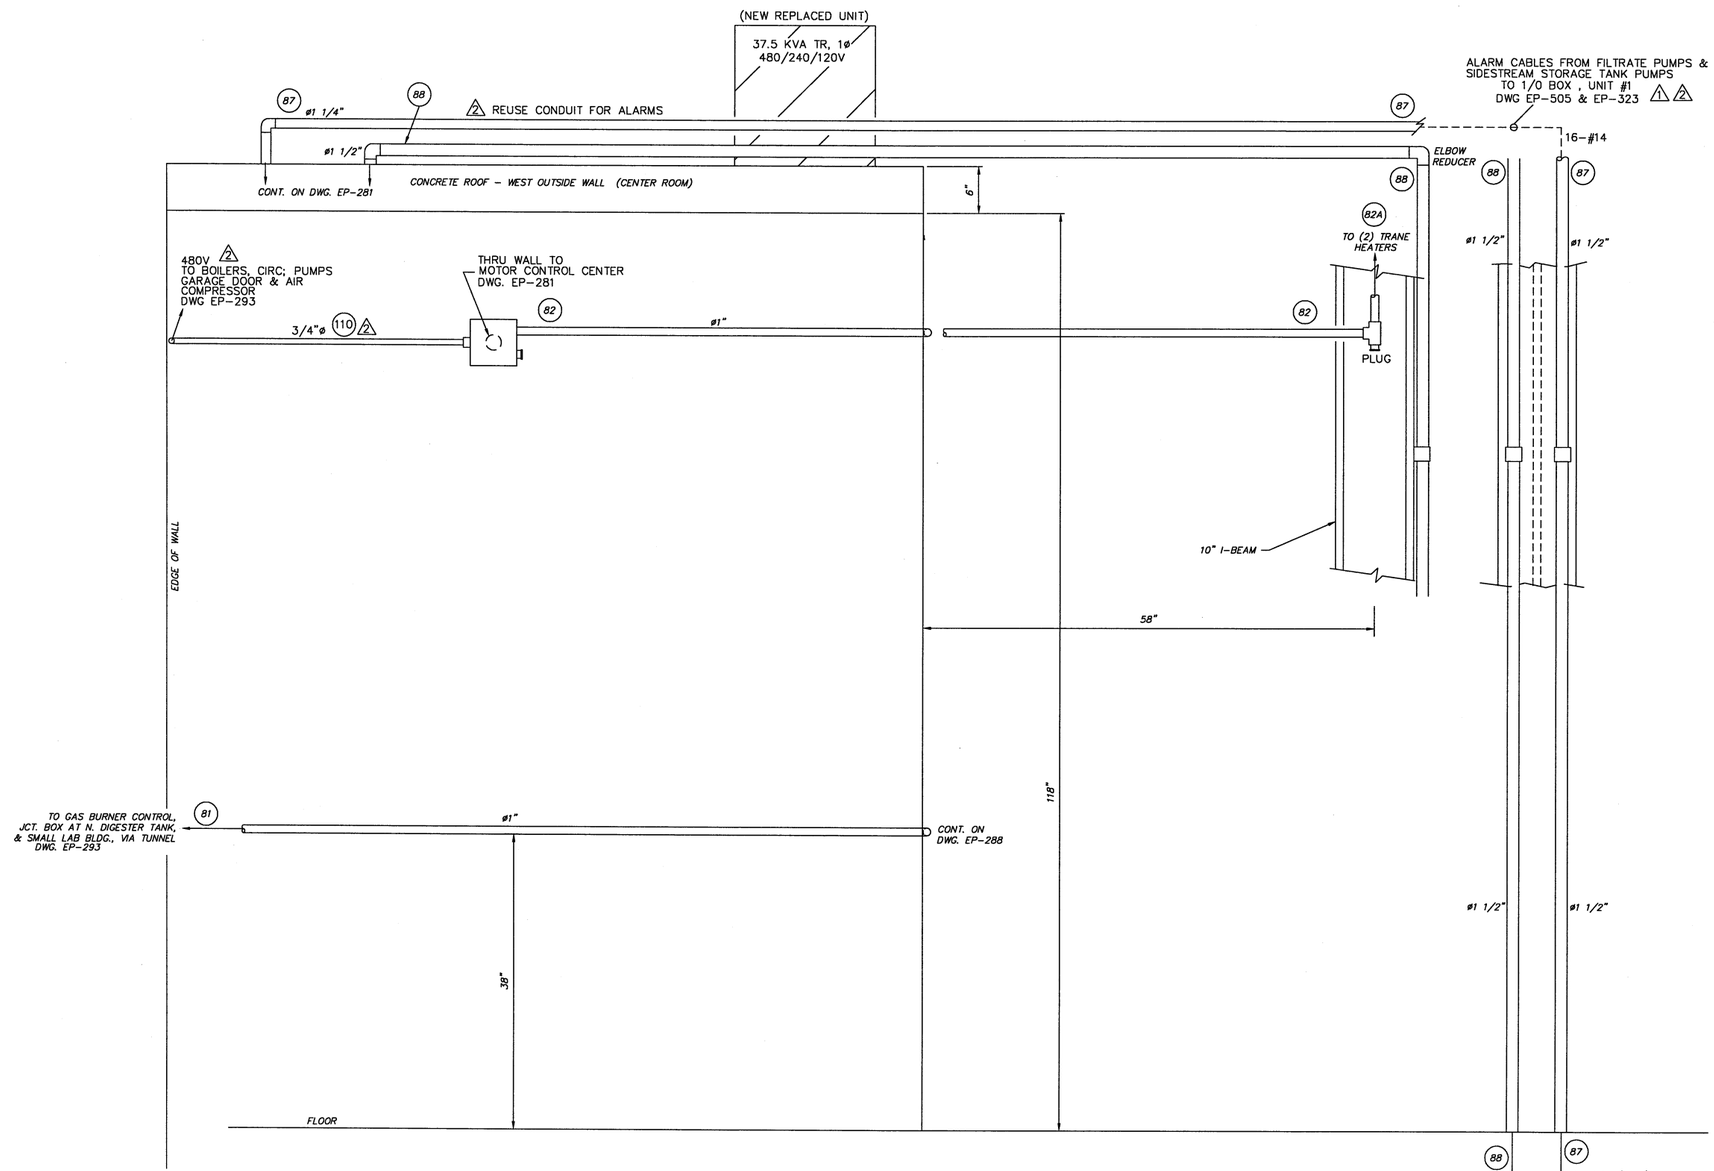

CENTER ROOM SOLIDS HANDLING BLDG.
WEST WALL

NOTE
1. ITEMS FOR ADDITION

SEIFERT TECHNOLOGIES, INC.
MASSILLON, OHIO
JOB No. 5674 PROJECT NO. R-JL

REVISIONS				
NO.	DESCRIPTIONS	DATE	BY	APP'D
1	REVISED AS PER CONSTUCTION	11/13/02	JDH	RJL
2	REVISED FOR CONSTUCTION	7/14/03	TSS	RJL

DESIGNED BY STI/TSS
DRAWN BY STI/TSS
CHECKED BY STI/TSS
APPROVED BY STI/RJL

ENVIRONMENTAL, INC.
ENGINEERS IN WATER AND EARTH SCIENCES
UNIONTOWN, OHIO

CITY OF MASSILLON, OHIO
WWTP UPGRADE 2000
TRANSFORMER "D1", CENTER ROOM, WEST WALL LAYOUT
SOLIDS HANDLING BLDG.

JOB NO. E9031
DATE 2/16/01
SCALE 1 1/2" = 12"
SHEET EP289-2

9031SPLE289.DWG