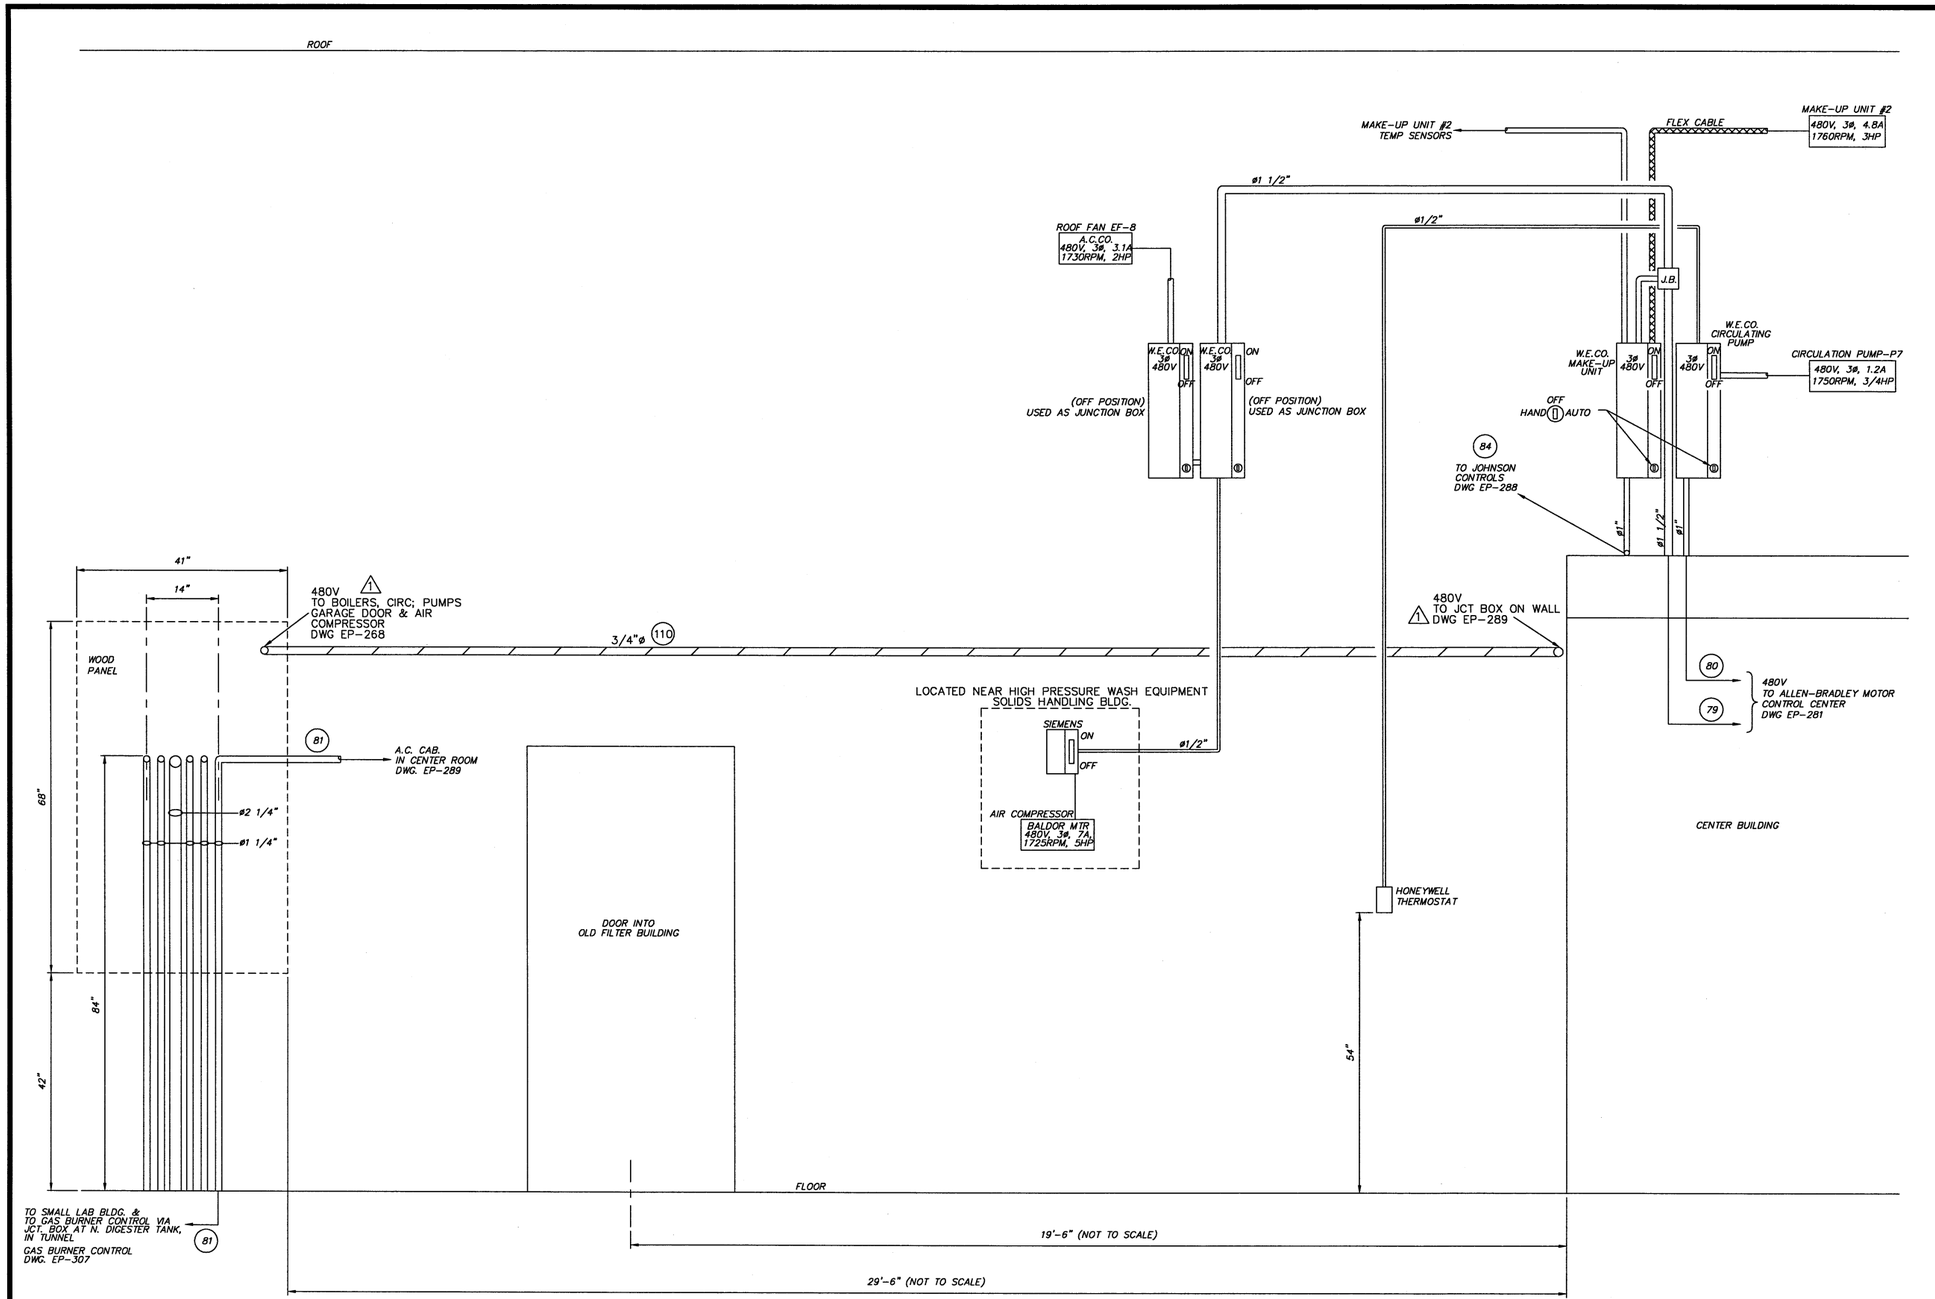

LOCATED IN SOLIDS HANDLING BLDG.
LOOKING AT SOUTH MIDDLE WALL

1 NOTE
1. ITEMS FOR ADDITION

SUPPORT TECHNOLOGIES, INC.
MASSILLON, OHIO
JOB NO. 3674 DRAWN BY RJL

REVISIONS				
NO.	DESCRIPTIONS	DATE	BY	APP'D
1	REVISED PER CONSTRUCTION	7/14/00	TSS	RJL

DESIGNED BY STI/TSS
DRAWN BY STI/RRR
CHECKED BY STI/TSS
APPROVED BY STI/RJL

ENVIRONMENTAL, INC.
ENGINEERS WATER AND EARTH SCIENCES
UNIONTOWN, OHIO

CITY OF MASSILLON, OHIO
WWTP UPGRADE 2000
TR "D1", CIRCULATING PUMP, MAKE-UP UNIT, AIR COMP LAYOUT
SOLIDS HANDLING BLDG.

JOB NO. E9031
DATE 02/16/01
SCALE 1"=1'
SHEET EP293-1

9031SPLE293.DWG