


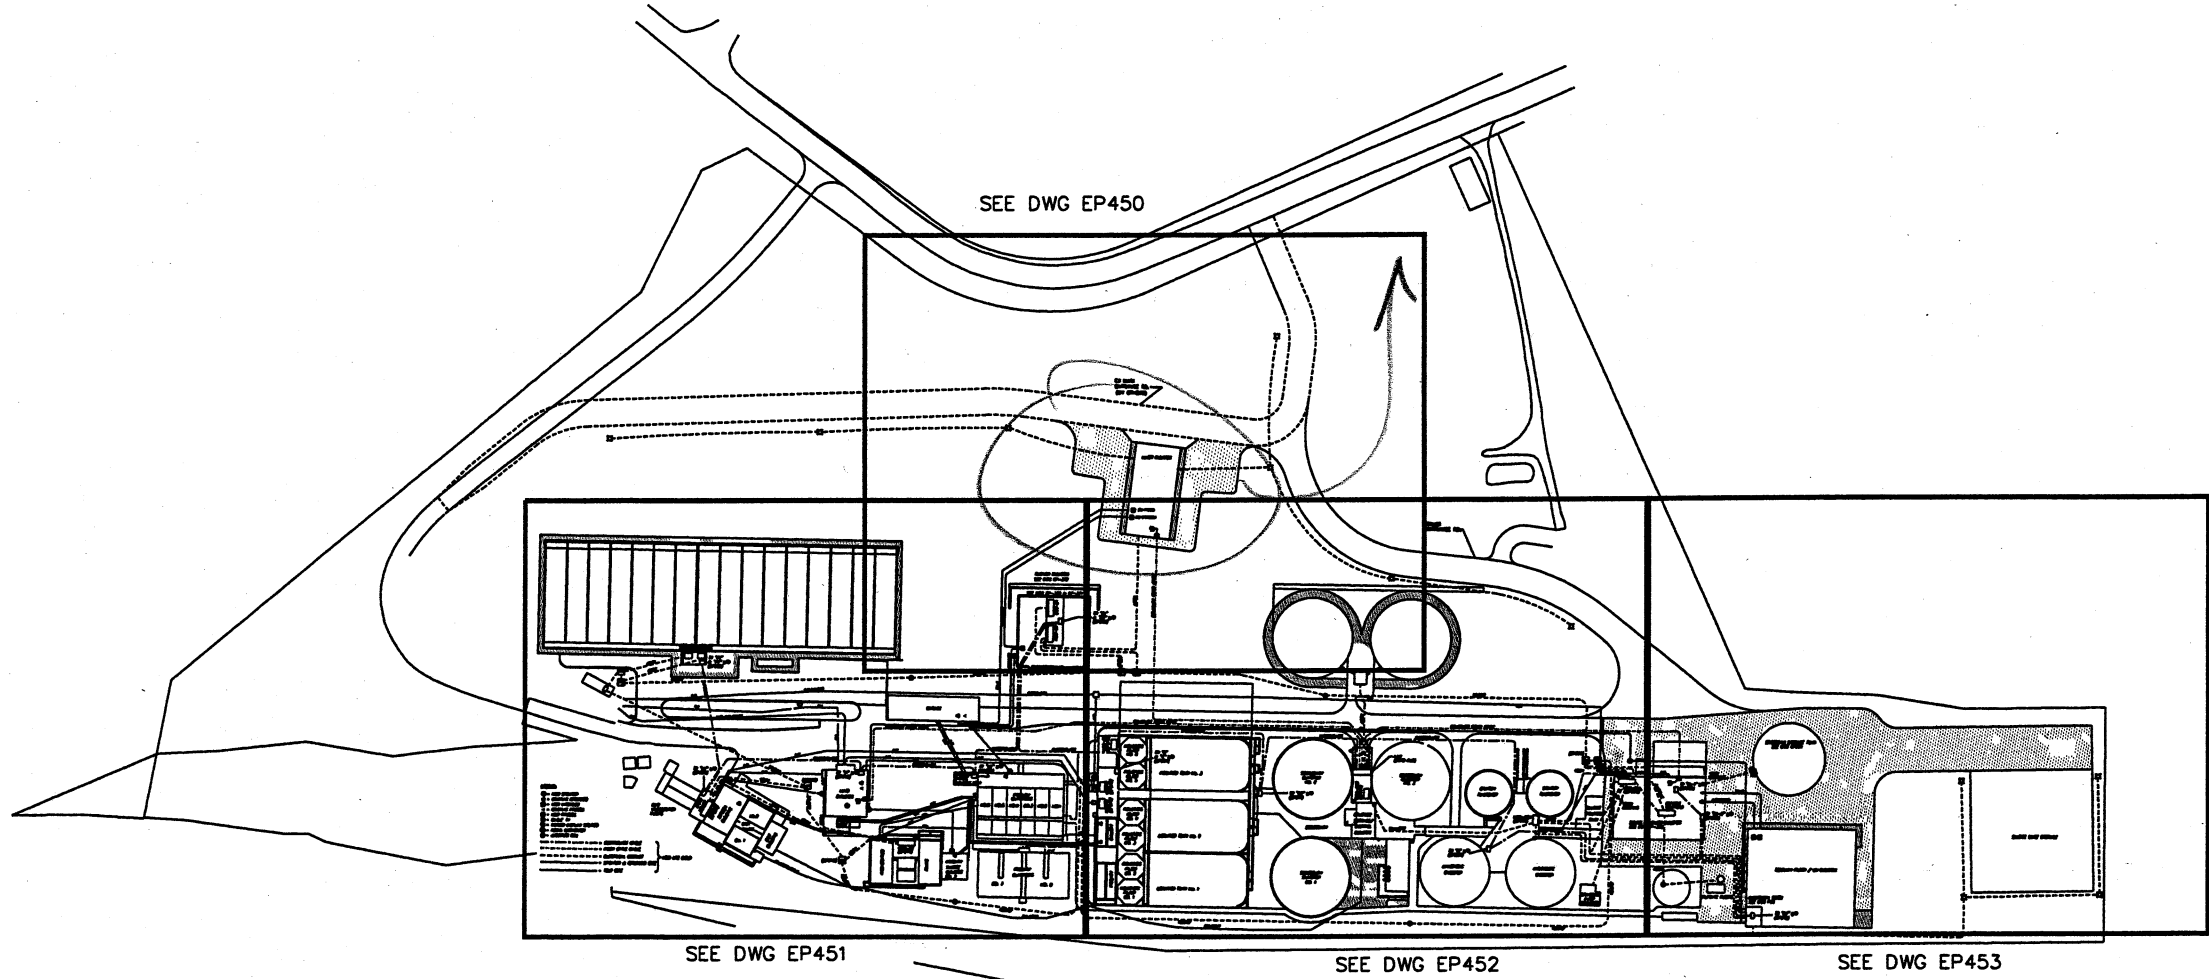

CTI
ENVIRONMENTAL, INC.
ENGINEERING, WATER AND EARTH SCIENCES
UNIONTOWN, OHIO

CITY OF MASSILLON, OHIO
WWTP UPGRADE 2000
SITE PLAN

DESIGNED BY		REVISIONS		DATE		BY	
STI/TSS		NO.	DESCRIPTIONS				APPD
DRAWN BY							
STI/RRR							
CHECKED BY							
STI/TSS							
APPROVED BY							
STI/R/L							

JOB NO.
E9031
DATE
02/14/00
SCALE
1/8"=1'
SHEET
EP3