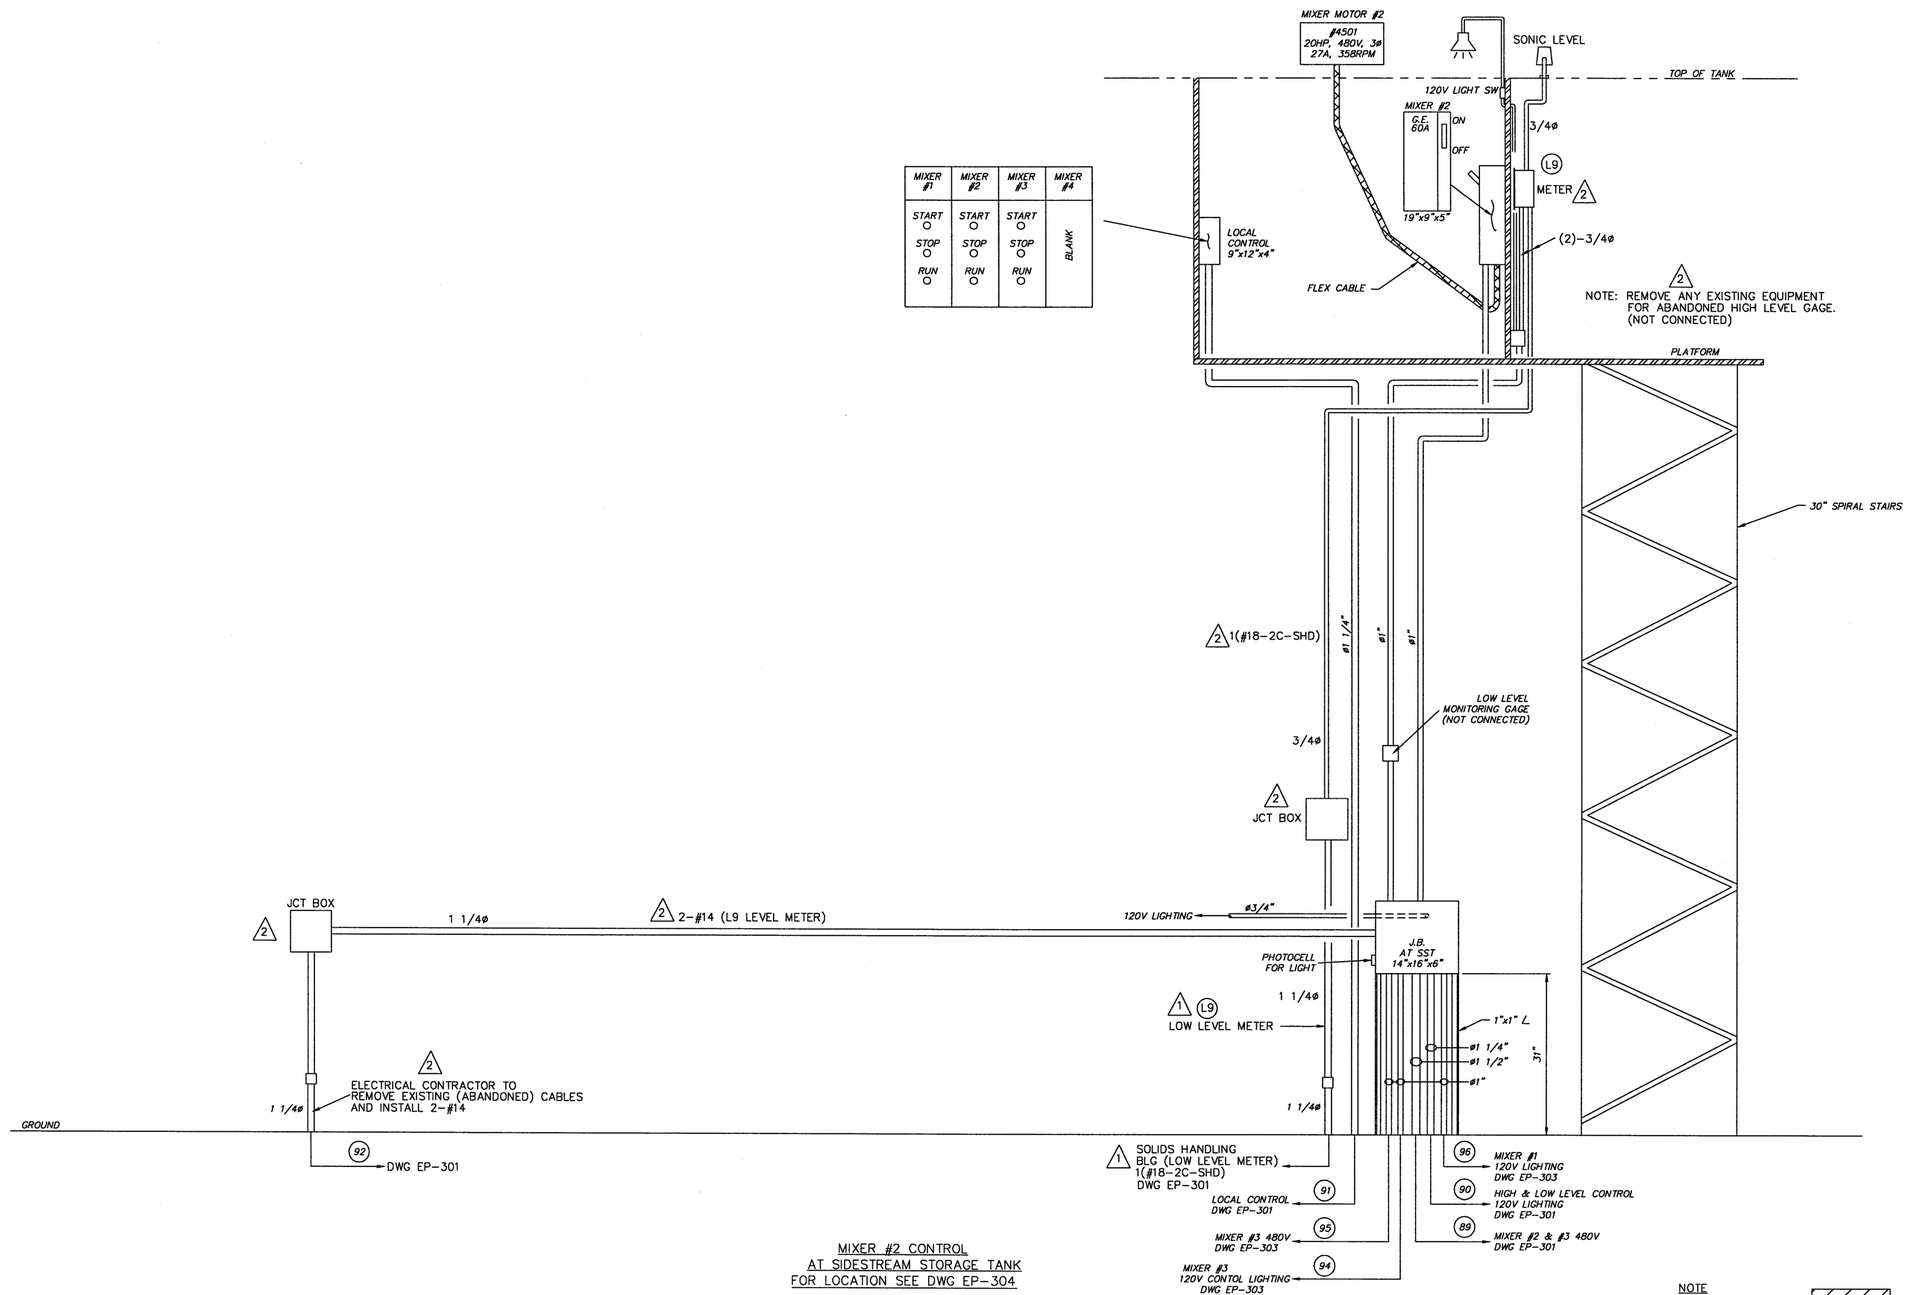

MIXER #2 CONTROL
AT SIDESTREAM STORAGE TANK
FOR LOCATION SEE DWG EP-304

NOTE
1. ITEMS FOR ADDITION

SEIFERT TECHNOLOGIES, INC.
MASSILLON, OHIO
JOB No. 3674 DRAWN BY RJL

REVISIONS				
NO.	DESCRIPTIONS	DATE	BY	APP'D
1	REVISED AT PER CONSTRUCTION	10/2/00	JDH	RJL
2	ADDED LEVEL METER	7/14/00	TSS	RJL

DESIGNED BY	STI/TSS
DRAWN BY	STI/RRR
CHECKED BY	STI/TSS
APPROVED BY	STI/RJL

ENVIRONMENTAL, INC.
ENGINEERS, WATER AND EARTH SCIENCES
UNIONTOWN, OHIO

CITY OF MASSILLON, OHIO
WWTP UPGRADE 2000
TRANSFORMER "D1", MIXER #2 CONTROL
AT SIDESTREAM STORAGE TANK

JOB NO.	E9031
DATE	2/28/01
SCALE	1"=1'
SHEET	EP302-2

9031SPLE302.DWG