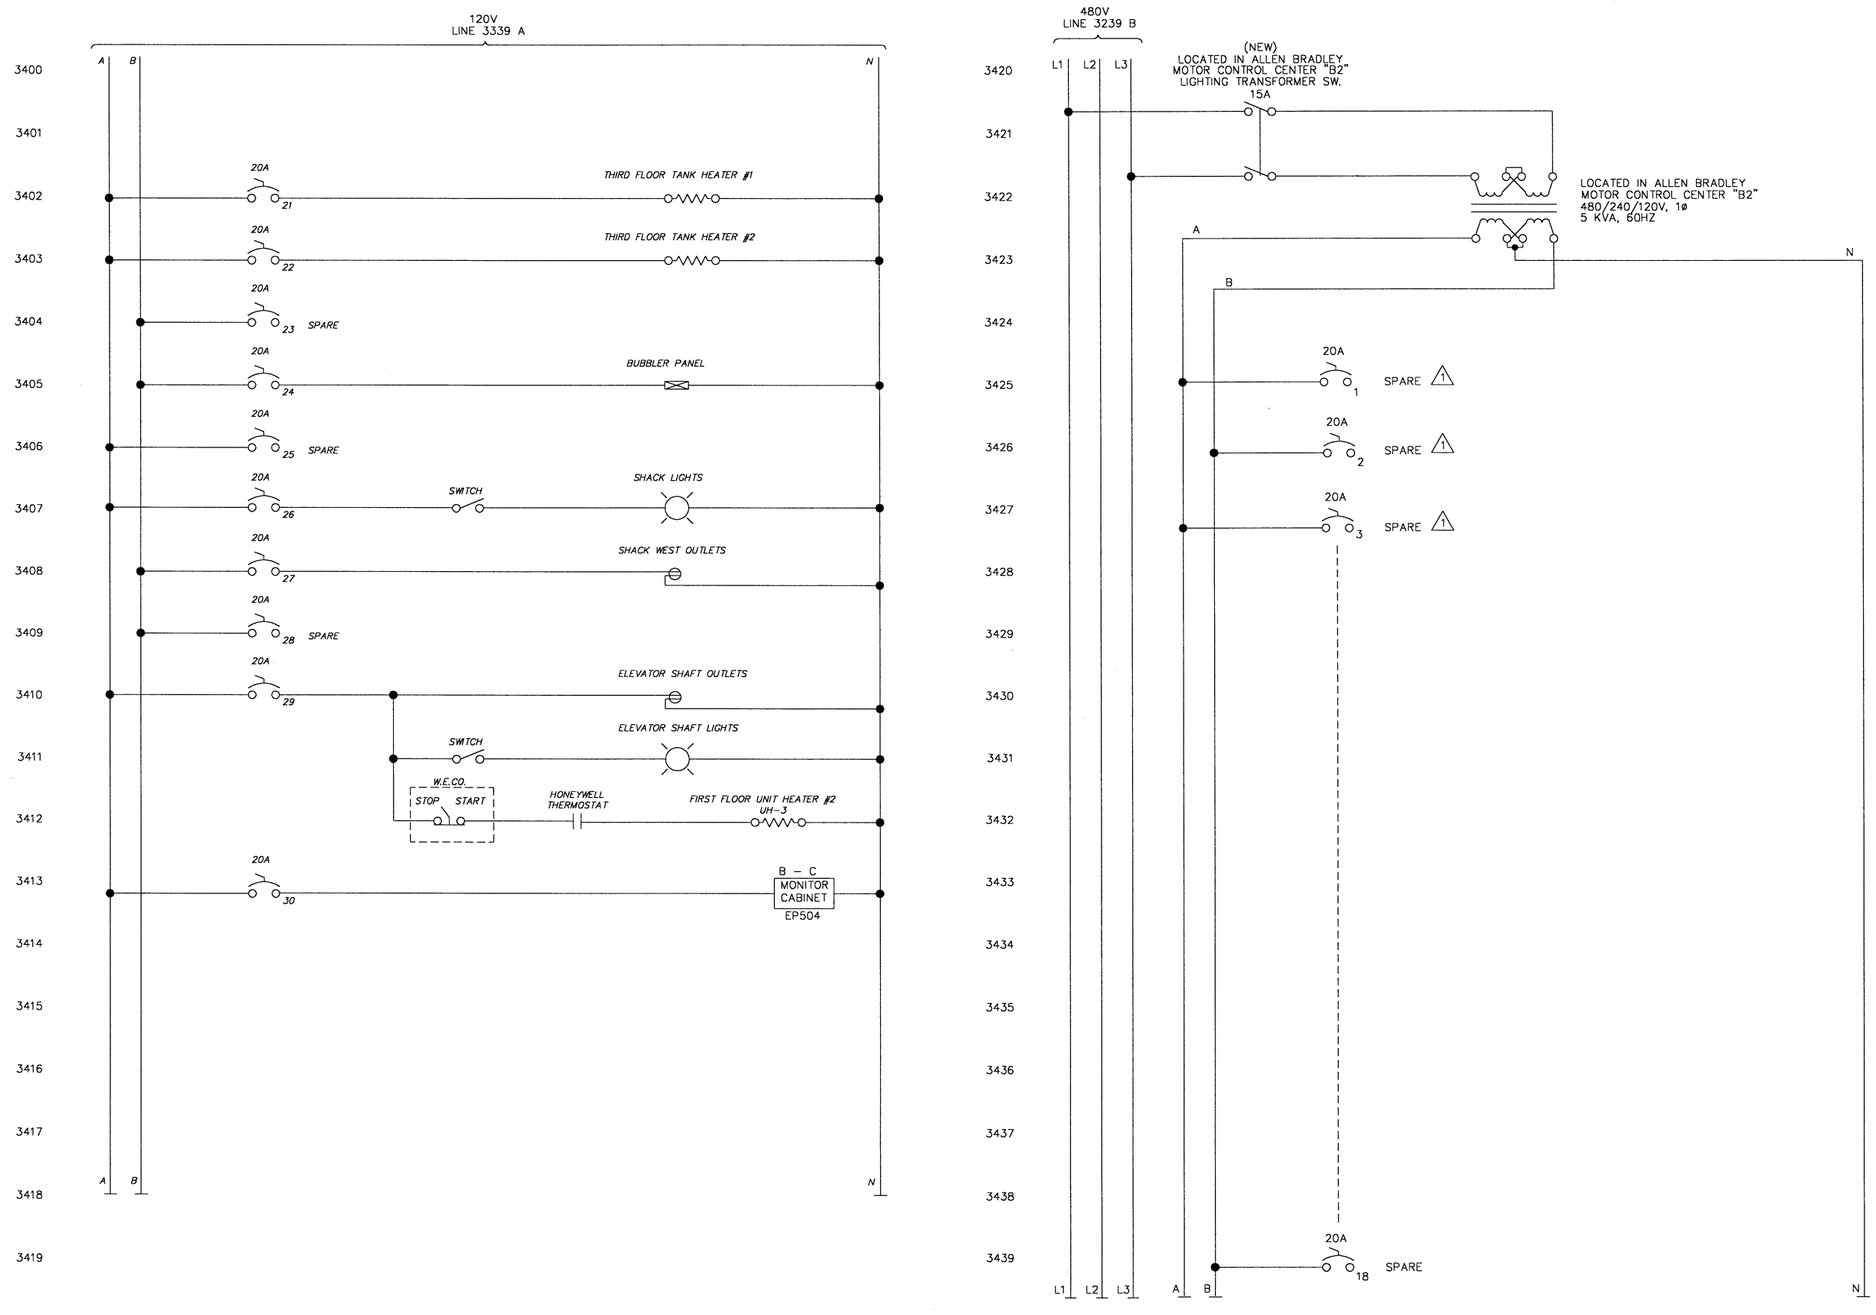

SEIFERT TECHNOLOGIES, INC.
MASSILLON, OHIO
JOB NO. 5674 DRAWN RJL

REVISIONS				
NO.	DESCRIPTIONS	DATE	BY	APP'D
1	REMOVED AIR CONTROL VALVES	3/06/01	TSS	R.J.L.

DESIGNED BY ST1/TSS
DRAWN BY ST1/TSS
CHECKED BY ST1/TSS
APPROVED BY ST1/RJL

ENVIRONMENTAL, INC.
ENGINEERS, WATER AND EARTH SCIENCES
UNIONTOWN, OHIO

CITY OF MASSILLON, OHIO
WWTP UPGRADE 2000
TRANSFORMER "B", MCC-B1, & B2
LIGHTING PANEL SCHEMATIC DIAGRAMS

JOB NO. E9031
DATE 3/08/01
SCALE N/A
SHEET EP34-1

9031SCHE34.DWG