W:\ACAD14\CTI Envi\5674\Completed Dwgs\300-399\9031SPLE340.dwg Fri Aug 10 14:07:12 2001

NOTE
ALL EQUIPMENT IN THIS AREA
IS EXPLOSION PROOF.

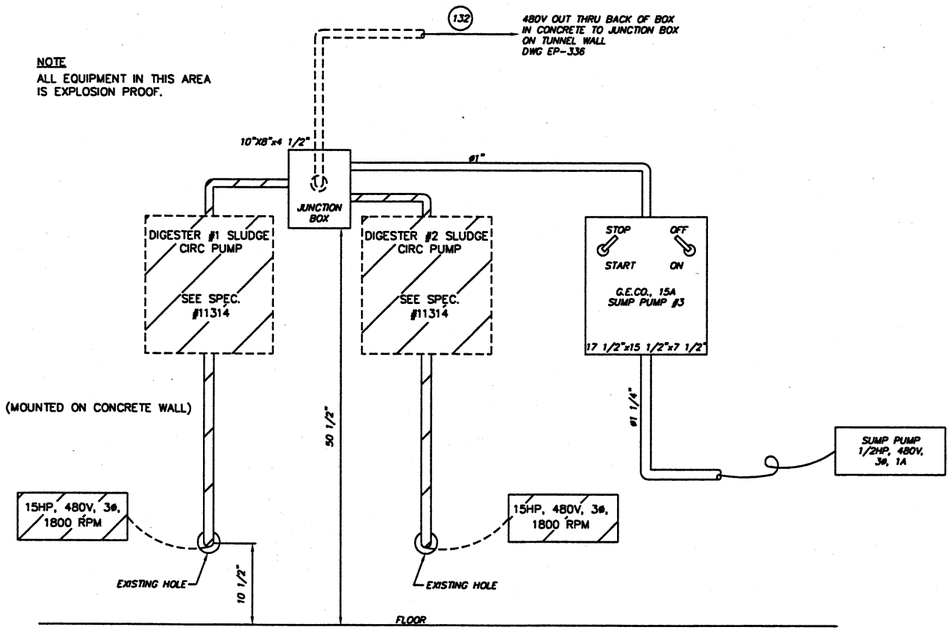

DIGESTER SLUDGE CIRCULATING PUMP
LOCATED IN TUNNEL (IN PIT)
BETWEEN DIGESTER TANKS

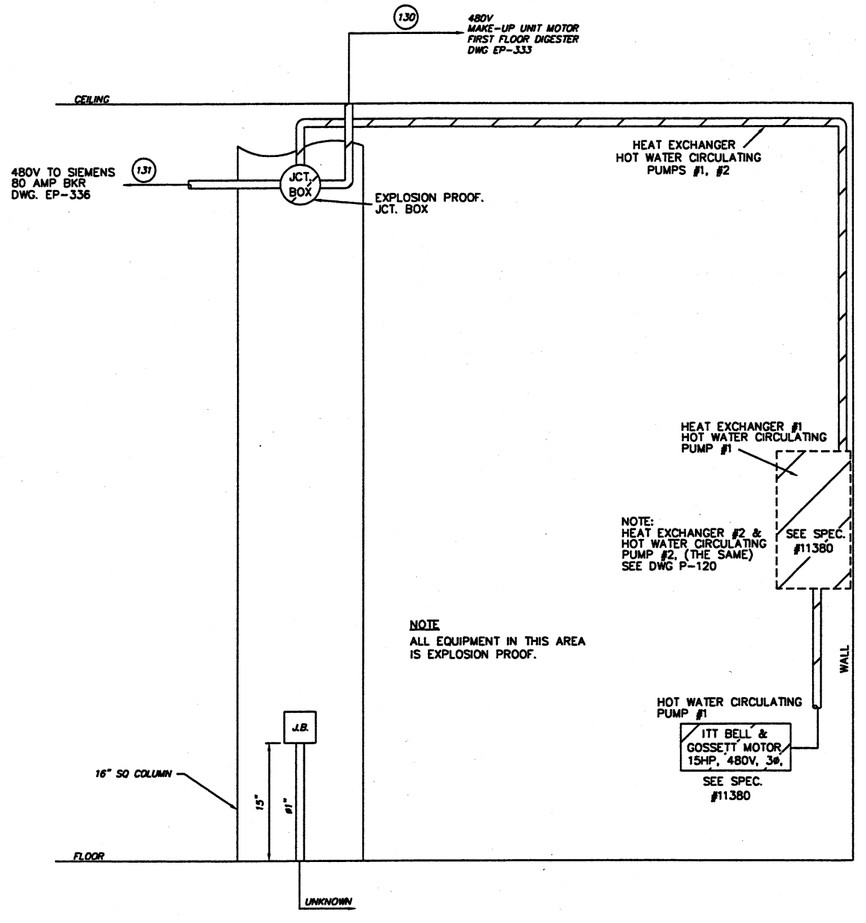

LOCATED IN TUNNEL
BY HEAT EXCHANGERS

NOTES
1. ITEMS FOR ADDITION
2. ALL BOX'S , MOTORS & CONDUITS TO MEET (NEC) CLASSIFIED HAZARDOUS LOCATION CLASS I, DIVISION 1, GROUP D

BISHOP TECHNOLOGIES, INC.
MASSILLON, OHIO
#s 5674 5660 R.J.L.

REVISIONS

NO.	DESCRIPTIONS	DATE	BY	APP'D

DESIGNED BY STI/TSS
DRAWN BY STI/TSS
CHECKED BY STI/TSS
APPROVED BY STI/R.J.L.

ENVIRONMENTAL, INC.
CONSULTING WATER AND EARTH SCIENCES
UNIONTOWN, OHIO

CITY OF MASSILLON, OHIO
WWTP UPGRADE 2000
TRANSFORMER "D2", SLUDGE CIRC PUMPS, & SUMP PUMP
HEAT EXCHANGER #1 AND #2, LOCATED IN TUNNEL

JOB NO. E9031
DATE 4/17/01
SCALE 1 1/2" = 12"
SHEET EP340

9031SPLE340.DWG