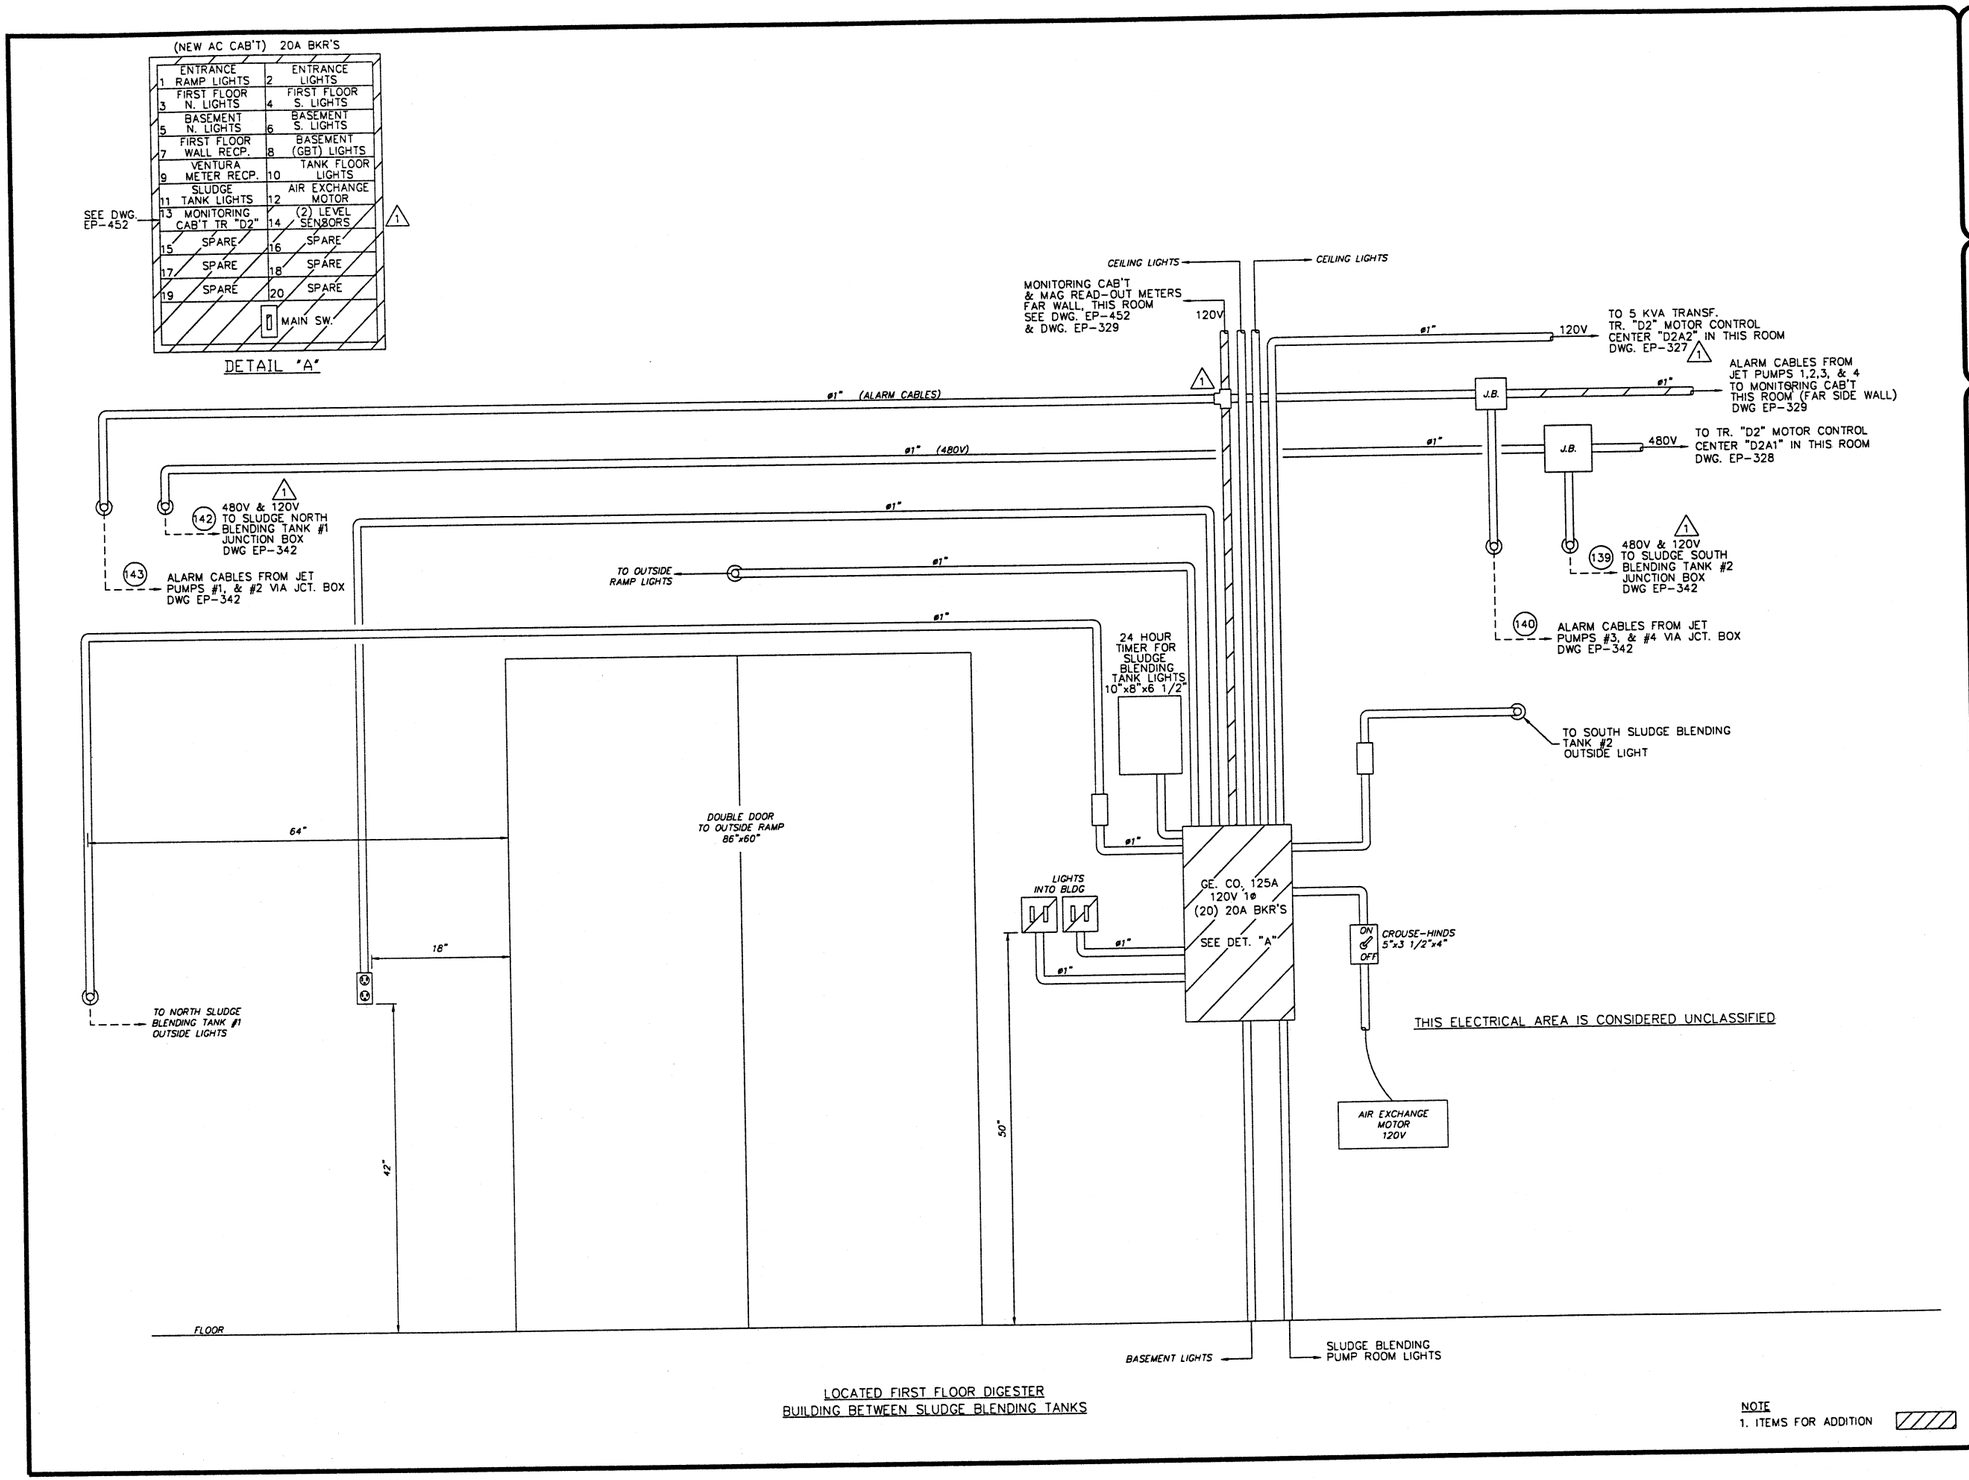

LOCATED FIRST FLOOR DIGESTER BUILDING BETWEEN SLUDGE BLENDING TANKS

NOTE
1. ITEMS FOR ADDITION

SEIFERT TECHNOLOGIES, INC.
MASSILLON, OHIO
JOB NO. 5674 DRAWN BY RJL

REVISIONS

NO.	DESCRIPTIONS	DATE	BY	APP'D
1	REVISED AS PER CONSTRUCTION	9/13/02	TSS	RJL

DESIGNED BY STI/TSS
DRAWN BY STI/TSS
CHECKED BY STI/TSS
APPROVED BY STI/RJL

ENVIRONMENTAL, INC.
ENGINEERS IN WATER AND EARTH SCIENCES
UNIONTOWN, OHIO

CITY OF MASSILLON, OHIO
WWTP UPGRADE 2000
JET PUMPS 1,2,3, & 4 JCT. BOX'S, LIGHTING PANEL
EAST WALL, FIRST FLOOR DIGESTER BLDG.

JOB NO. E9031
DATE 5/16/01
SCALE 1 1/2" = 12"
SHEET EP341

9031SPLE341.DWG