


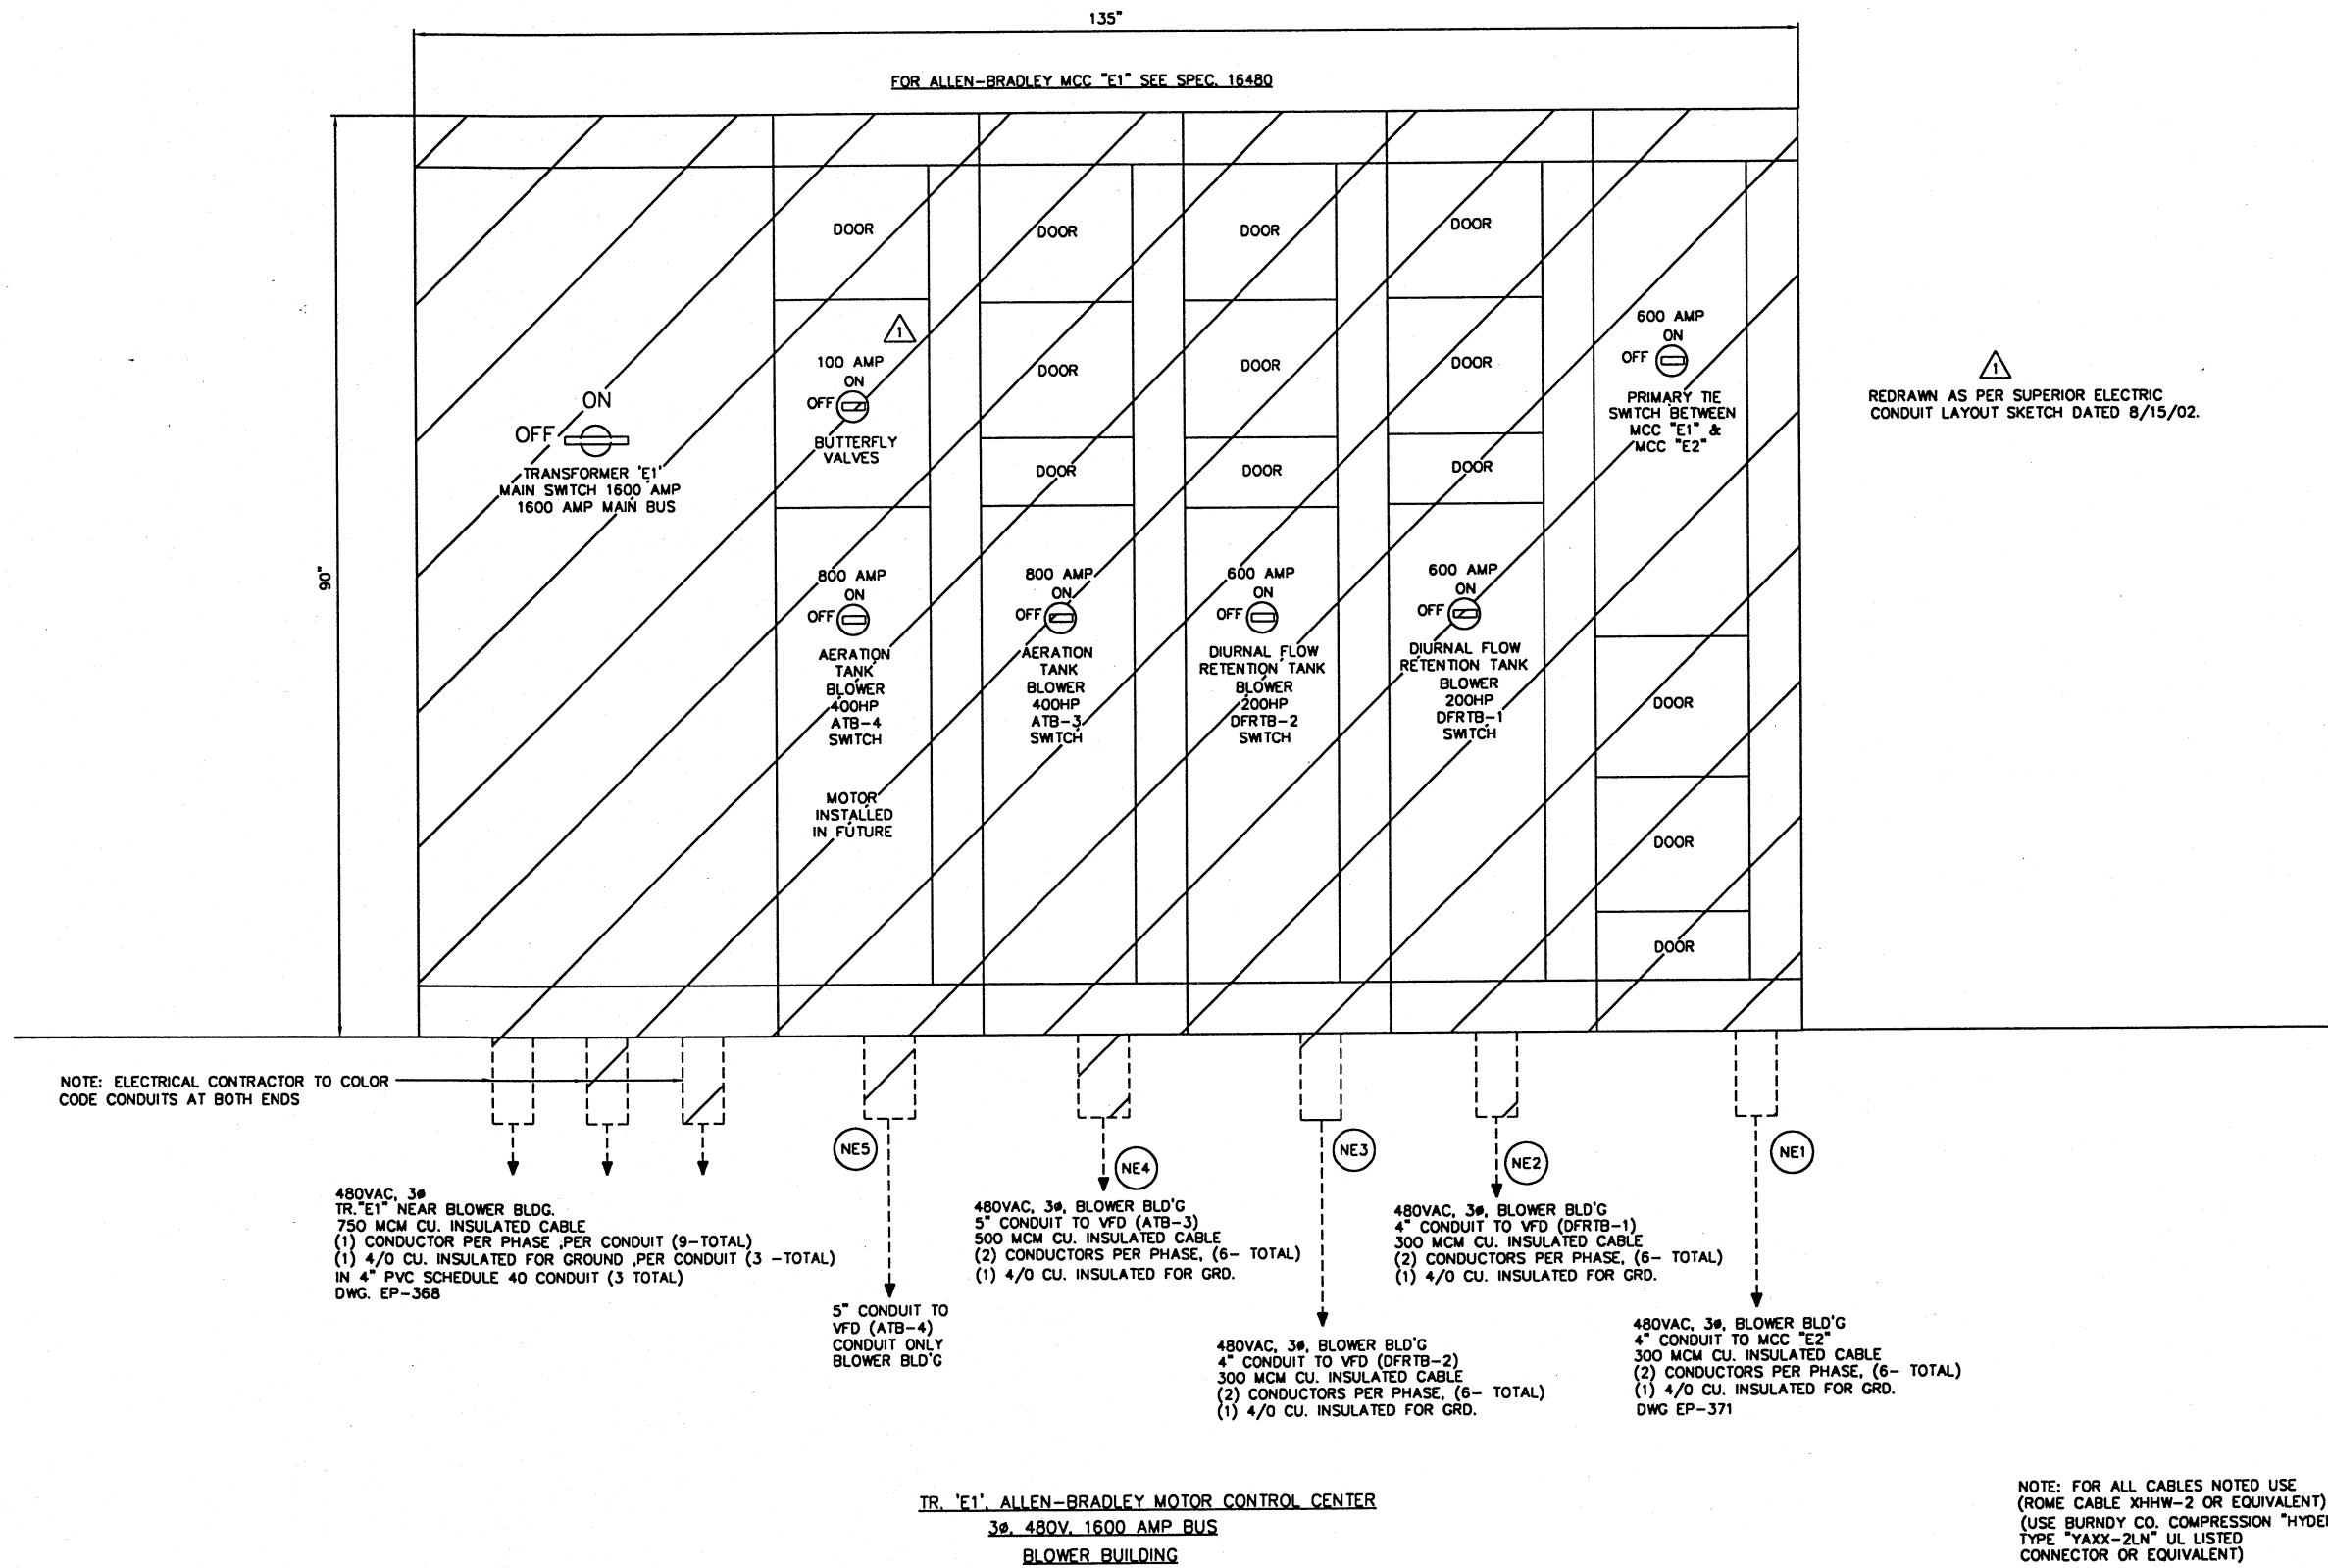

NOTE: FOR ALL CABLES NOTED USE
(ROME CABLE XHHW-2 OR EQUIVALENT)
(USE BURNDY CO. COMPRESSION "HYDENT"
TYPE "YAXX-2LN" UL LISTED
CONNECTOR OR EQUIVALENT)

USE "NO-OX-ID" INHIBITOR COMPOUND
ON ALL PAD CONNECTIONS.

NOTE

1. ITEMS FOR ADDITION 

2. SEE EP-372 FOR REFERENCE

DESIGNED BY		REVISIONS					
	STI/TSS	NO.	DESCRIPTIONS	DATE	BY	APP'D	
DRAWN BY	STI/TSS	1	REVISED AS PER CONSTRUCTION	M7/M8	TSS	R.L.	
CHECKED BY	STI/TSS						
STI/TSS							
APPROVED BY							
STI/R.L.							

GFI ENVIRONMENTAL, INC.
ENGINEERS IN WATER AND EARTH SCIENCES
UNITONTOWN, OHIO

CITY OF MASSILLON, OHIO
WWTP UPGRADE 2000
TRANSFORMER "E1", MCC-"E1" LAYOUT
BLOWER BUILDING



SHIFERT TECHNOLOGIES, INC.
MASSILLON, OHIO
TEL. 567-485-7200 FAX 567-485-7201

JOB NO.	E9031
DATE	6/19/01
SCALE	1 1/2" = 12"
SHEET	EP370-1