


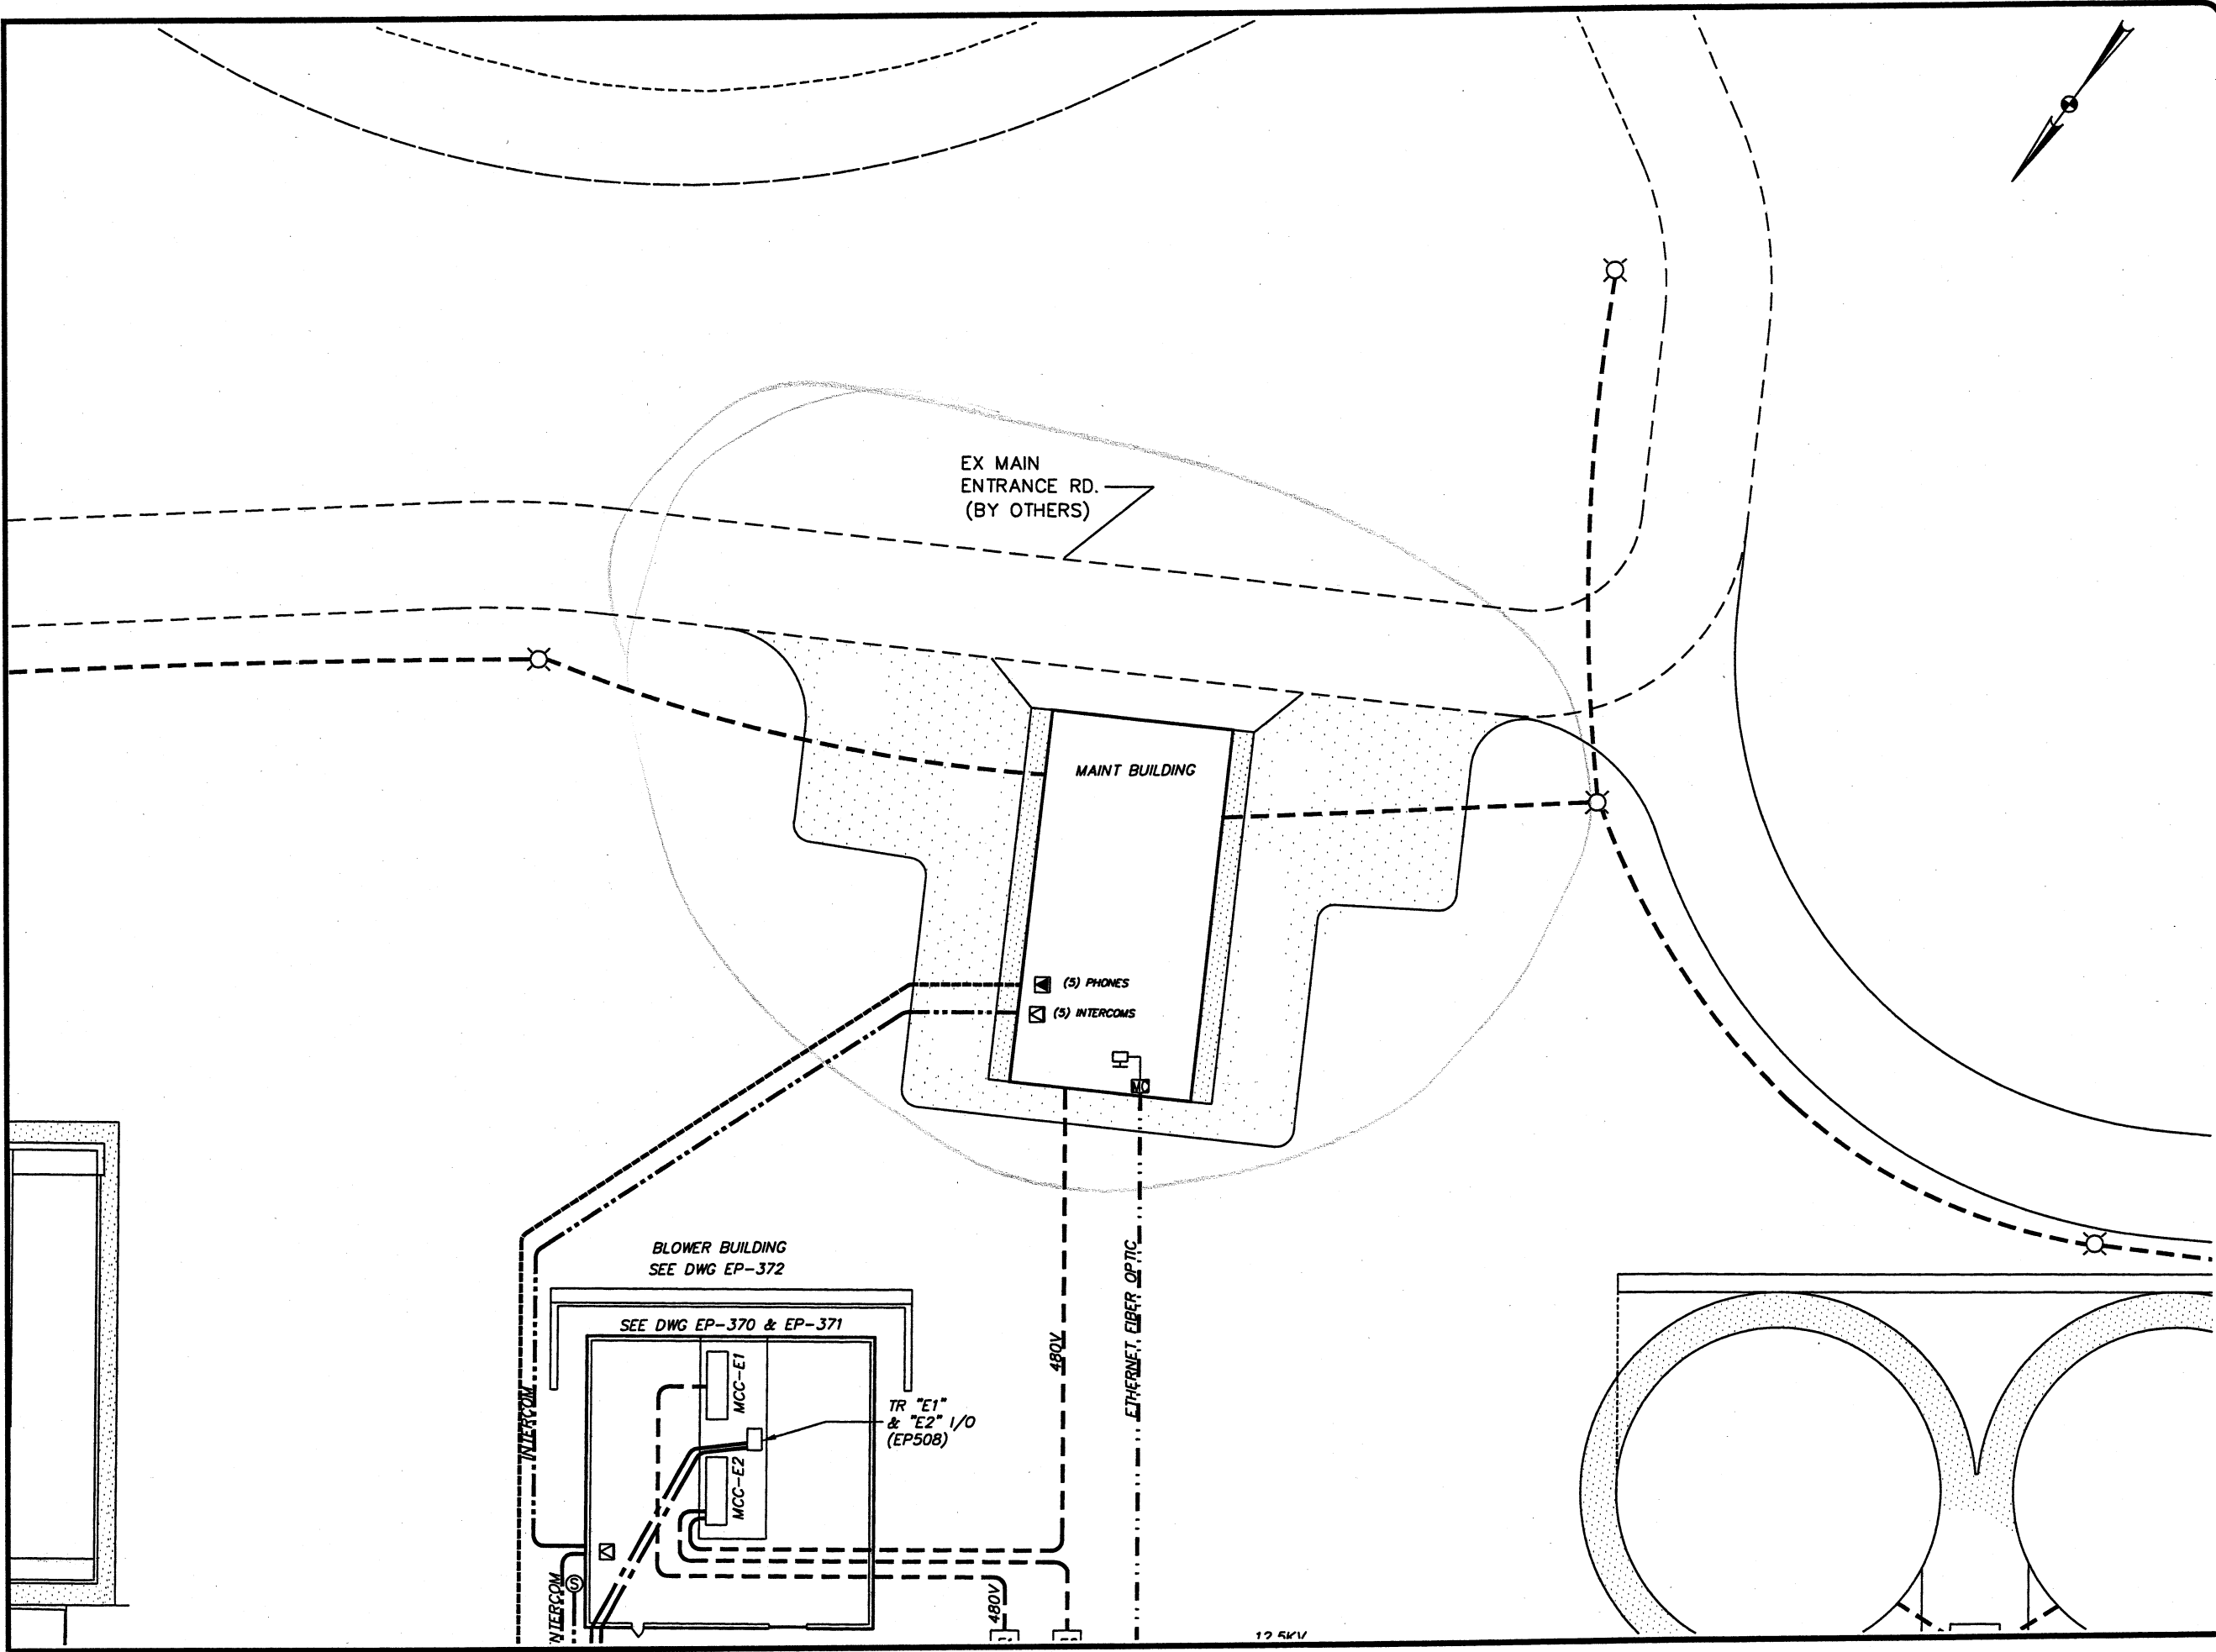

DESIGNED BY
STI/RRR

DRAWN BY
STI/RRR

CHECKED BY
STI/R/L

APPROVED BY
STI/R/L

ENVIRONMENTAL, INC.
ENGINEERS IN WATER AND EARTH SCIENCES
UNIONTOWN, OHIO

CITY OF MASSILLON, OHIO
WWTP UPGRADE 2000
ELECTRICAL RUNS, SHEET 1 OF 4

JOB NO.
E9031

DATE
2/14/01

SCALE
1"=20'

SHEET
EP450

THIS DRAWING IS AN INSTRUMENT OF SERVICE OWNED BY CTI ENVIRONMENTAL, INC. AND SHALL BE LOANED TO THE CLIENT FOR THE PROJECT ONLY. IT IS NOT TO BE REPRODUCED, COPIED, OR DISTRIBUTED TO OTHERS IN ANY FORM OR FOR ANY PURPOSE WITHOUT THE WRITTEN CONSENT OF CTI ENVIRONMENTAL, INC. CTI ENVIRONMENTAL, INC. CANNOT GUARANTEE THAT THE INFORMATION CONTAINED HEREIN IS COMPLETE, ACCURATE, OR FREE FROM OMISSIONS. THE USER SHALL BE RESPONSIBLE FOR OBTAINING NECESSARY DATA AND INFORMATION FROM OTHER SOURCES. 

REVISIONS		DATE	BY	APP'D
NO.	DESCRIPTIONS			

9031SPL450.DWG