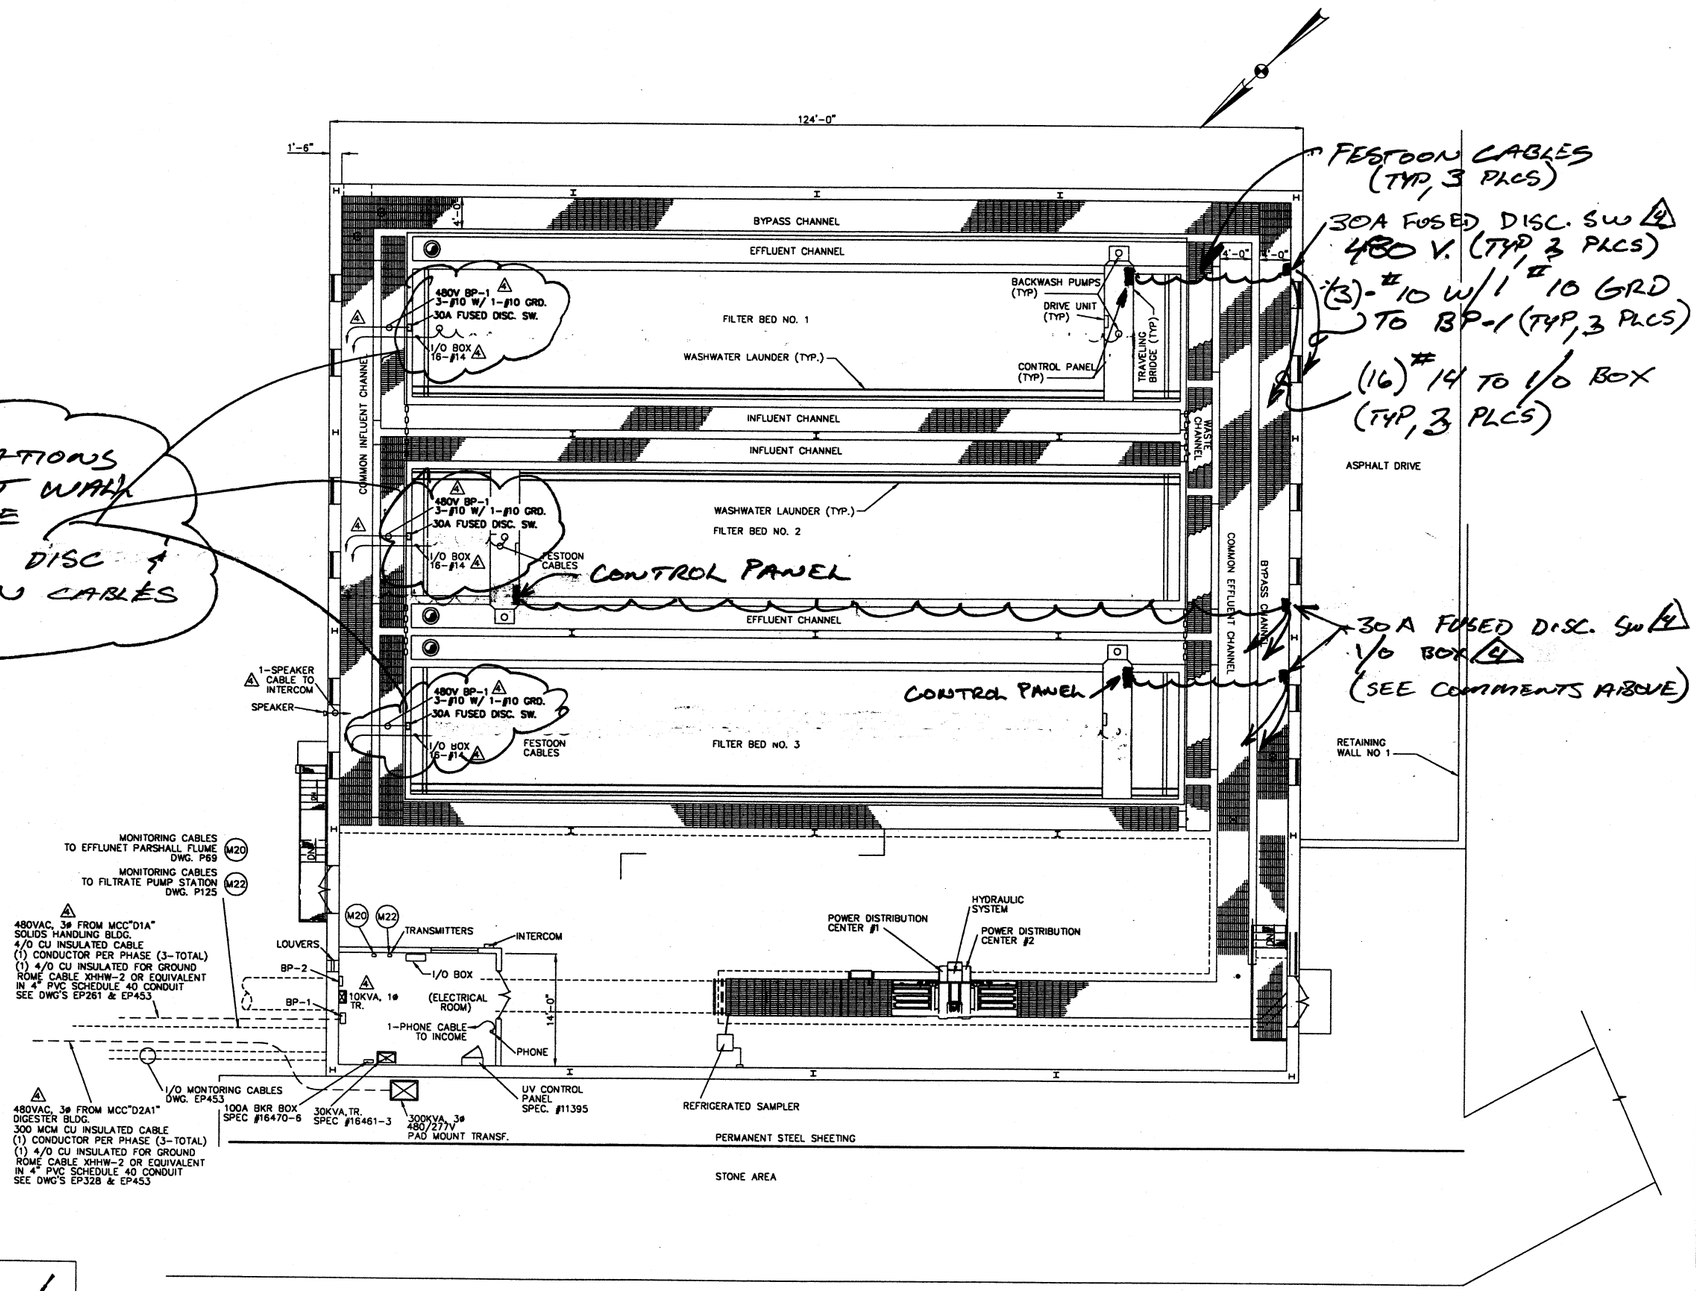

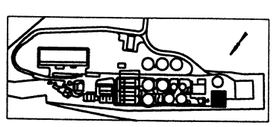

KEY PLAN

PLAN
SCALE:1/8"=1'-0"

NOTES:
1. SEE CTI PROCESS DWG'S P65 THRU P68
2. WORK THIS STI DWG. WITH DWG. EP457
3. ALL CONDUIT IS 3/4"ø AS PER SPEC #16111 UNLESS NOTED.

SEIFERT TECHNOLOGIES, INC.
MASSILLON, OHIO
#5674 PROJ. R.J.L.

REVISIONS

NO.	DESCRIPTIONS	DATE	BY	APP'D
1	MARK-UP	7/23/02	TSS	R.J.L.
2	MARK-UP	8/19/02	TSS	R.J.L.
3	MARK-UP	9/09/02	TSS	R.J.L.
4	UP-DATED ELECTRICAL LAYOUT	10/01/02	TSS	R.J.L.

DESIGNED BY TSS
DRAWN BY TSS
CHECKED BY TSS
APPROVED BY R.J.L.

ENVIRONMENTAL, INC.
ENGINEERS IN WATER AND EARTH SCIENCES
CINCINNATI, OHIO

CITY OF MASSILLON, OHIO
WWTP UPGRADE 2000
TERTIARY FILTER AND UV DISINFECTION BUILDING
ELECTRICAL LAYOUT

JOB NO. E9031
DATE 10/09/02
SCALE AS NOTED
SHEET EP454-4

9031SCHE454.DWG