
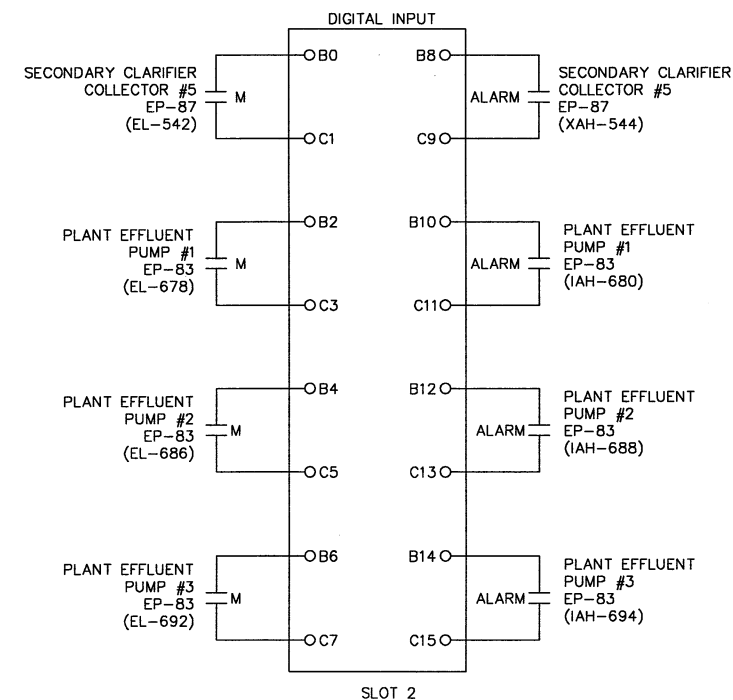
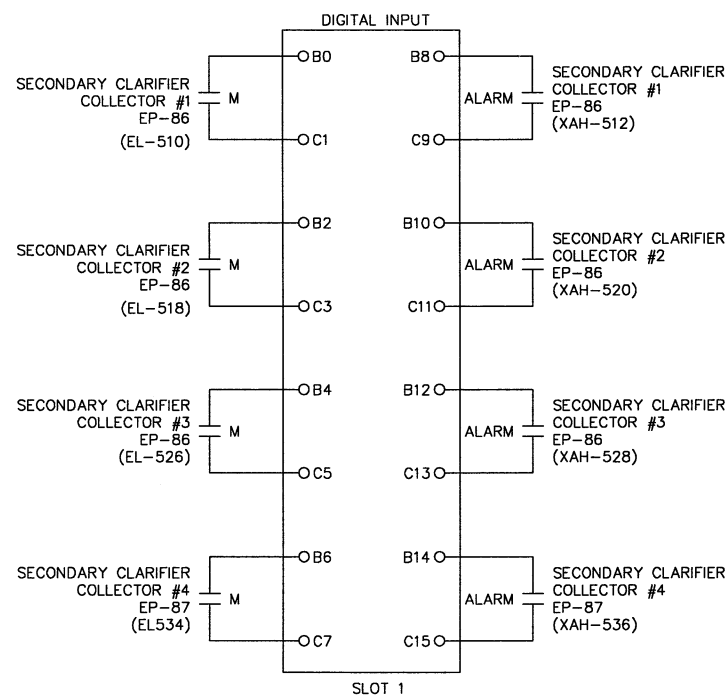
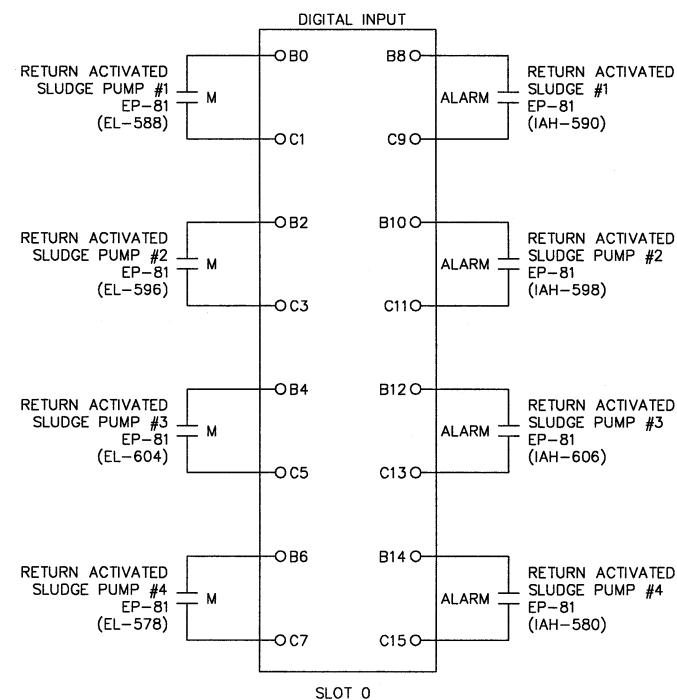
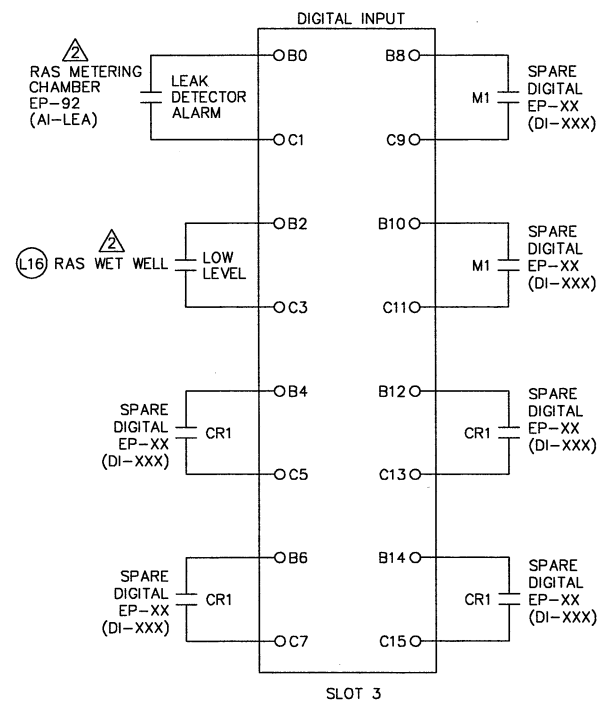
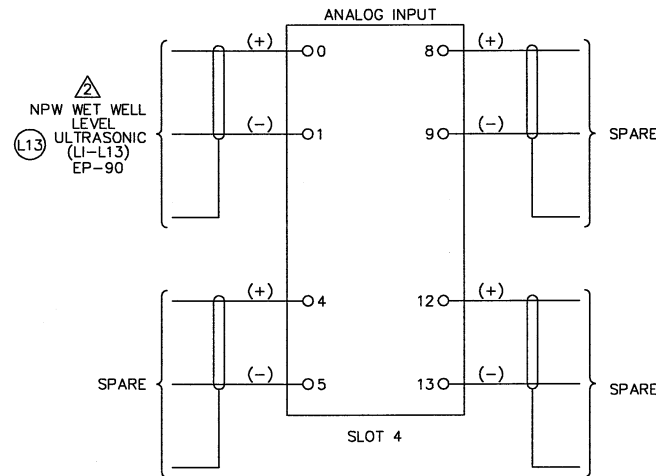
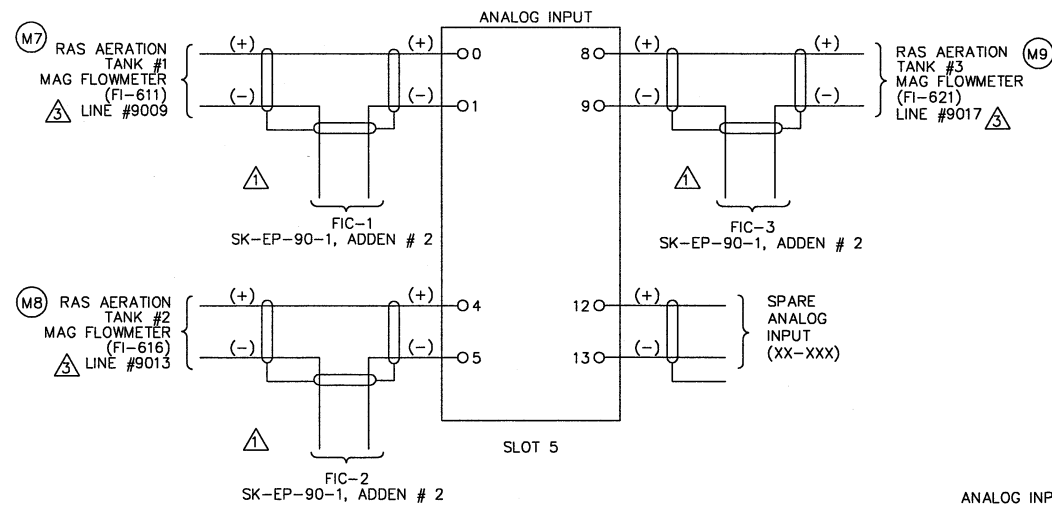


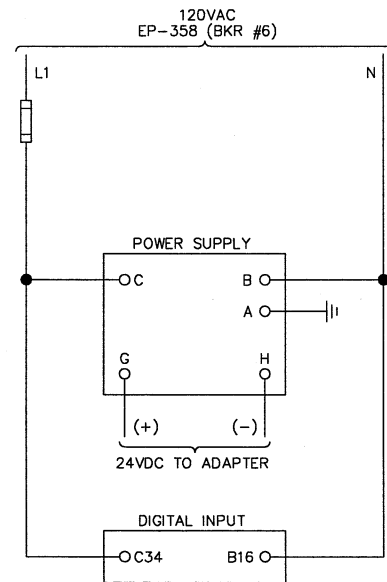

NODE 10: TRANSFORMER "D2" - RAS & SECONDARY CLARIFIER

NOTE: CAN BE RE-ARRANGED WITHIN NODE

ENVIRONMENTAL, INC.
ENGINEERS IN WATER AND EARTH SCIENCES
UNIONTOWN, OHIO

MASSILLON, OHIO
5674 PWS RLL

CITY OF MASSILLON, OHIO
WWTP UPGRADE 2000
MONITORING SYSTEM - I/O DIAGRAM - NODE 10
TRANSFORMER "D2" - RAS & SECONDARY CLARIFIER

NO.	DATE	BY	APPROVED	DESCRIPTIONS
1	12-30-00	STI/RLL	RLL	UPDATED I/O
2	1/10/01	STI/RRR	TSS	UPDATED I/O
3	7/20/01	CHEKED BY	TSS	UPDATED I/O
		STI/RLL		
		APPROVED BY		

JOB NO. E9031
DATE 5/29/01
SCALE N/A
SHEET EP511-3