

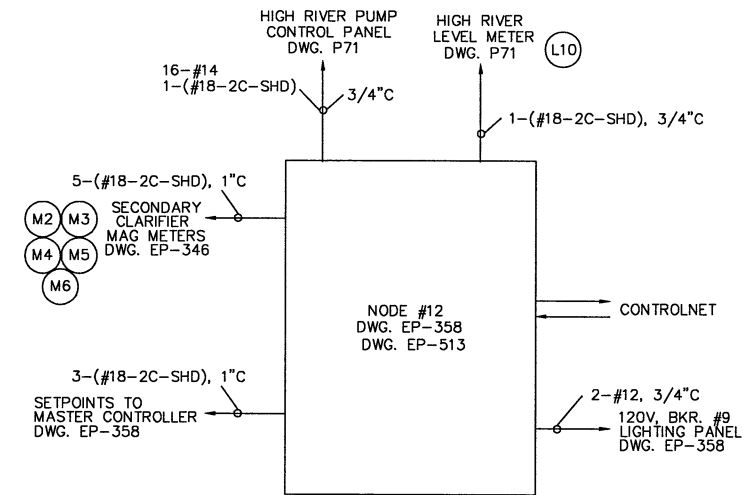
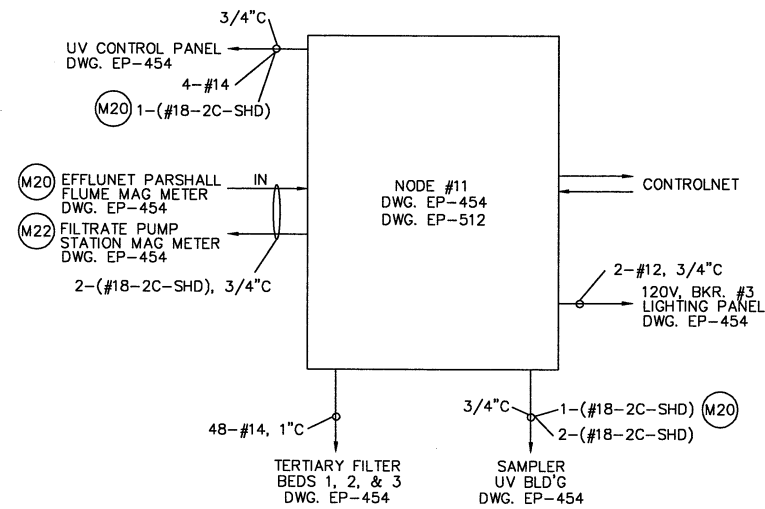
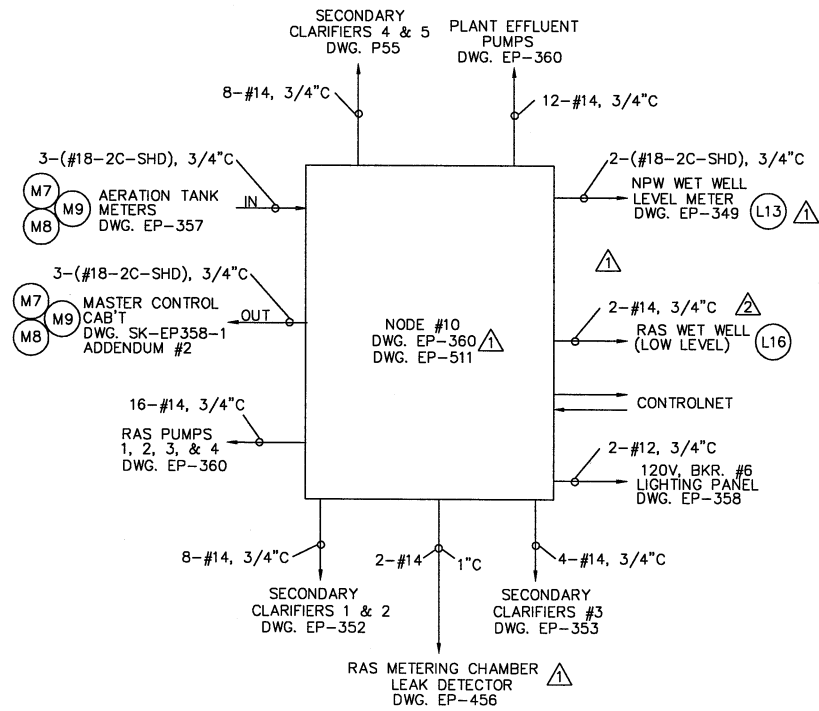
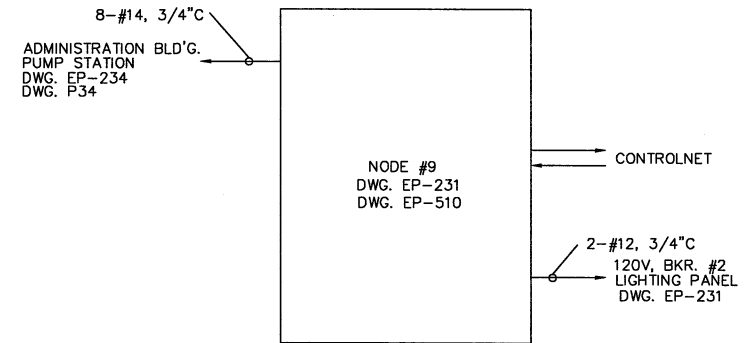


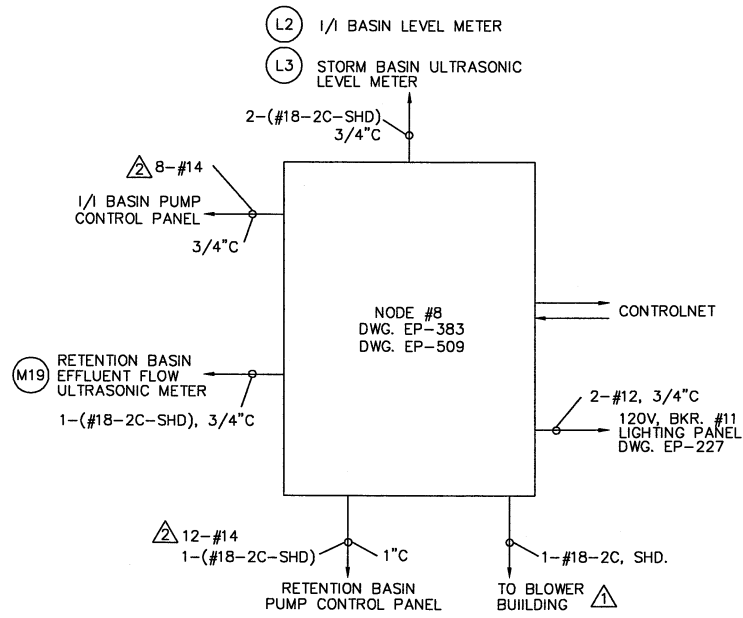

DESIGNED BY		REVISIONS		DATE		BY		APPROVED	
NO.	DESCRIPTION	NO.	DESCRIPTION	NO.	DESCRIPTION	NO.	DESCRIPTION	NO.	DESCRIPTION
1	UPDATED I/O	1	UPDATED I/O	1/10/03	1/10/03	1	UPDATED I/O	1	UPDATED I/O
2	UPDATED I/O	2	UPDATED I/O	7/29/03	7/29/03	2	UPDATED I/O	2	UPDATED I/O

ENVIRONMENTAL, INC.
ENGINEERS IN WATER AND EARTH SCIENCES
UNIONTOWN, OHIO

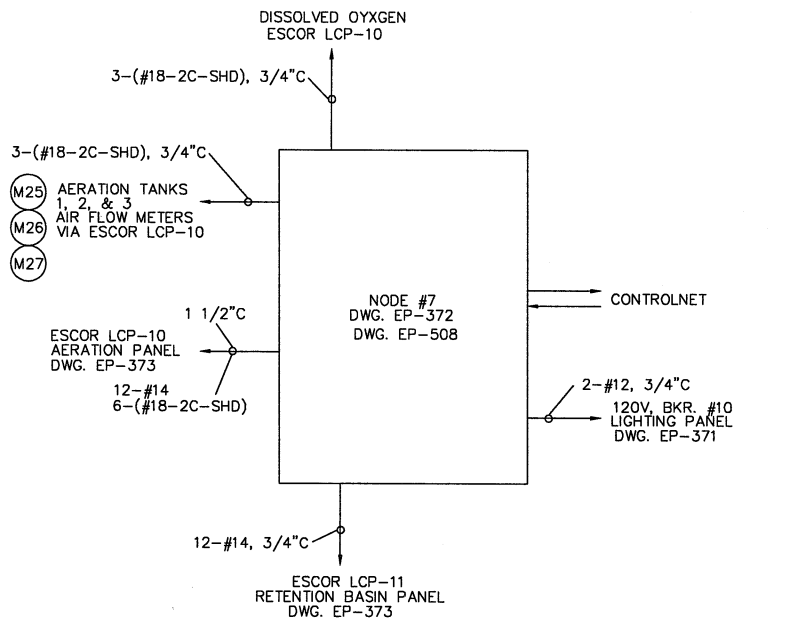

CITY OF MASSILLON, OHIO
WWTP UPGRADE 2000
MONITORING SYSTEM - I/O DIAGRAM - NODE 7 TURE NODE 12

JOB NO.	9031
DATE	1/03/03
SCALE	N/A
SHEET	EP515-2