

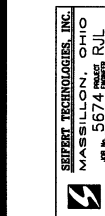


NOTE:  DIGESTER GAS COMPRESSORS
WERE REMOVED FROM "MCC D1A"
AND CONNECTED TO "MCC D2A2" ON
DWG. EP-80A

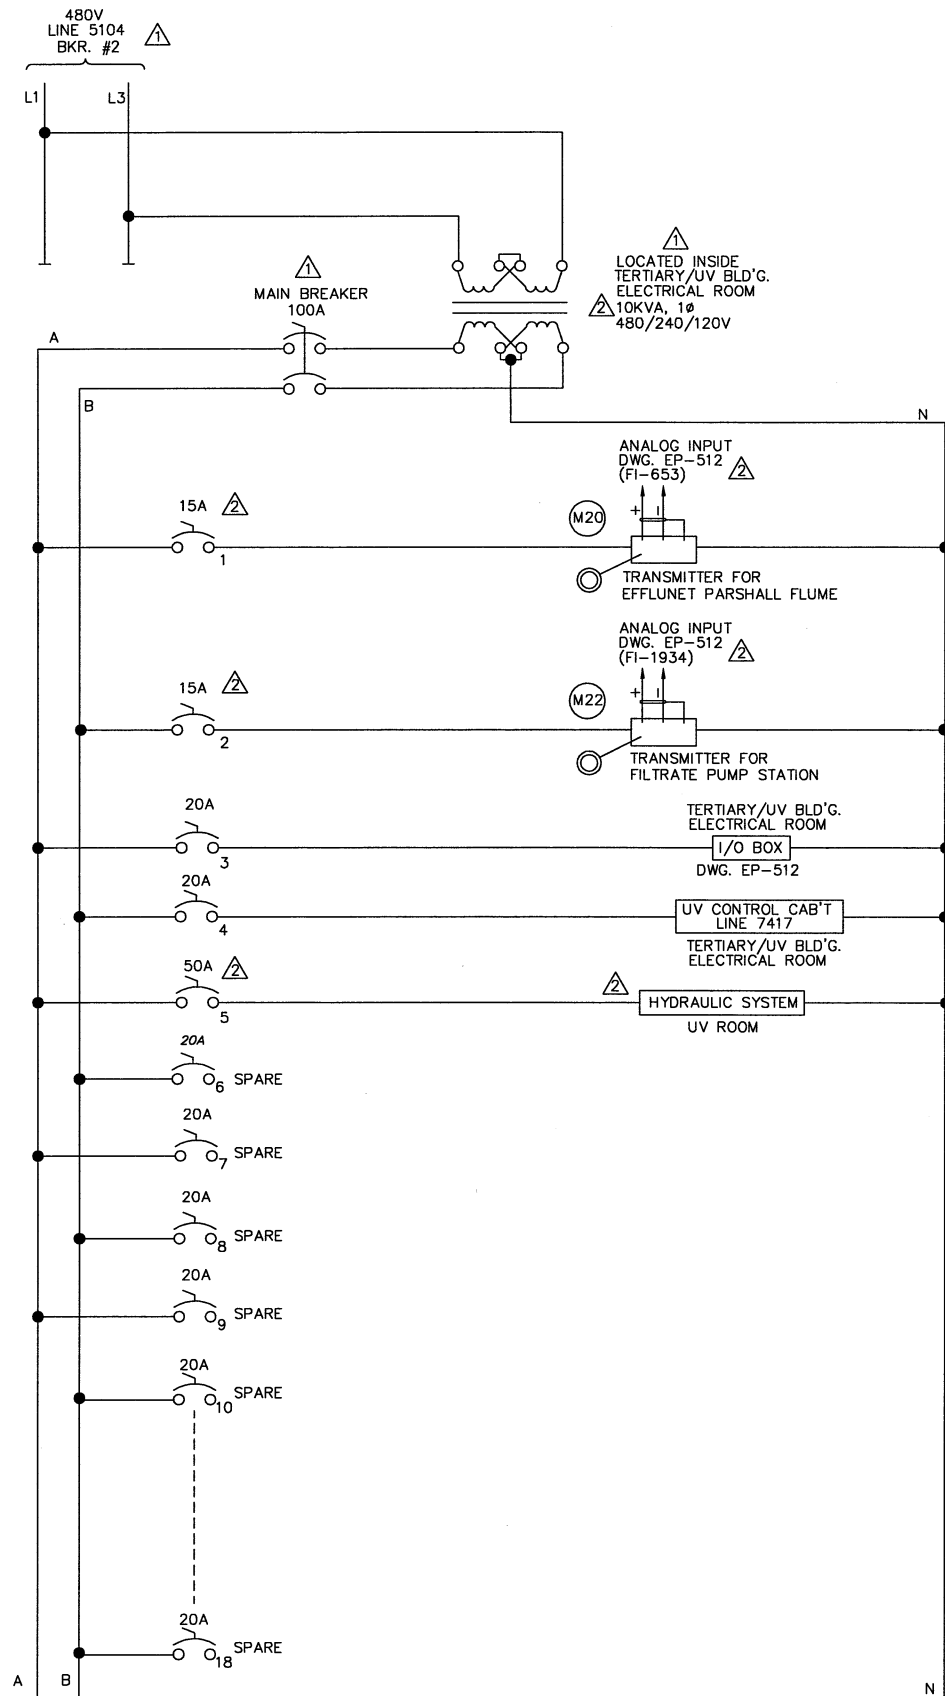

DESIGNED BY		REVISIONS		DATE		BY	
NO.	DESCRIPTION	NO.	DESCRIPTION	DATE	BY	DATE	BY
1	REVISED AS PER CONSTRUCTION	1	REVISED AS PER CONSTRUCTION	4/24/04	TSS	4/24/04	TSS
2	REVISED AS PER CONSTRUCTION	2	REVISED AS PER CONSTRUCTION	4/24/04	TSS	4/24/04	TSS
3	REMOVED (3) GAS COMPRESSORS	3	REMOVED (3) GAS COMPRESSORS	7/8/03	TSS	7/8/03	TSS

ENVIRONMENTAL, INC.
ENGINEERS, WATER AND EARTH SCIENCES
UNIONTOWN, OHIO

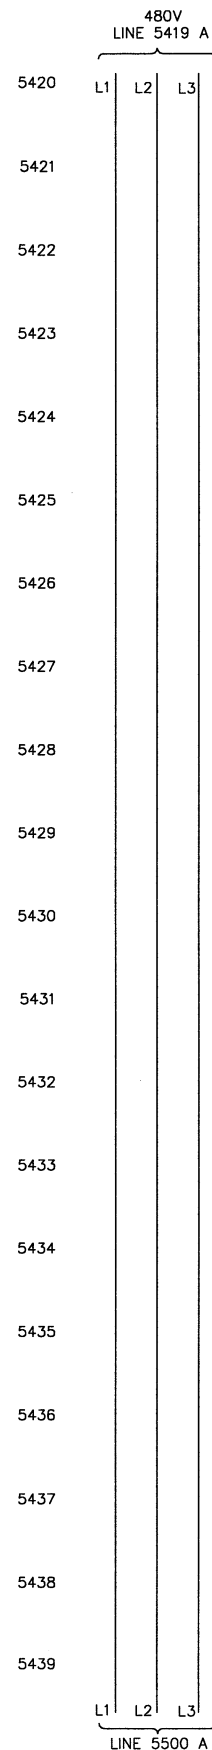

CITY OF MASSILLON, OHIO
WWTP UPGRADE 2000
TRANSFORMER "D1", MCC-D1A, DIGESTER GAS COMPRESSORS
AND TERTIARY FILTER/UV SCHEMATIC DIAGRAM

JOB NO. E9031
DATE 2/16/01
SCALE N/A
SHEET EP54-3