


TR. "D1" 480V, 3Ø,
ALLEN-BRADLEY MOTOR
CENTRAL CENTER "D1A", DWG EP-50
LOCATED IN SOLIDS HANDLING BLDG.

6200 L1 L2 L3
6201


6202 LOCATED IN SOLID HANDLING BLDG. (CENTER ROOM)
ALLEN-BRADLEY MOTOR CONTROL CENTER "D1B"
FEED SW. BETWEEN MCC "D1B" & MCC "D1A"
480V, 3Ø, 600 AMP (800 AMP BUS)

6203

6204 TR. "D1B" MOTOR CONTROL CENTER
CENTER ROOM SOLID HANDLING BLDG.
SST MIXER SW. #1

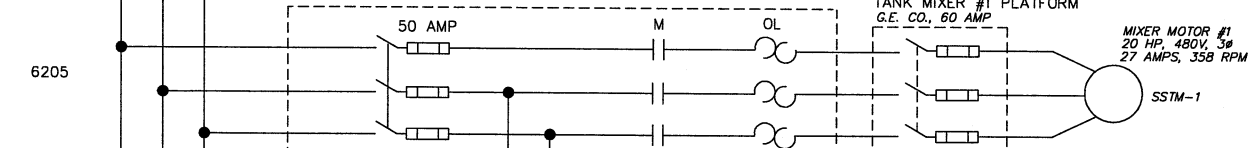


TR. "D1B" MOTOR CONTROL CENTER
CENTER ROOM SOLID HANDLING BLDG.
SST MIXER SW. #2

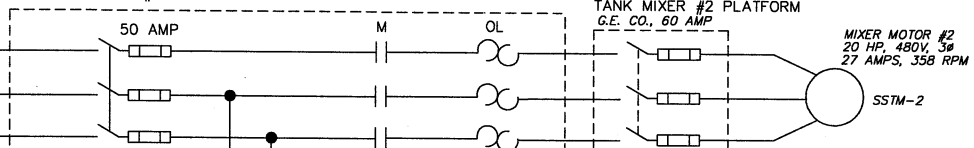

L1 L2 L3
LINE 6220 A

480V
LINE 6219 A
L1 L2 L3

TR. "D1B" MOTOR CONTROL CENTER
CENTER ROOM SOLID HANDLING BLDG.
SST MIXER SW. #3

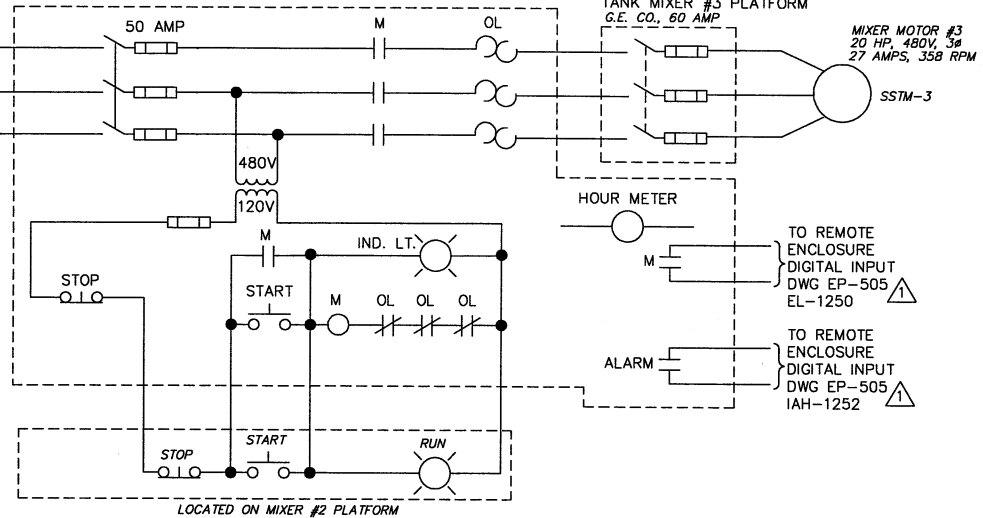

L1 L2 L3
LINE 6300 A



DESIGNED BY		REVISIONS		BY		DATE	
STI/TSS	STI/TSS	NO.	DESCRIPTIONS	DATE	BY	DATE	BY
1	1	1	REVISED FOR CONSTRUCTION	7/29/03	TSS		R/L
STI/TSS	STI/TSS						
STI/TSS	STI/TSS						
STI/TSS	STI/TSS						
STI/R/L	STI/R/L						

ENVIRONMENTAL, INC.
ENGINEERS IN WATER AND EARTH SCIENCES
UNIONTOWN, OHIO



CITY OF MASSILLON, OHIO
WWTP UPGRADE 2000
TRANSFORMER "D1", MCC-D1B
MIXER MOTORS & SST PUMPS SCHEMATIC DIAGRAM

JOB NO. E9031
DATE 3/1/01
SCALE N/A
SHEET EP62-1

9031SCHE62.DWG