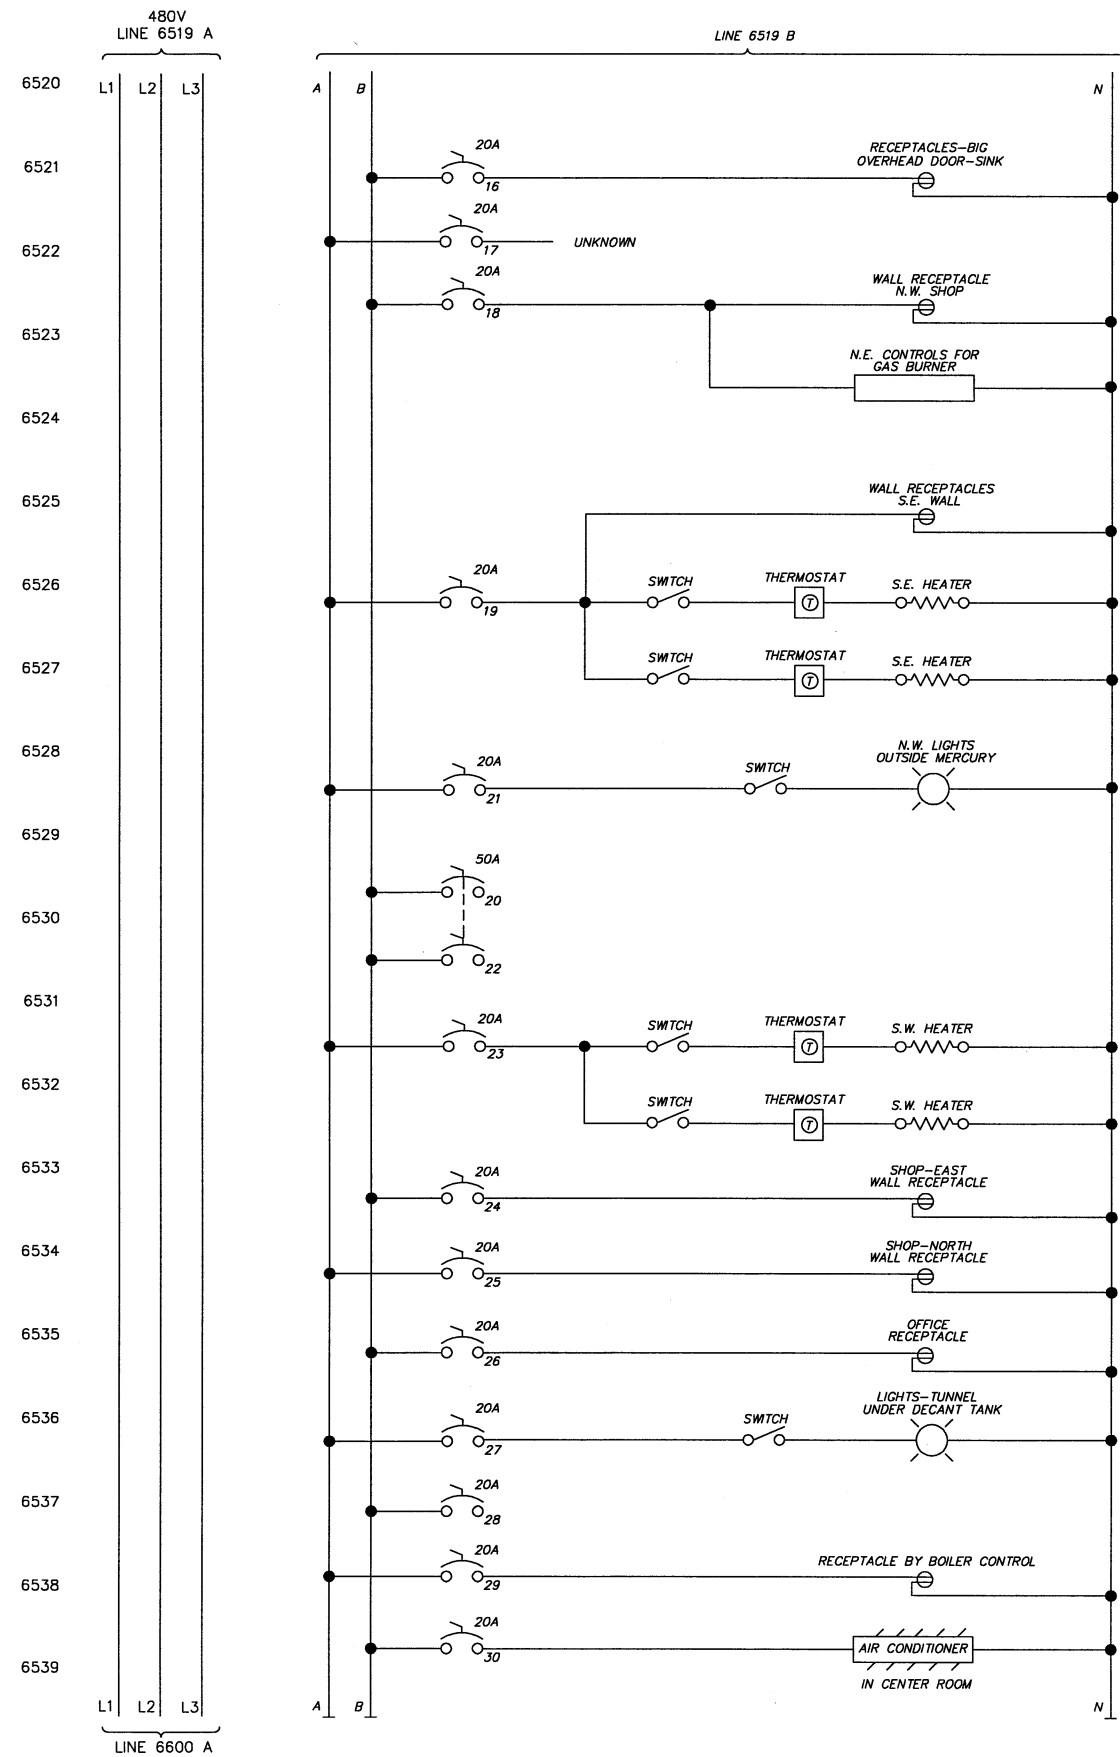
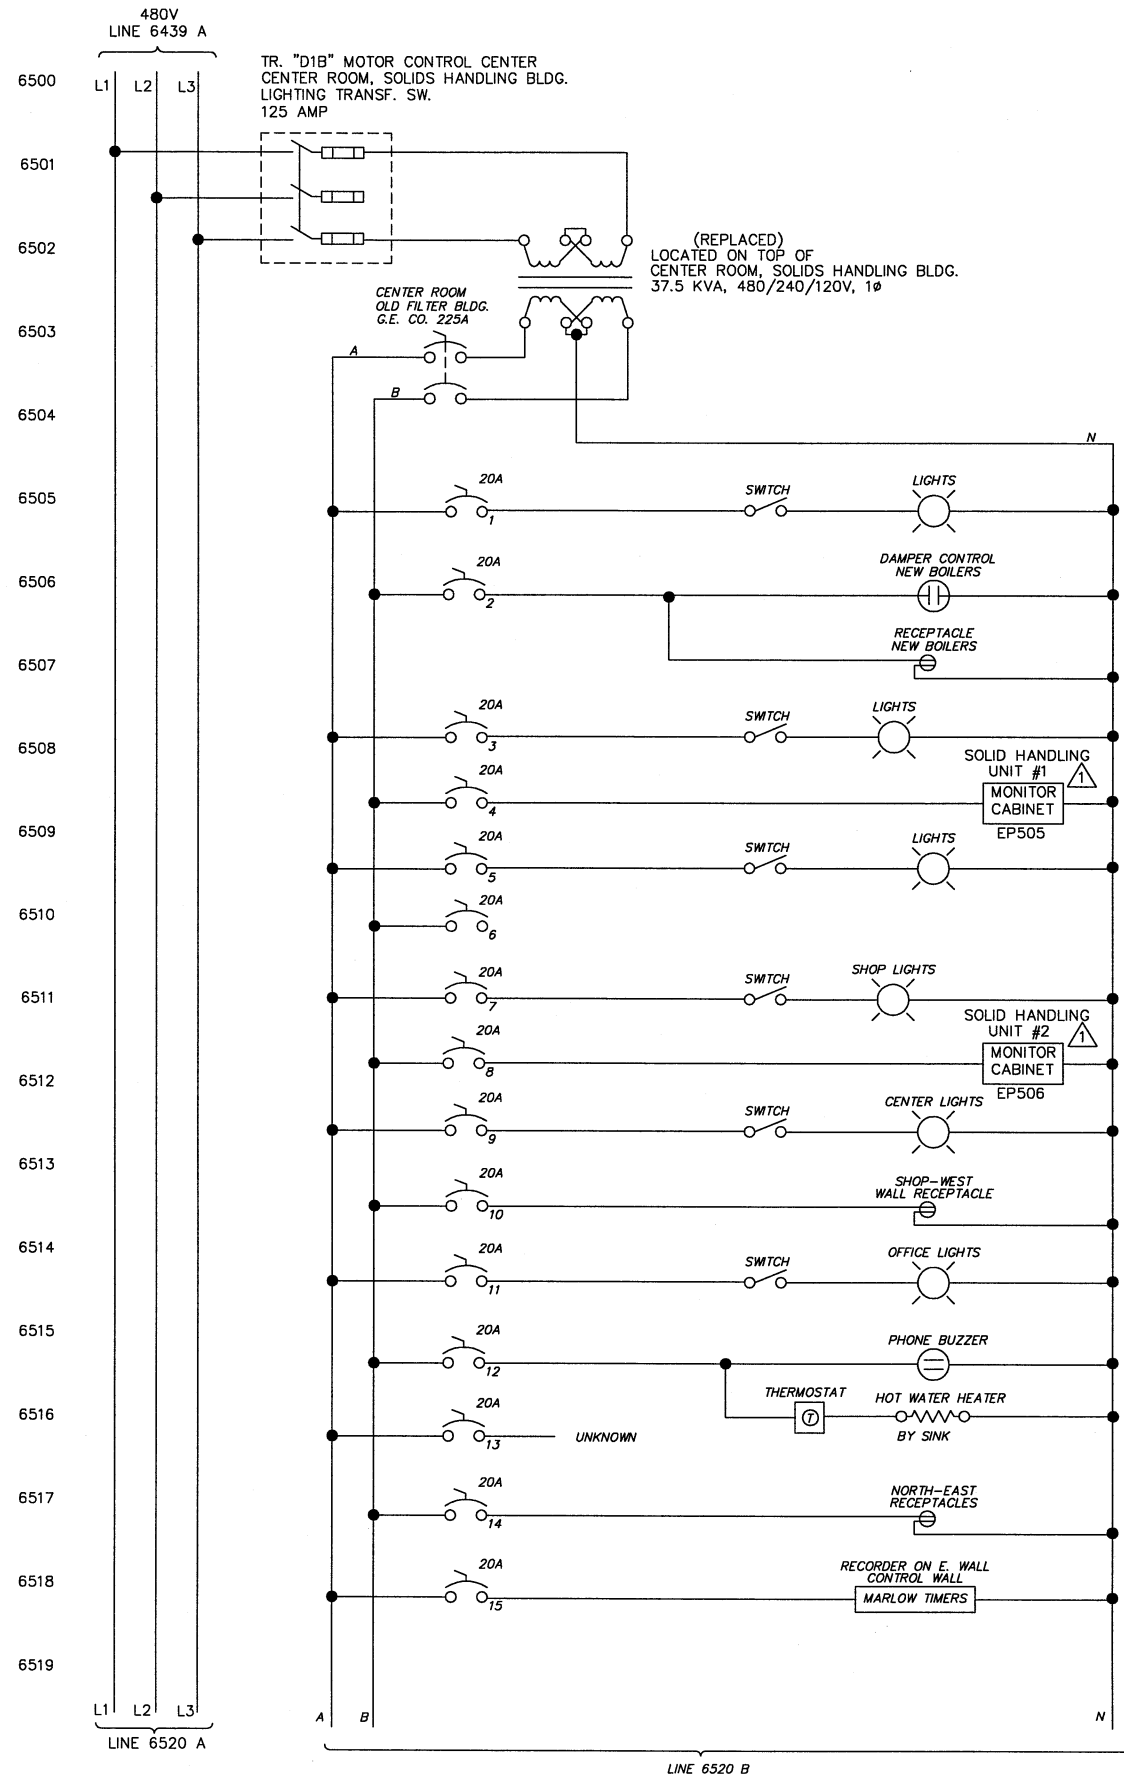


REVISIONS					
DESIGNED BY	NO.	DESCRIPTIONS	DATE	BY	APPD
STI/TSS	1	REVISED FOR CONSTRUCTION	7/28/01	TSS	R/L
STI/TSS					
STI/TSS					
ENVIRONMENTAL, INC.
DESIGNED BY WATER AND EARTH SCIENCES
UNIONTOWN, OHIO

CITY OF MASSILLON, OHIO
WWTP UPGRADE, 2000
TRANSFORMER "D1", MCC-D1B
LIGHTING PANEL SCHEMATIC DIAGRAM

JOB NO. E9031
DATE 3/1/01
SCALE N/A
SHEET EP65-1