


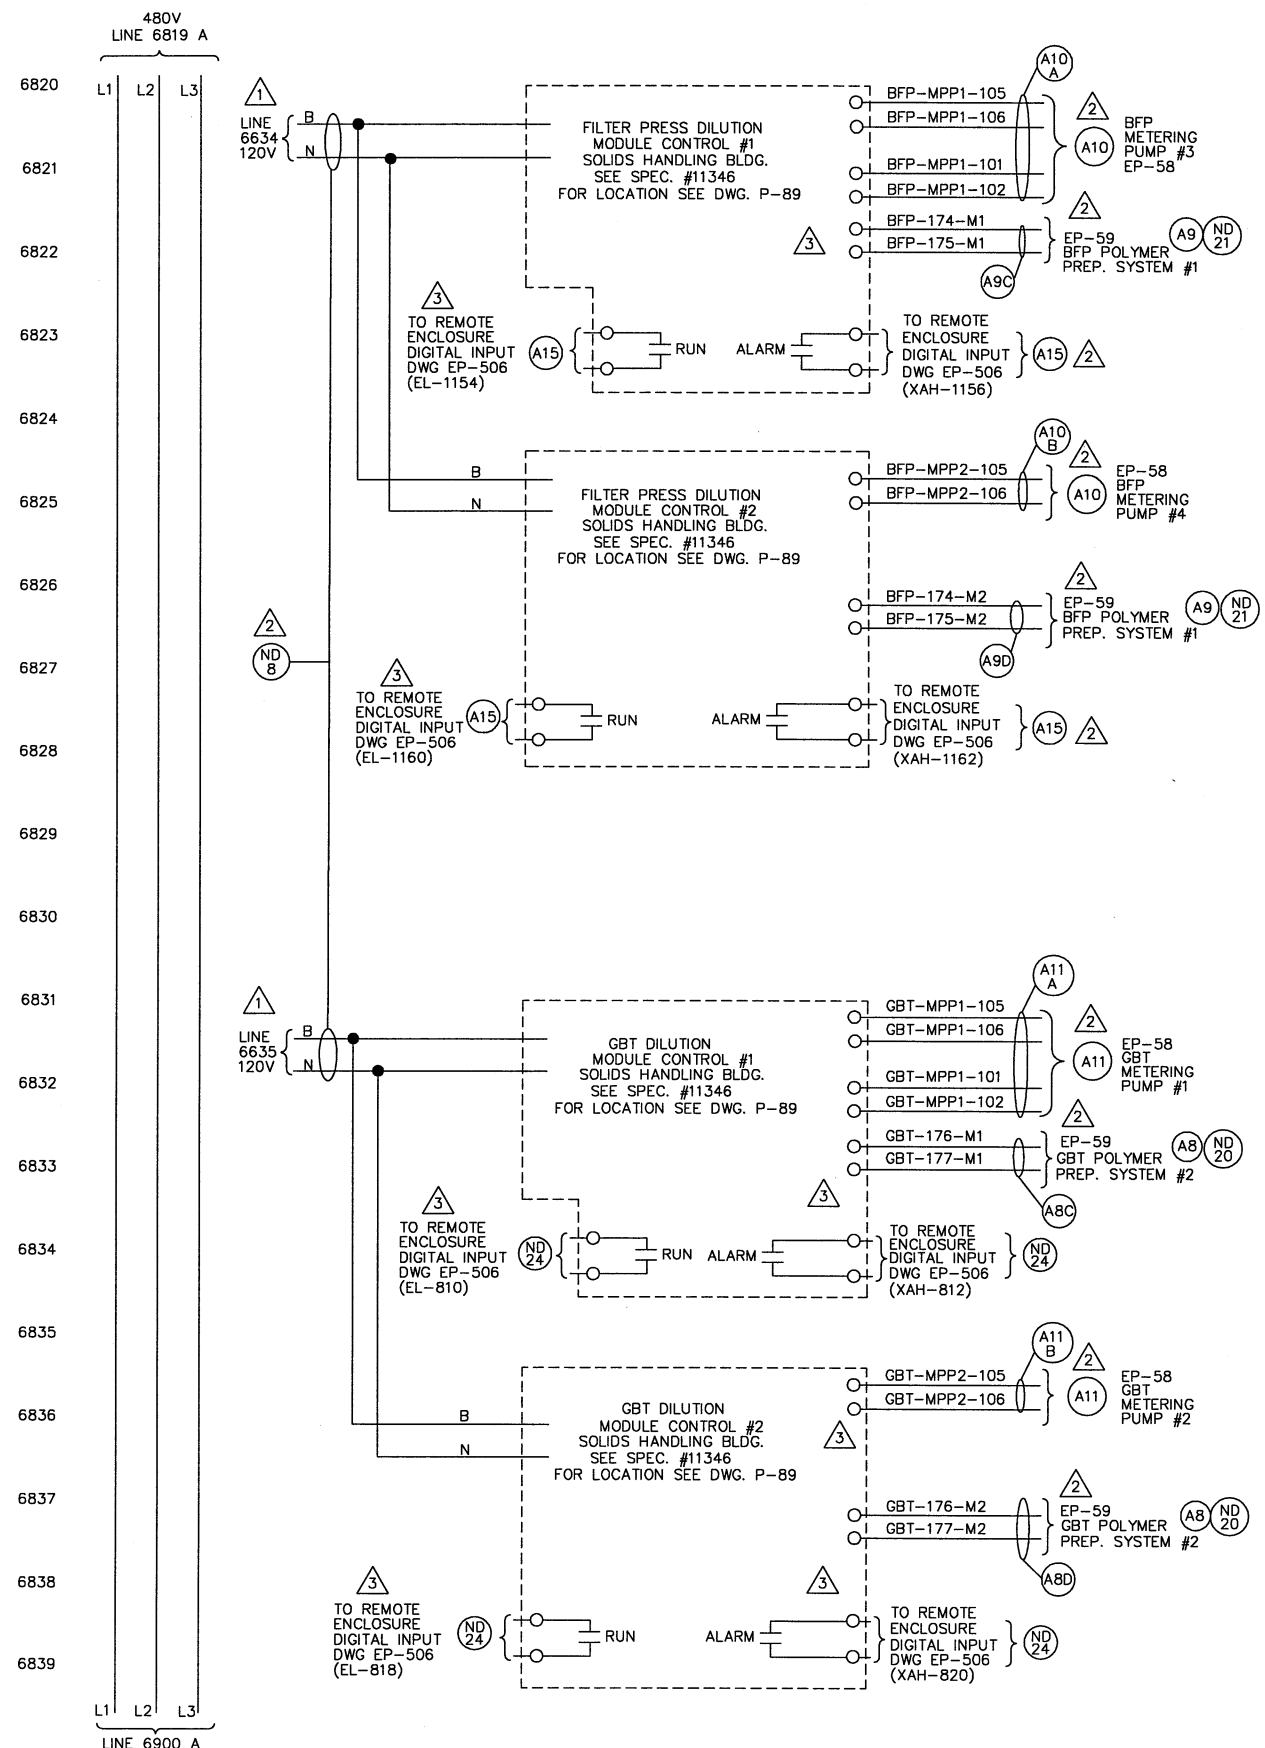

**CEP** ENVIRONMENTAL, INC.  
ENGINEERS IN WATER AND EARTH SCIENCES  
UNIONTOWN, OHIO

CITY OF MASSILLON, OHIO  
WWTP UPGRADE 2000  
TRANSFORMER "D1", MCC-D1B  
CONVEYOR MOTORS THICKENERS, & FILTER PRESS SCHEMATIC

|                  |
|------------------|
| JOB NO.<br>E9031 |
| DATE<br>3/1/01   |
| SCALE<br>N/A     |
| SHEET<br>EP68-3  |