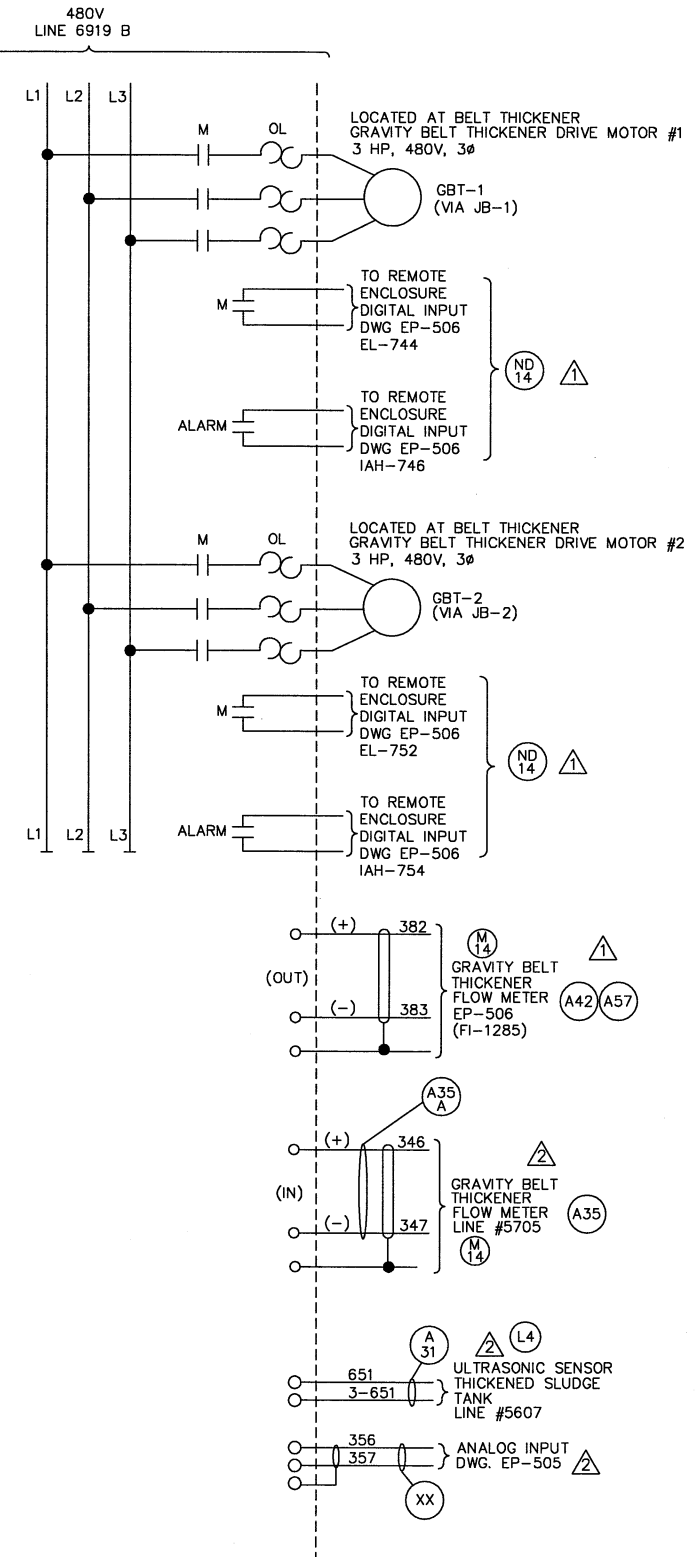
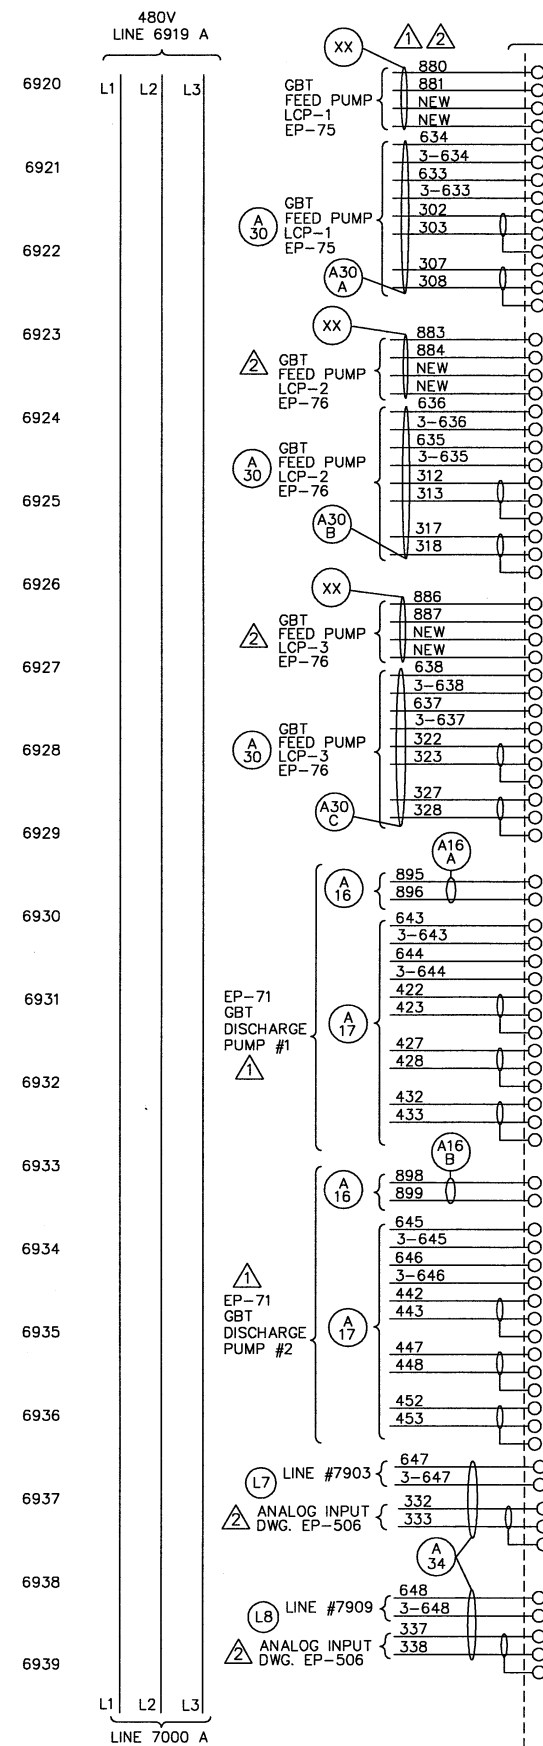
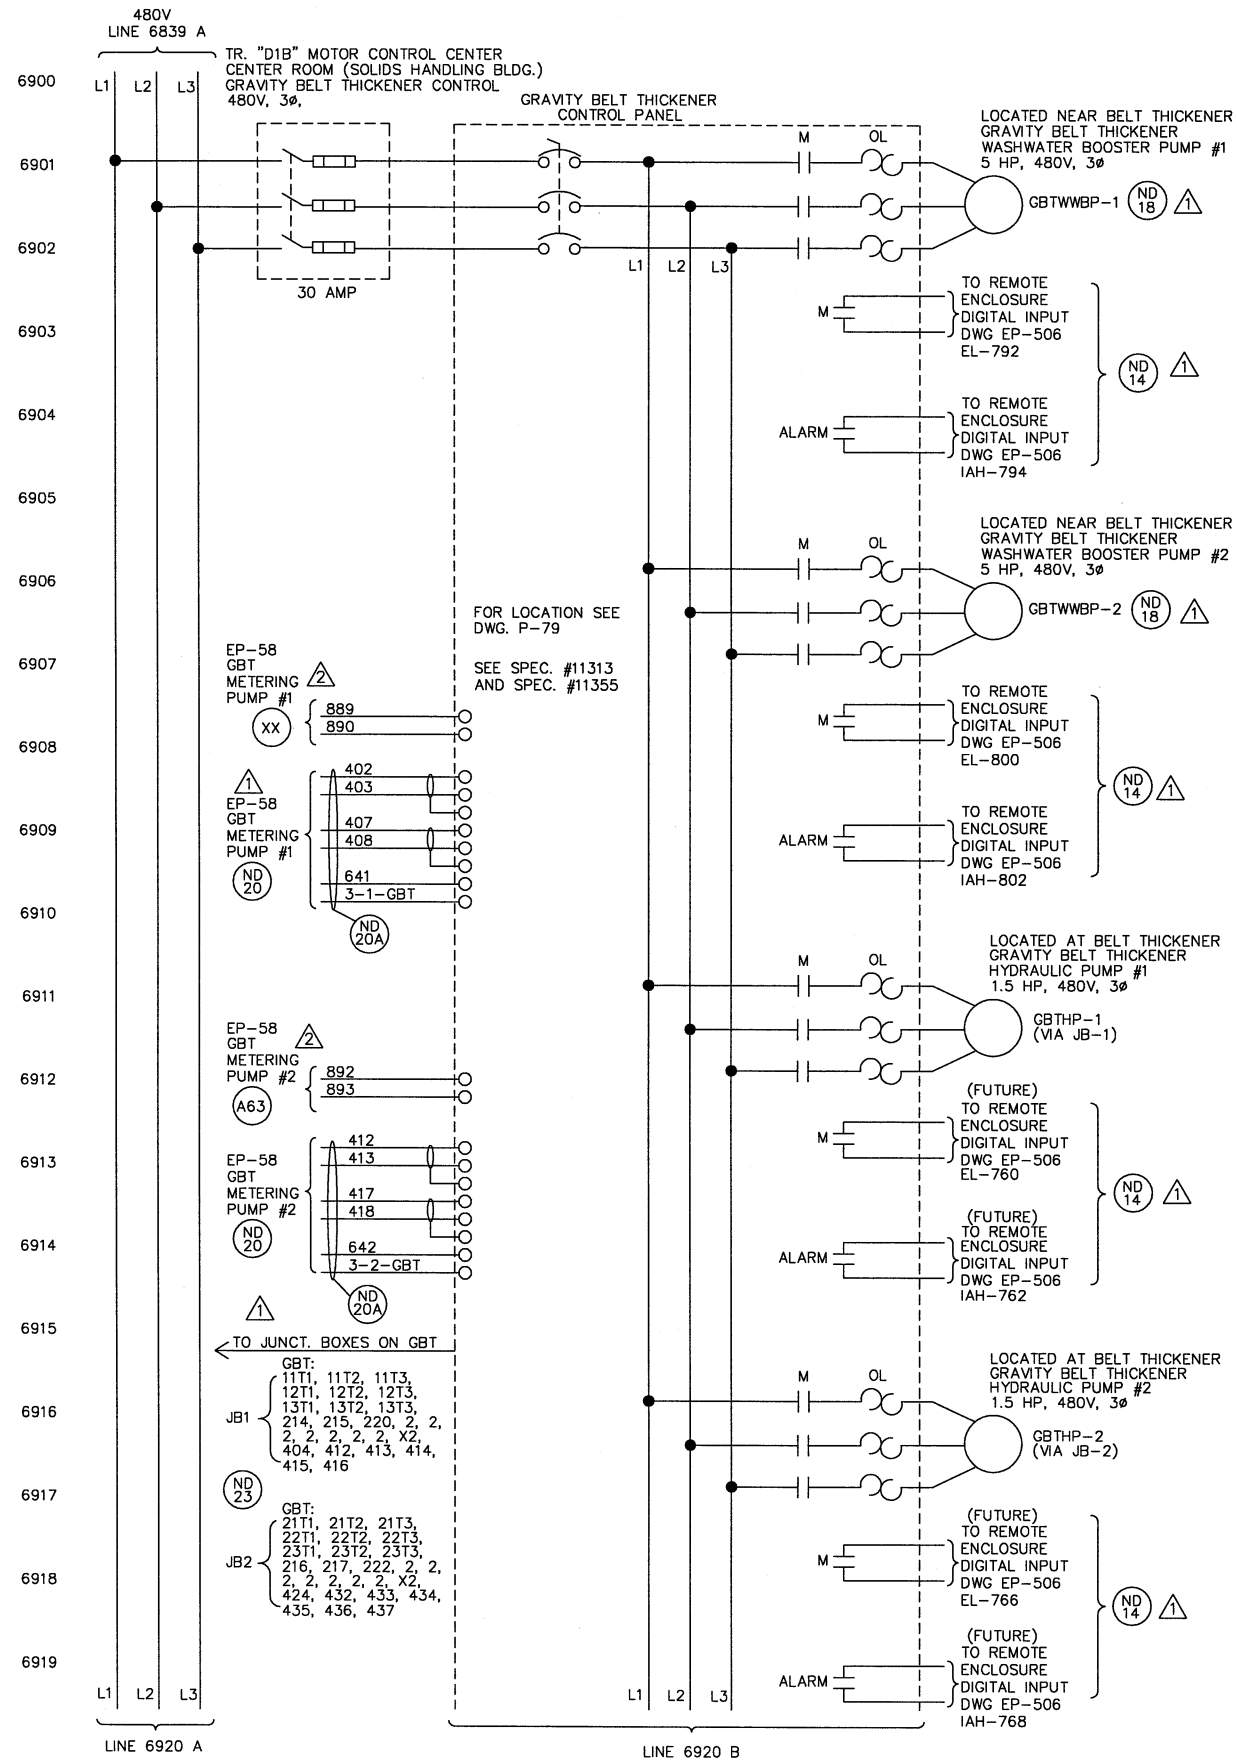


DESIGNED BY	NO.	DESCRIPTION	DATE	BY	APPROVED
STI/TSS	1	ADDED INTERCONNECTIONS	7/24/02	R.L.	R.L.
STI/TSS	2	REVISED FOR CONSTRUCTION	7/26/02	TSS	R.L.
STI/TSS					
STI/TSS					
STI/TSS					

ENVIRONMENTAL, INC.
ENGINEERS IN WATER AND EARTH SCIENCES
UNIONTOWN, OHIO

CITY OF MASSILLON, OHIO
WWTP UPGRADE 2000
TRANSFORMER "D1", MCC-D1B
GRAVITY BELT THICKENER CONTROL SCHEMATIC DIAGRAM

JOB NO. E9031
DATE 3/1/01
SCALE N/A
SHEET EP69-2