


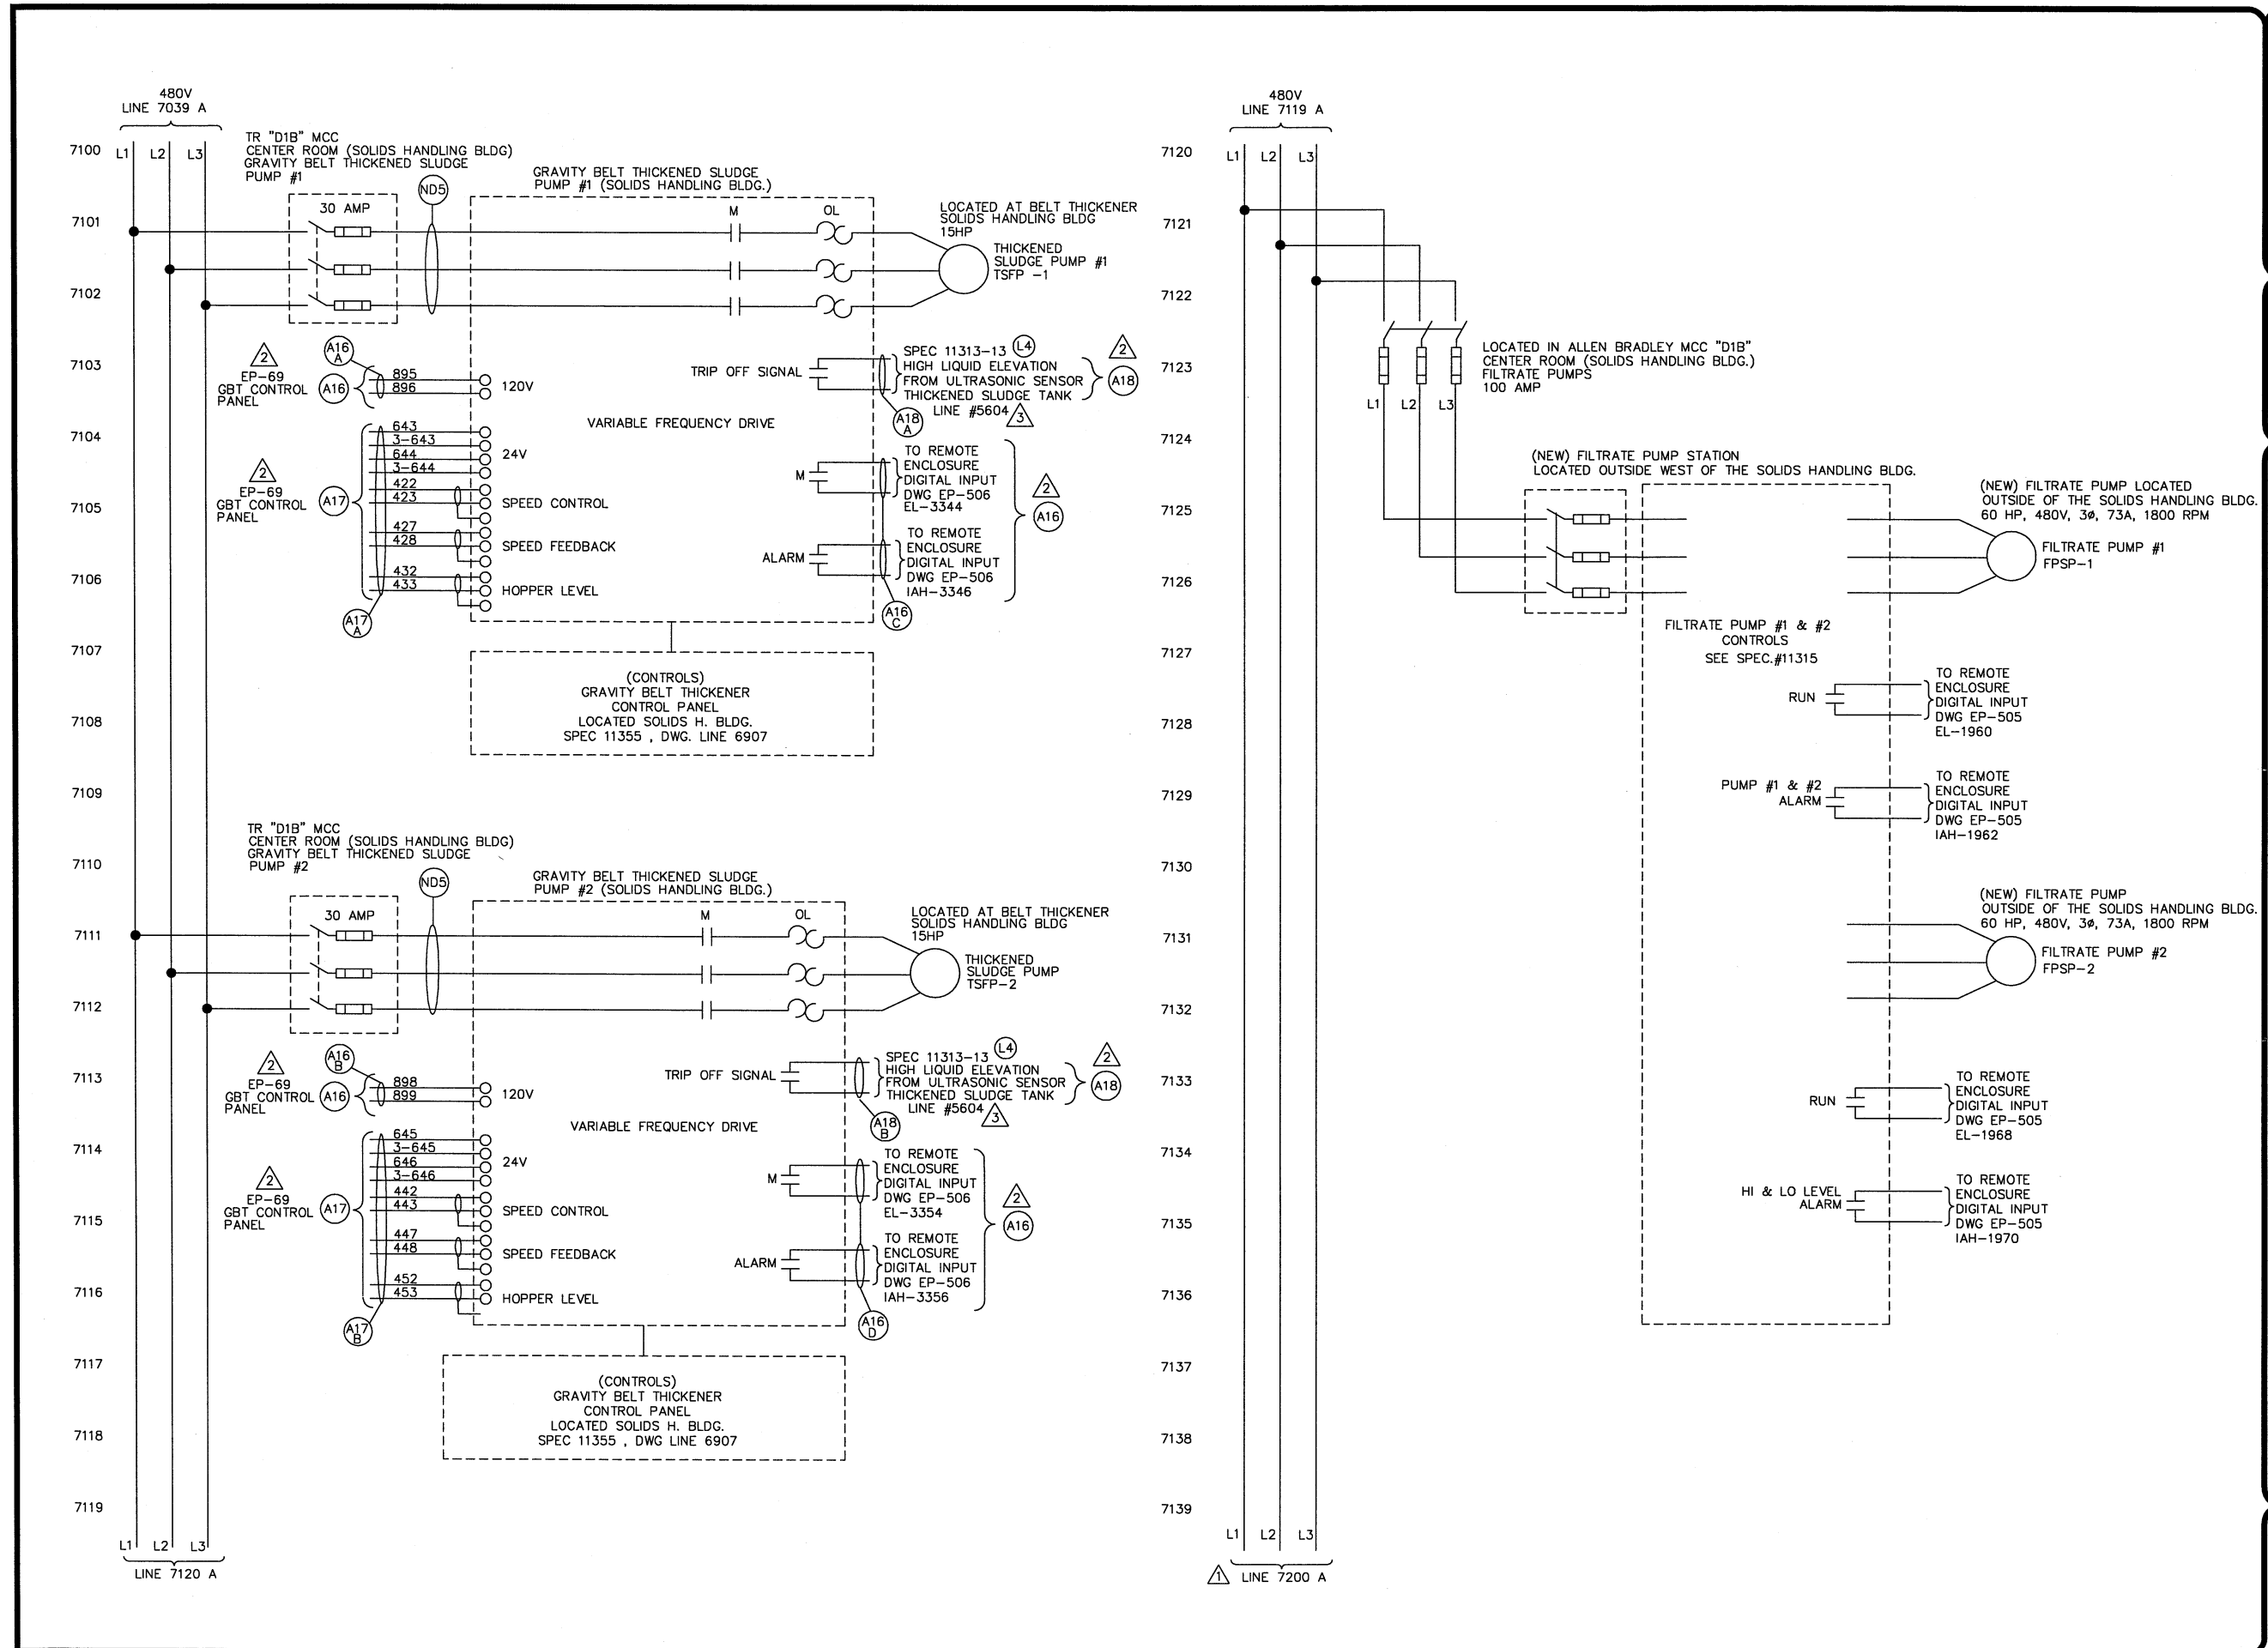

STI TECHNOLOGIES, INC.
MASSILLON, OHIO
5672

REVISIONS		DATE	BY	APP'D
1	REVISED AS PER CONSTRUCTION	7/12/04	TSS	RUL
2	ADDED INTERCONNECTIONS	7/27/04	TSS	RUL
3	ADDED INTERCONNECTIONS	7/29/04	TSS	RUL

DESIGNED BY	DRAWN BY	CHECKED BY	APPROVED BY
STI/TSS	STI/TSS	STI/TSS	STI/RUL

ENVIRONMENTAL, INC.
ENGINEERS IN WATER AND EARTH SCIENCES
UNIONTOWN, OHIO

STI

CITY OF MASSILLON, OHIO
WWTP UPGRADE 2000
TRANSFORMER "D1", MCC-D1B
FILTRATE PUMPS & DISCHARGE PUMPS SCHEMATIC DIAGRAM

JOB NO.	E9031
DATE	3/01/01
SCALE	N/A
SHEET	EP71-3

9031SCHE71.DWG