
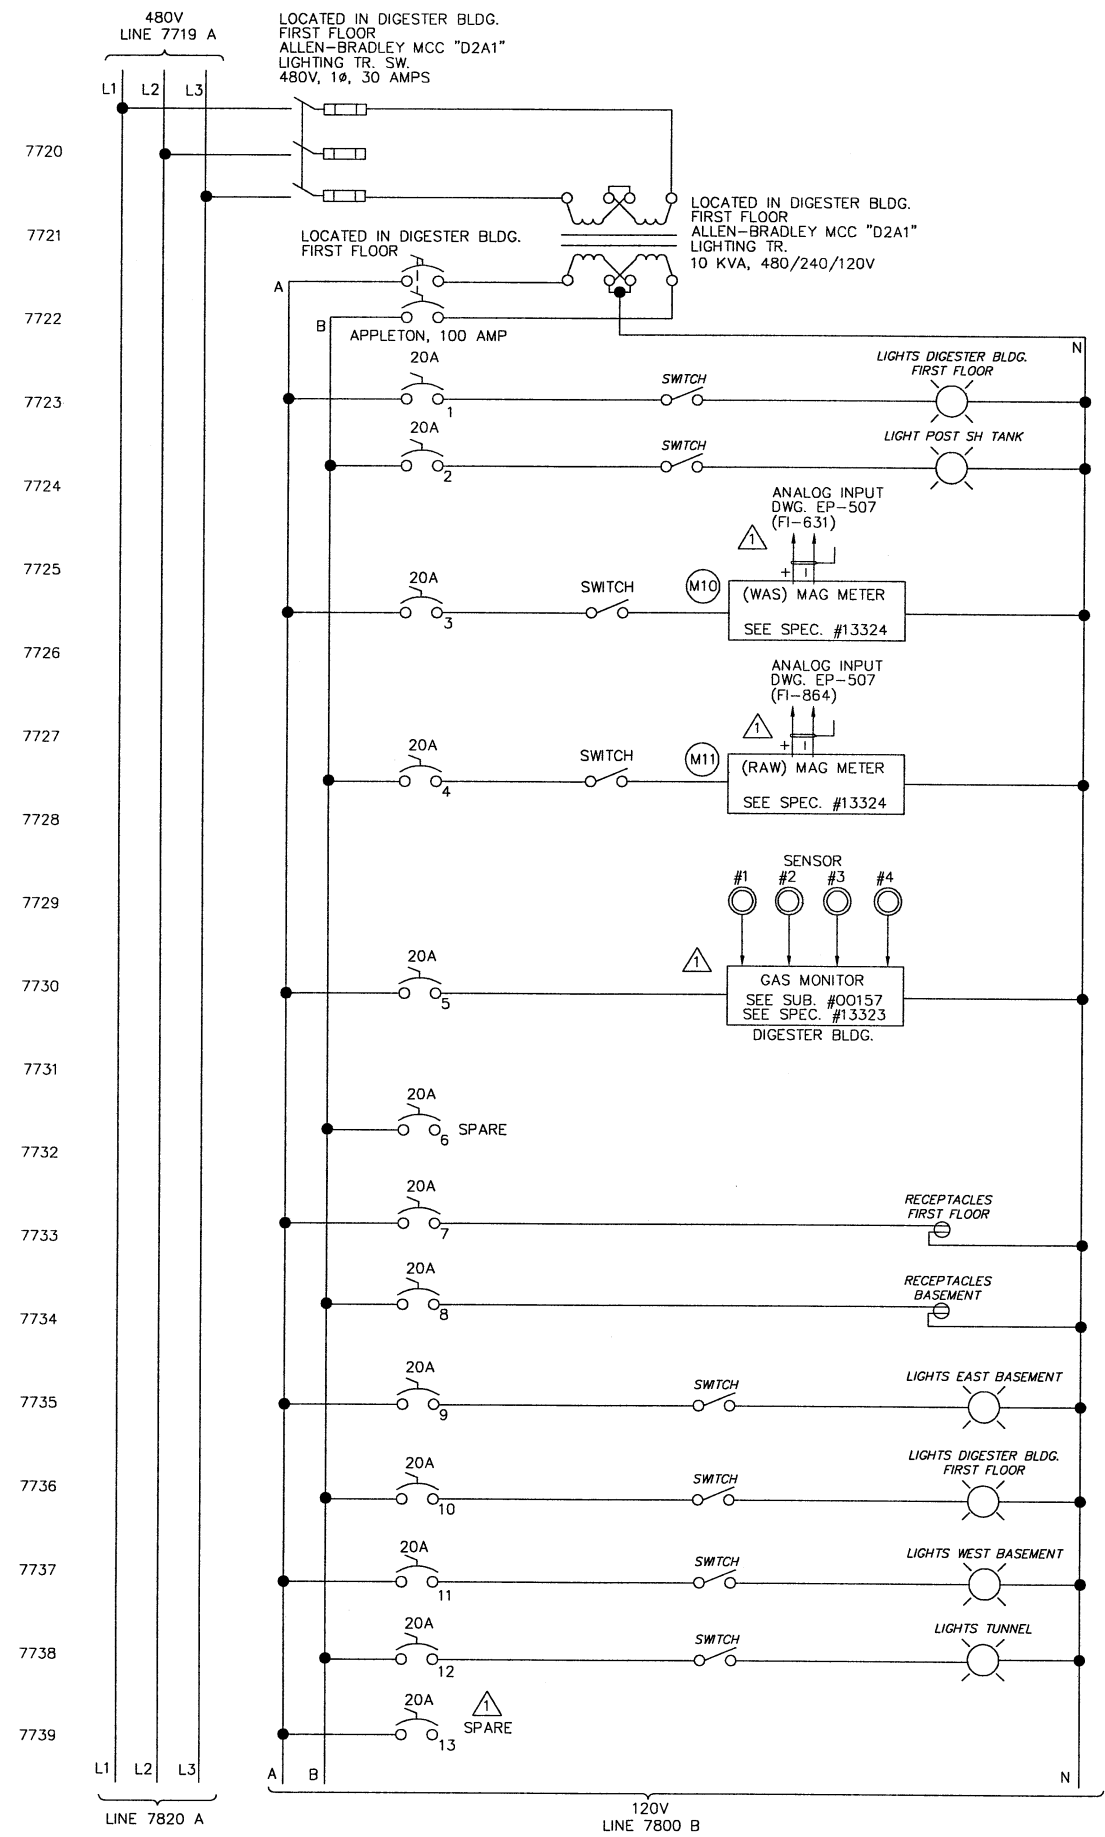


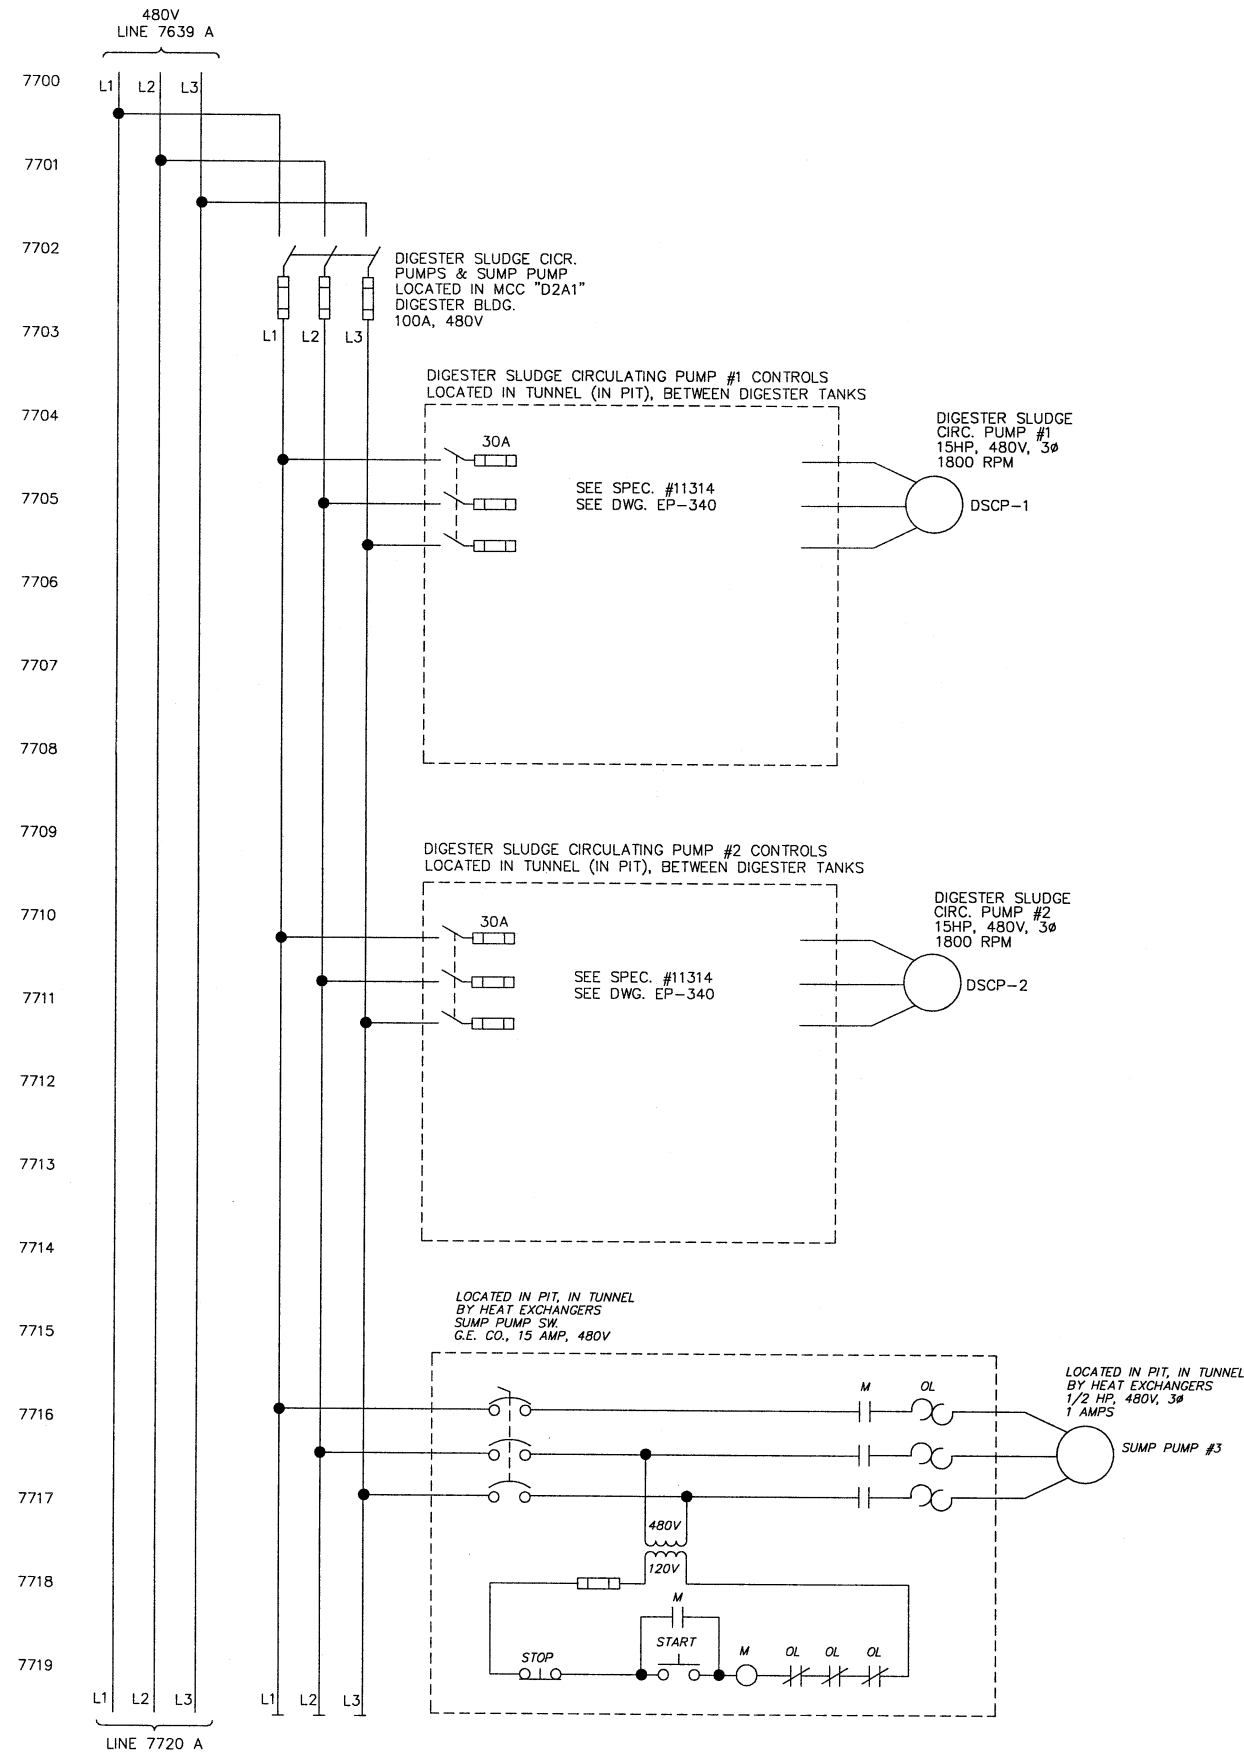

ENVIRONMENTAL, INC.
ENGINEERS IN WATER AND EARTH SCIENCES
UNIONTOWN, OHIO

CTI

CITY OF MASSILLON, OHIO
WWTP UPGRADE 2000
TRANSFORMER "D2" MCC-"D2A1"
SLUDGE CIRC. PUMPS, 10 KVA TRANSF. SCHEMATIC

DESIGNED BY		DRAWN BY		CHECKED BY		APPROVED BY	
STI/TSS		STI/TSS		STI/TSS		STI/R/L	
NO.	1	NO.	1	NO.	1	NO.	1
REVISIONS	DESCRIPTIONS	DATE	BY	APPROVED	DATE	BY	APPROVED
	REVISED FOR CONSTRUCTION	7/8/03	TSS				

JOB NO.
E9031

DATE
7/19/01

SCALE
N/A

SHEET
EP77-1