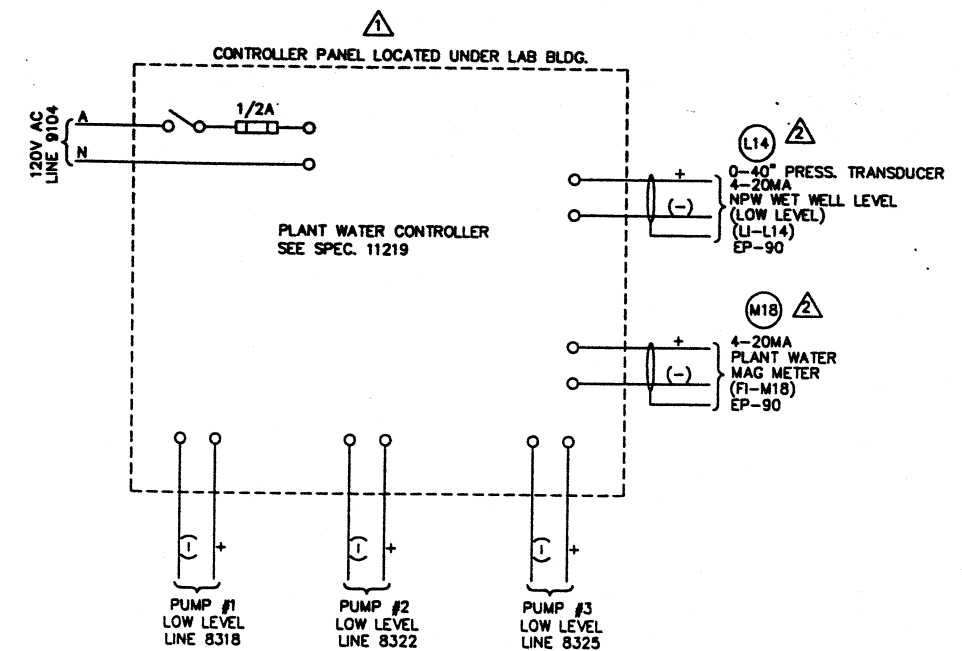
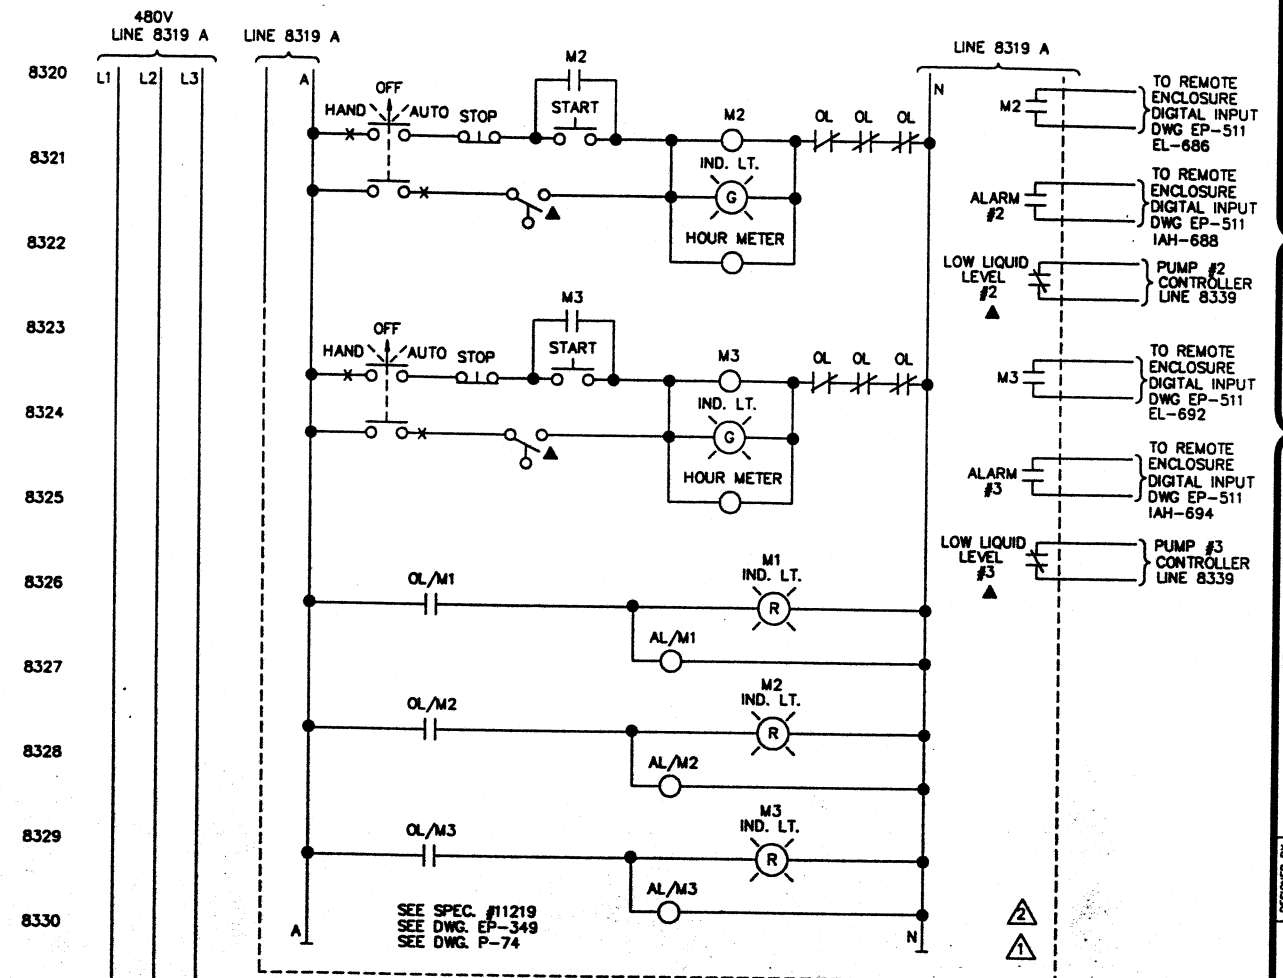
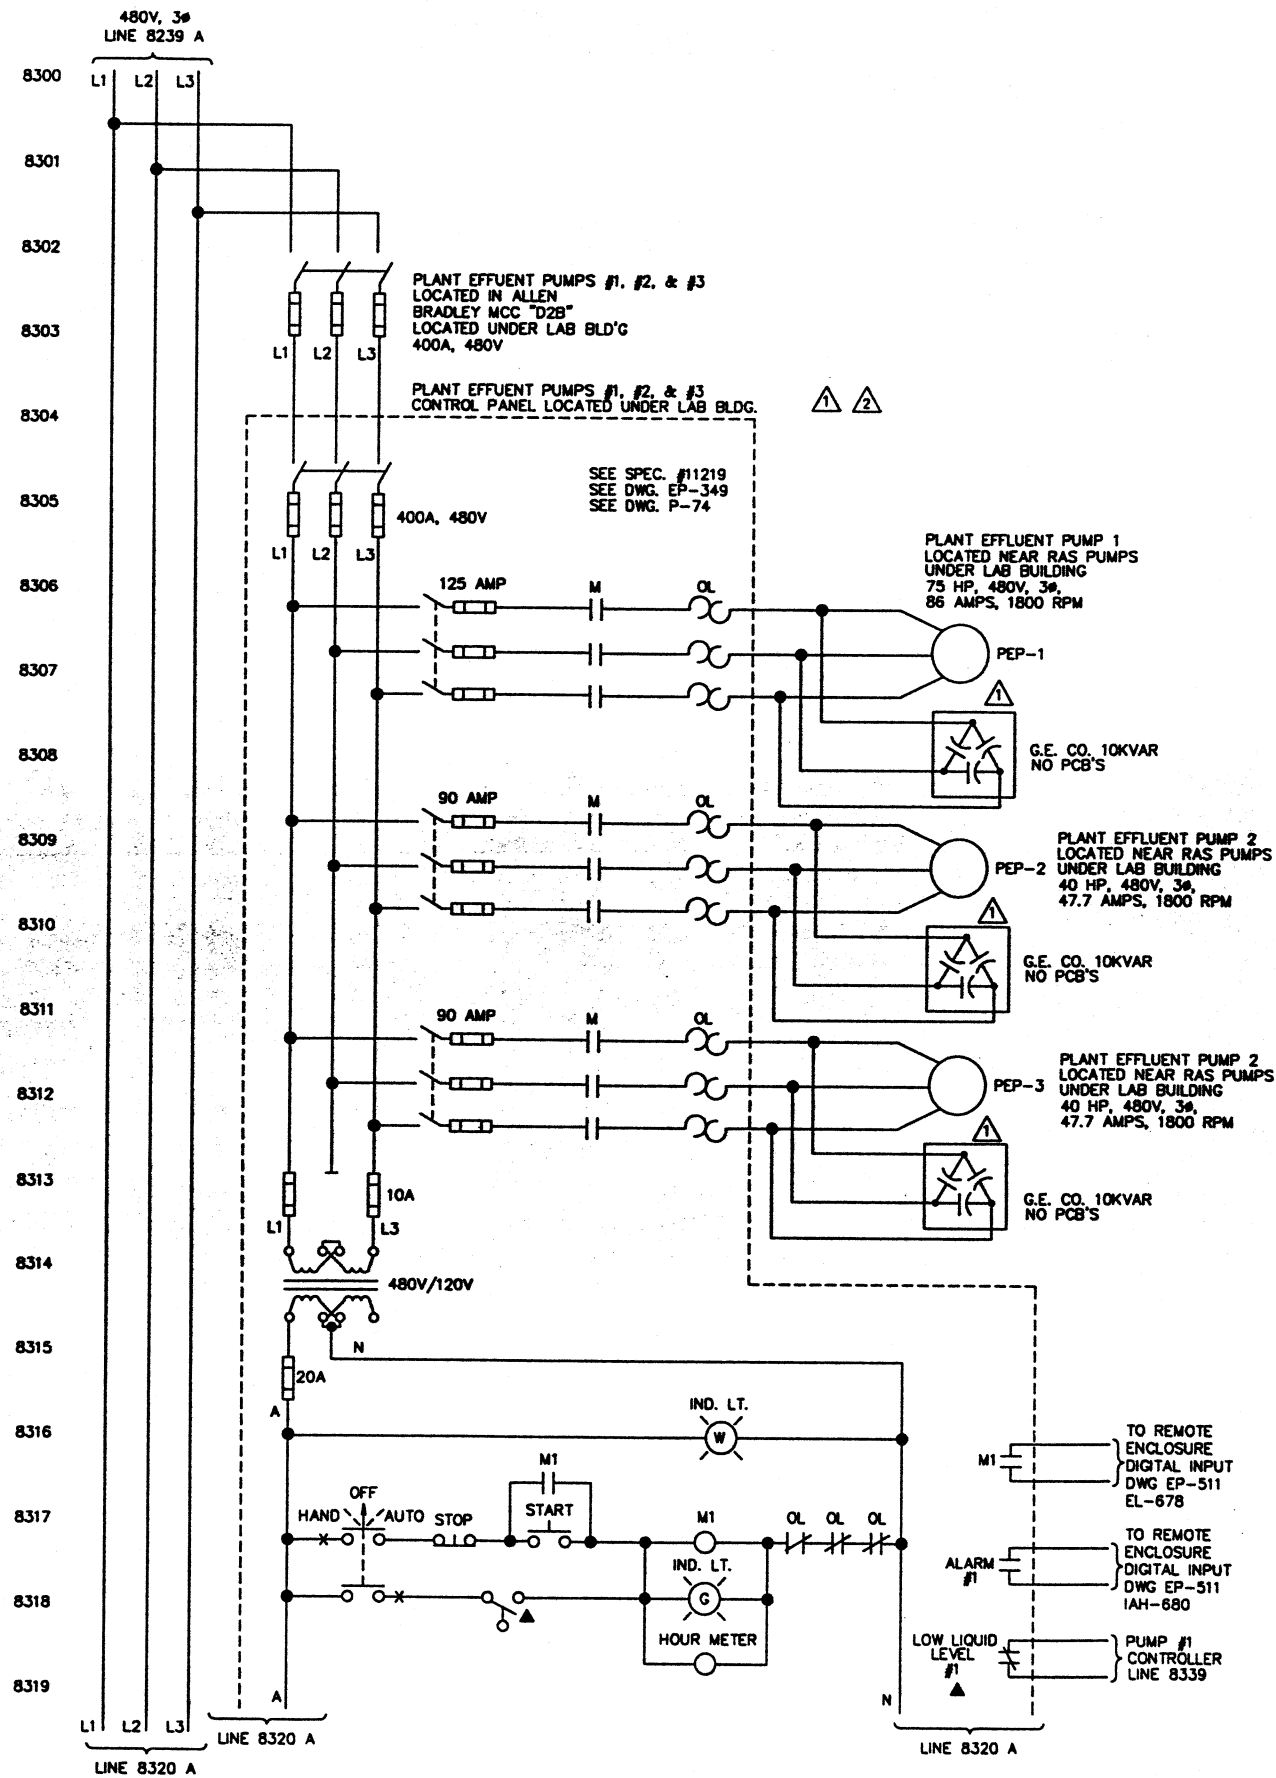


ENVIRONMENTAL INC.
ENGINEERS IN WATER AND EARTH SCIENCES
UNIONTOWN, OHIO

CITY OF MASSILLON, OHIO
WWTP UPGRADE 2000
TRANSFORMER "D2", MCC-D2B
PLANT EFFLUENT PUMPS - SCHEMATIC DIAGRAM

JOB NO.	E9031
DATE	7/19/01
SCALE	N/A
SHEET	EP83-2

9031SCHE83.DWG