


DATE	SYM	REVISION RECORD	AUTH	DR	CK
5/12/03	A	FOR APPROVAL	CUST	HR	BS

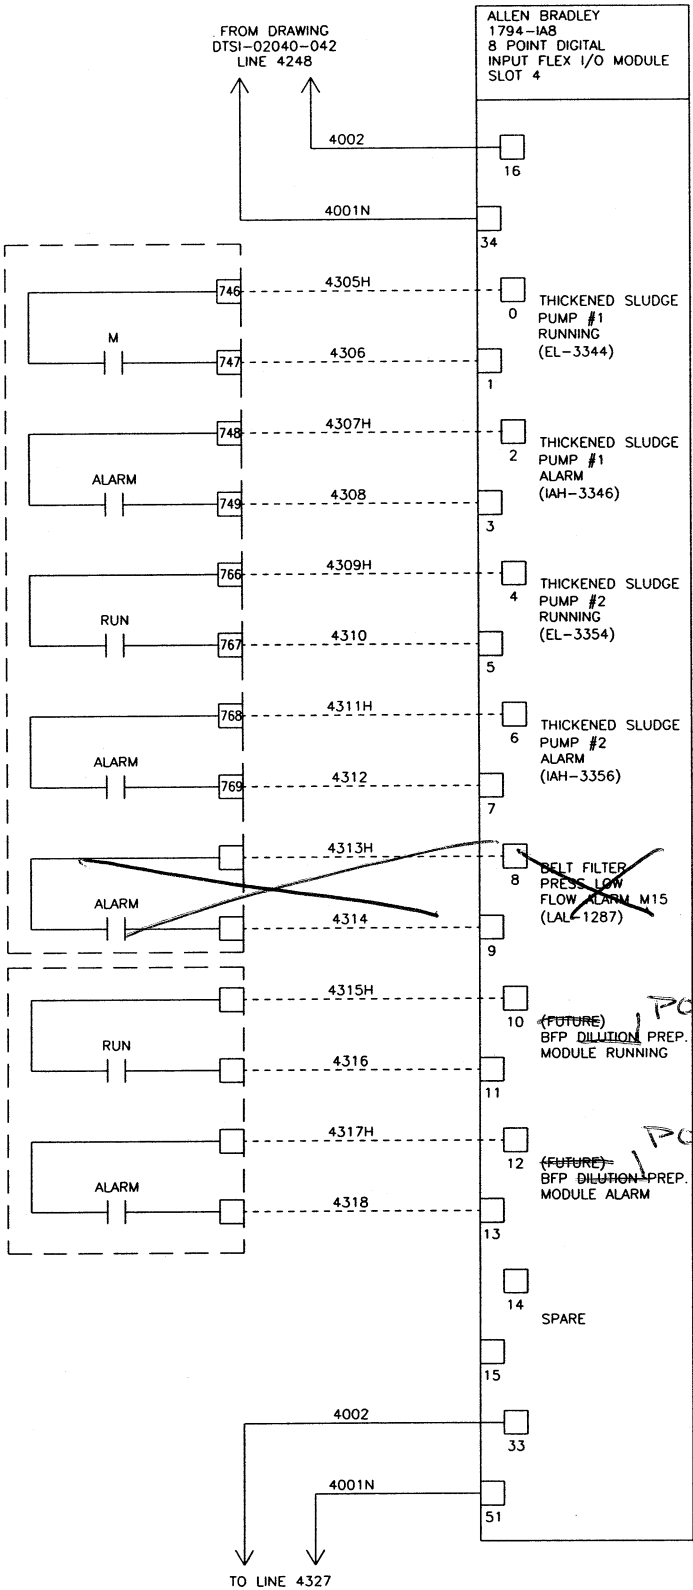


DELETE

POLYMER

POLYMER


BELT FILTER PRESS CONTROL PANEL

SLUDGE CAKE SCREW CONVEYOR CONTROL PANEL

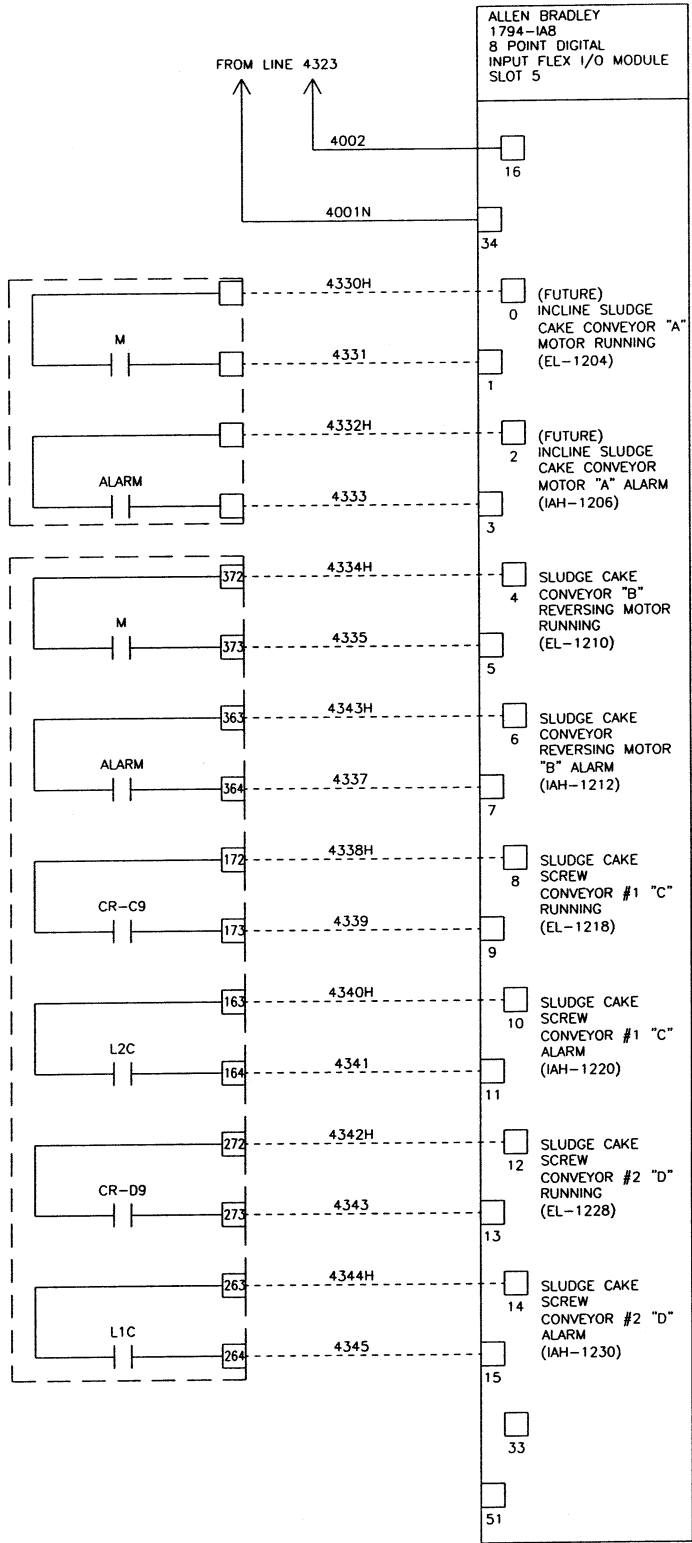

04/22/02 14:18

WIRE LUGS - NO ☒ YES ☐	INSULATION: NYLON ☐ PVC ☒	RING ☐ LOCKING SPADE ☐
WIRE SPECIFICATIONS:	SIZE	COLOR
AC PANEL POWER	AWG #12	BLK.
AC PANEL NEUTRAL	AWG #12	WHT.
AC PANEL GROUND	AWG #12	GRN.
AC CONTROL POWER	AWG #14	RED
AC CONTROL NEUTRAL	AWG #14	WHT.
AC FOREIGN	AWG #14	YELLOW
DC POWER	AWG #16	BLUE
DC CONTROL SIGNAL/INSTRUMENTS	AWG #16	BLUE

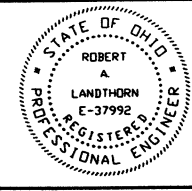

KOKOSING CONSTRUCTION CO.
P.O. #

DUBLIN TECHNICAL SYSTEMS INC.
PROJECT # 02040

TOLERANCES	DUBLIN TECHNICAL SYSTEMS, INC.
DECIMAL	CITY OF MASSILLON, OHIO REGIONAL WASTEWATER TREATMENT PLANT - UPGRADE 2000 PROJECT NO. E9031
FRACTIONAL	SCALE NONE
ANGULAR	DRAWN BY HR
	APPROVED BY BS
	TITLE TRANS D1B NODE 5 SOLIDS HANDLING UNIT #2 I/O WIRING DIAGRAM SLOTS 4 & 5
	DATE 4/08/02
	DRAWING NUMBER DTSI - 02040 - 043