

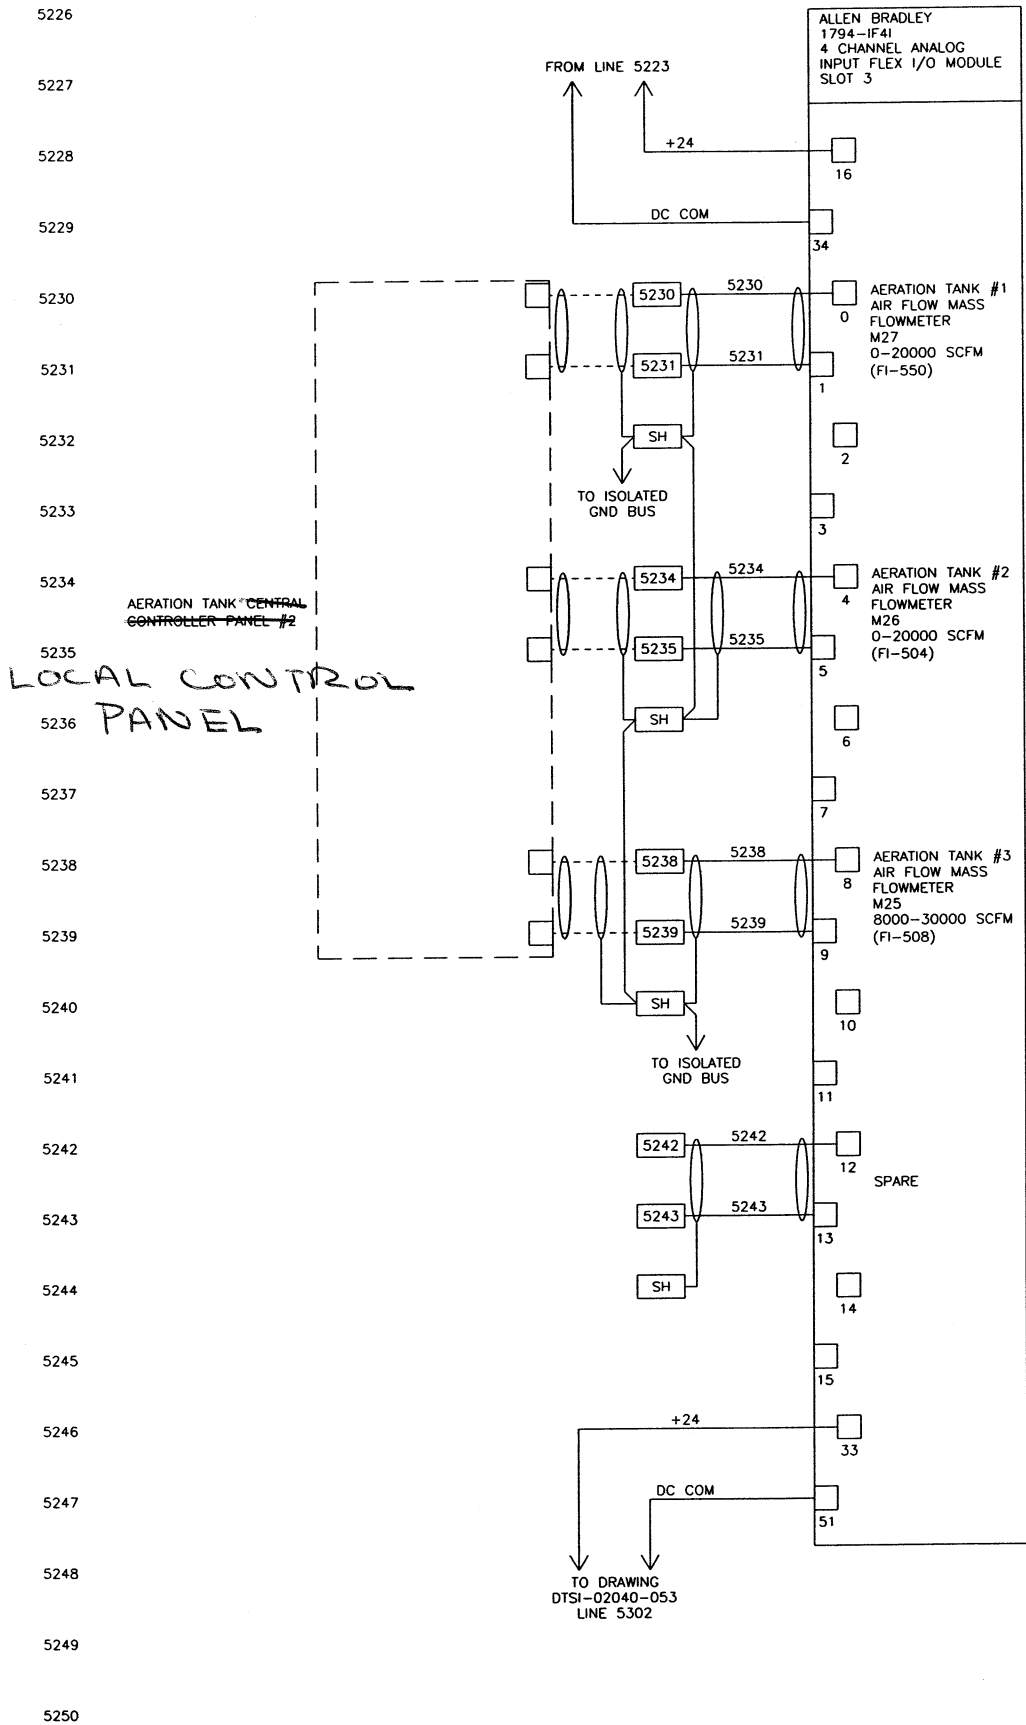


DATE	SYM	REVISION RECORD	AUTH	DR	CK
5/12/03	A	FOR APPROVAL	CUST	HR	BS

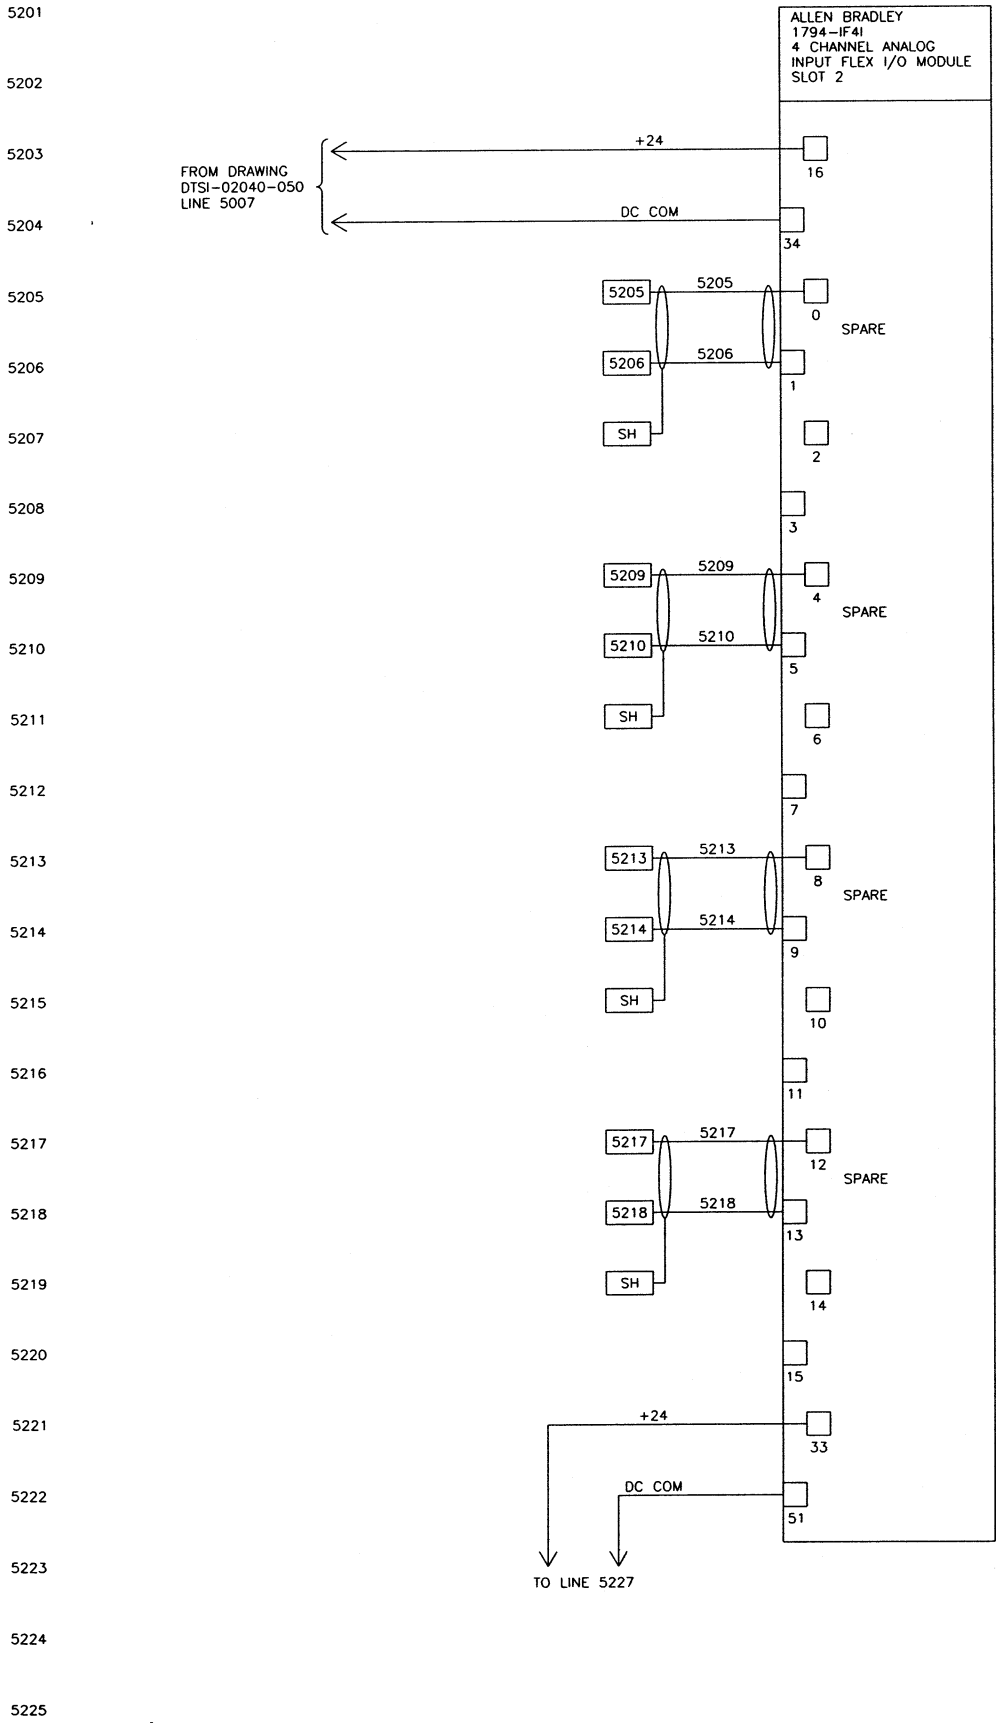

06/03/03 10:17

WIRE LUGS - NO ☒ YES ☐		RING ☐ LOCKING SPADE ☐	
INSULATION: NYLON ☐ PVC ☒			
WIRE SPECIFICATIONS:			
<u>USAGE</u>	<u>SIZE</u>	<u>COLOR</u>	<u>INSUL</u>
AC PANEL POWER	AWG #12	BLK.	THW/THHN
AC PANEL NEUTRAL	AWG #12	WHT.	THW/THHN
AC PANEL GROUND	AWG #12	GRN.	THW/THHN
AC CONTROL POWER	AWG #14	RED	THW/THHN
AC CONTROL NEUTRAL	AWG #14	WHT.	THW/THHN
AC FOREIGN	AWG #14	YELLOW	THW/THHN
DC POWER	AWG #16	BLUE	THW/THHN
DC CONTROL SIGNAL/INSTRUMENTS	AWG #16	BLUE	THW/THHN
		2 CONDUCTOR SHLD	

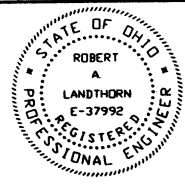

KOKOSING
CONSTRUCTION CO.
P.O. #

DUBLIN TECHNICAL
SYSTEMS, INC.
PROJECT # 02040

TOLERANCES		DUBLIN TECHNICAL SYSTEMS, INC.	
DECIMAL	± .03	CITY OF MASSILLON, OHIO REGIONAL WASTEWATER TREATMENT PLANT - UPGRADE 2000 PROJECT NO. E9031	SCALE NONE
FRACTIONAL	± 1/32"	TITLE TRANS E1 & E2 NODE 7 BLOWER BUILDING I/O WIRING DIAGRAM SLOTS 2 & 3	
ANGULAR	± 1°	DATE 4/08/02	DRAWING NUMBER DTSI - 02040 - 052