


DATE	SYM	REVISION RECORD	AUTH	DR	CK
5/12/03	A	FOR APPROVAL	CUST	HR	BS

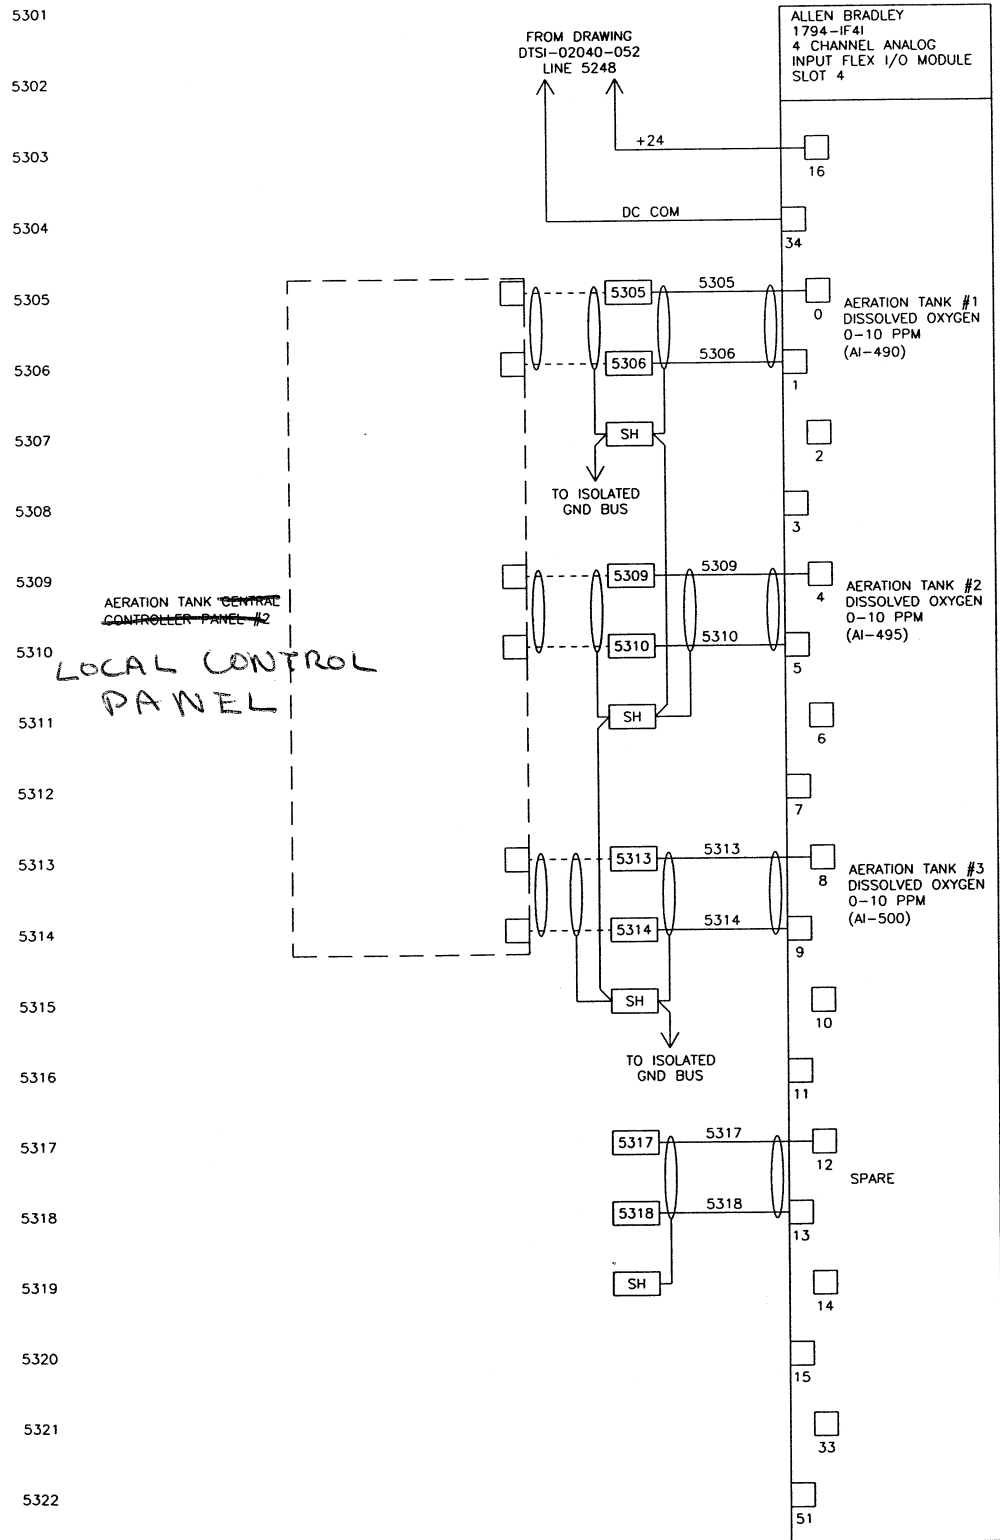

5326

5327

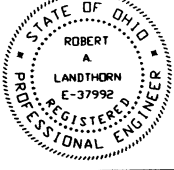06/03/03 10:18	WIRE LUGS - NO ☒ YES ☐ RING ☐ LOCKING SPADE ☐		 KOKOSING CONSTRUCTION CO. P.O. #	TOLERANCES		 DUBLIN TECHNICAL SYSTEMS, INC.
	INSULATION: NYLON ☐ PVC ☒			DECIMAL	CITY OF MASSILLON, OHIO REGIONAL WASTEWATER TREATMENT PLANT - UPGRADE 2000 PROJECT NO. 63031	
	WIRE SPECIFICATIONS:			FRACTIONAL	TITLE	
	USAGE	SIZE	COLOR	INSULATION	TRANS E1 & E2 NODE 7 BLOWER BUILDING I/O WIRING DIAGRAM SLOT 4	
	AC PANEL POWER	AWG #12	BLK.	THW/THHN		
	AC PANEL NEUTRAL	AWG #12	WHT.	THW/THHN		
	AC PANEL GROUND	AWG #12	GRN.	THW/THHN		
	AC CONTROL POWER	AWG #14	RED	THW/THHN		
	AC CONTROL NEUTRAL	AWG #14	WHT.	THW/THHN		
	AC FOREIGN	AWG #14	YELLOW	THW/THHN		
	DC POWER	AWG #18	BLUE	THW/THHN		
	DC CONTROL SIGNAL/INSTRUMENTS	AWG #18	BLUE	THW/THHN		
		AWG #16	2 CONDUCTOR SHLD	THW/THHN		
					DATE	DRAWING NUMBER
					4/08/02	DTSI - 02040 - 053