
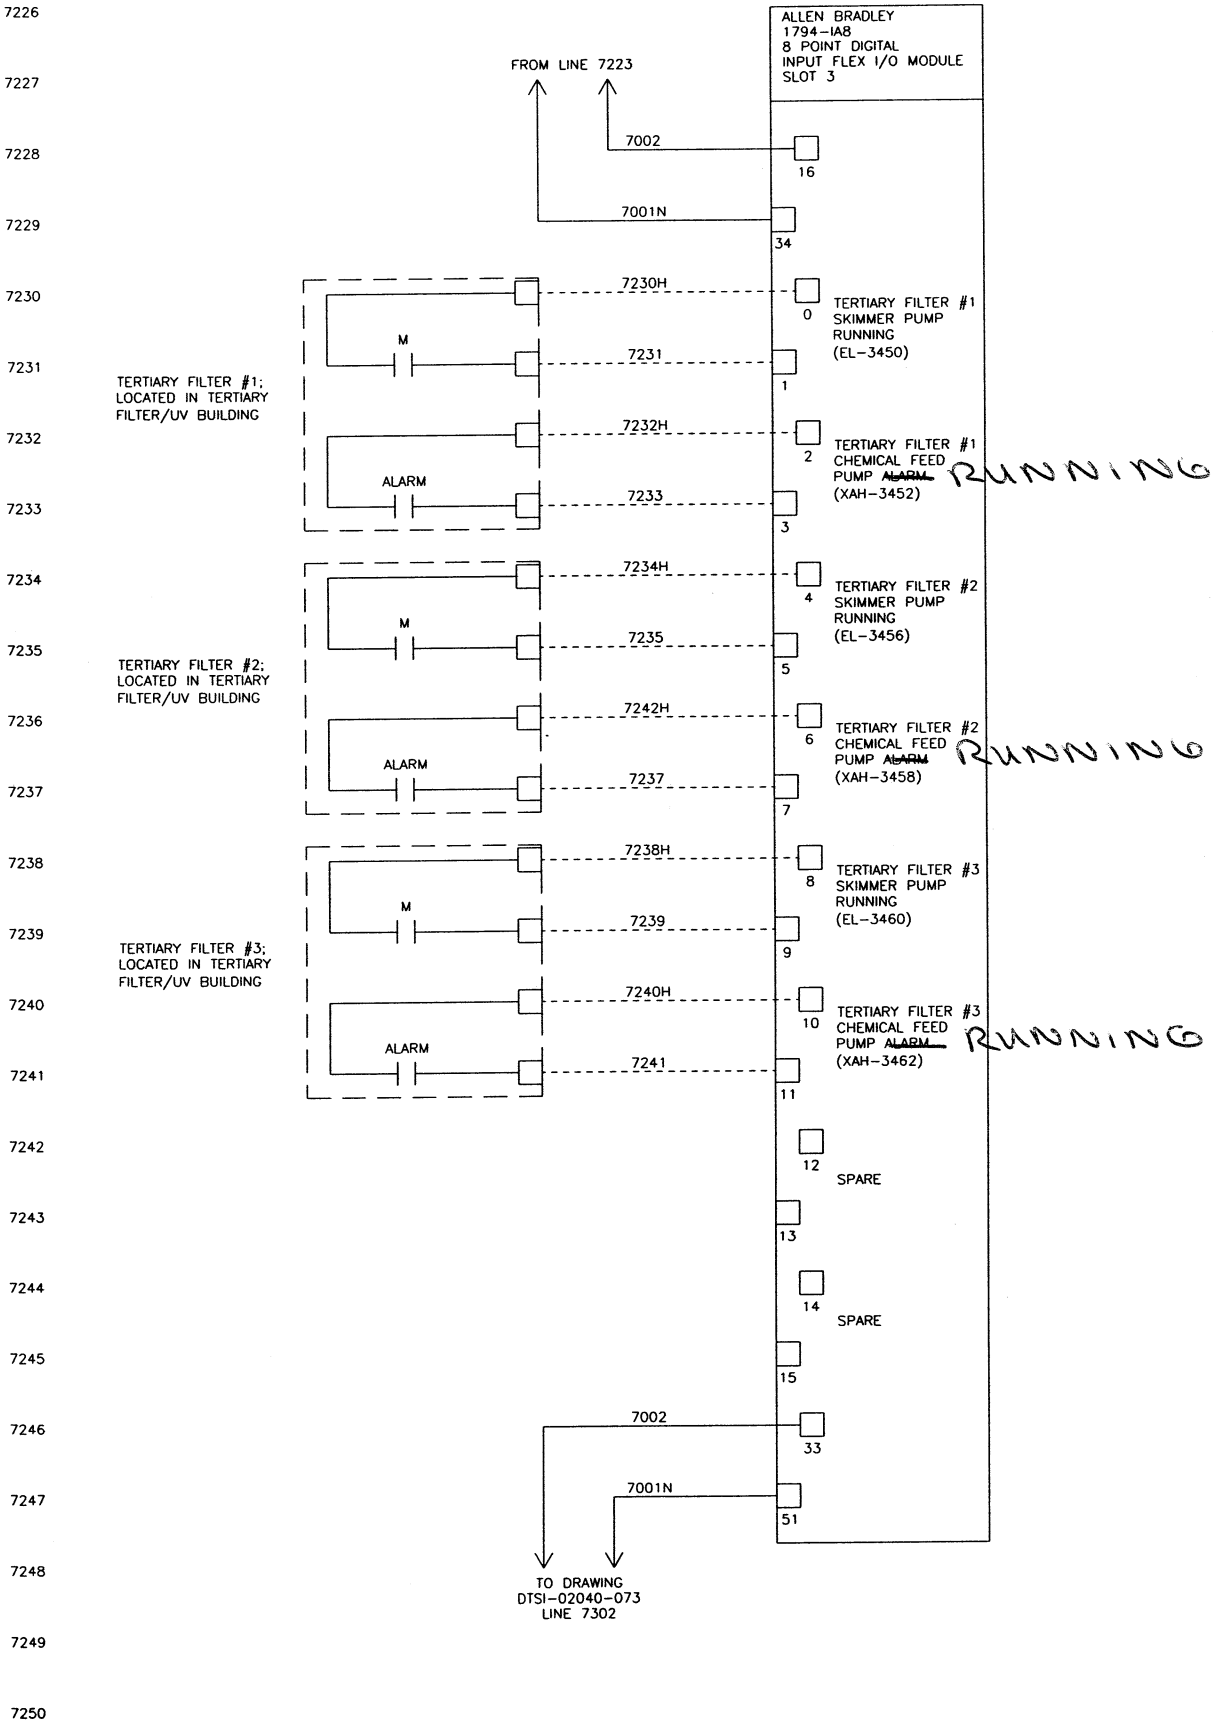


DATE	SYM	REVISION RECORD	AUTH	DR	CK
5/12/03	A	FOR APPROVAL	CUST	HR	BS

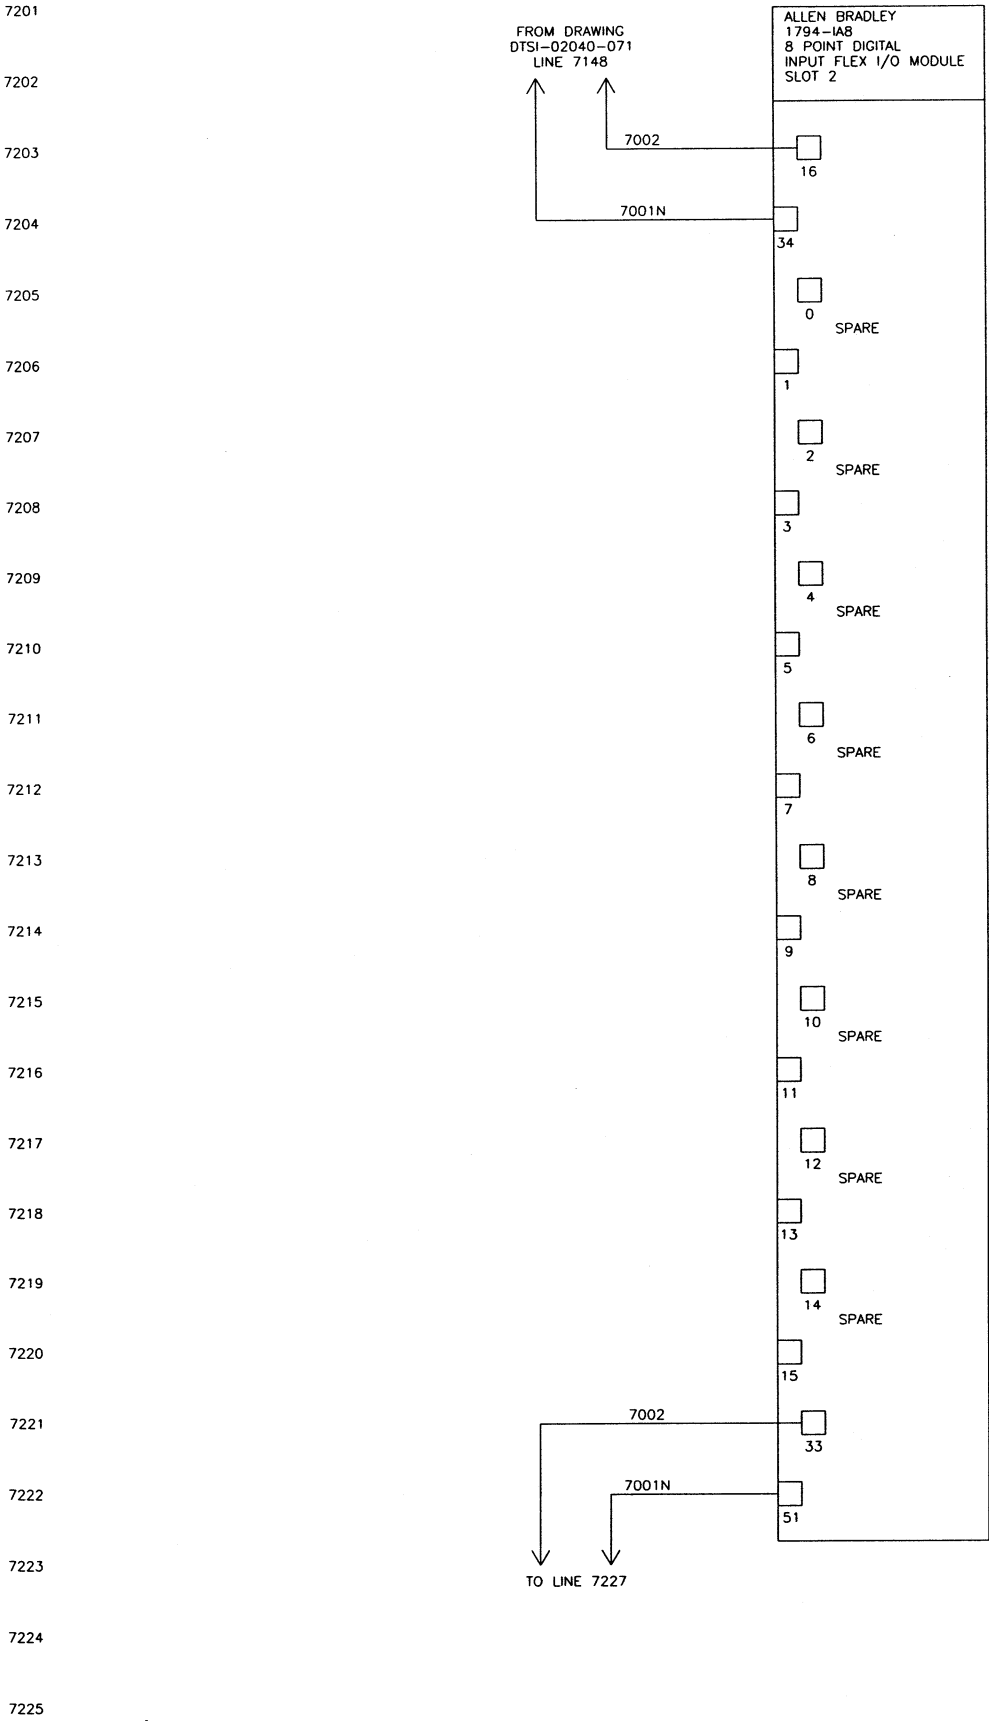

06/03/03 10:58	WIRE LUGS - NO ☒ YES ☐		RING ☐ LOCKING SPADE ☐			 KOKOSING CONSTRUCTION CO. P.O. #	TOLERANCES		 DUBLIN TECHNICAL SYSTEMS, INC.	
	INSULATION: NYLON ☐ PVC ☒						DECIMAL	SCALE		DRAWN BY <i>HR</i>
	WIRE SPECIFICATIONS:						± .03	NONE		APPROVED BY <i>BS</i>
	USAGE	SIZE	COLOR	INSULATION			FRACTIONAL	TITLE		
	AC PANEL POWER	AWG #12	BLK.	THW/THHN			± 1/32"	TRANS D1 NODE 11 TERTIARY FILTER & UV		
	AC PANEL NEUTRAL	AWG #12	WHI.	THW/THHN				I/O WIRING DIAGRAM SLOTS 2 & 3		
	AC PANEL GROUND	AWG #12	GRN.	THW/THHN						
	AC CONTROL POWER	AWG #14	RED	THW/THHN						
	AC CONTROL NEUTRAL	AWG #14	WHI.	THW/THHN						
	AC FORECH	AWG #14	YELLOW	THW/THHN						
DC POWER	AWG #16	BLUE	THW/THHN		DATE	DRAWING NUMBER				
DC CONTROL	AWG #16	BLUE	THW/THHN		4/08/02	DTSI - 02040 - 072				
SIGNAL/INSTRUMENTS	AWG #16	2 CONDUCTOR SHLD								